

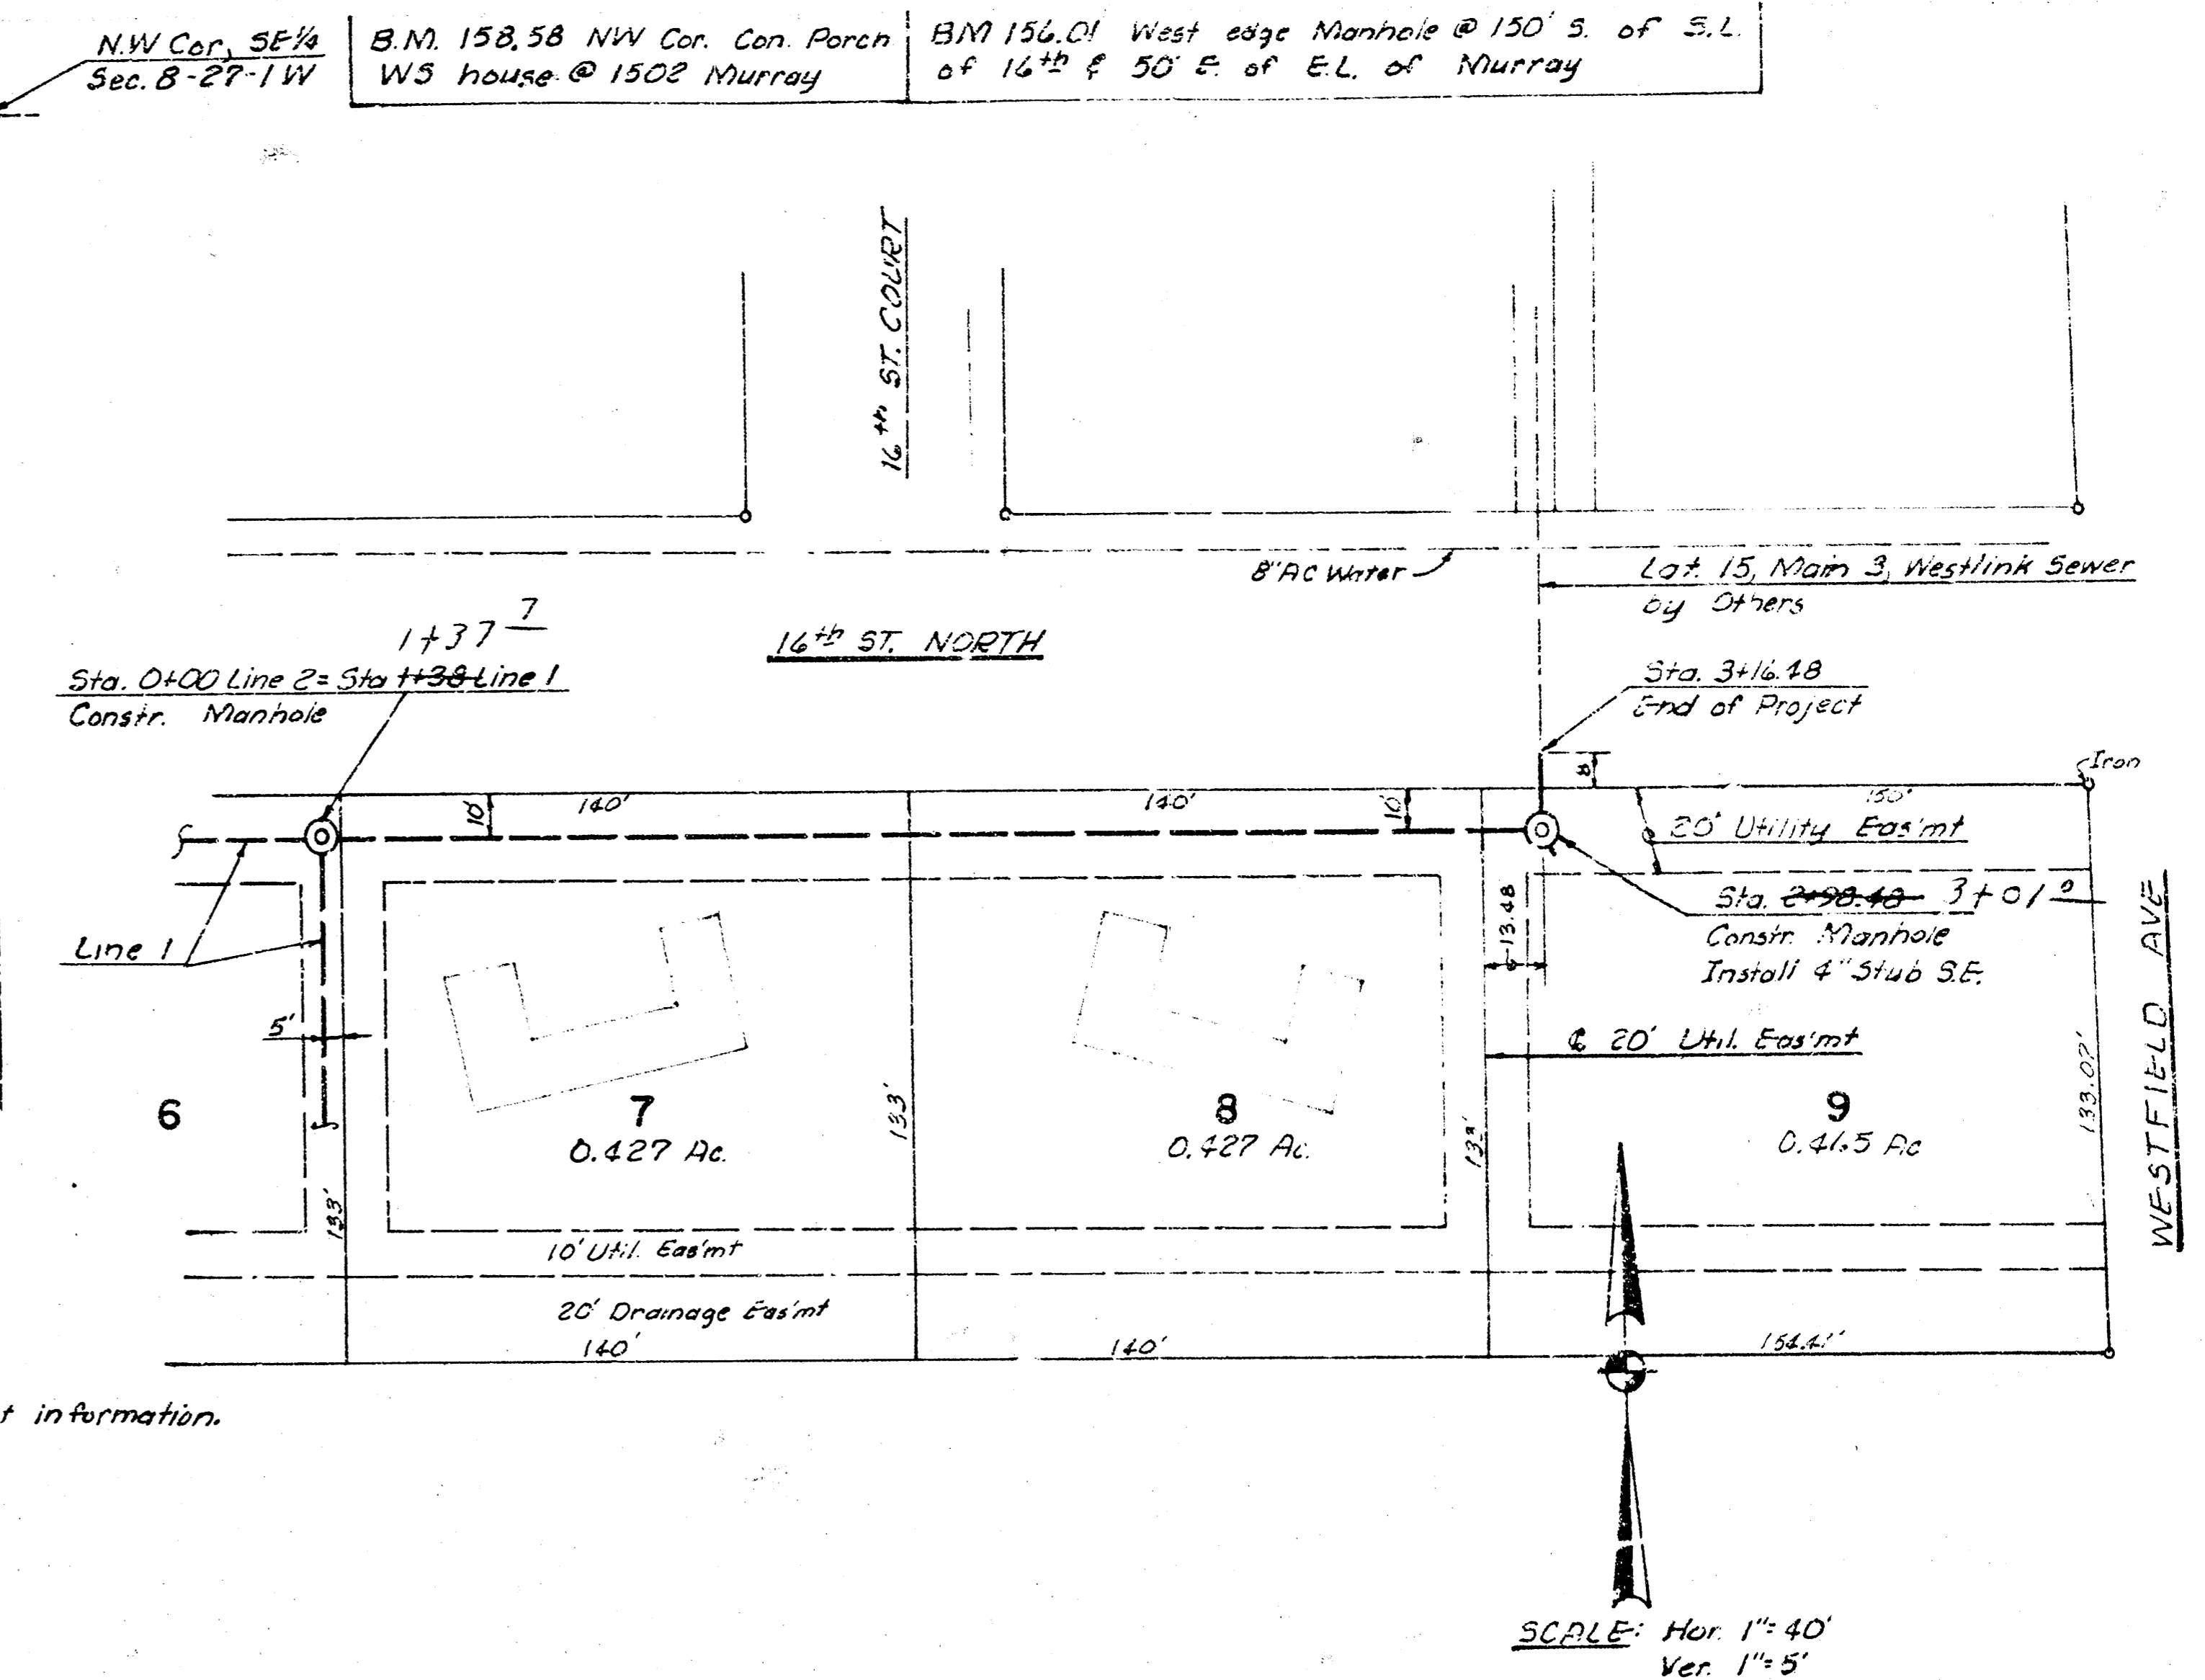


JFC:lgf (L&S-2)  
WSK

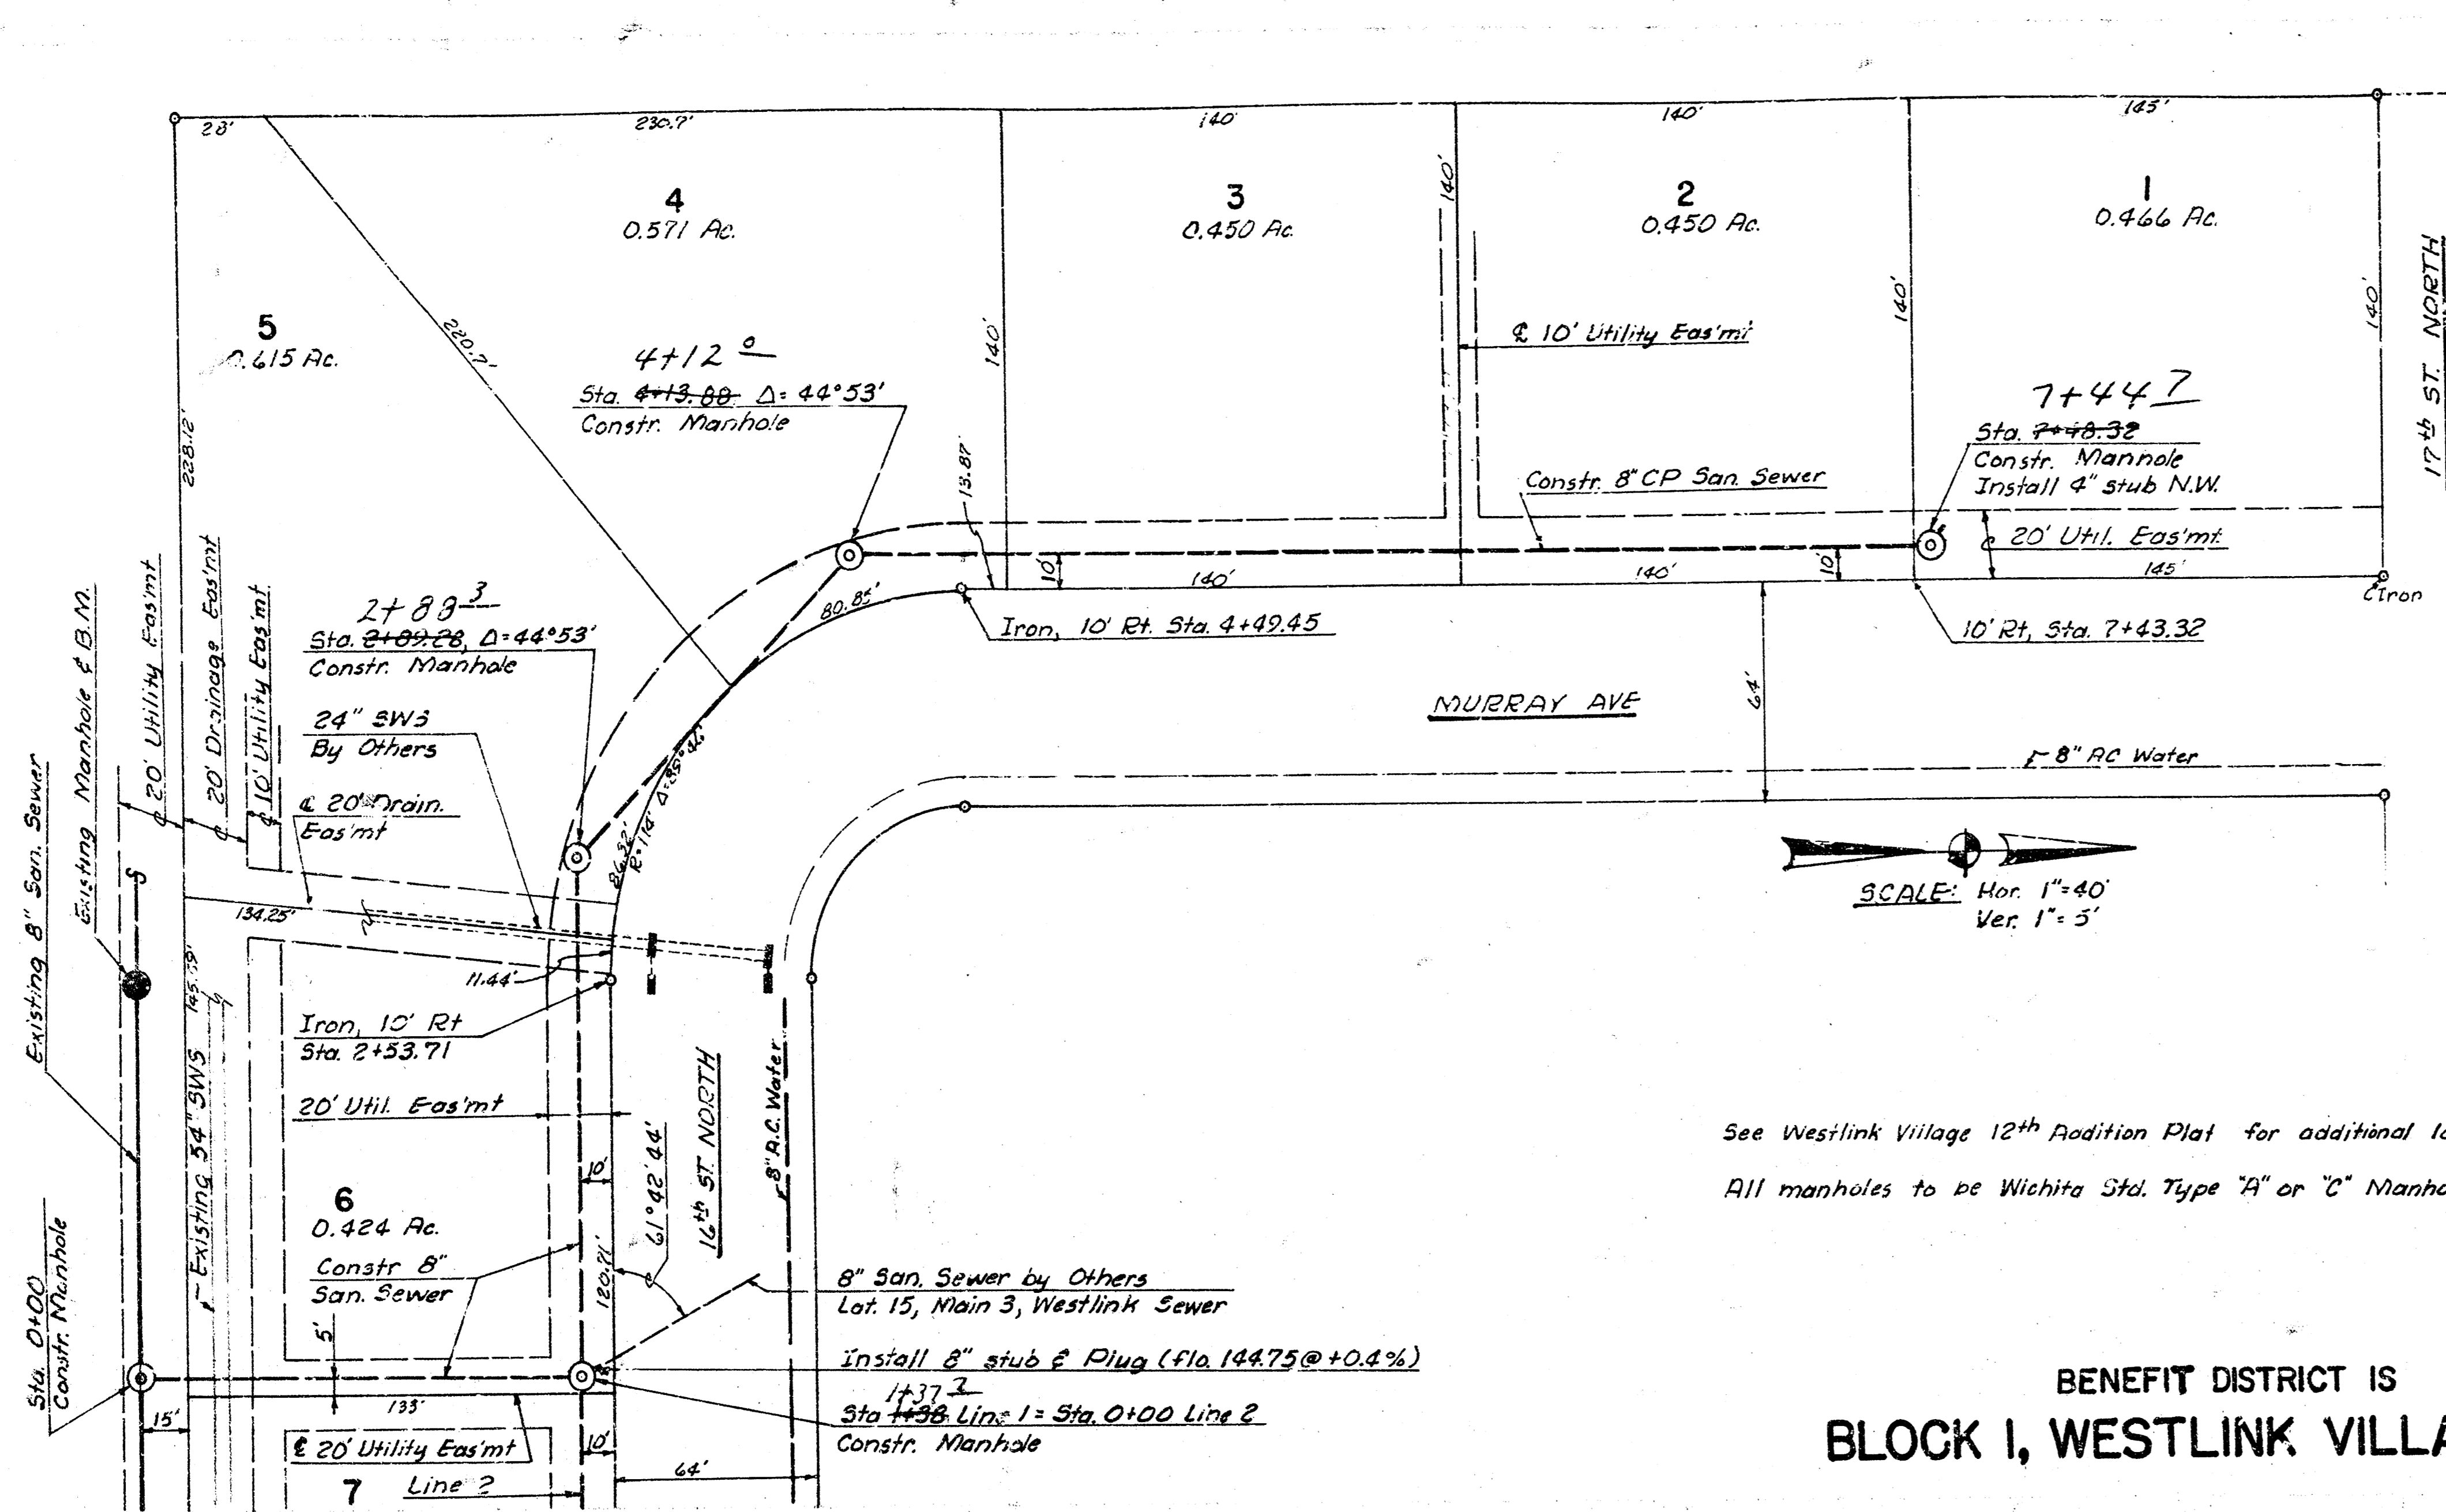

See Westlink Village 12<sup>th</sup> Addition Plat for additional layout information.  
All manholes to be Wichita Std. Type "A" or "C" Manholes.

### BENEFIT DISTRICT IS BLOCK I, WESTLINK VILLAGE TWELFTH ADDITION

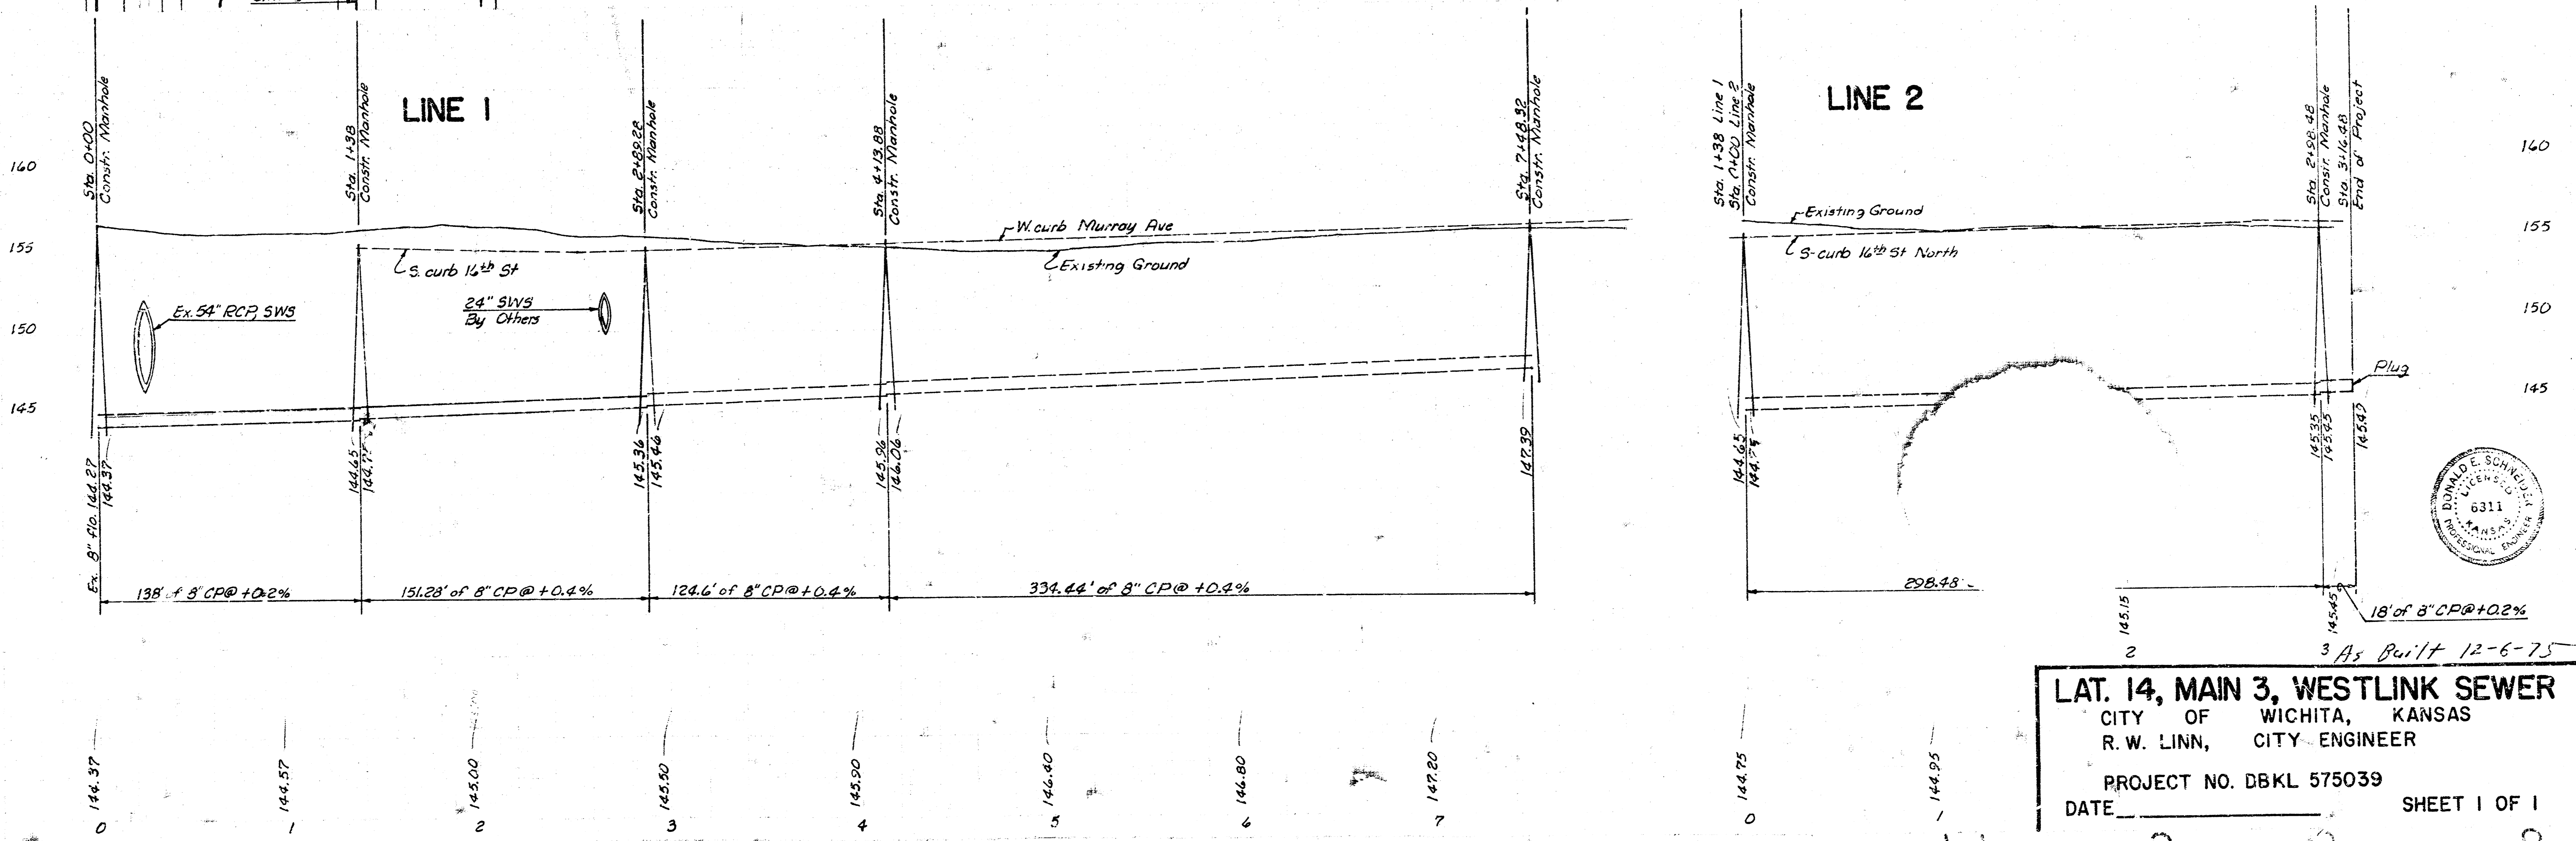

**LAT. 14, MAIN 3, WESTLINK SEWER**  
 CITY OF WICHITA, KANSAS  
 R. W. LINN, CITY ENGINEER  
 PROJECT NO. DBKL 575039  
 DATE \_\_\_\_\_ SHEET 1 OF 1

8 12 8