


JFG, 184 (LES 2)
WSK

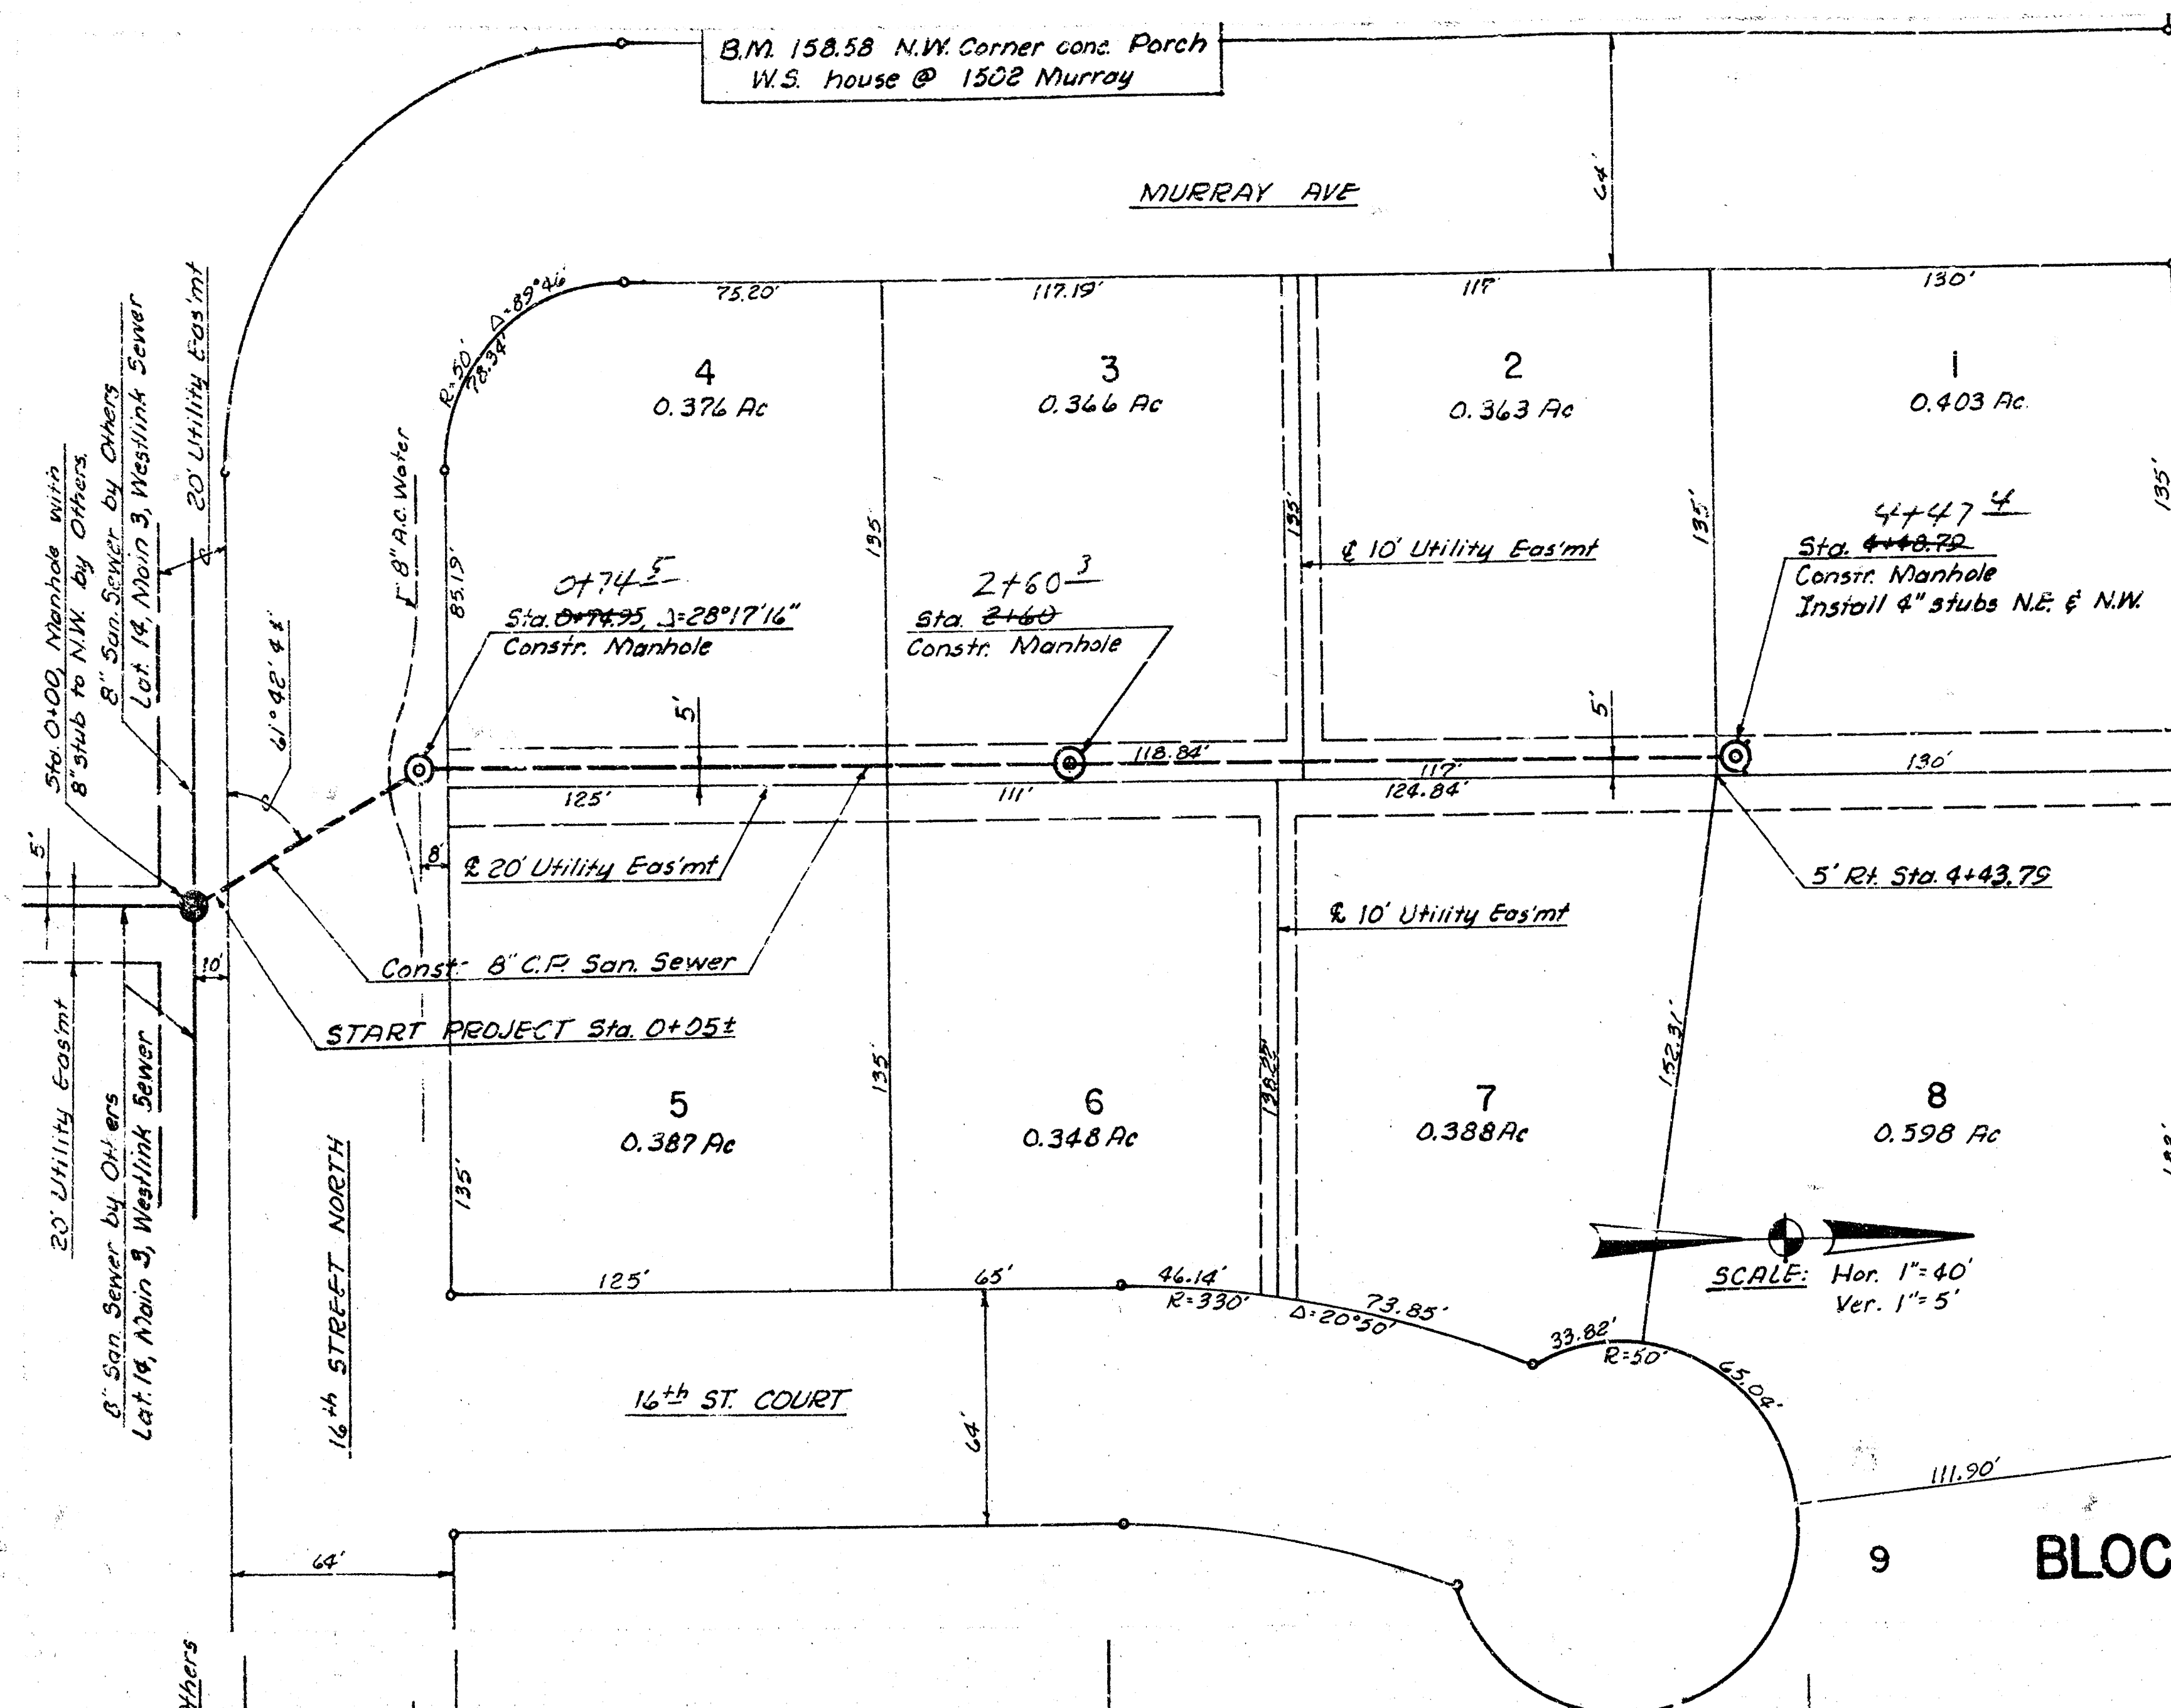

BENEFIT DISTRICT IS
BLOCK 2, WESTLINK VILLAGE TWELFTH ADDITION

