



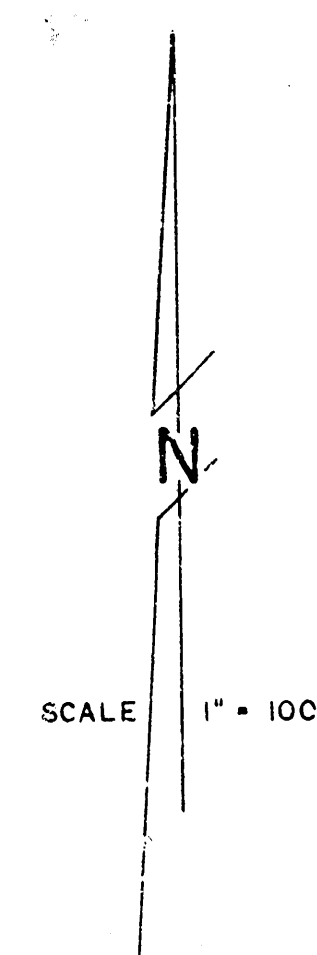


City of WICHITA, KANSAS Dean Sellers — City Engineer

Project No. 468.76.245.80206.000.000.001

Date : _____

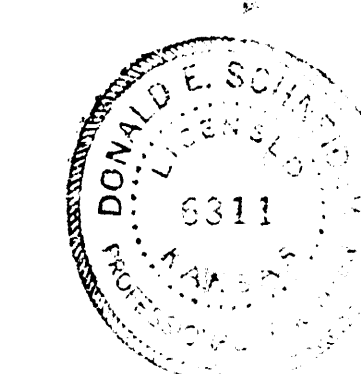


5806 JONATHAN ROAD 10 19
W3/11

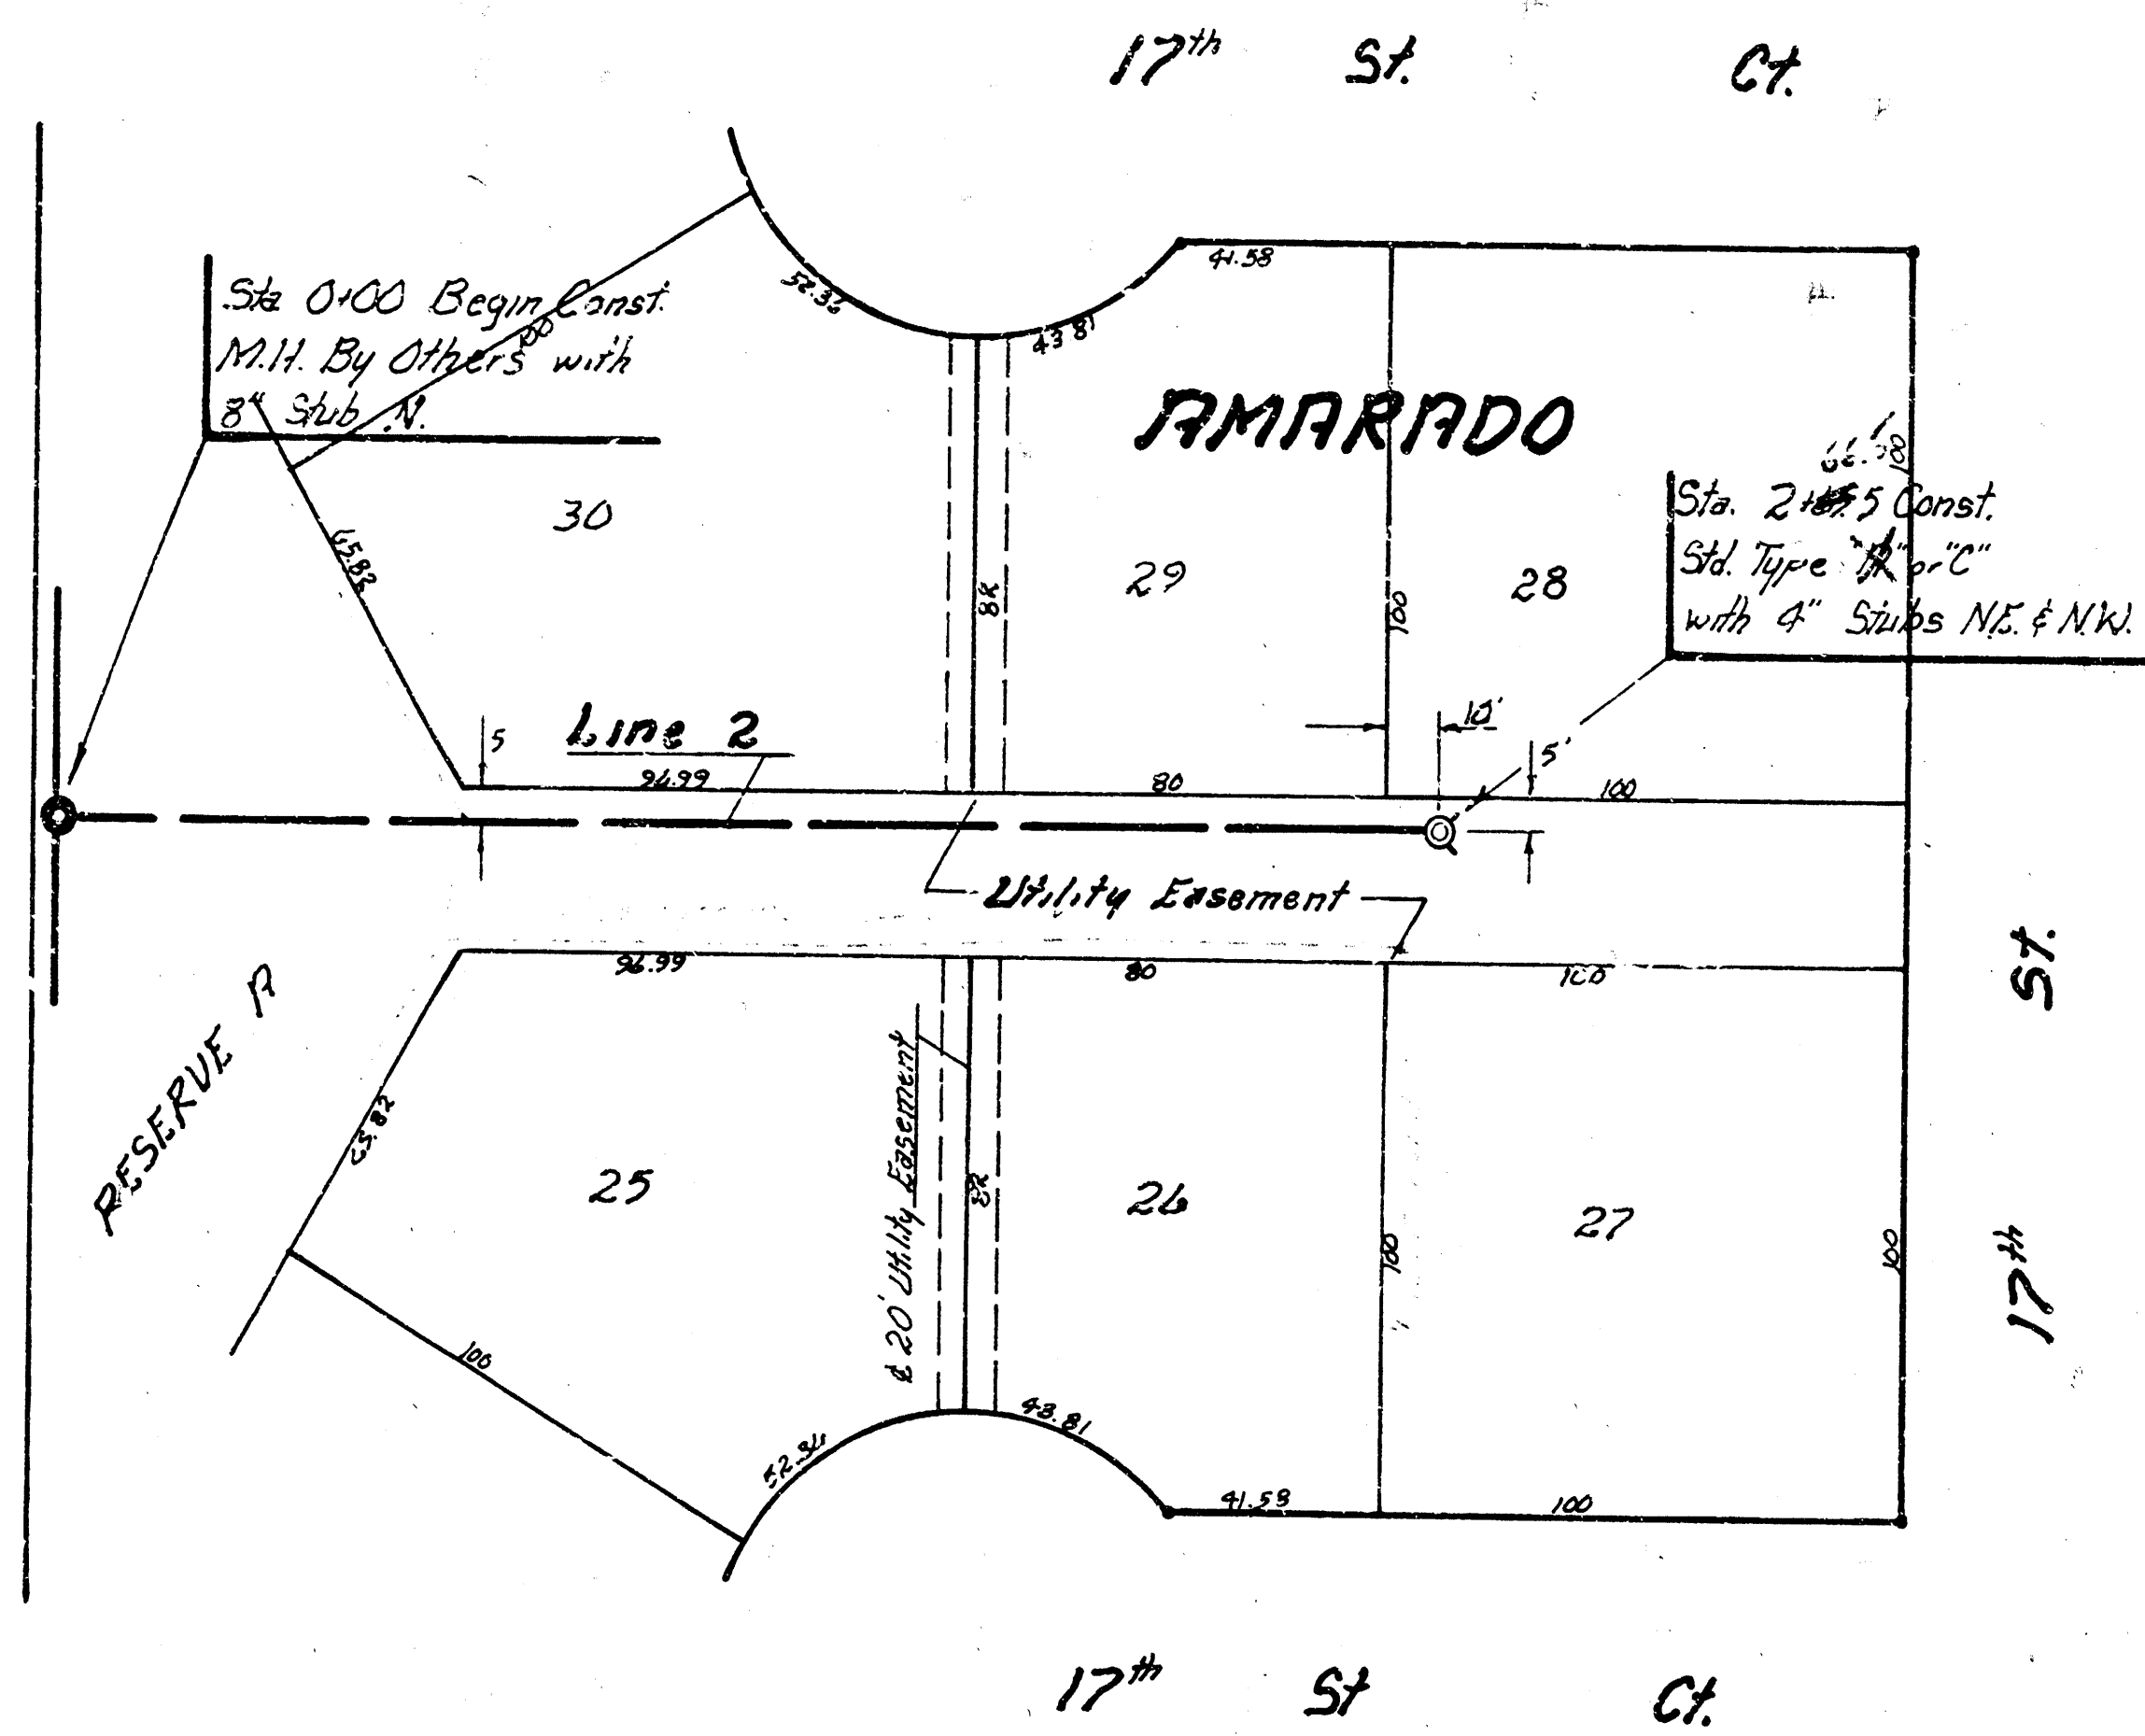

Sta 0+00 Begin Const.
M.H. By Others with
8" Stubs N.

Sta 2+65 Const.

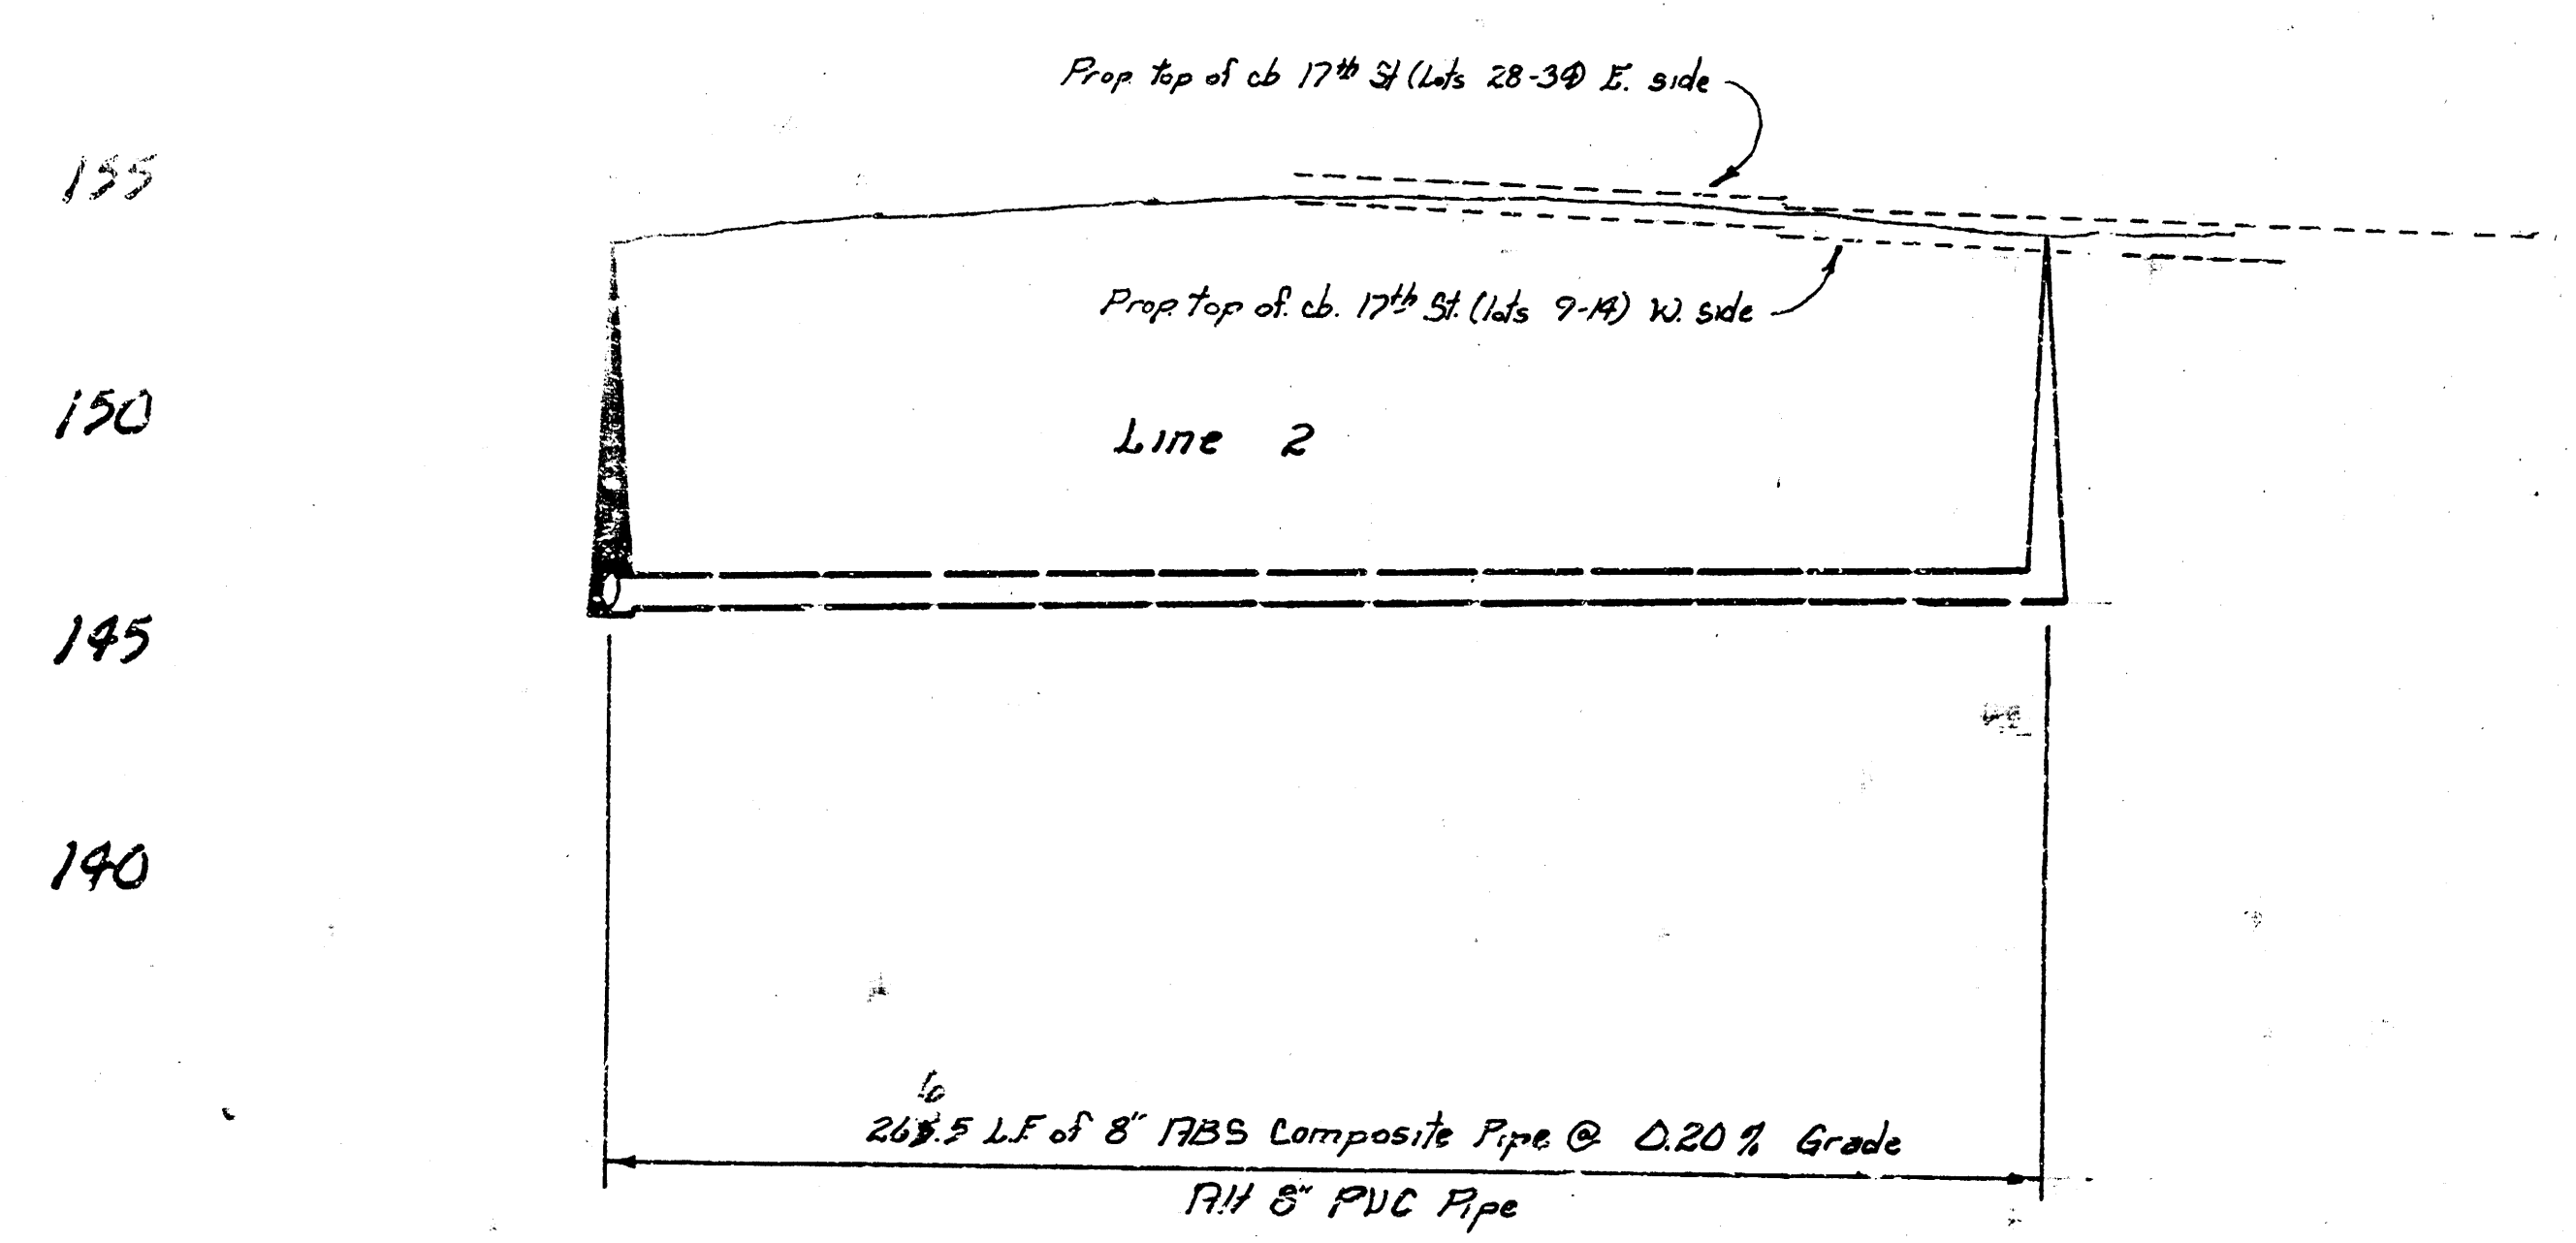


146.93 14 Out
147.03 14 In

147.23


147.63

147.56

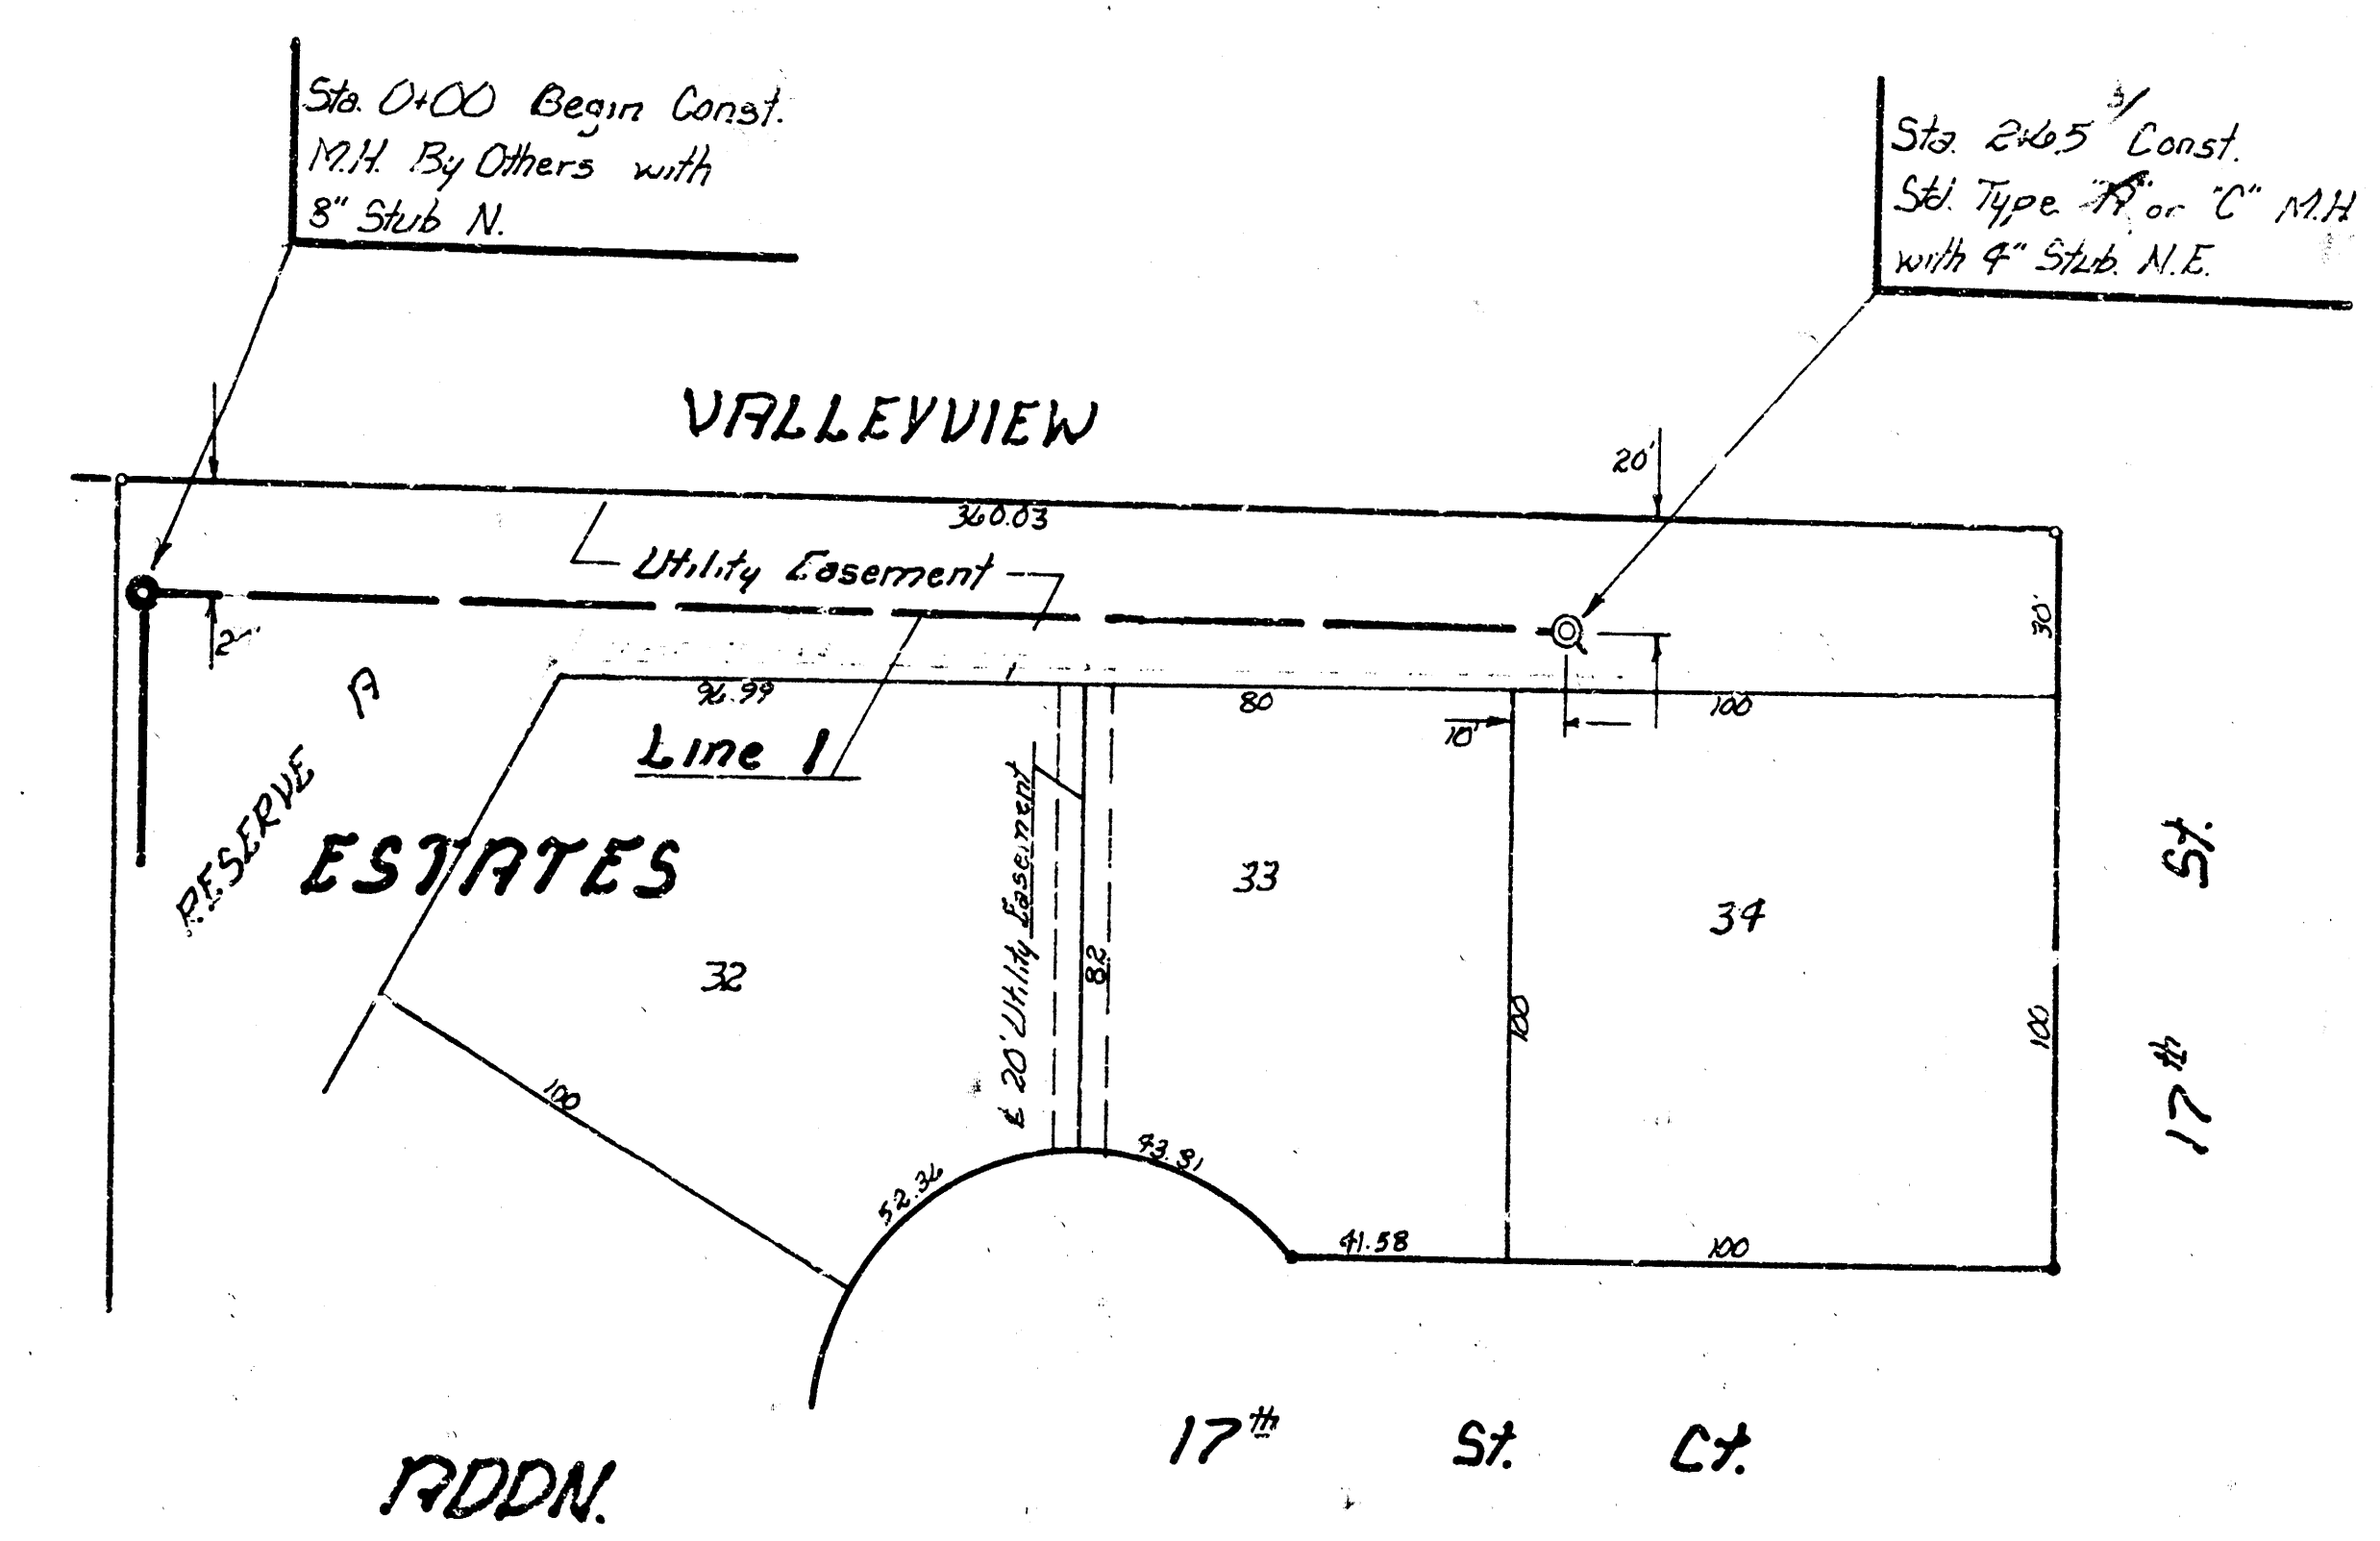

Sta 0+00 Begin Const.
M.H. By Others with
8" Stubs N.

Sta 2+65 Const.

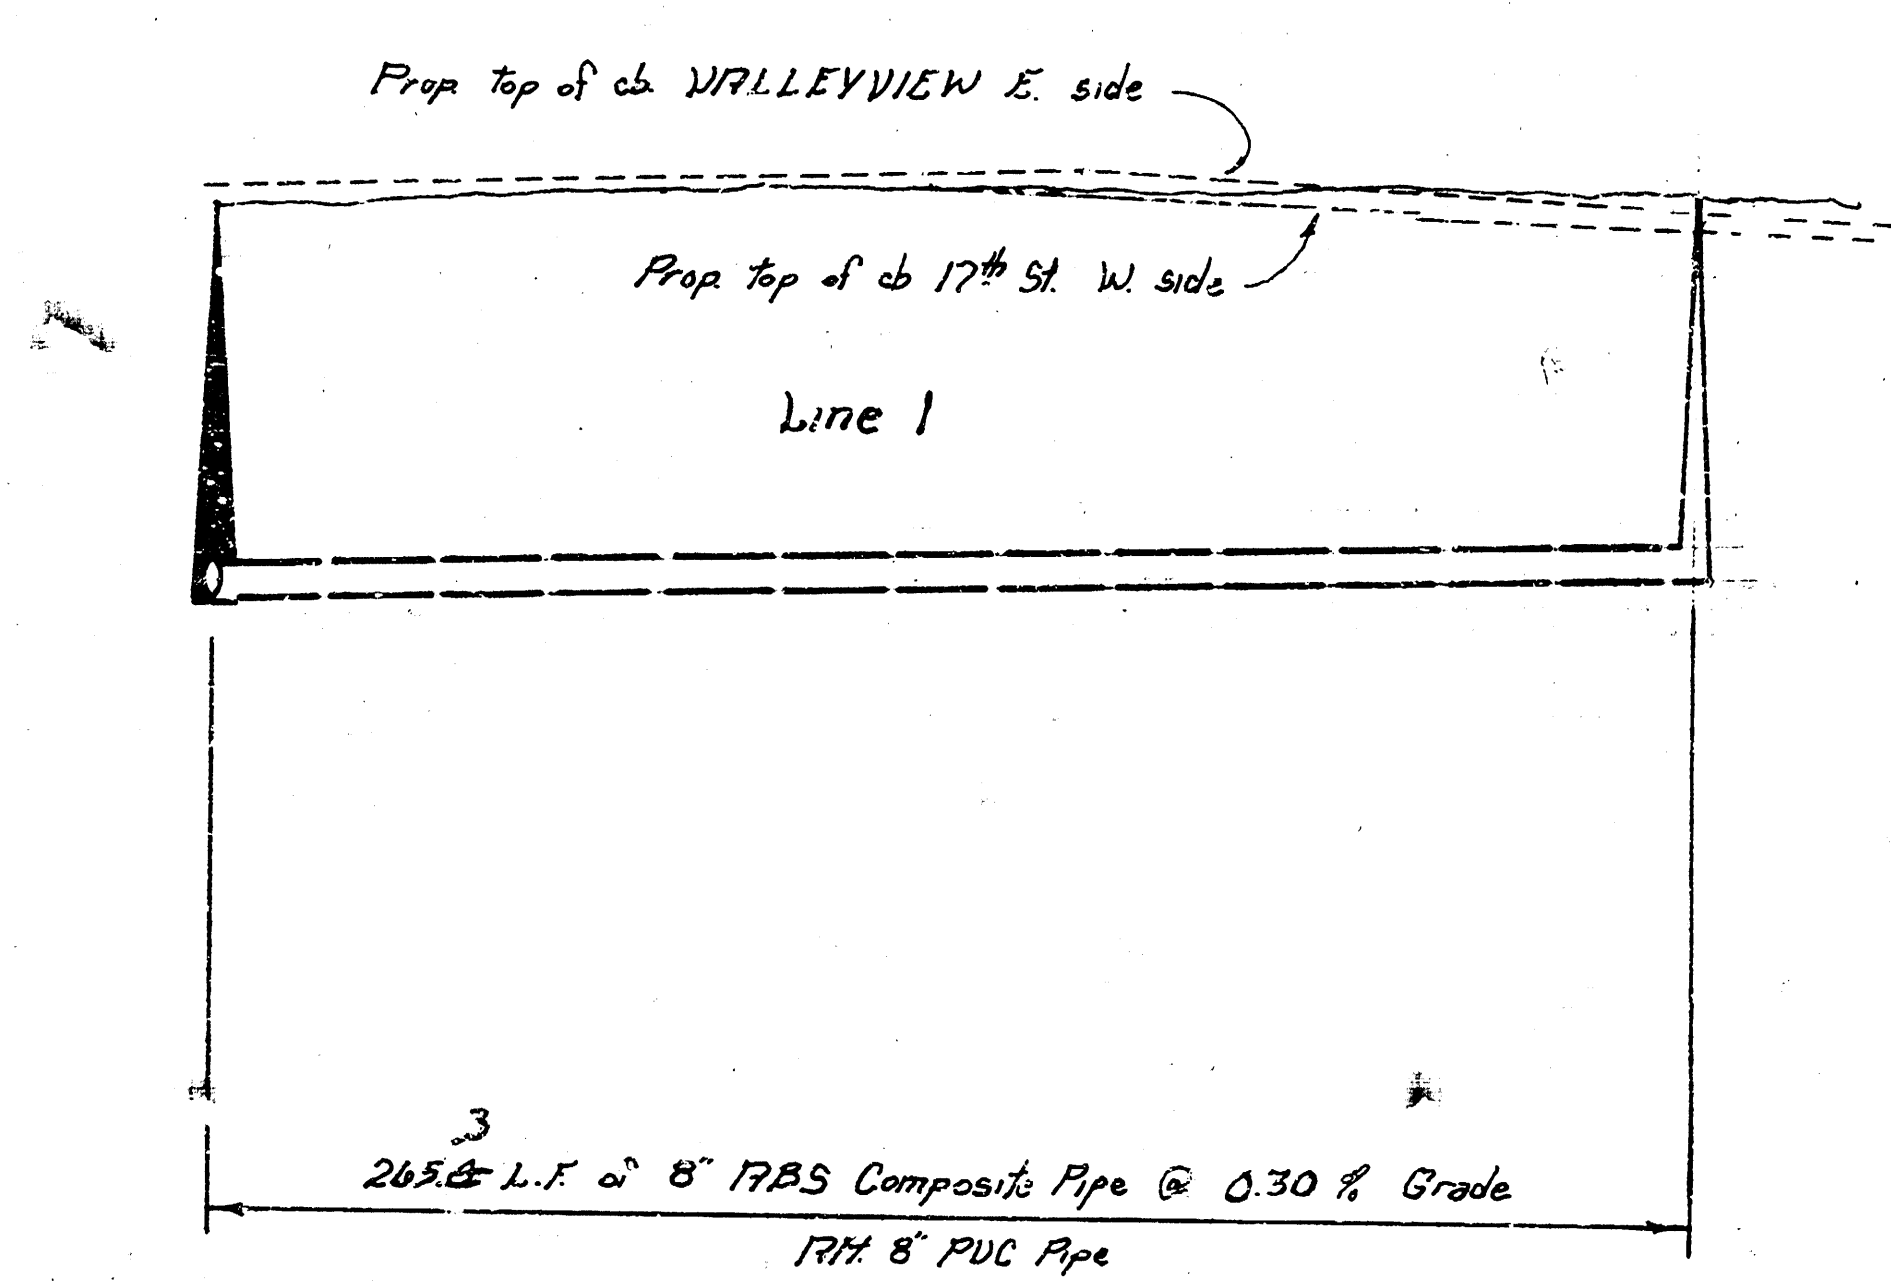

142.78 14 Out
147.98 14 In

148.18

148.68

148.08 14 In







SCALE

Plan 1" = 20'


Profile 1" = 5'

Horz 1" = 20'

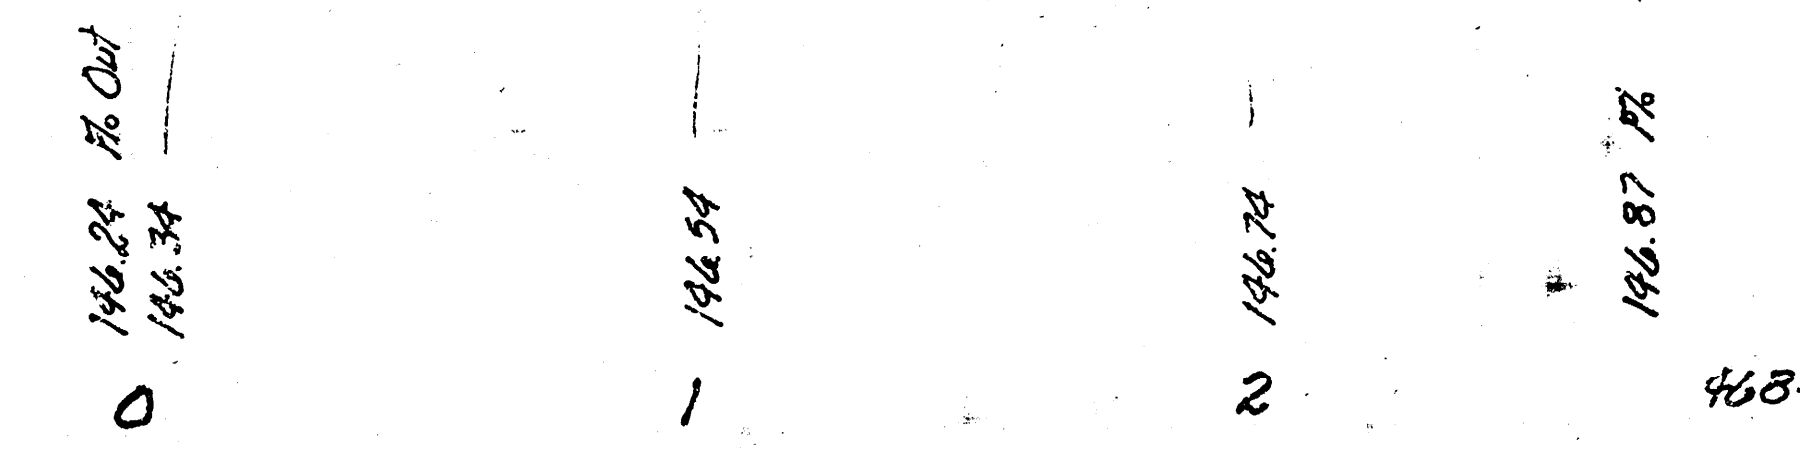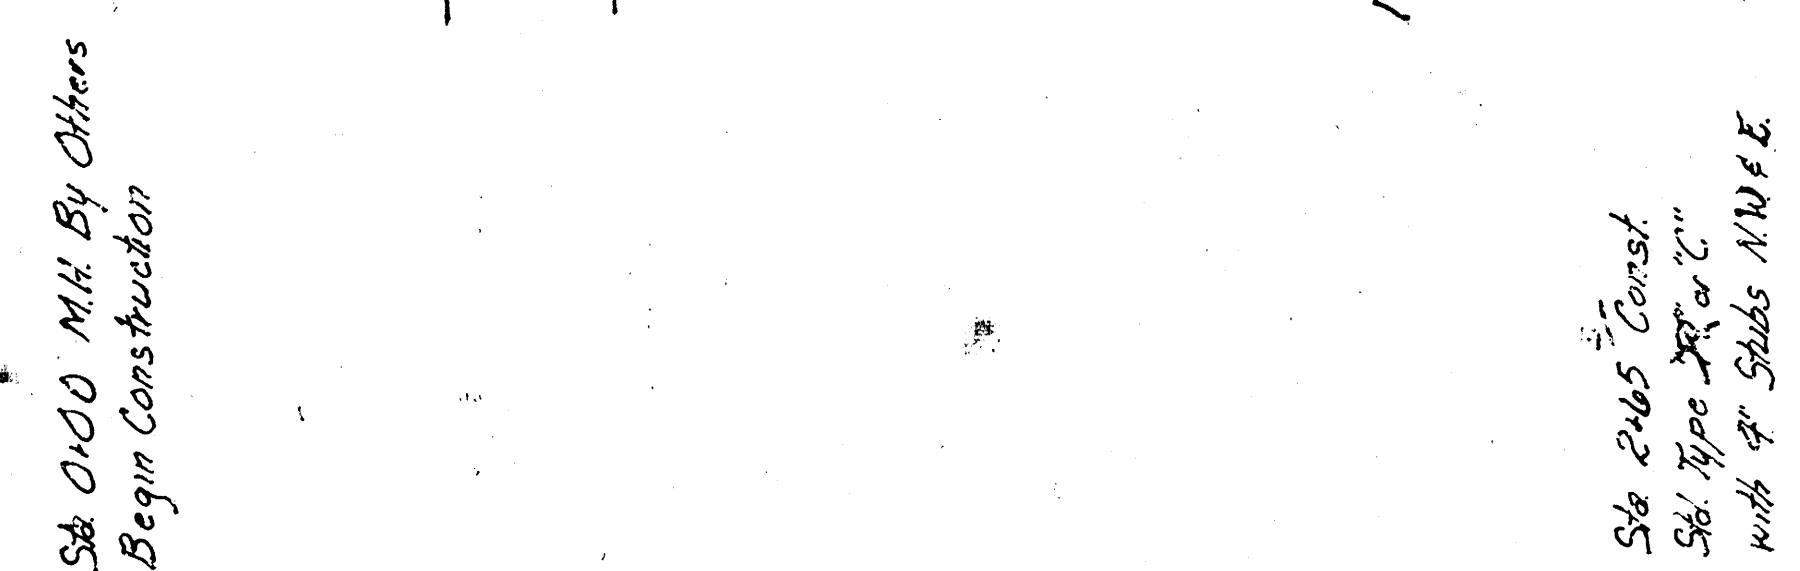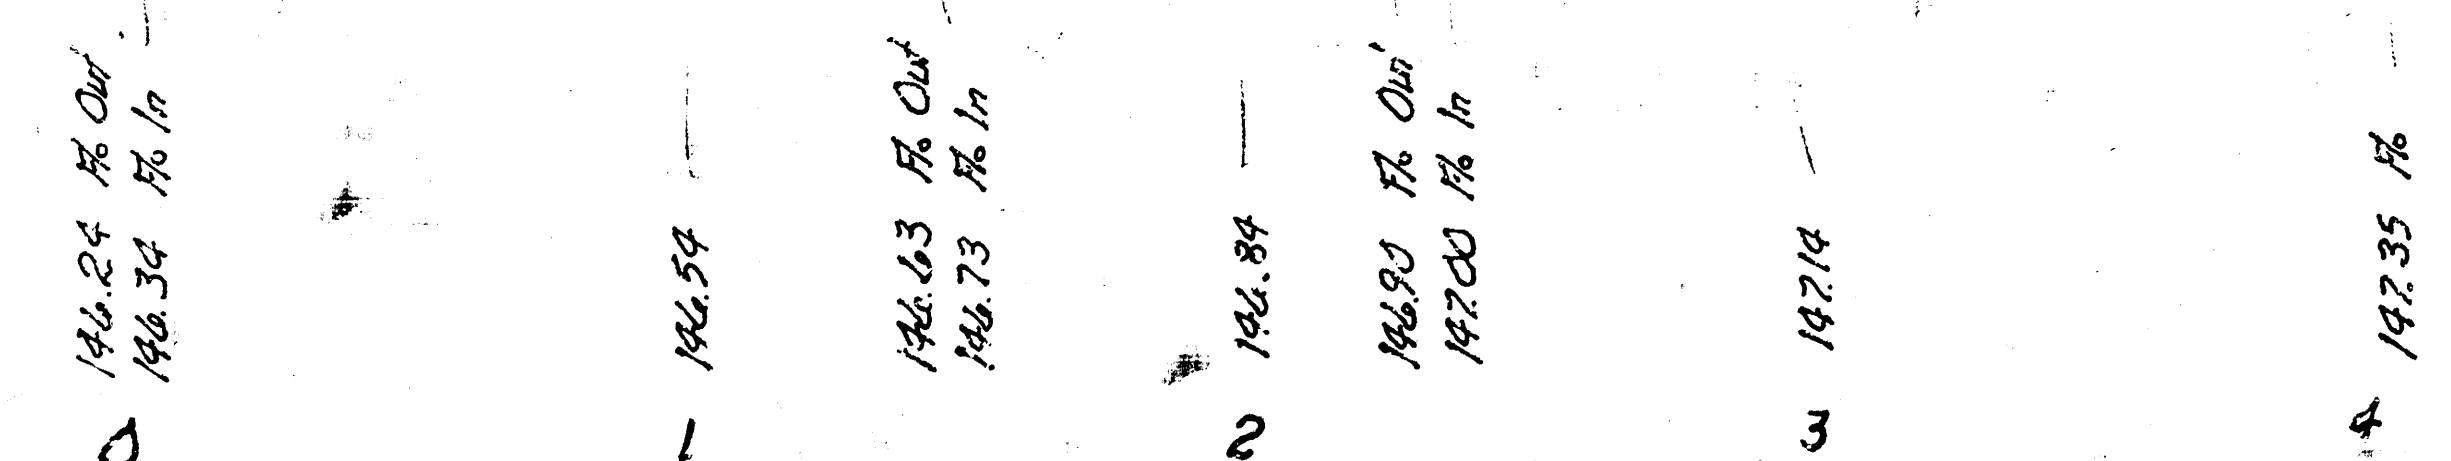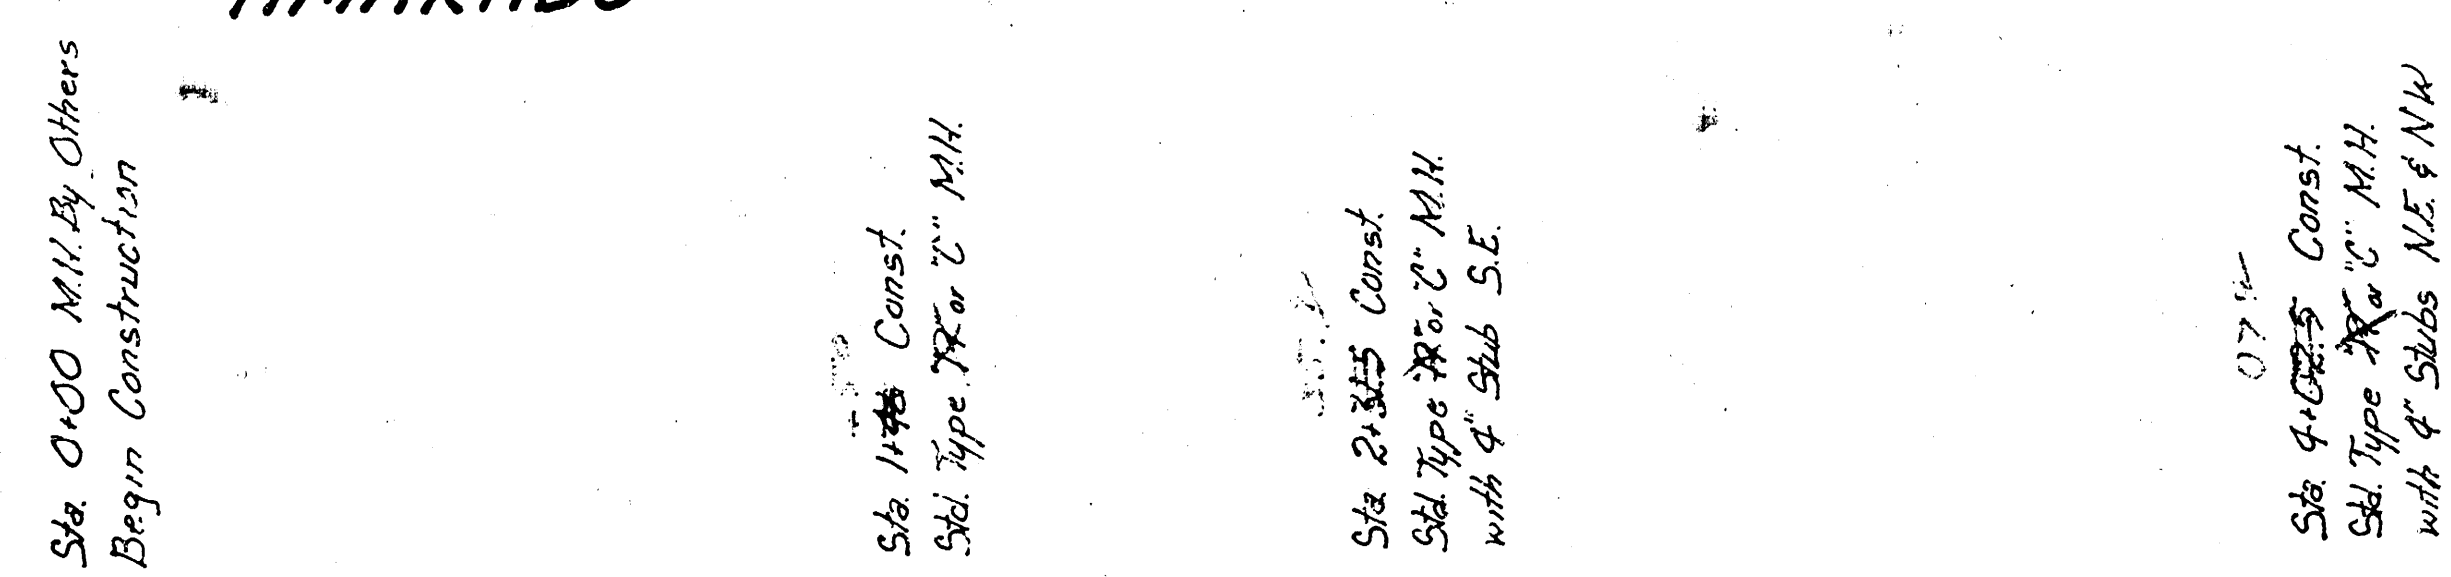

Plan	1" = 20'
Profile	
Vert	1" = 5'
Horz	1" = 20'

Sheet 3 of 4 $\frac{3}{4}$

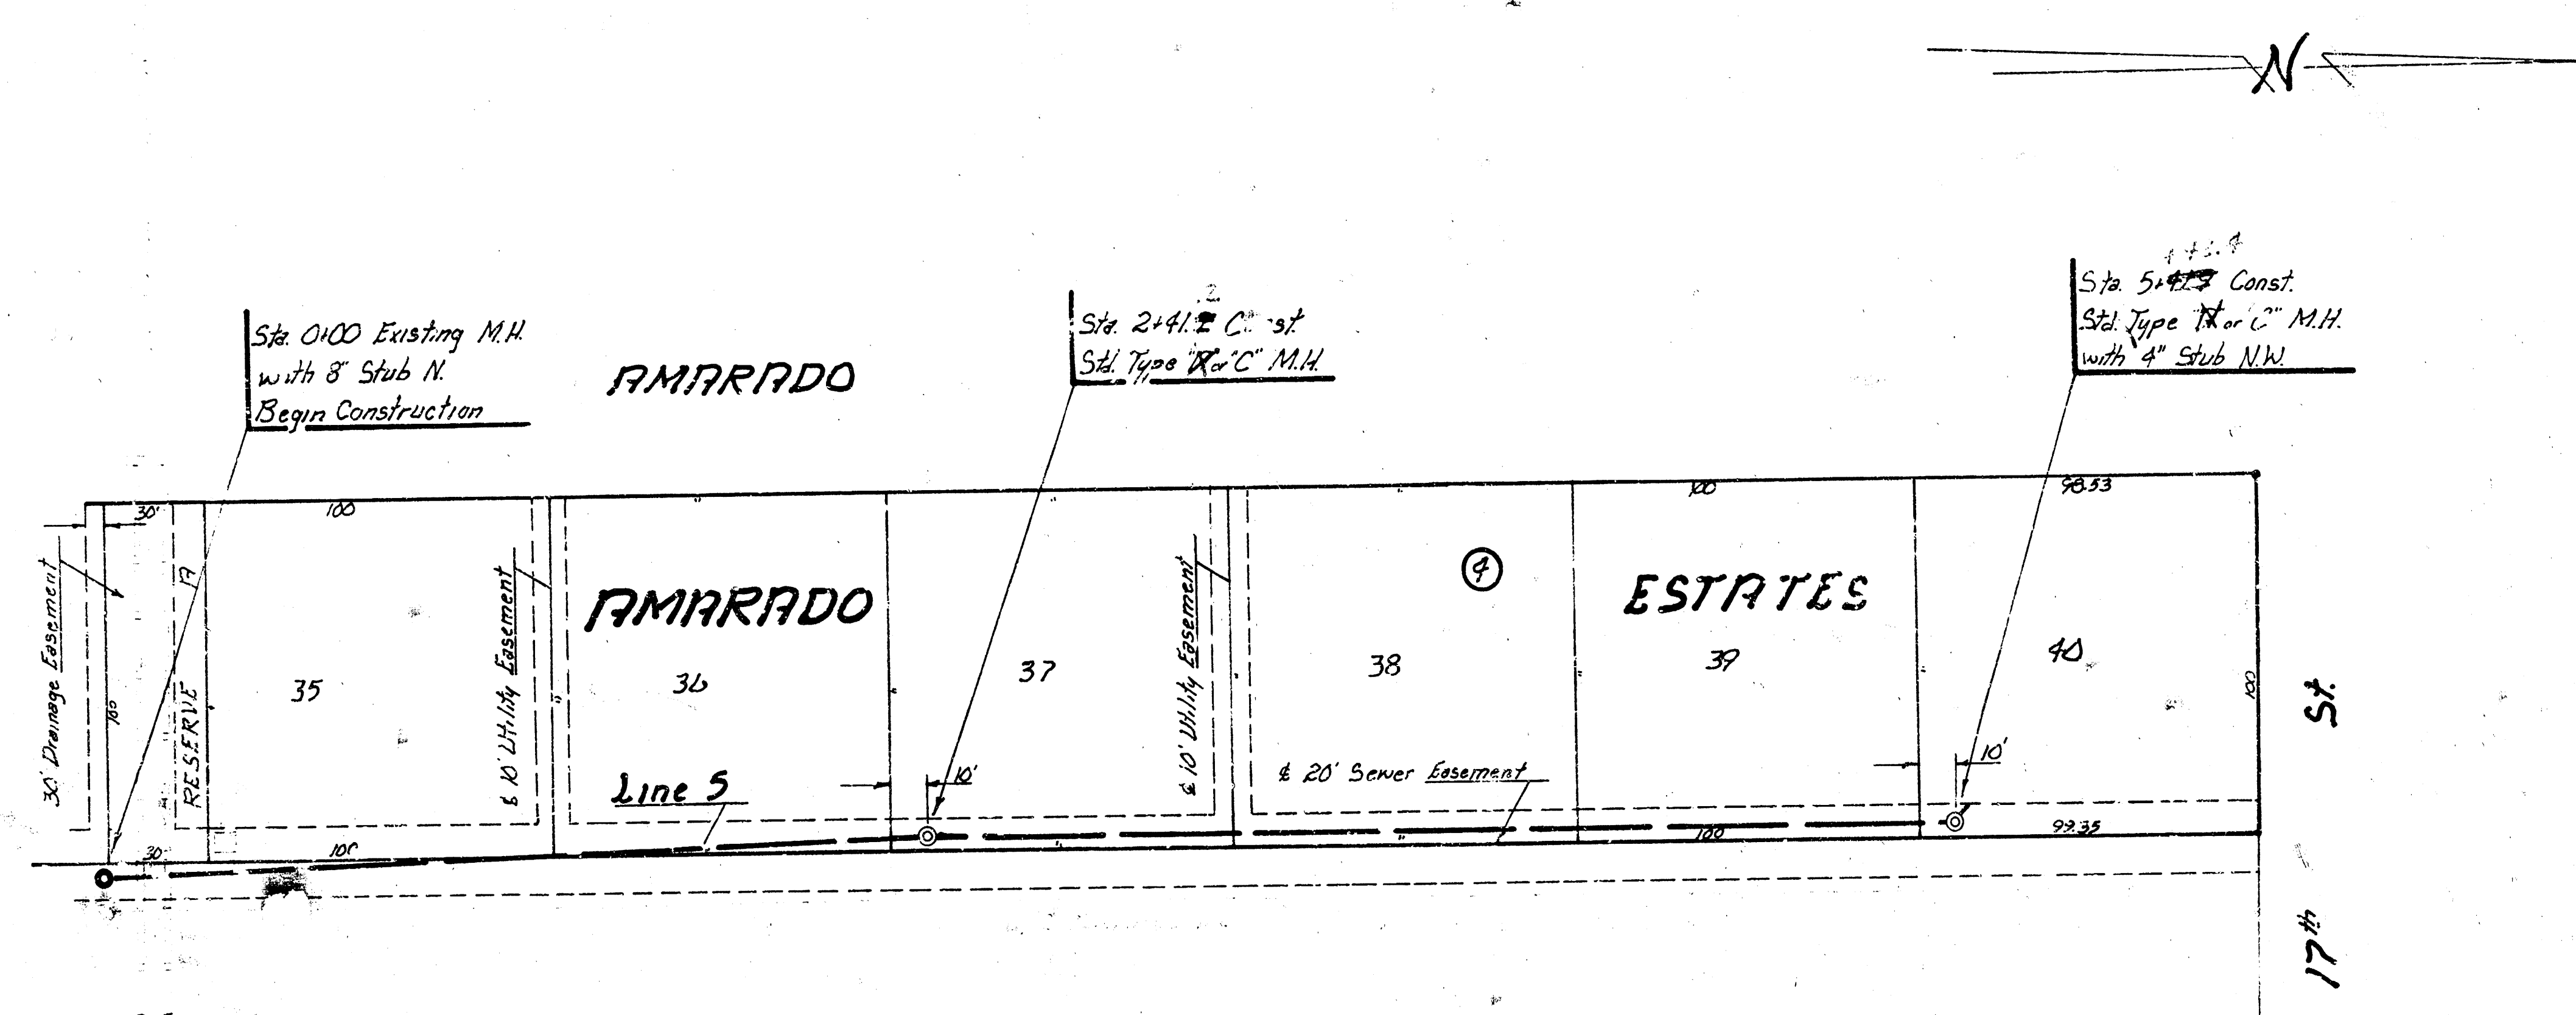

SCALE
 Plan 1" = 20'
 Profile 1" = 5'
 Vert 1" = 20'
 Horiz

