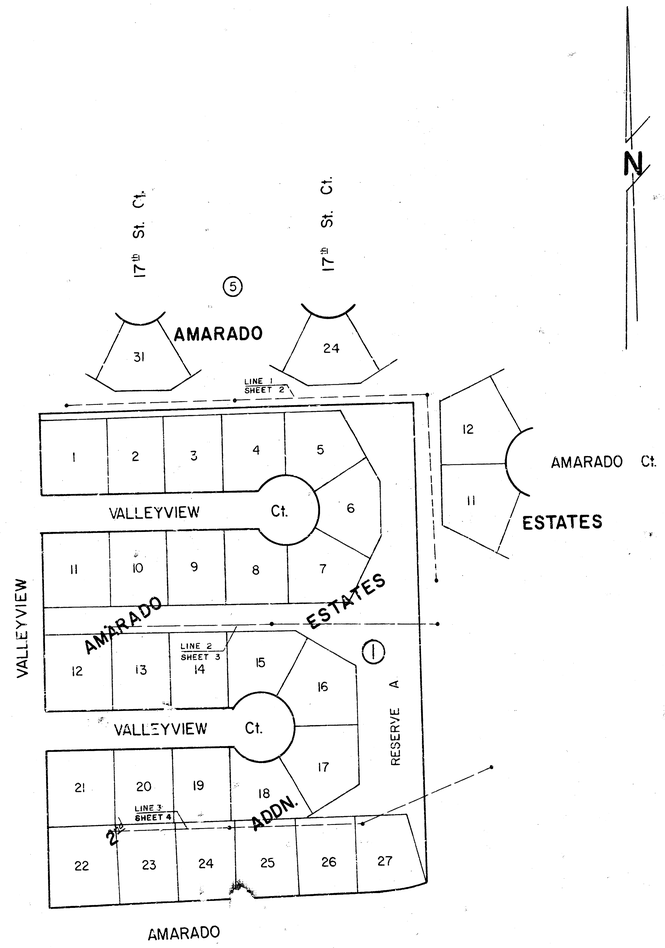

LATERAL 20, MAIN 3, WESTLINK SEWER

City of WICHITA, KANSAS Dean Sellers — City Engineer

Project No. : 468-76-245-80815-000-000-001

Date : _____

DONALD E. SCHMITT 6311

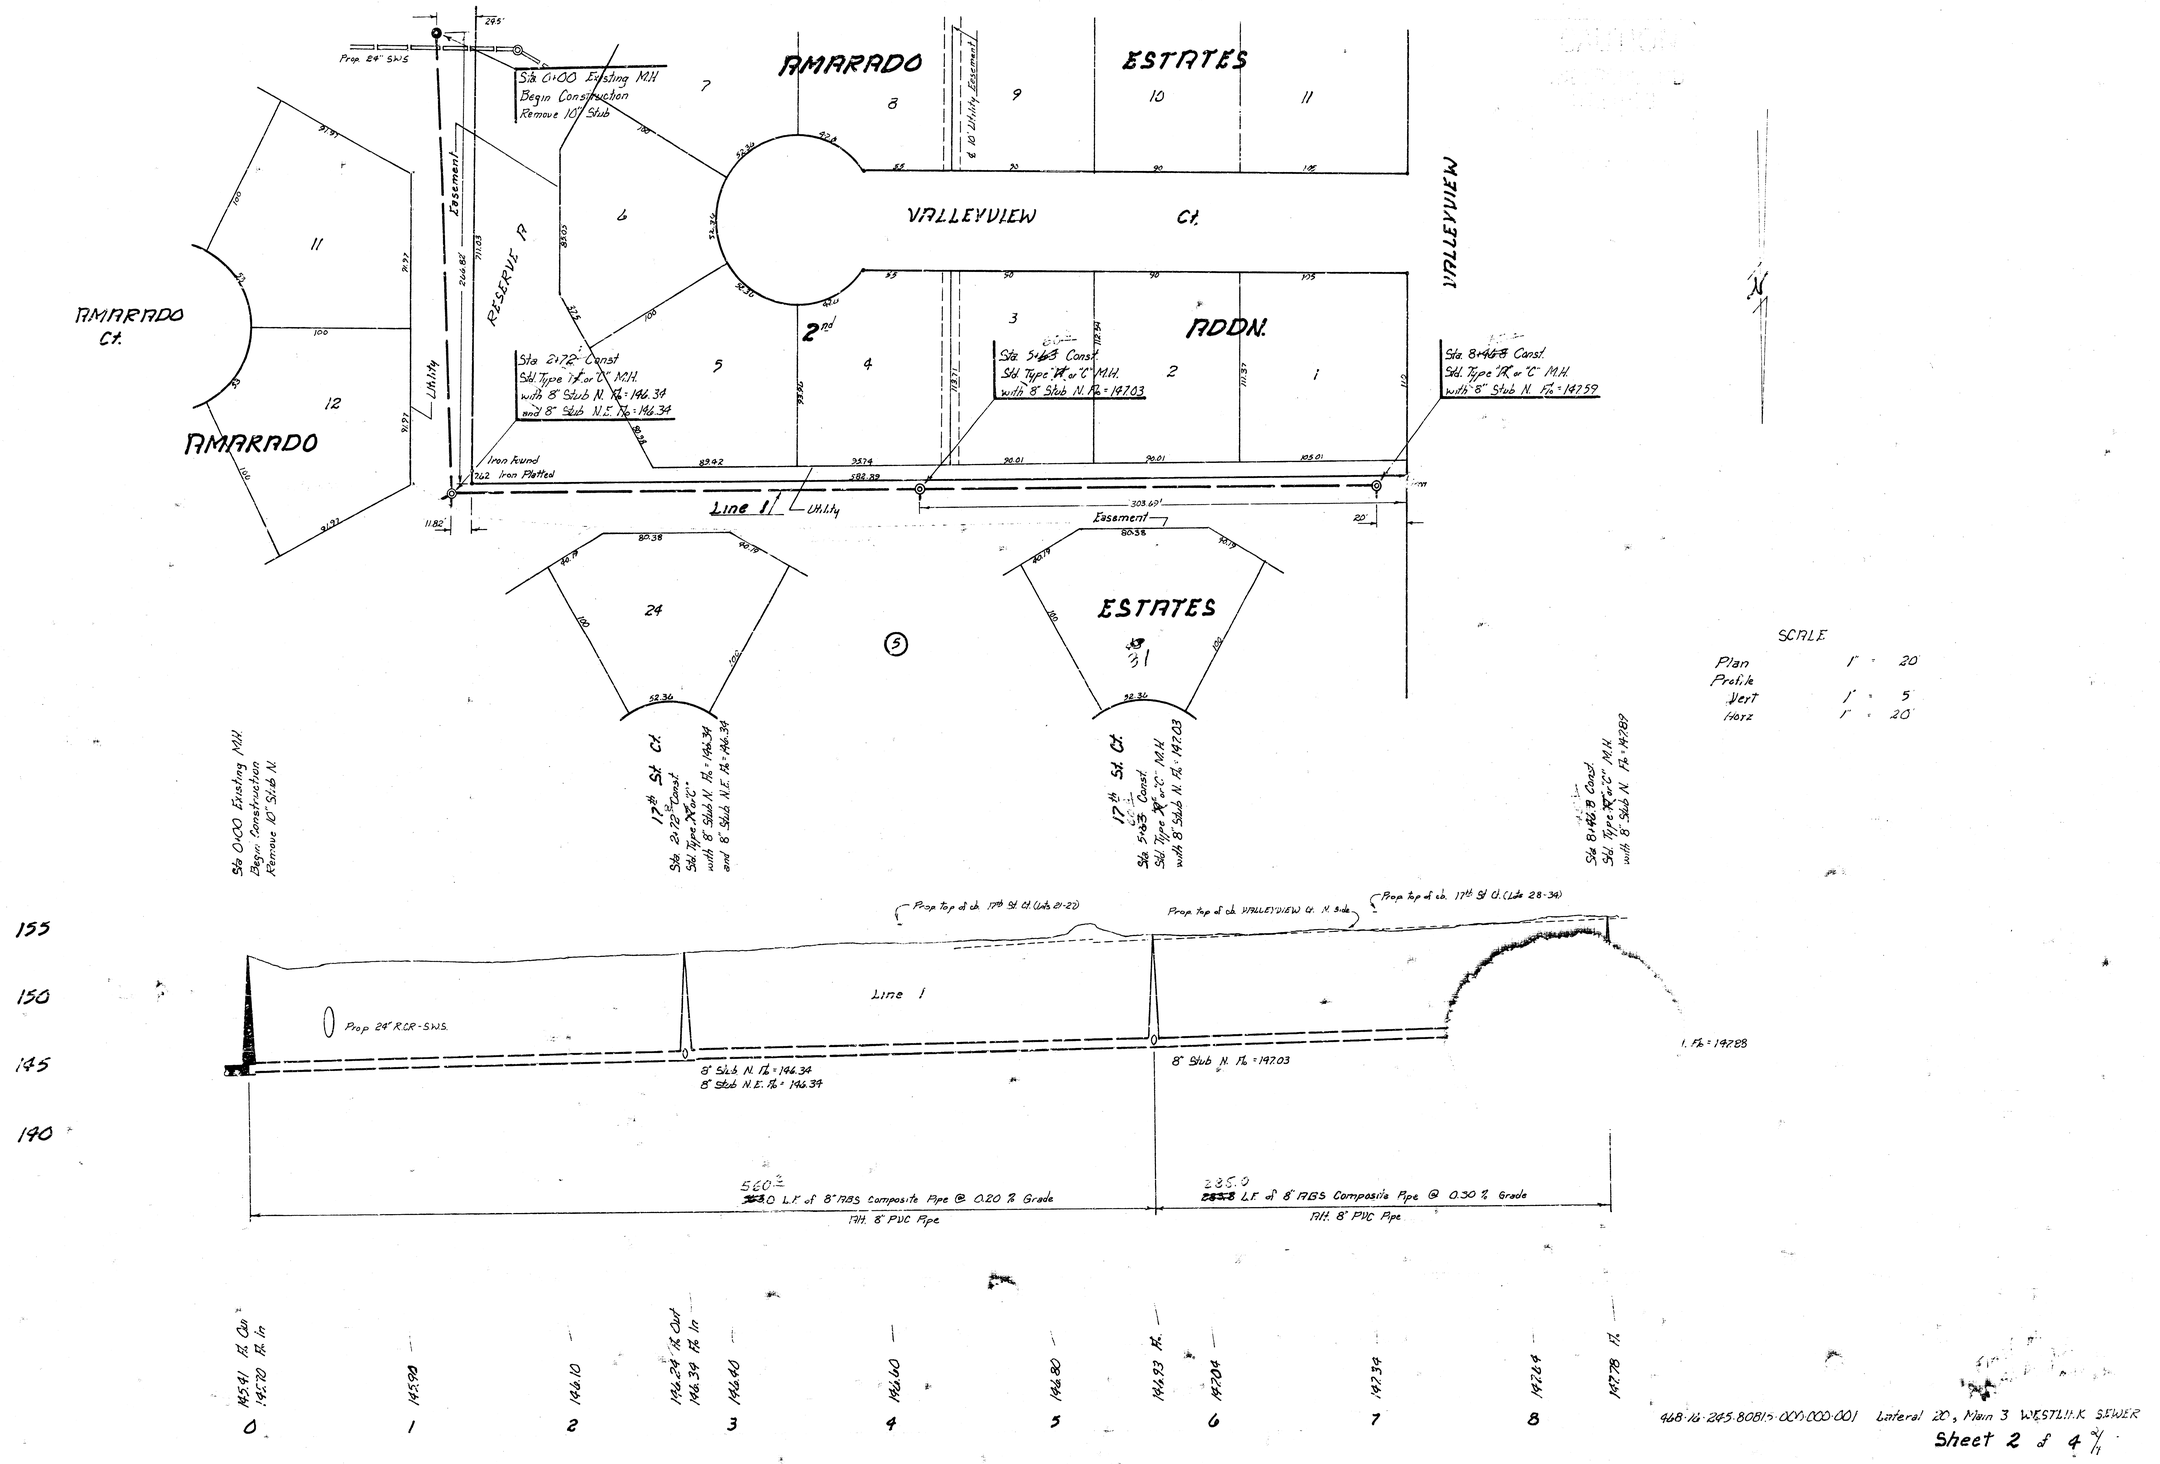

SCALE

Plan	1" =	20'
Profile		
Vert	1" =	5'
Horz	1" =	20'

468-16-245-80815-000-000-001 Lateral 20, Main 3 WESTLINK SEWER

Sheet 2 of 4 2/1

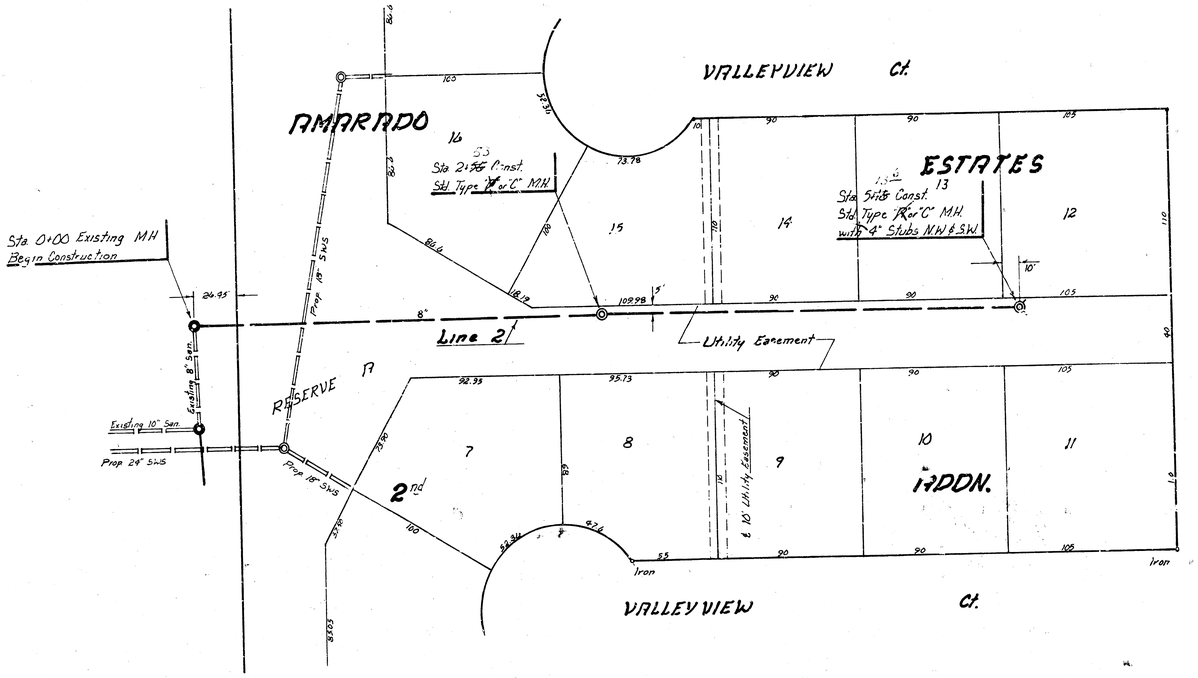

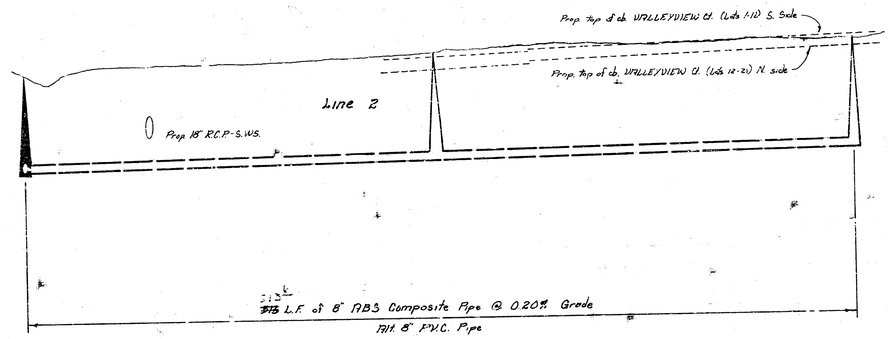

SCALE

Plan	1" = 20'
Profile	
Vert	1" = 5'
Horz	1" = 20'

468-26-245-808/5-000-000-001 Lateral 20, Main 3 WESTLINK SEWER

Sheet 3 of 4 31

NOTE: CONTRACTOR SHALL GIVE [illegible] S OF LOTS 2 & 4 A MINIMUM ADVANCE NOTICE OF 48 HOURS PRIOR TO BEGINNING CONSTRUCTION ON LINE NO. 3. CONTRACTOR WILL BE REQUIRED TO RESTORE ANY IMPROVEMENTS OR VEGETATION DISTURBED ON THESE LOTS TO A CONDITION EQUAL TO OR BETTER THAN THE ORIGINAL CONDITION. THIS WORK WILL BE PAID FOR AT THE LUMP SUM PRICE BID FOR SITE PREPARATION AND RESTORATION.

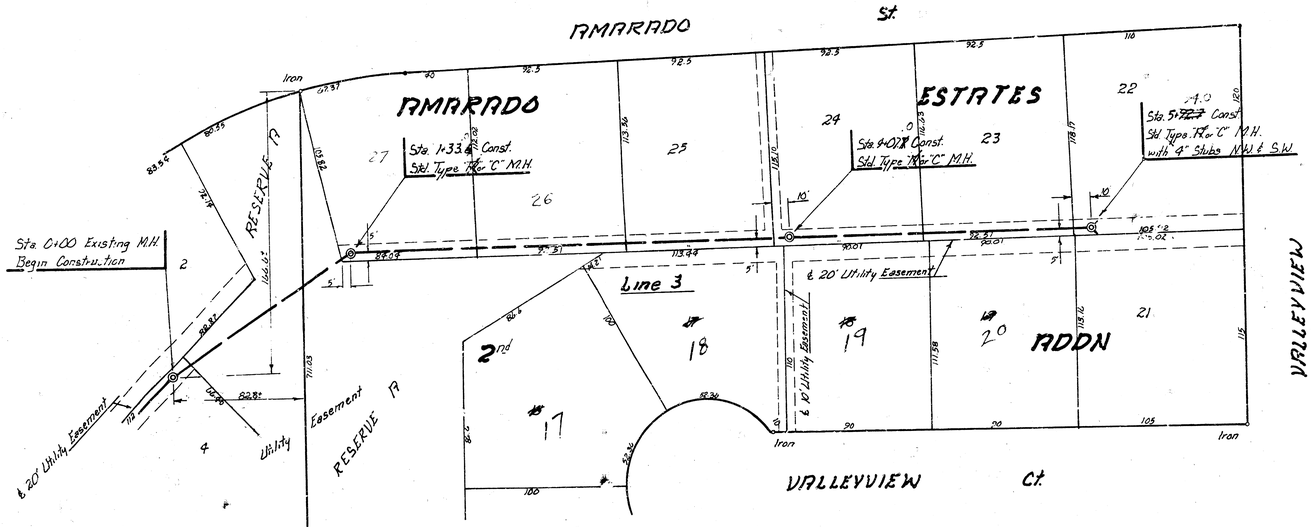

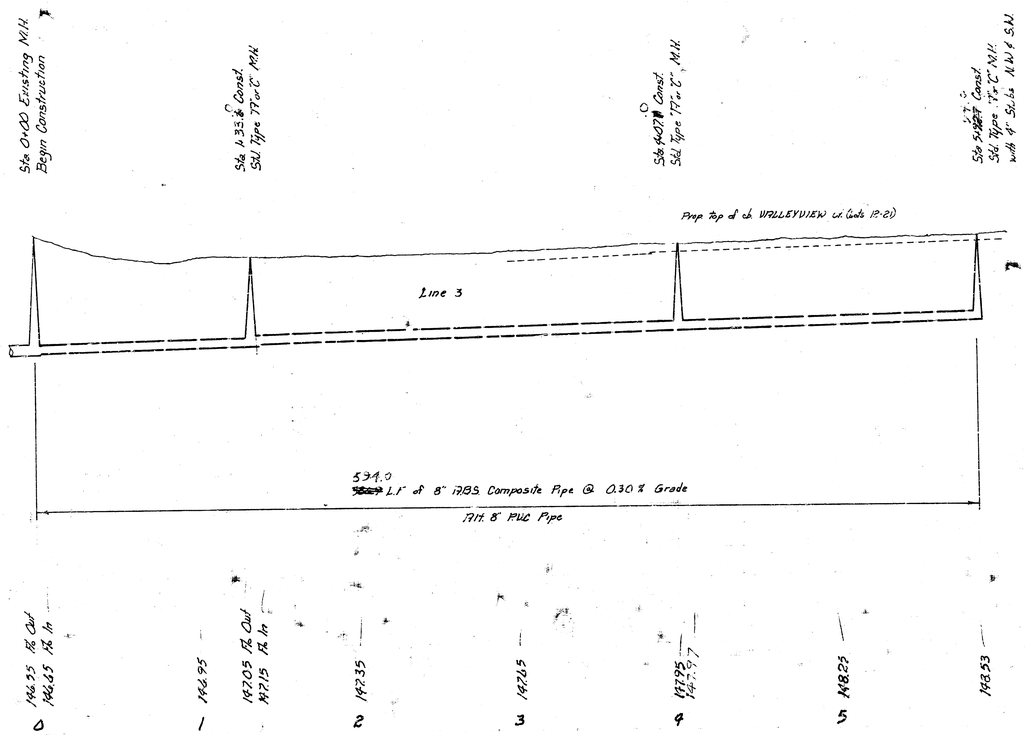

SCALE

Plan	1"	= 20'
Profile		
Vert	1"	= 5'
Horz	1"	= 20'

468.76.295.80815.000.000.001 Lateral 20, Main 3 WESTLINK SEWER

Sheet 4 of 4 7/1