

LATERAL 20, MAIN 3, WESTLINK SEWER


City of WICHITA, KANSAS Dean Sellers — City Engineer

Project No. : 468-76-245-80815-000-000-001

Date: _____




WJSL08
 12/17/19
 12/17/19

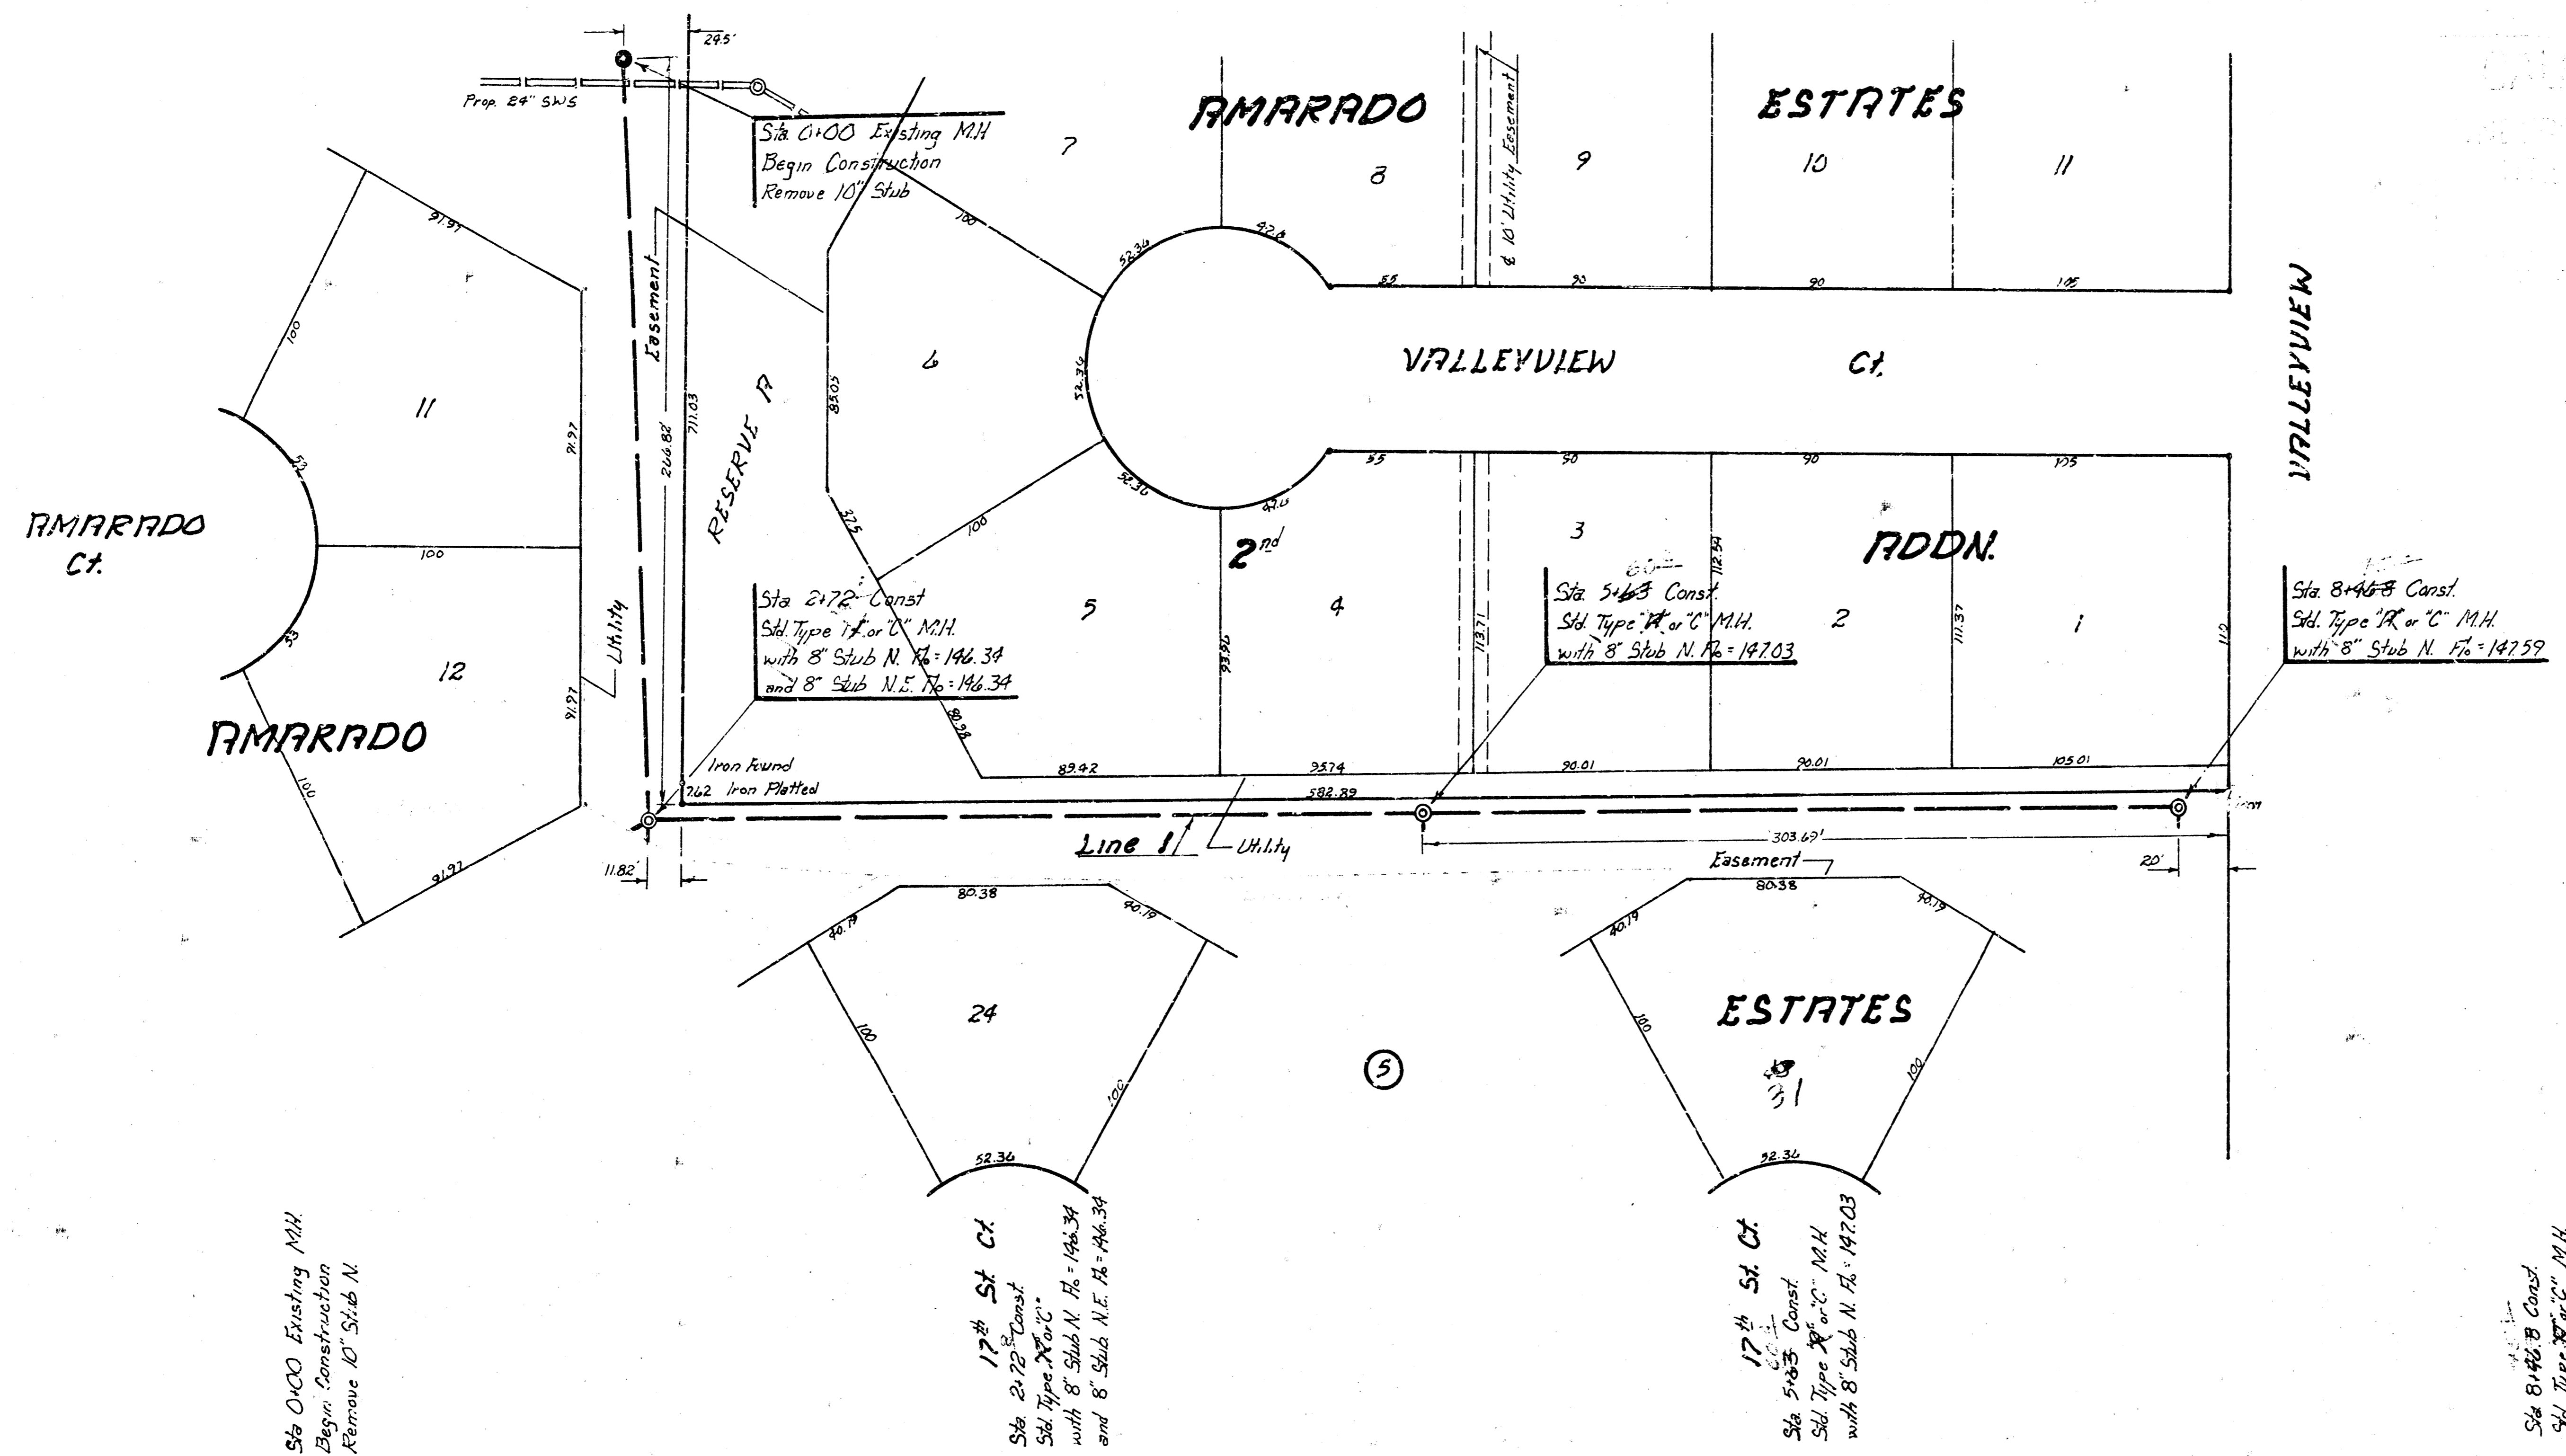


SCALE
 Plan 1" = 20'
 Profile 1" = 5'
 Vert 1" = 5'
 Horiz 1" = 20'

155
 150
 145
 140

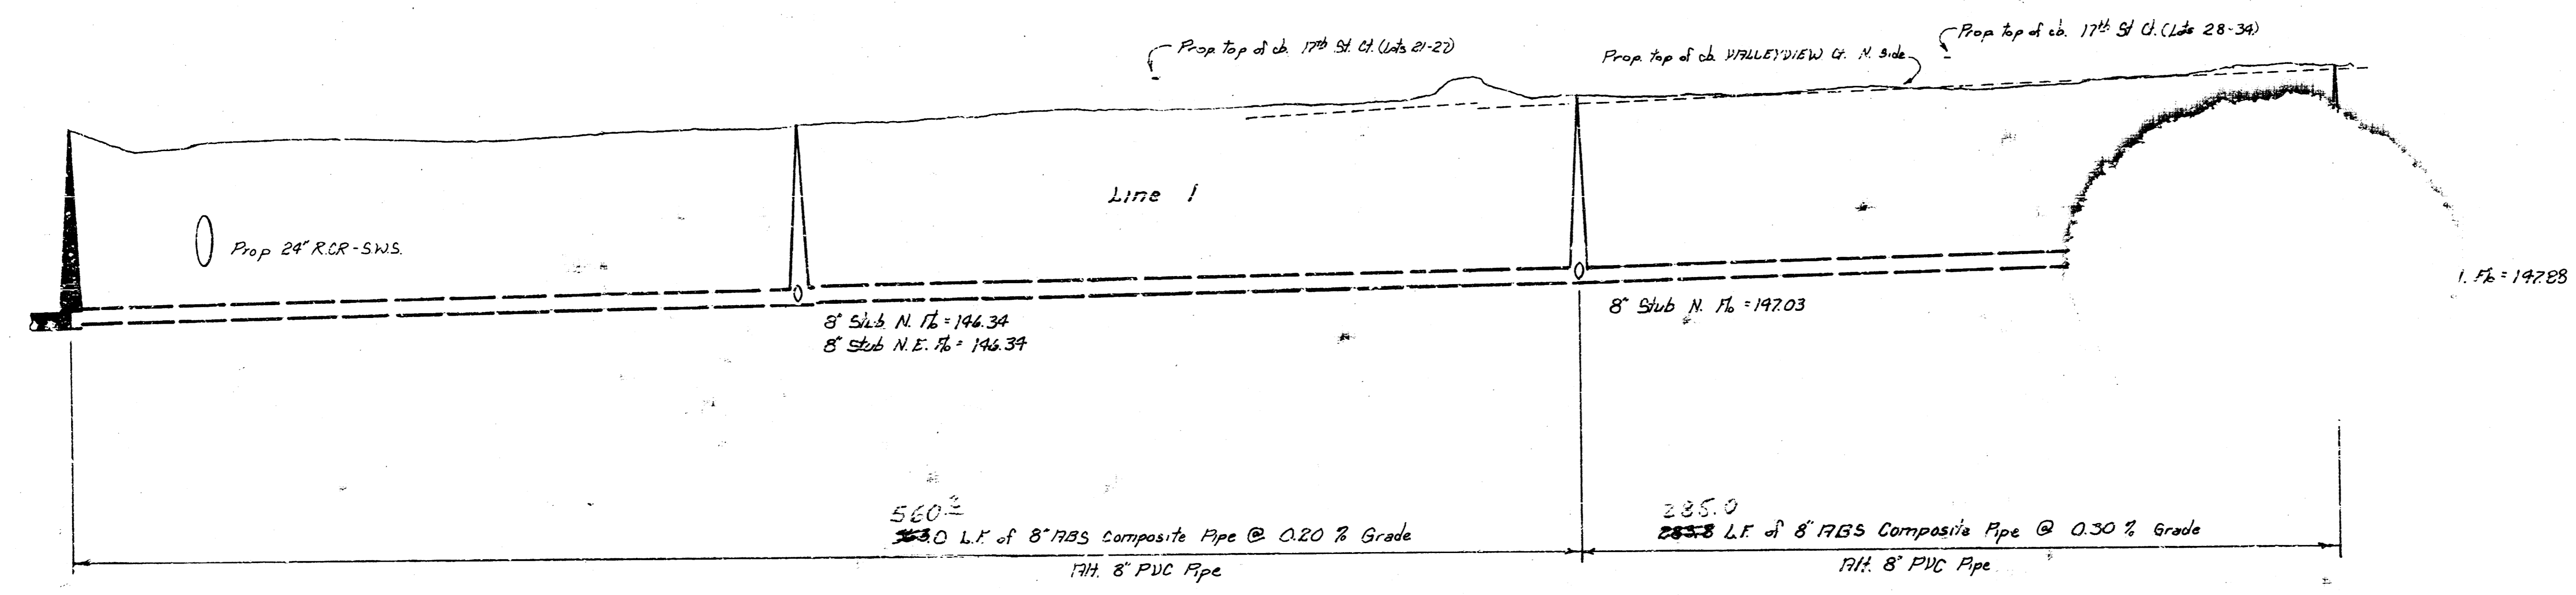

145.41 At Cur
 145.20 At In
 145.90
 146.10
 146.24 At Cur
 146.39 At In
 146.40
 146.60
 146.80
 146.93 At
 147.04
 147.34
 147.64
 147.78 At

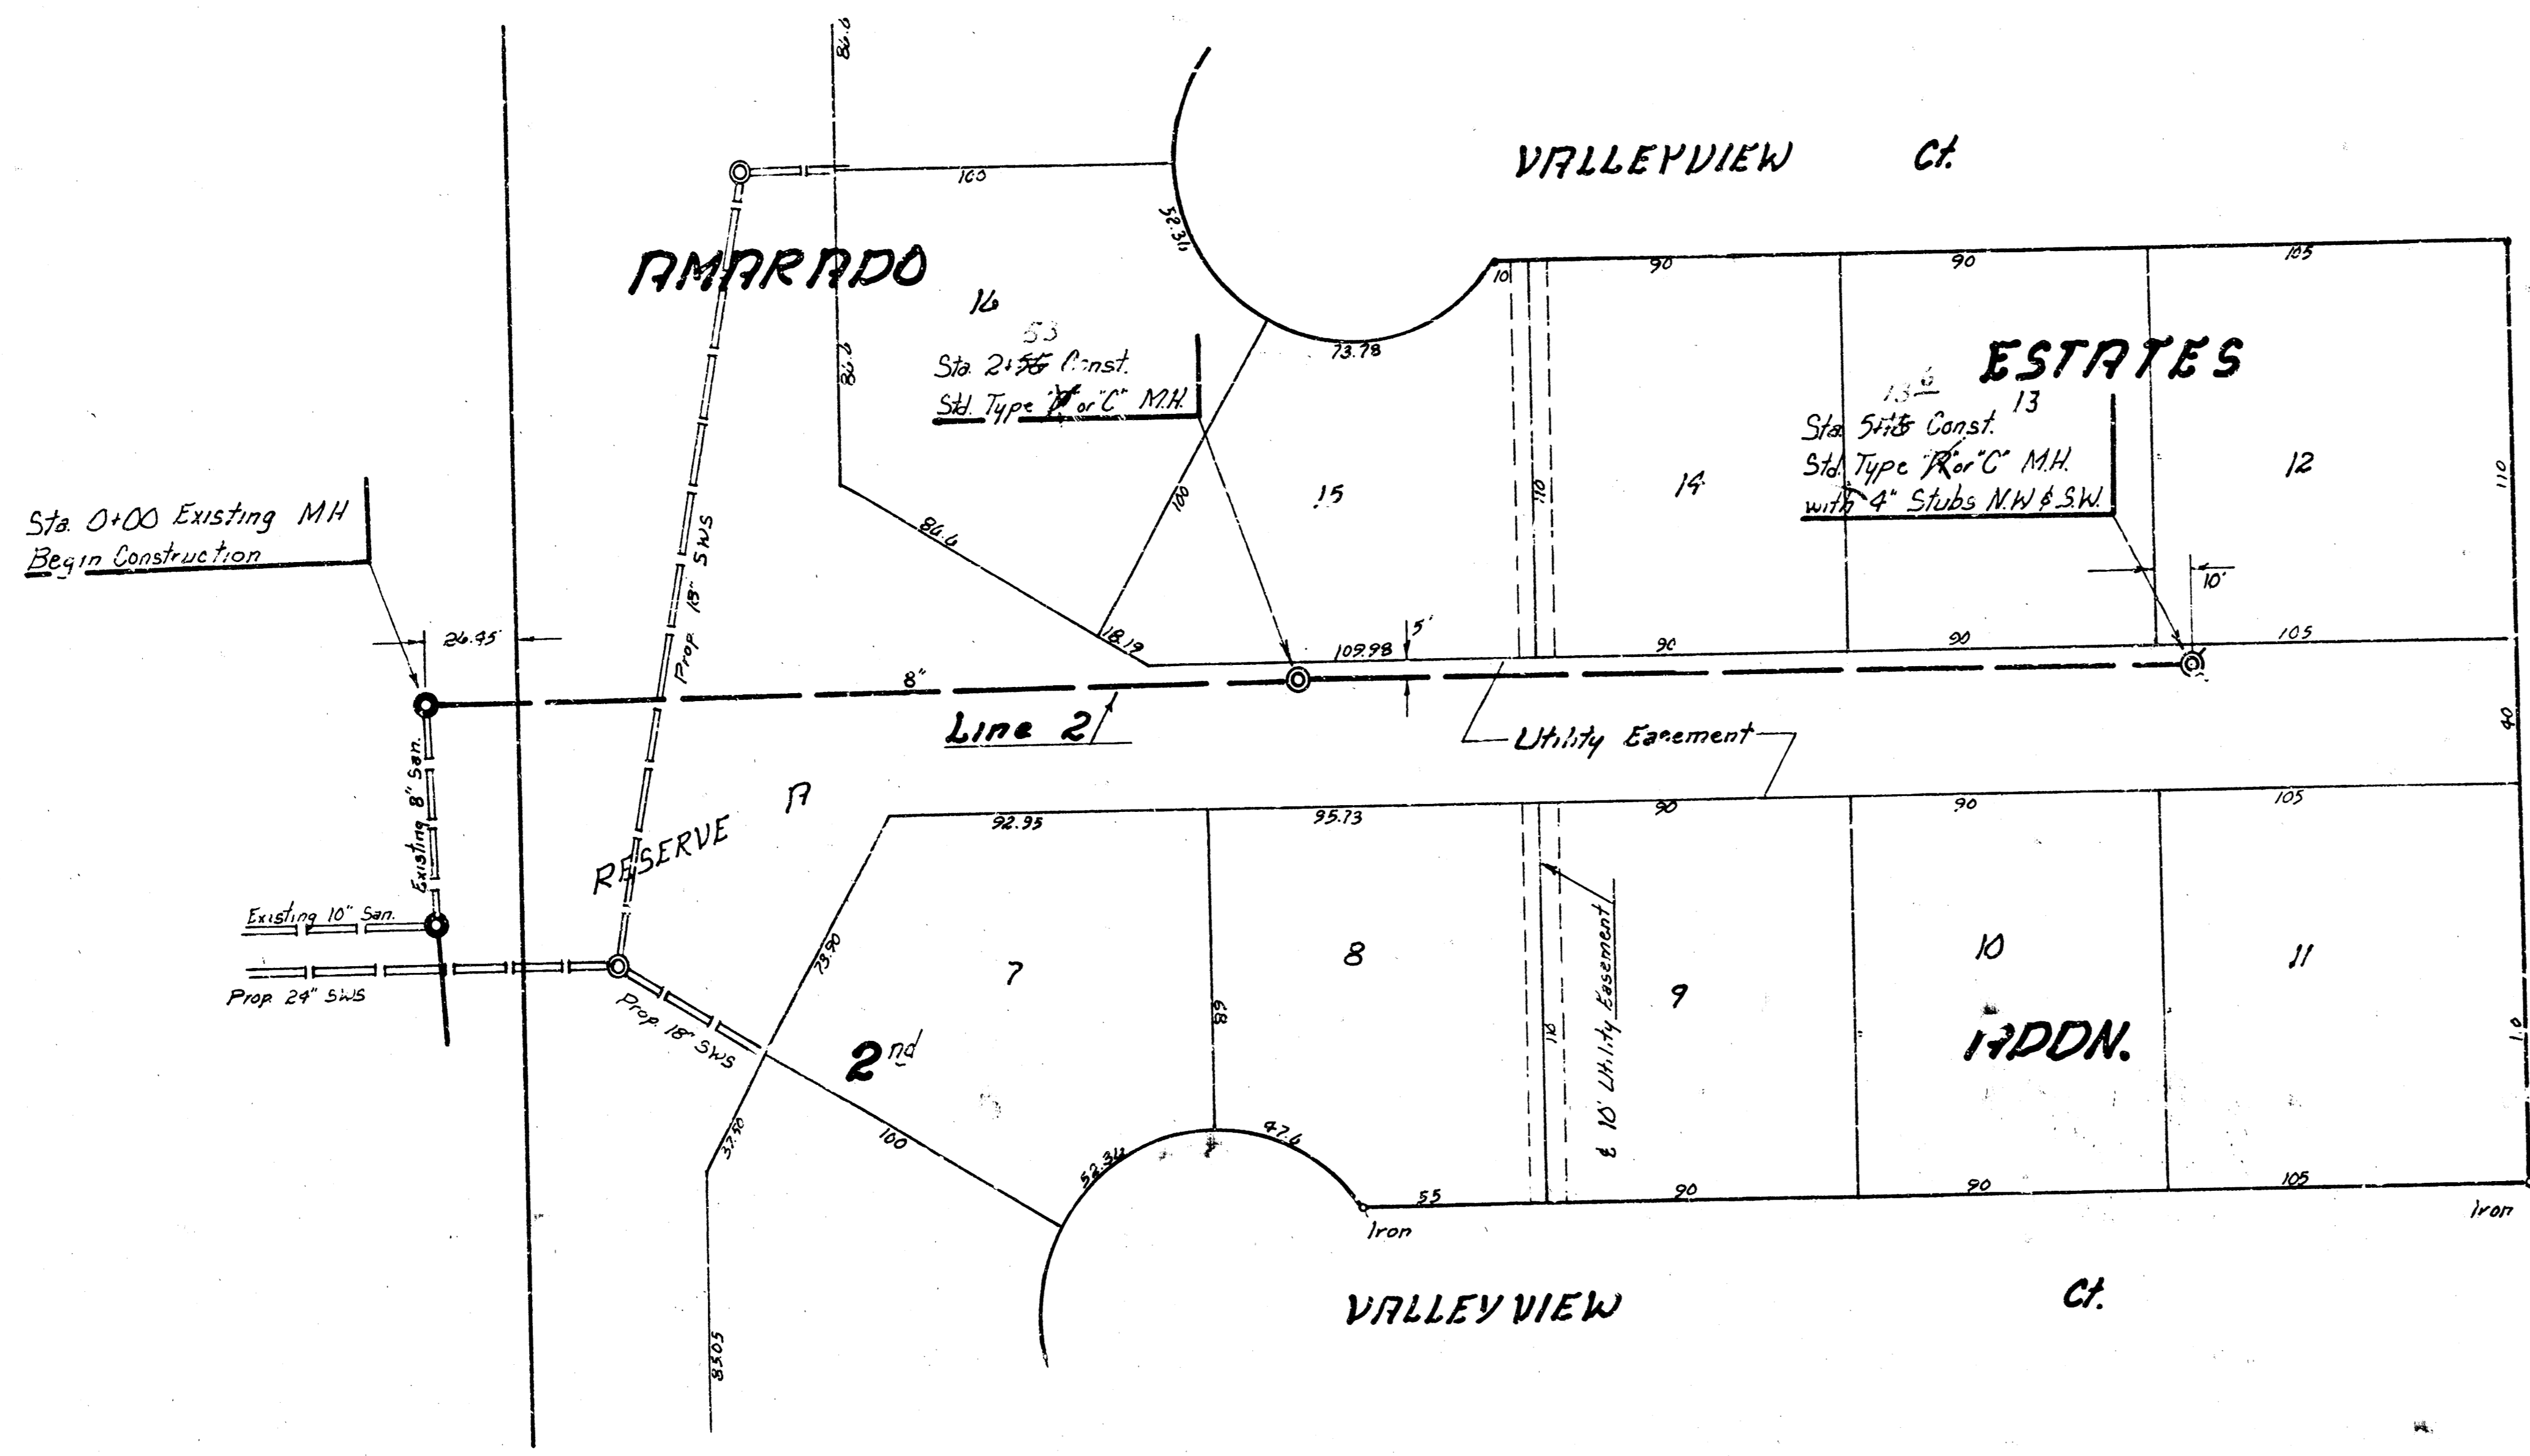

SCALE
 Plan 1" = 20'
 Profile 1" = 5'
 Area 1" = 20'

Sta 0+00 Existing MH Begin Construction

Existing 10" Sewer

Prop 24" SWS


Existing 8" Sewer

Prop 18" SWS

Sta 0+00 Existing MH Begin Construction

Sta 2+56 Const. Sta Type 24" C. MH

Sta 5+16 Const. Sta Type 24" C. MH with 4" Stubs NW & SW

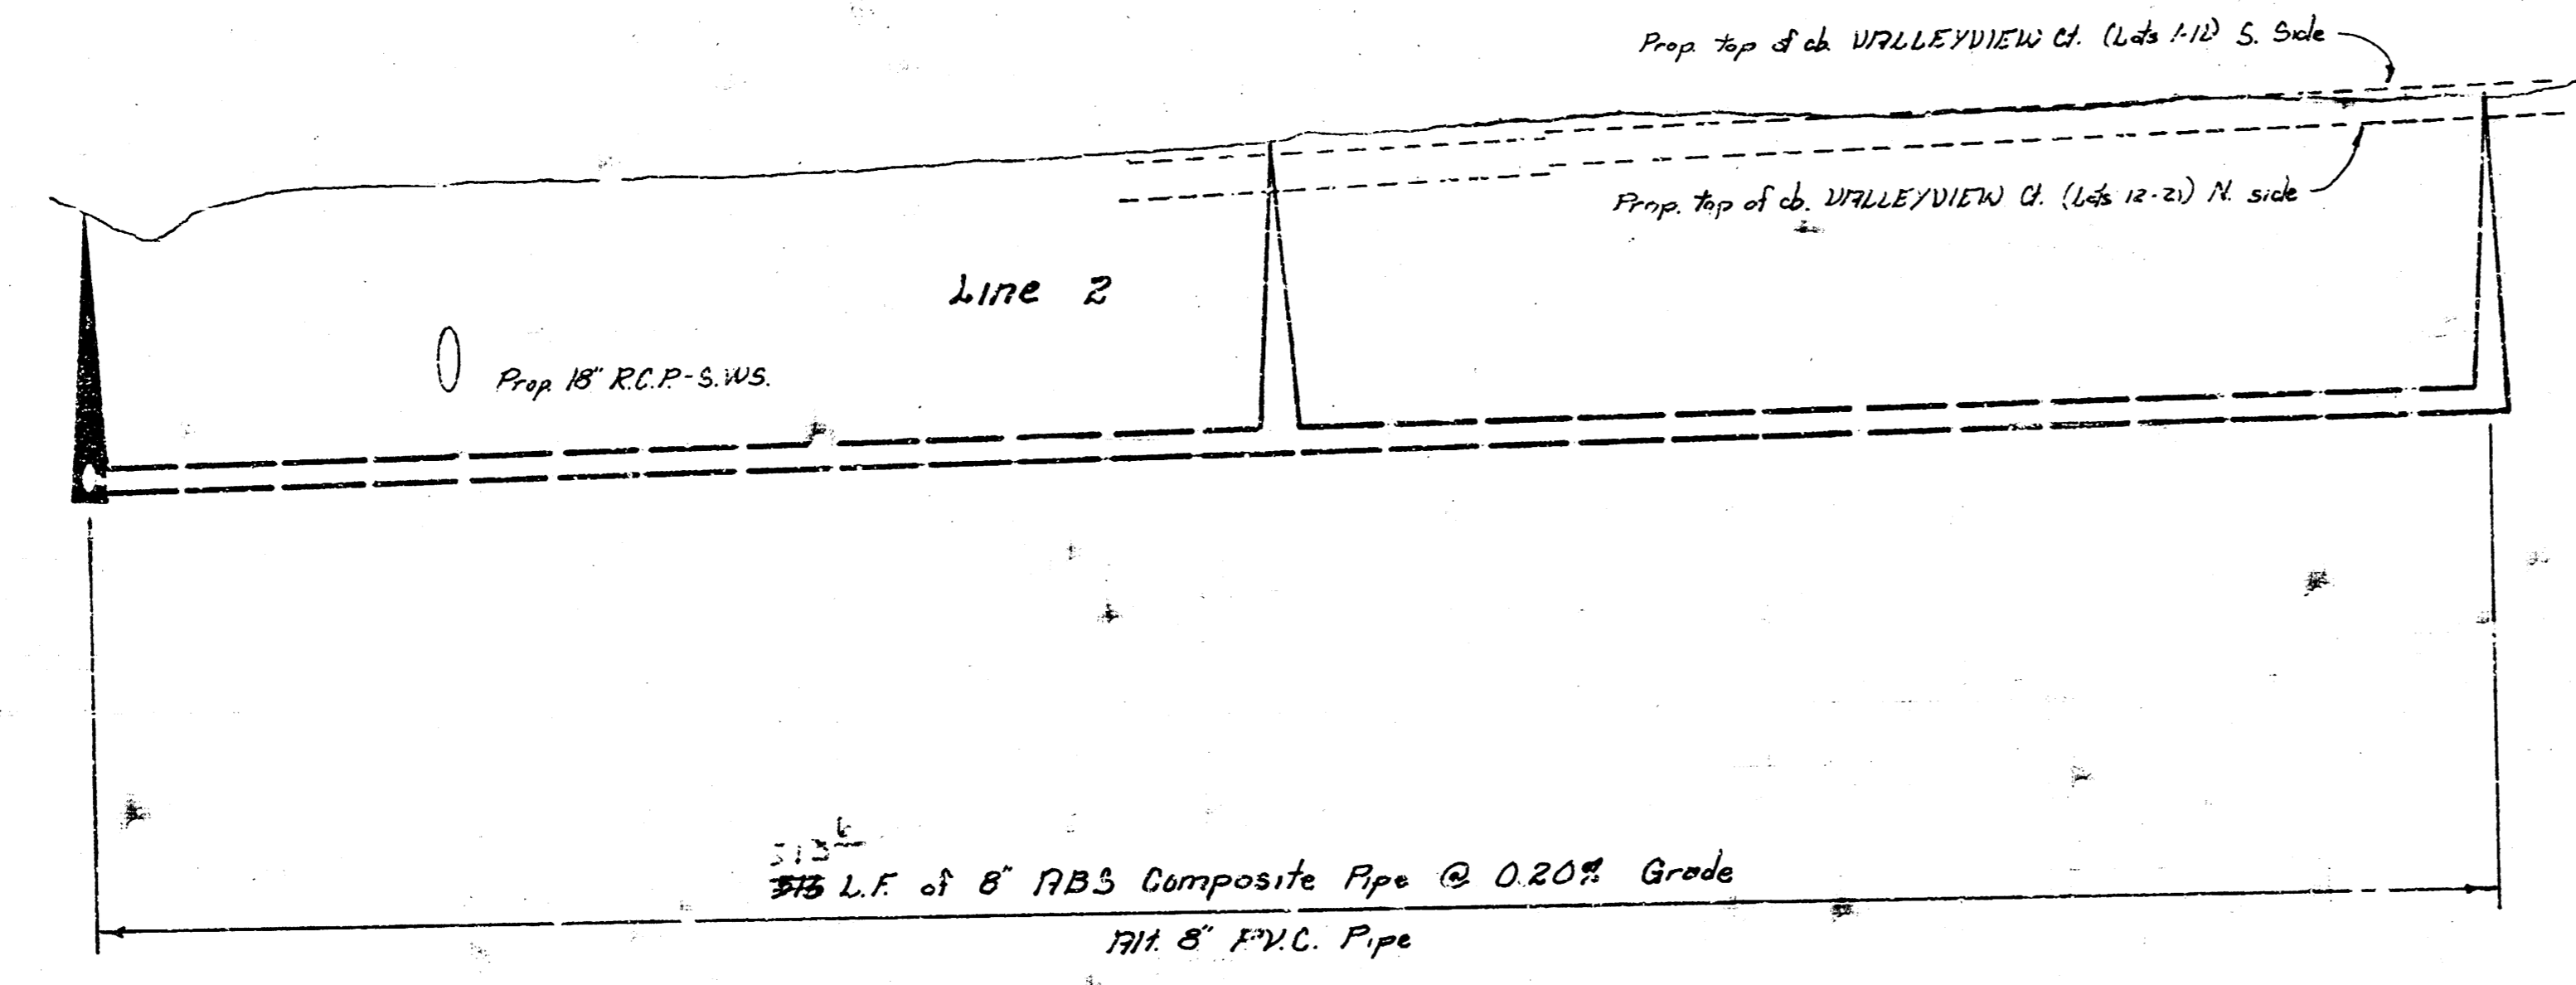

155
 150
 145
 140

146.00 Ft Out
 146.10 Ft In

146.30

146.50

146.61 Ft


146.70

146.90

147.10


147.13 Ft

NOTE: CONTRACTOR SHALL OBTAIN PERMITS OF LOTS 2 & 4 A MINIMUM ADVANCE NOTICE OF 48 HOURS BEFORE BEGINNING CONSTRUCTION OF LINE NO. 3. CONTRACTOR WILL BE REQUIRED TO RESTORE ANY IMPROVEMENTS OR VEGETATION DISTURBED ON THESE LOTS TO A CONDITION EQUAL TO OR BETTER THAN THE ORIGINAL CONDITION. THIS WORK WILL BE PAID FOR AT THE UNIT PRICE \$7.00 FOR SITE PREPARATION AND STORAGE.

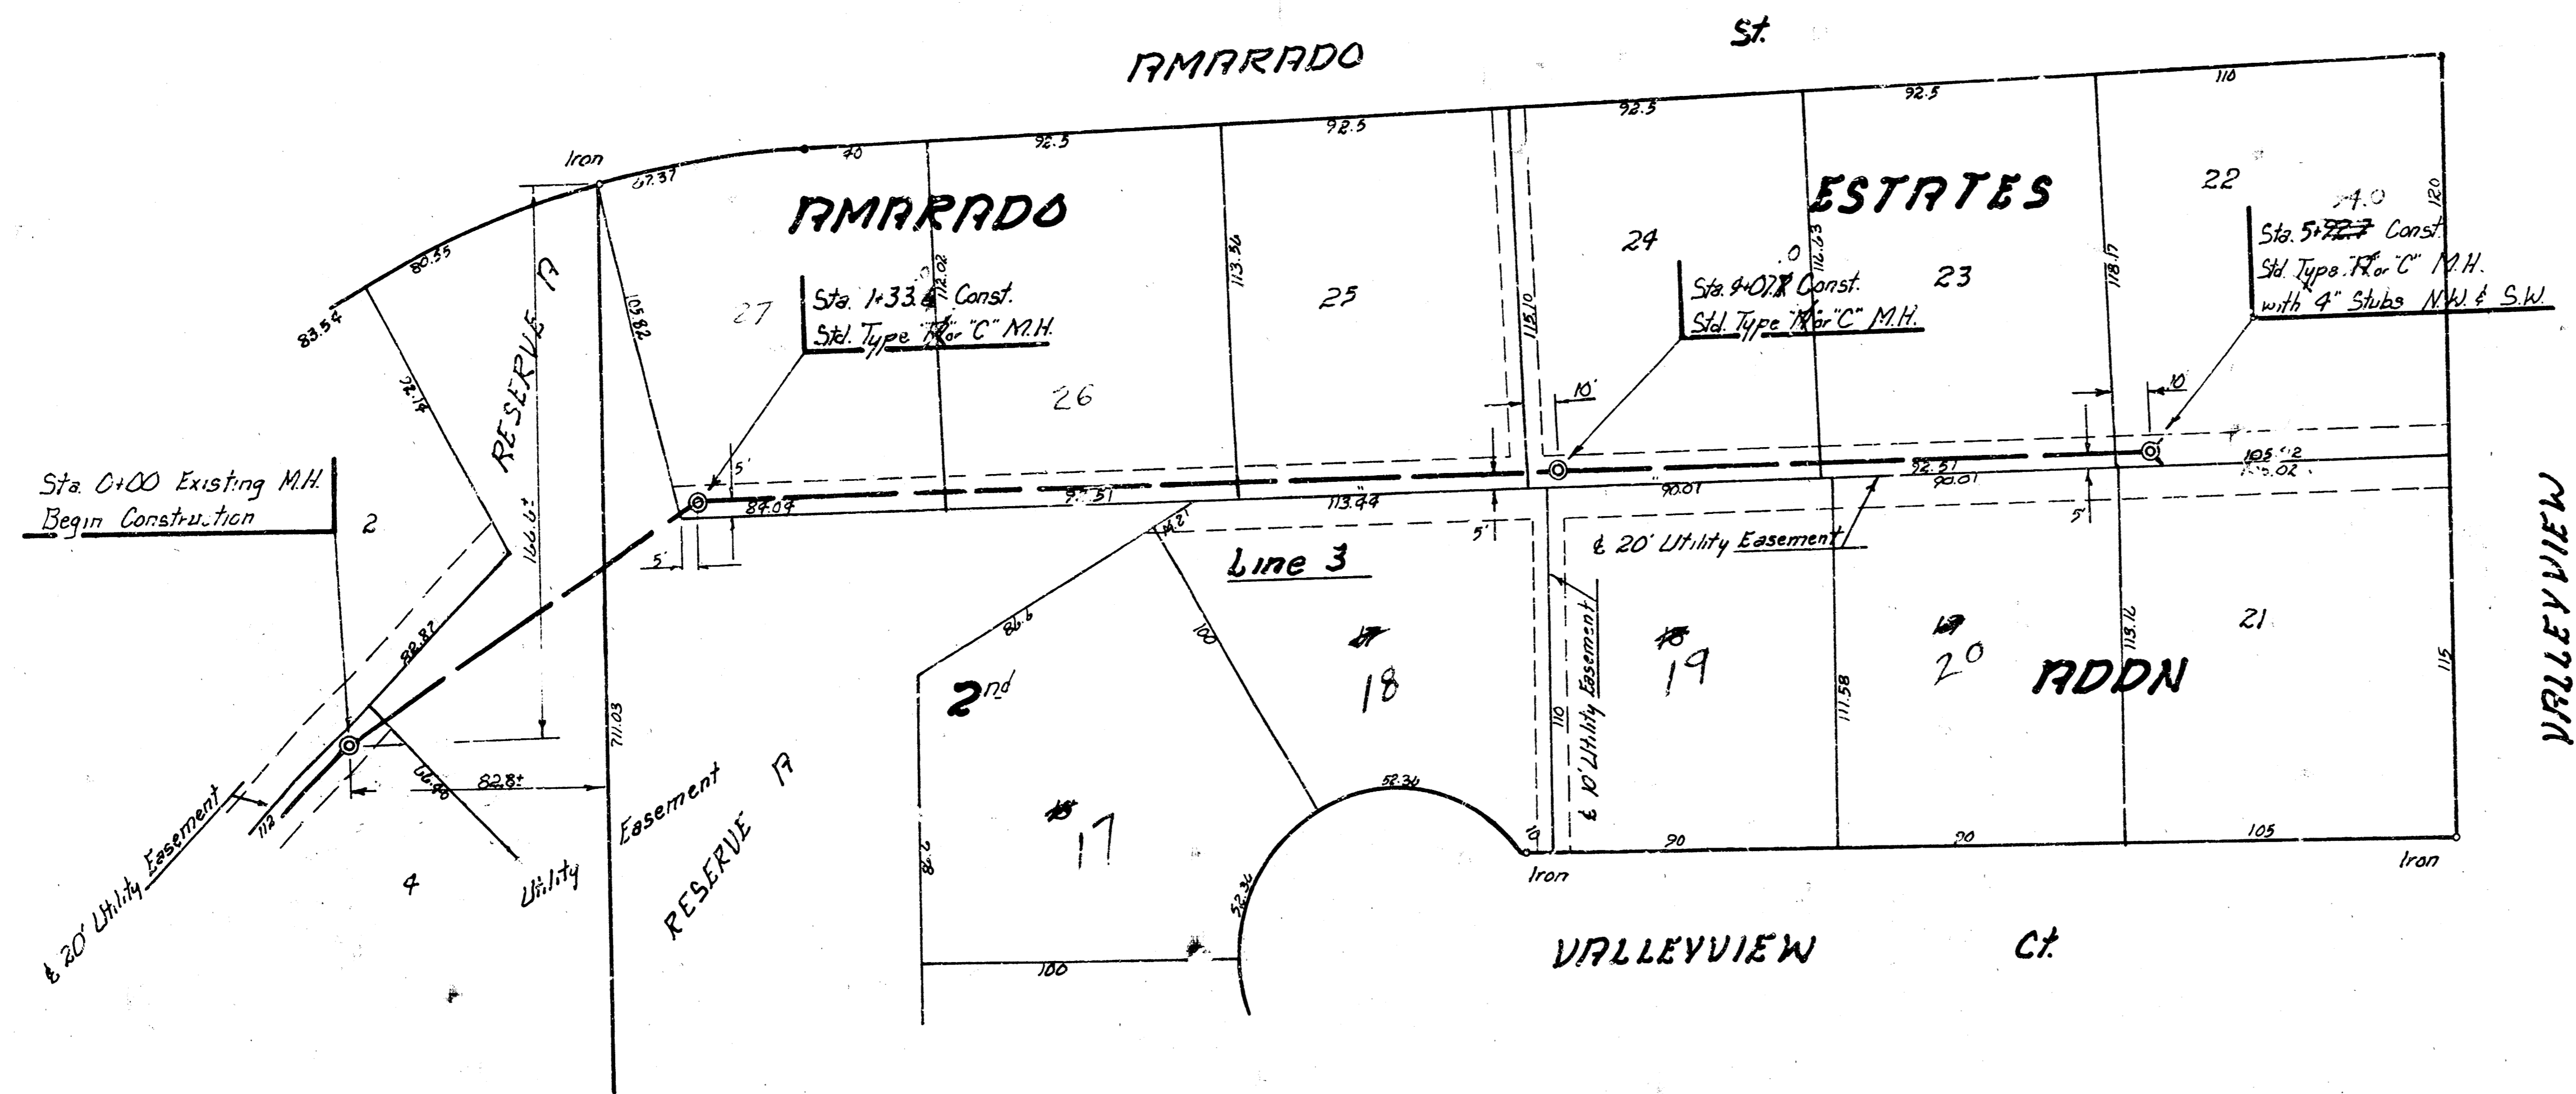

SCALE
 Plan 1" = 20'
 Profile 1" = 5'
 Horiz 1" = 20'

155
 150
 145
 140

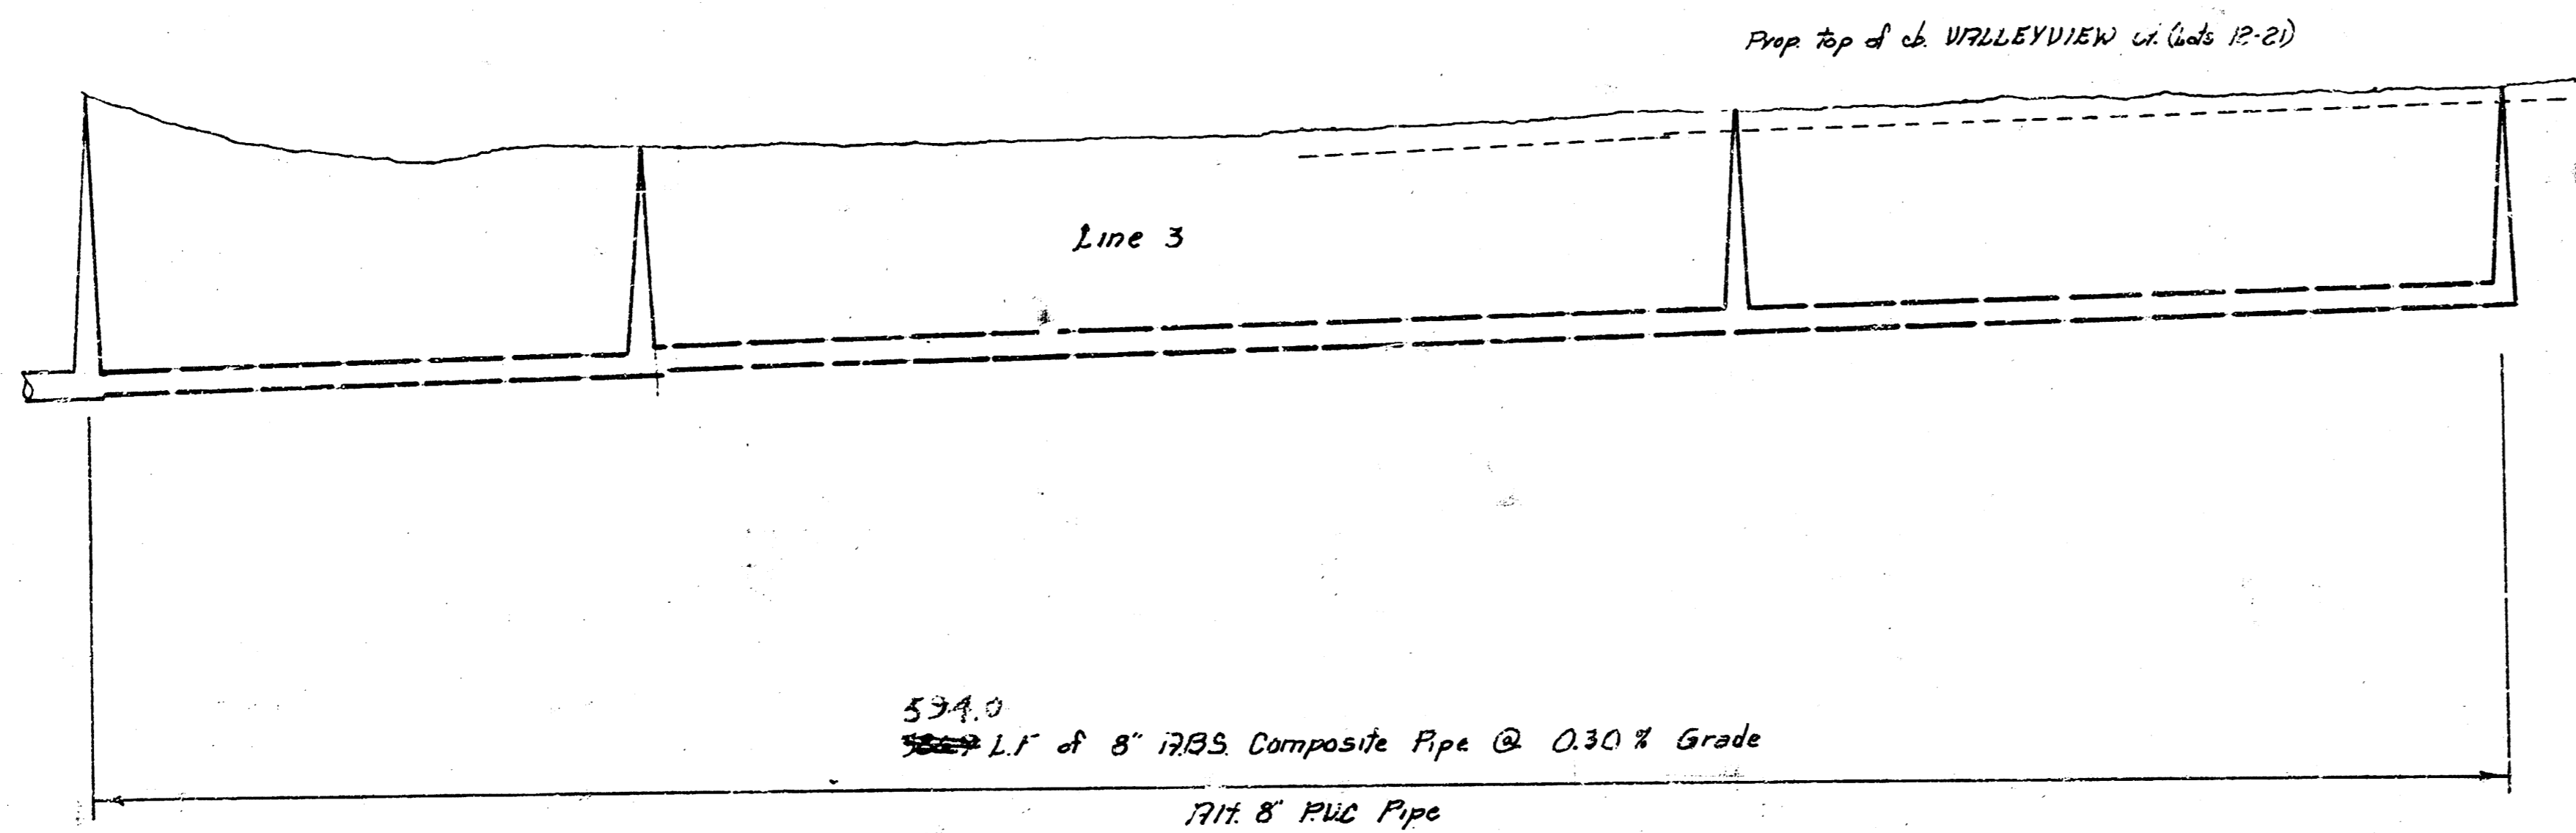

0 146.95 146.65 146.35
 1 146.95
 147.05 147.05 147.15 147.15
 2 147.35
 3 147.65
 4 147.95 147.95
 5 148.25
 148.53