LATERAL 4, MAIN 4
WESTLINK SEWER

PROJECT NUMBER
468-76-245-81408-000-000-001

As Built
J.L.L.
8/85

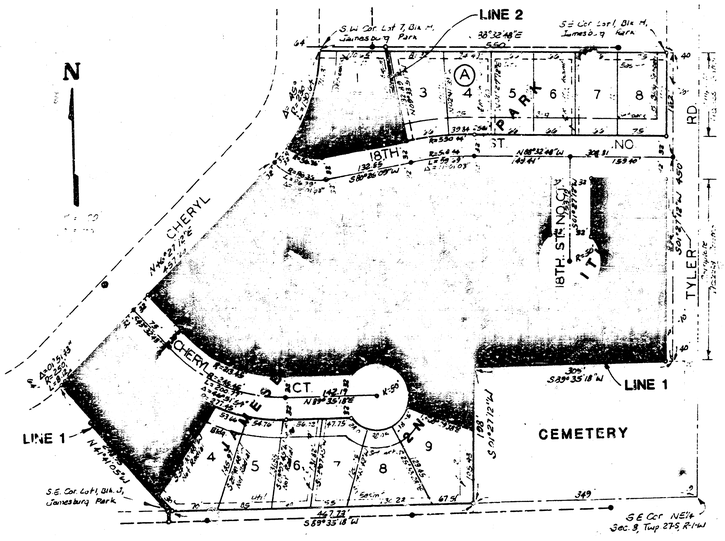

GENERAL NOTES

The contractor shall be responsible for preserving property irons. The contractor shall be required to re-establish any property irons which are damaged or destroyed by his construction operations. Such irons shall be re-established by a licensed land surveyor or a professional engineer in accordance with state laws.

The contractor shall contact the utility companies for any proposed or existing underground lines which they may have in the vicinity of this project.

The contractor shall co-ordinate sewer construction with the construction of a proposed water line in Cheryl Court.

Contractor shall provide 48 hours notice to owners of developed lots prior to beginning construction. Contractor shall restore to original condition any grassed lawns, flower gardens, etc. Cost shall be incidental to the project.

CITY OF WICHITA, KANSAS
MICHAEL E. LINDEBAK CITY ENGINEER

THOMAS CHARLES PRICE — LICENSED — 9621 — KANSAS

BAUGHMAN COMPANY, P.A.
SURVEYING & ENGINEERING
316/262-7271 • 330 LAURA • WICHITA, KANSAS 67211

1/5

BENCH MARK: W. RIM OF MANHOLE, 56' S.E. OF S.W. COR. LOT 4, JAMESBURG PARK 2ND ADD., ELEV. 1656

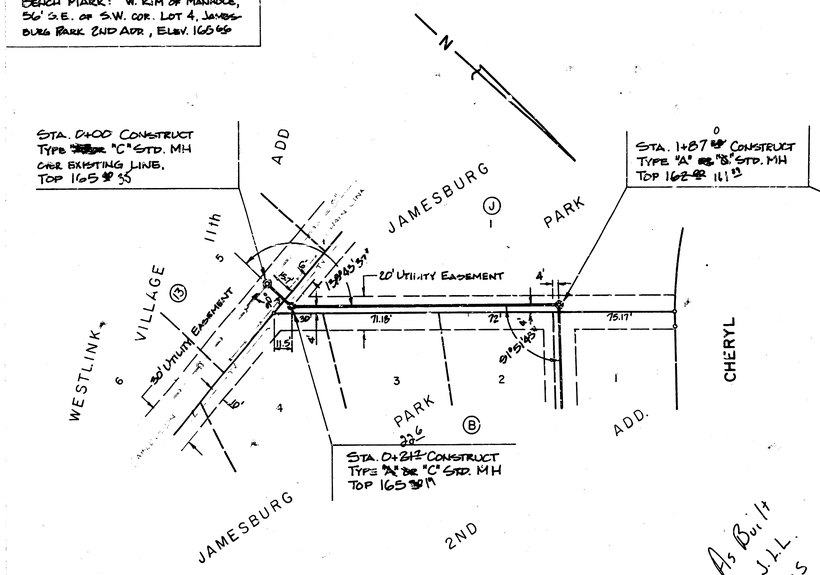

As Built J.L.L. 8/65

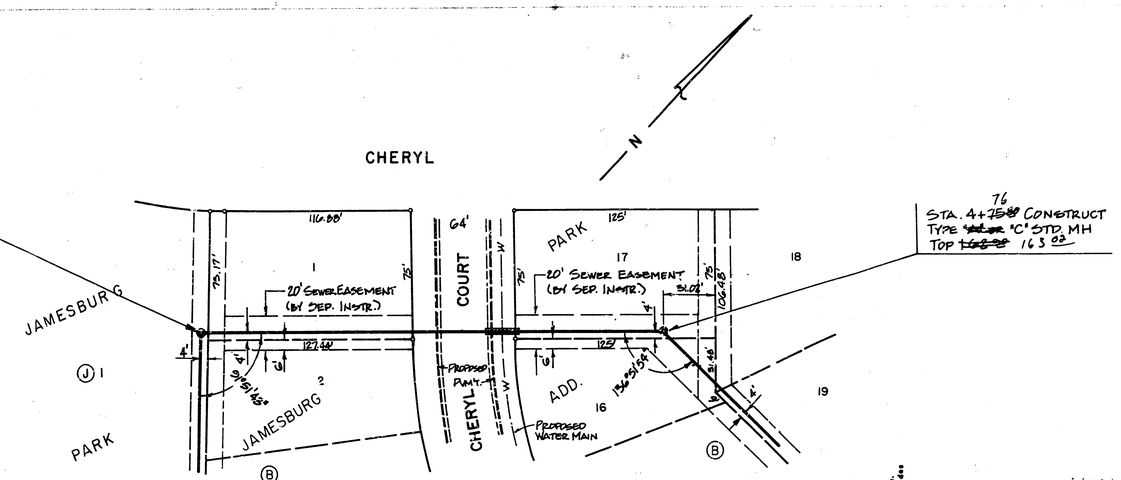

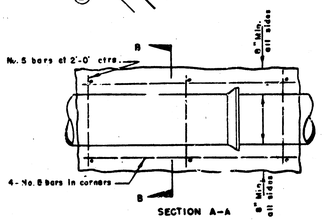

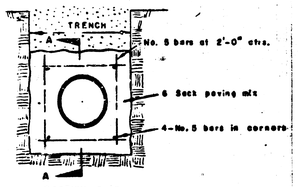

LINE 1

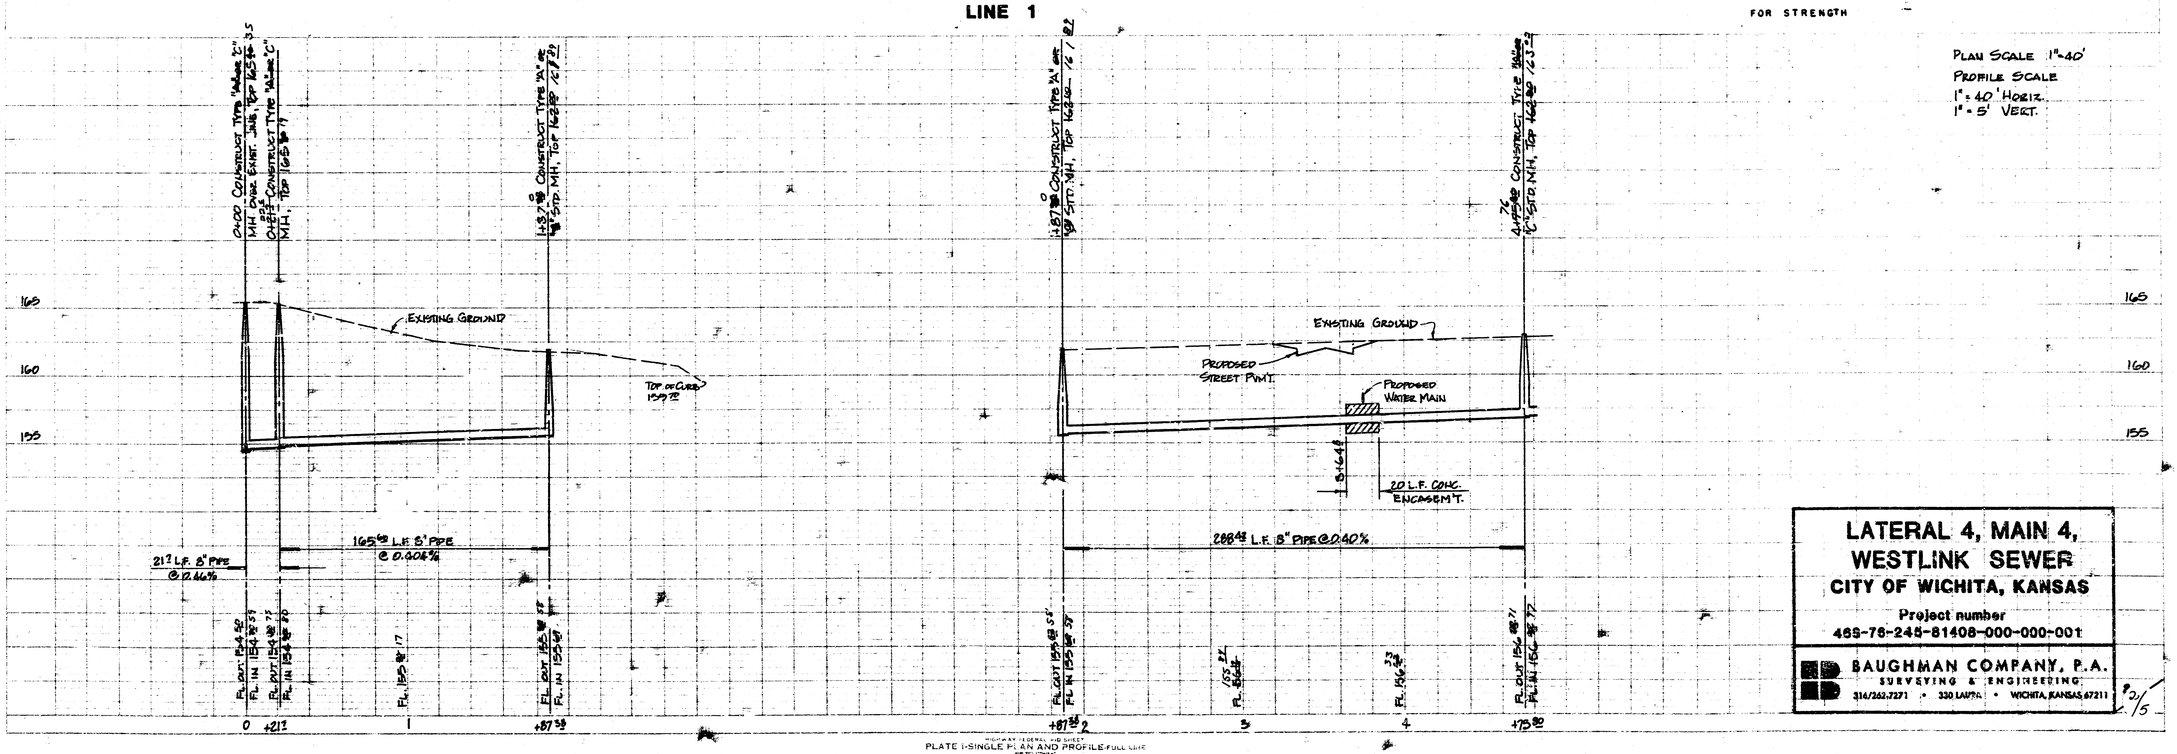

REINFORCED CONCRETE ENCASEMENT FOR STRENGTH

PLAN SCALE 1"=40'
PROFILE SCALE
1"=40' HORIZ.
1"=5' VERT.

PROFILE

LATERAL 4, MAIN 4, WESTLINK SEWER
CITY OF WICHITA, KANSAS

Project number

BAUGHMAN COMPANY, P.A.
SURVEYING & ENGINEERING
316/262-7271 • 330 LAURA • WICHITA, KANSAS, 67211

2/5

HIGHWAY FEDERAL AID SHEET
PLATE I-SINGLE PLAN AND PROFILE-FULL SIZE
TIE TELEPHONE
PRINTED IN U.S.A.

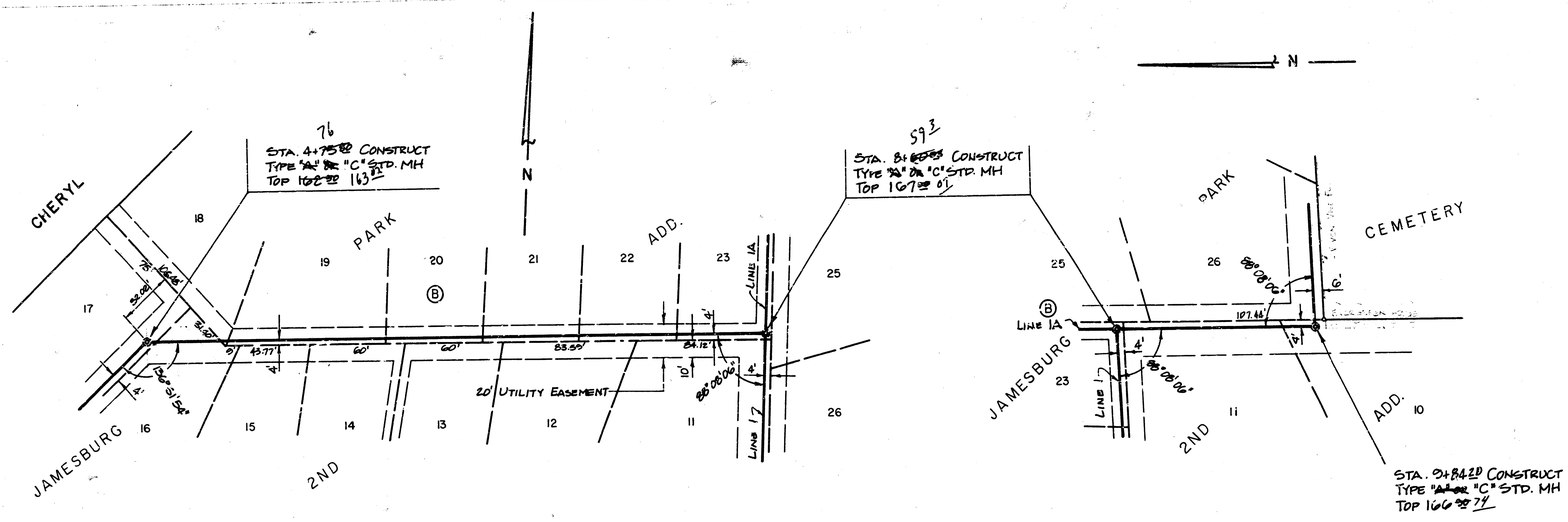

LINE 1

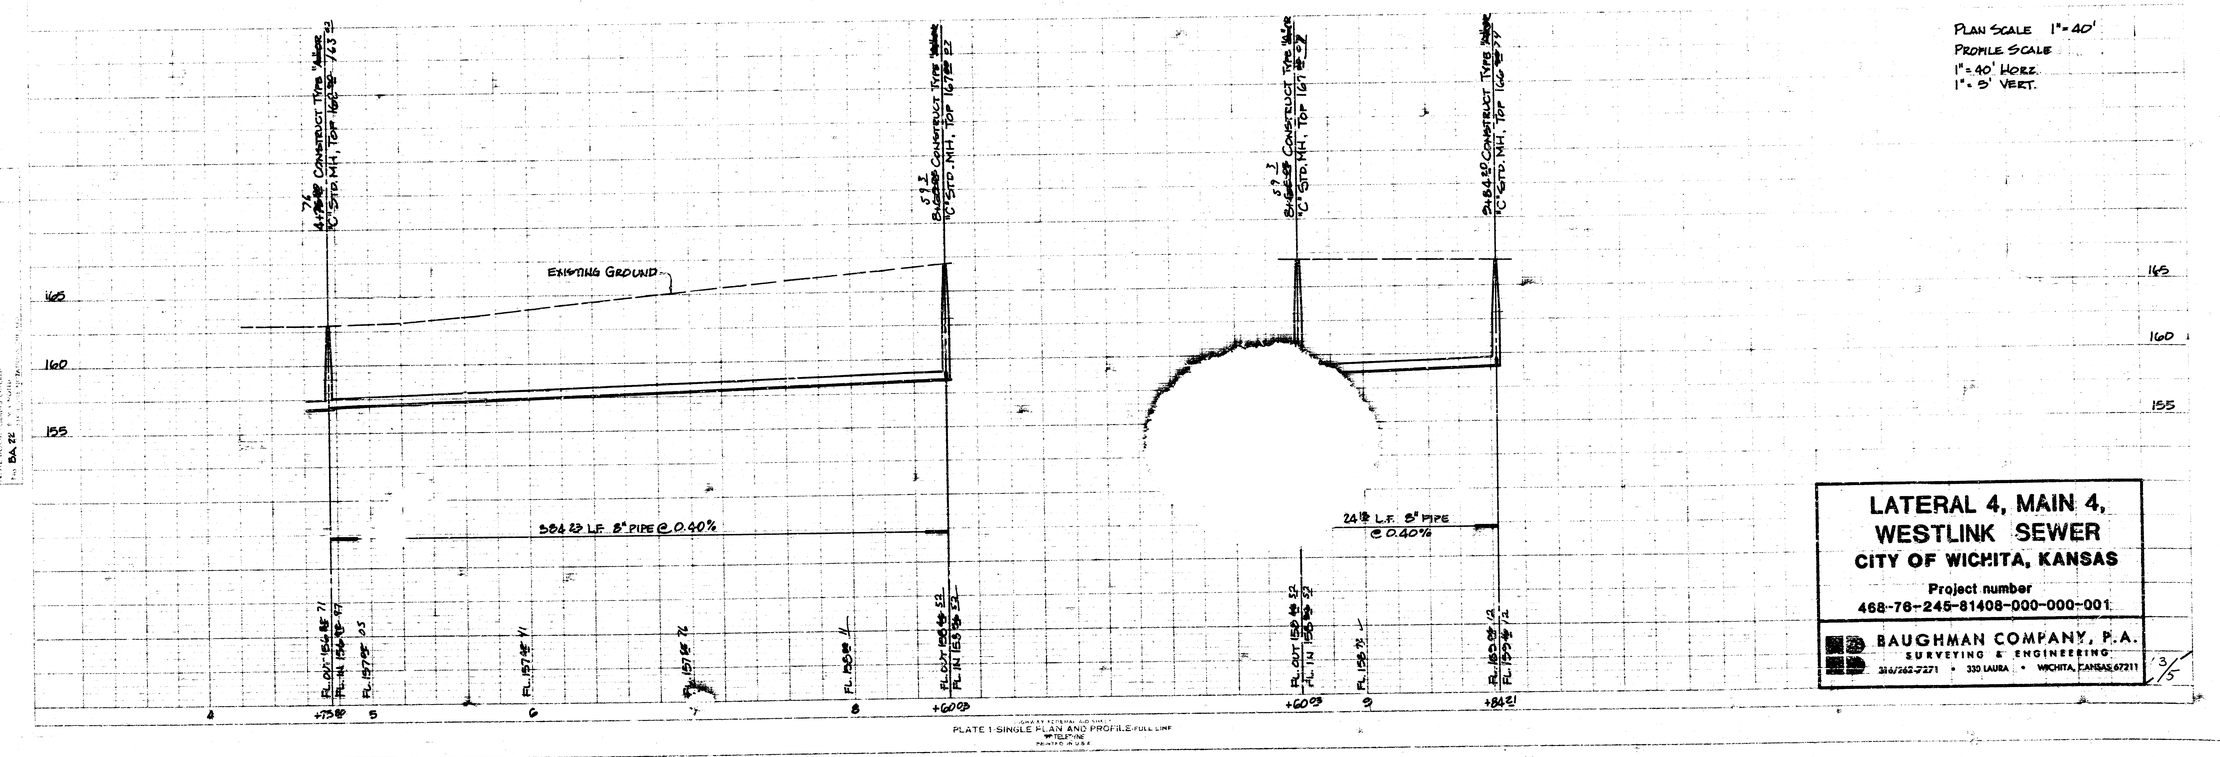

LATERAL 4, MAIN 4, WESTLINK SEWER
CITY OF WICHITA, KANSAS

Project number
468-76-245-81408-000-000-001

BAUGHMAN COMPANY, P.A.
SURVEYING & ENGINEERING
316/262-7271 • 330 LAURA • WICHITA, KANSAS 67211

PLATE 1 SINGLE PLAN AND PROFILE-FULL LINE

BENCH MARK: CITY OF WICHITA STD. DISC, 31' S. AND 36' E. OF 1/4 SEC. COR. @ 17TH & TYLER. ELEV. 1,249

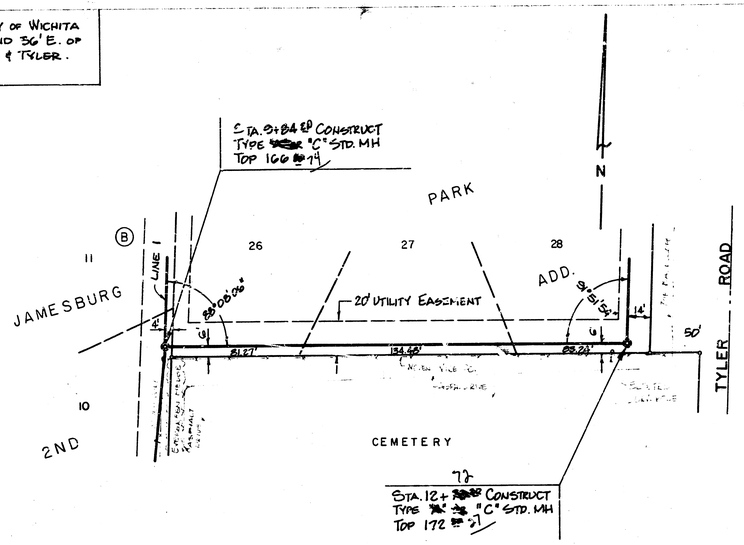

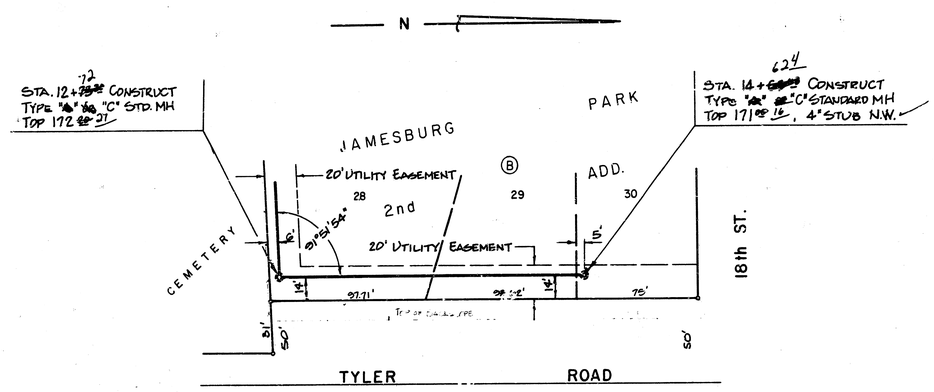

As Built J.L.L. 8/83

PLAN

PROFILE
No. BA-22

LINE 1

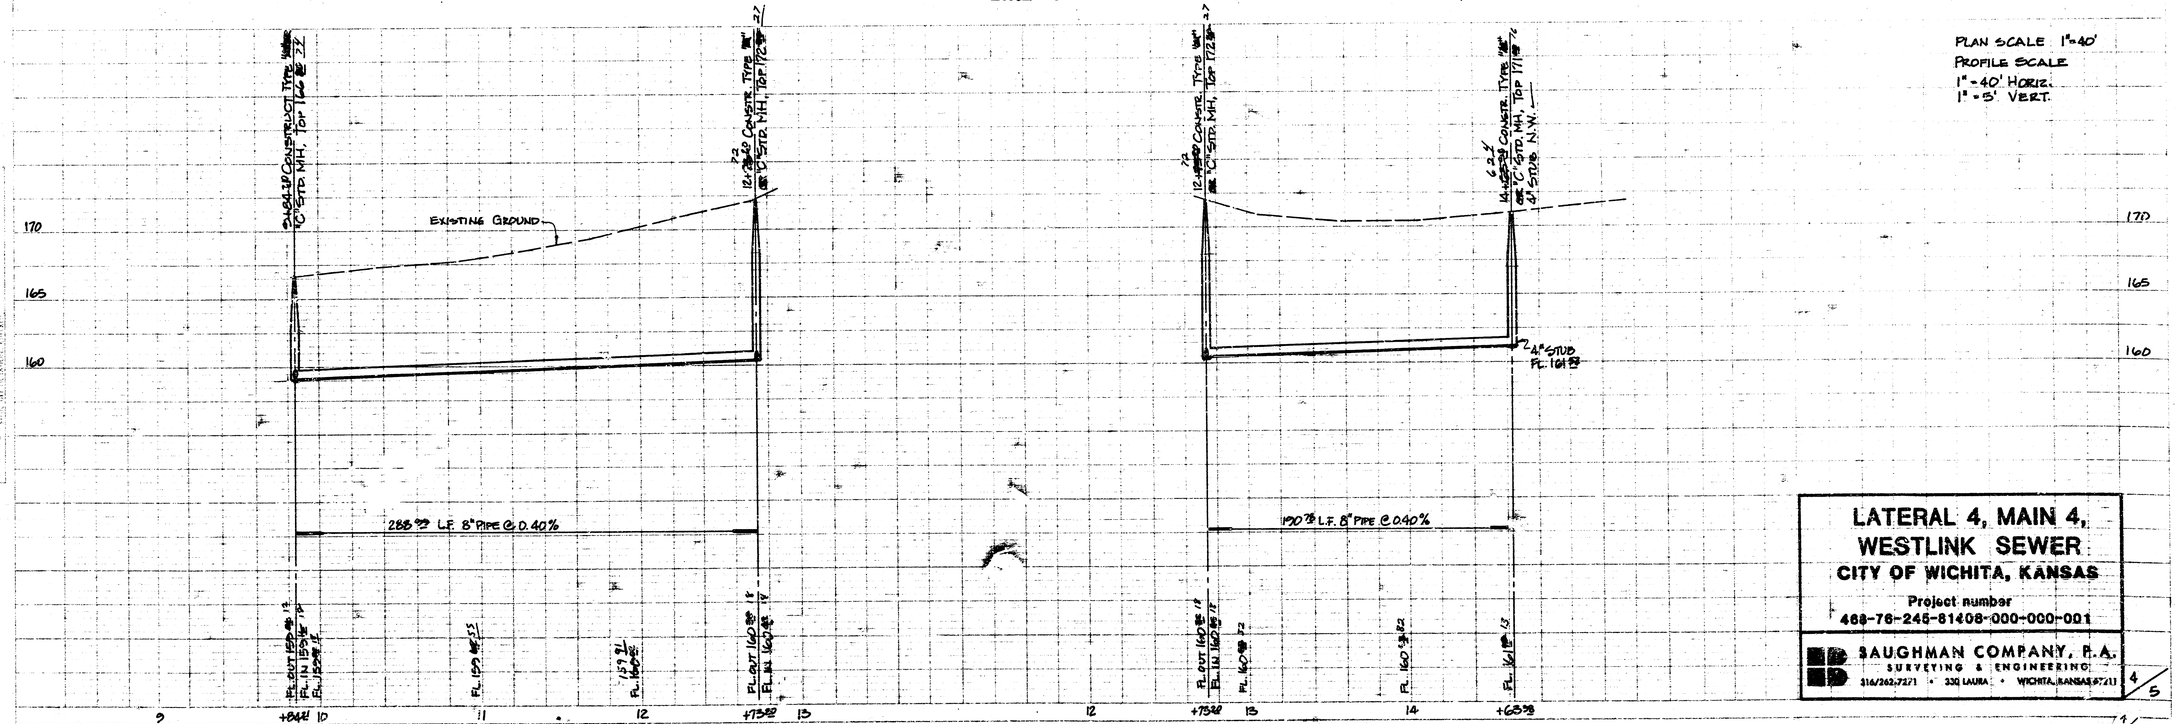

PLATE 1-SINGLE PLAN AND PROFILE-FULL LINE

LATERAL 4, MAIN 4, WESTLINK SEWER
CITY OF WICHITA, KANSAS

Project number
468-76-245-81408-000-000-001

SAUGHMAN COMPANY, P.A.
SURVEYING & ENGINEERING
316/262-7271 • 330 LAURA • WICHITA, KANSAS 67211

4/5

1/5

BENCH MARK: TOP OF IRON @ S.W. CORNER LOT 5, BLOCK A, JAMESBURG PARK 2ND ELEV. 167.81

N

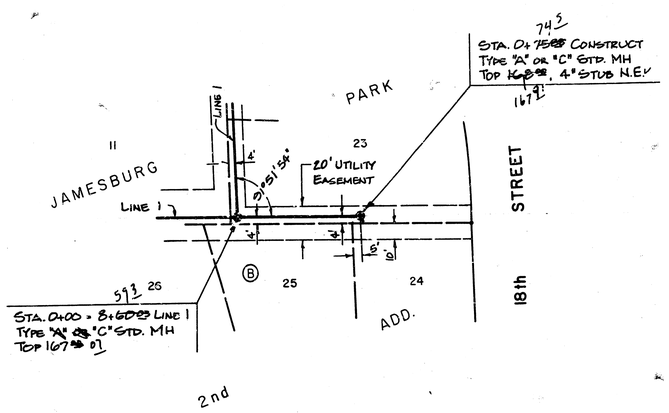

N

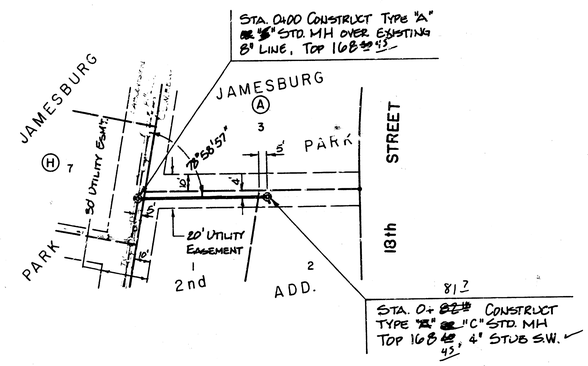

A's Built
J.L.L.
8/05

LINE 1A

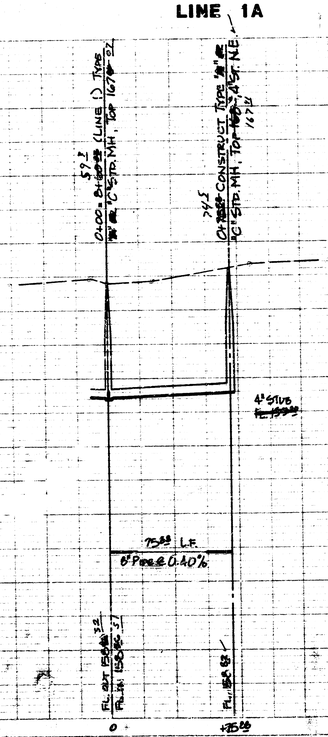

LINE 2

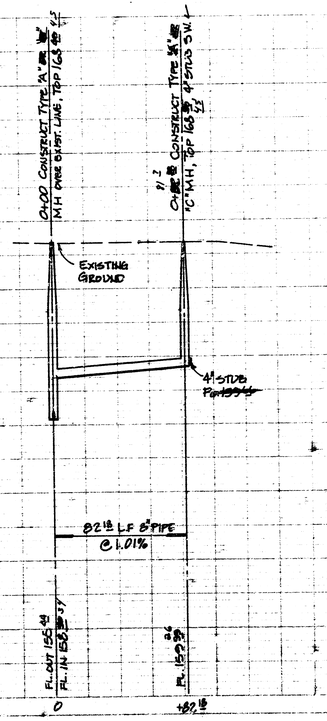

PLAN SCALE 1"=40'
PROFILE SCALE
1"=40' HORZ.
1"=5' VERT.

PROFILL
NOTE FOUND CABLE AND PIPE LOCATIONS ARE APPROXIMATE
No. BA 22

PLATE 1-SINGLE PLAN AND PROFILE FULL LINE
ARTISTYPE
PRINTED IN U.S.A.

LATERAL 4, MAIN 4, WESTLINK SEWER
CITY OF WICHITA, KANSAS

Project number
468-76-245-81408-000-000-001

BAUGHMAN COMPANY, P.A.
SURVEYING & ENGINEERING
316/262-7271 • 330 LAURA • WICHITA, KANSAS 67211

5
5

Sheet 10 of 32