




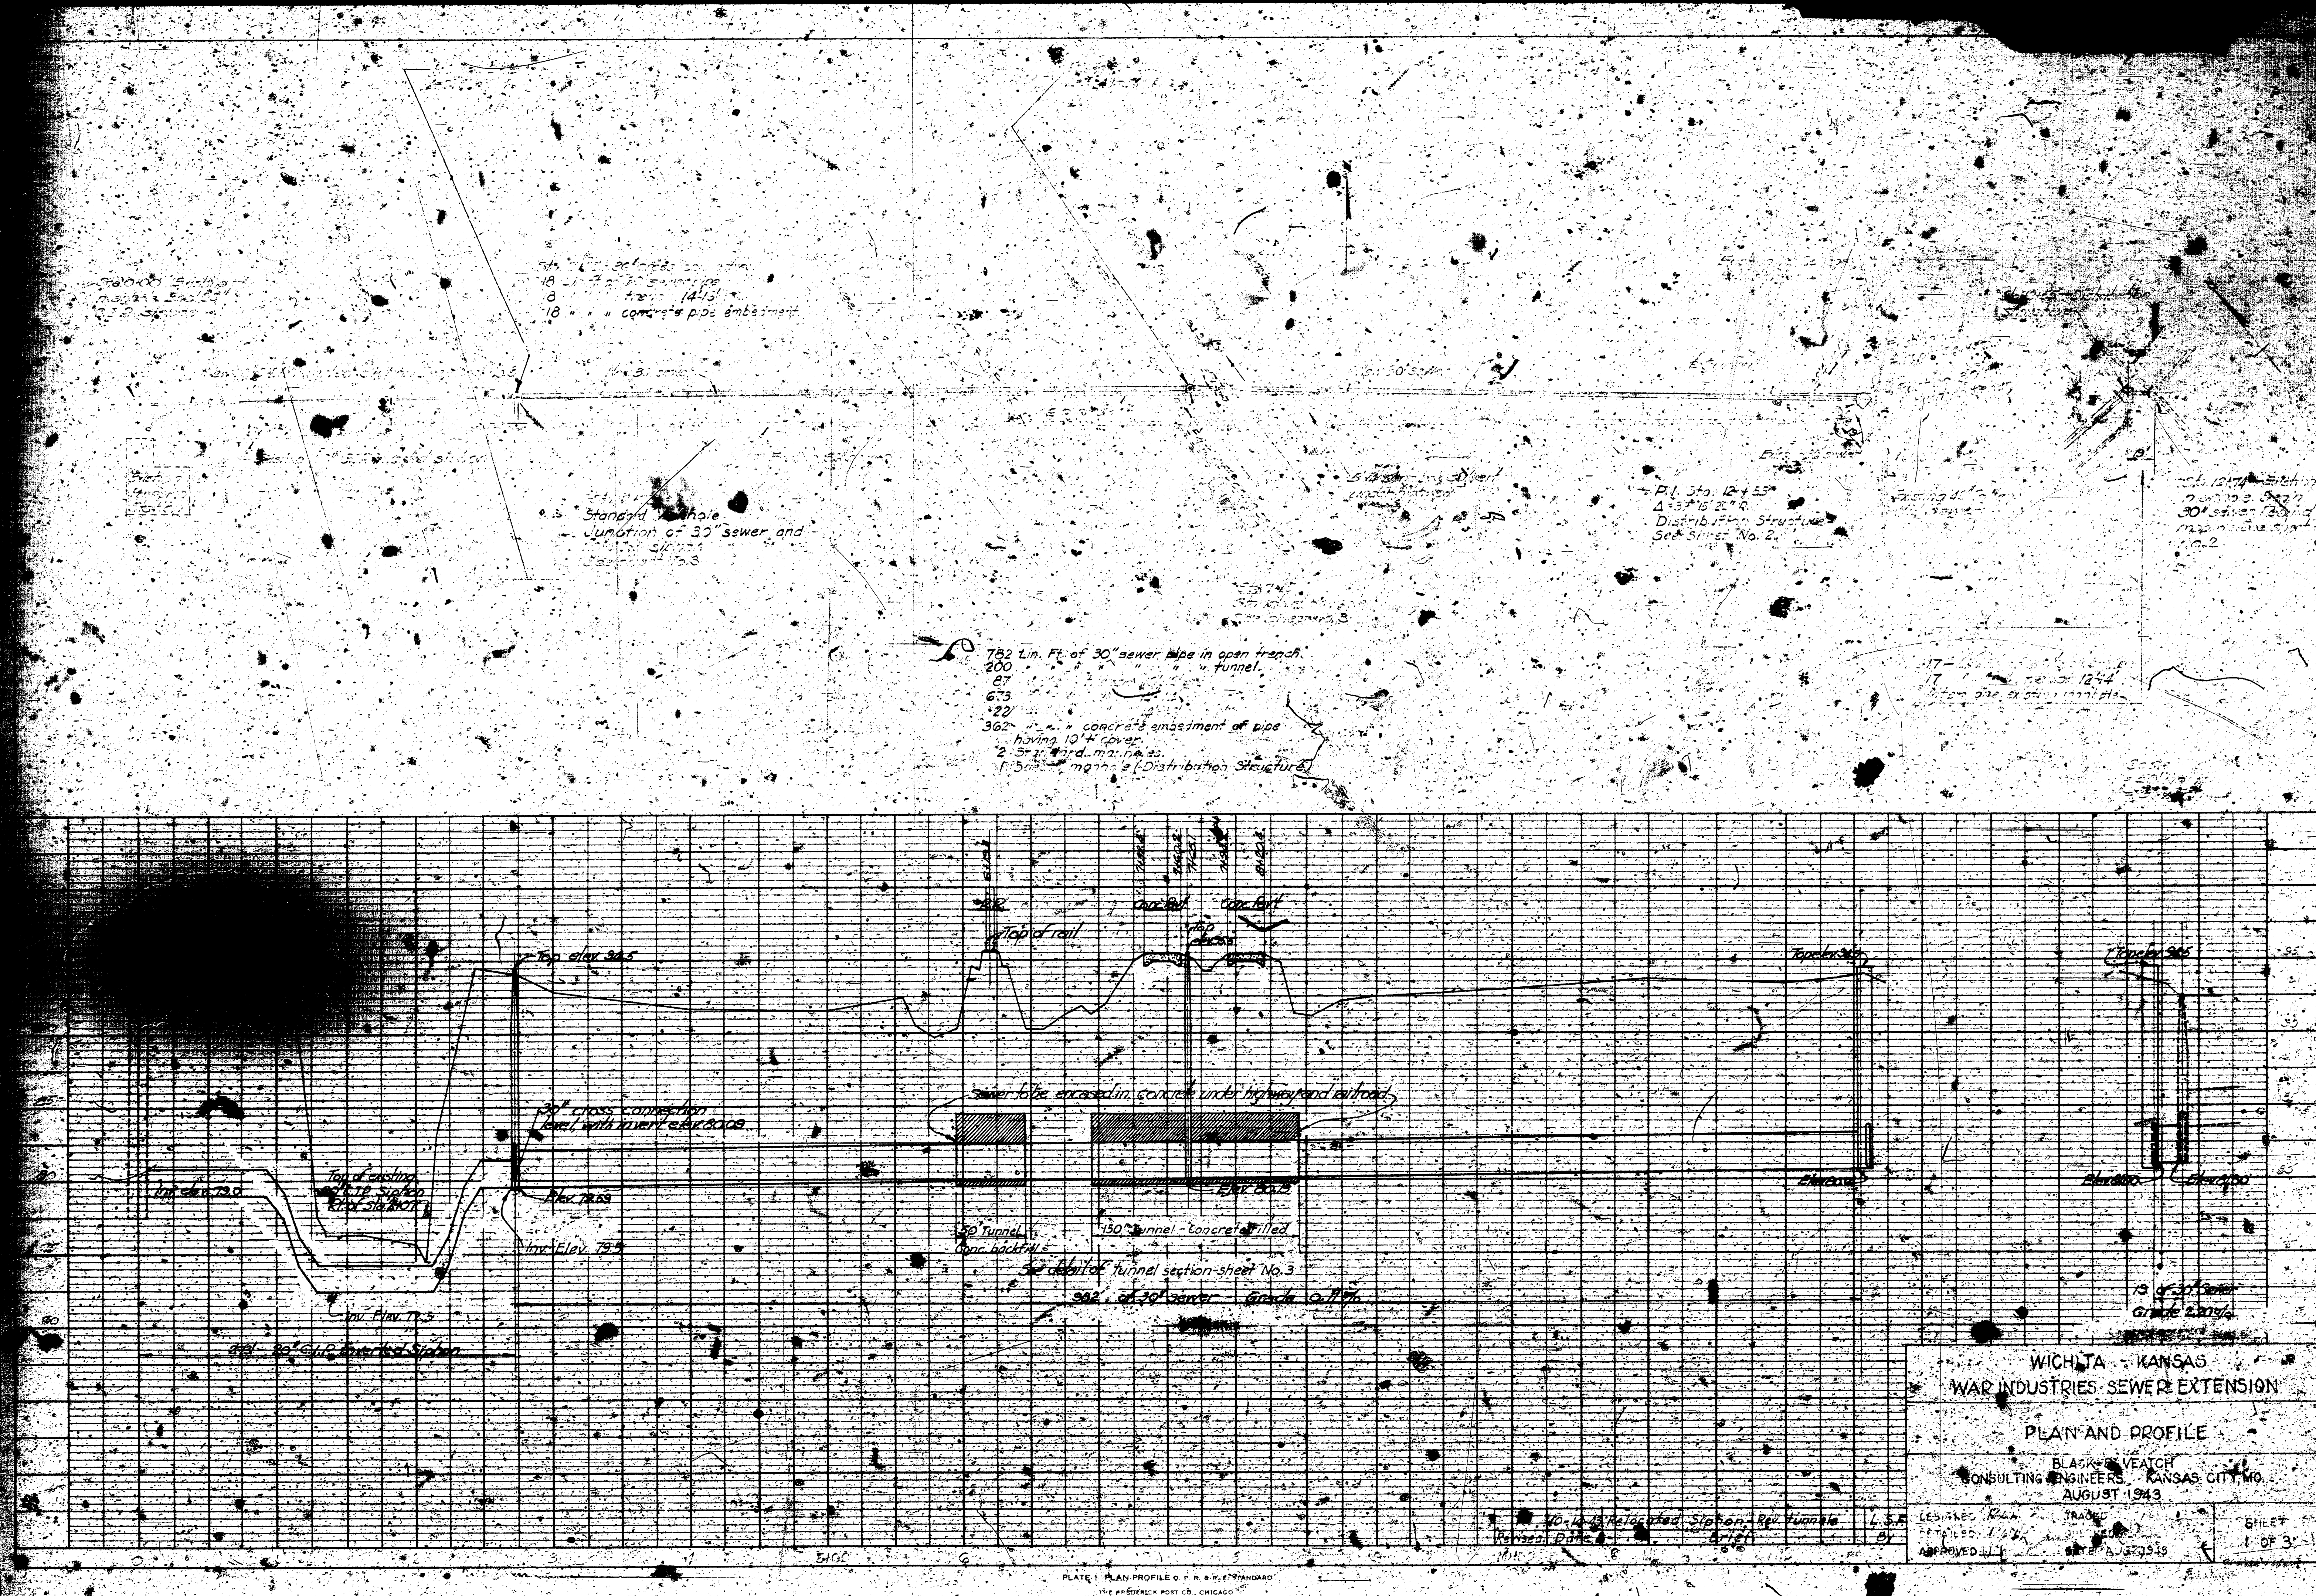

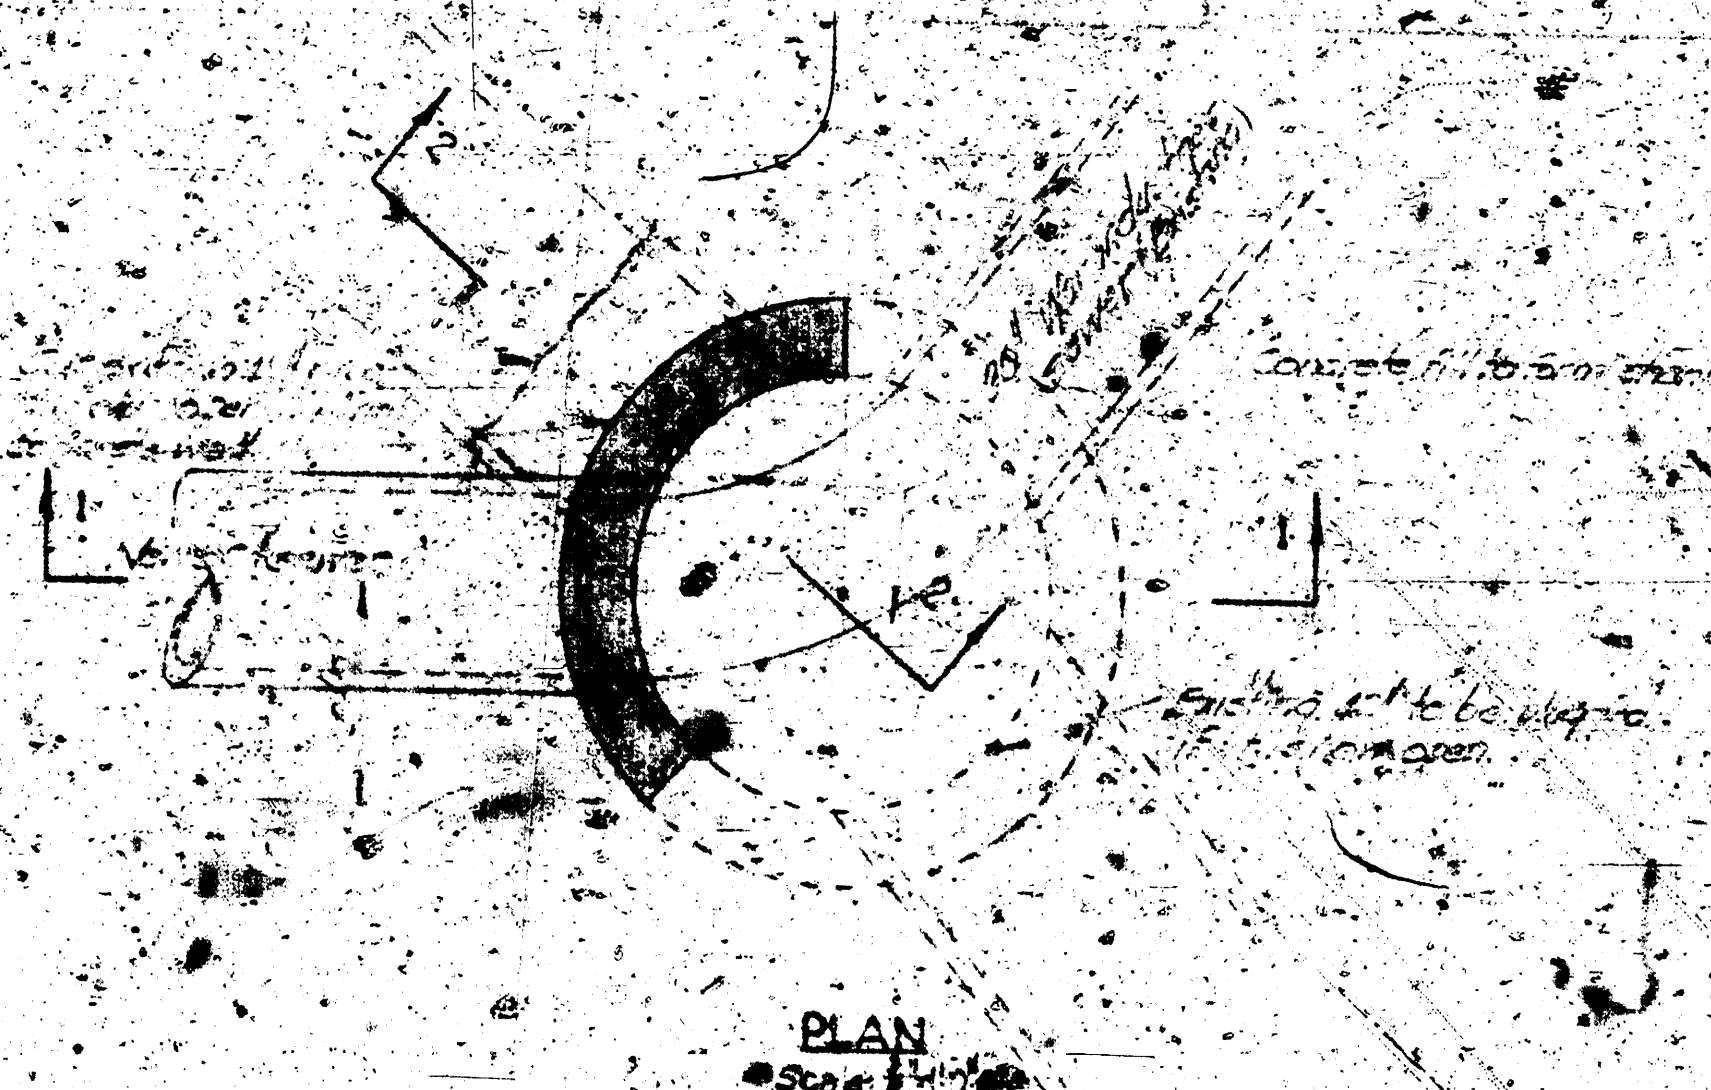


PLAN

 

SECTION 6-8
Scale: 1" = 1'-0"


DETAILS OF 30" SEWER AT EXISTING MANHOLE - STA. 12 + 74

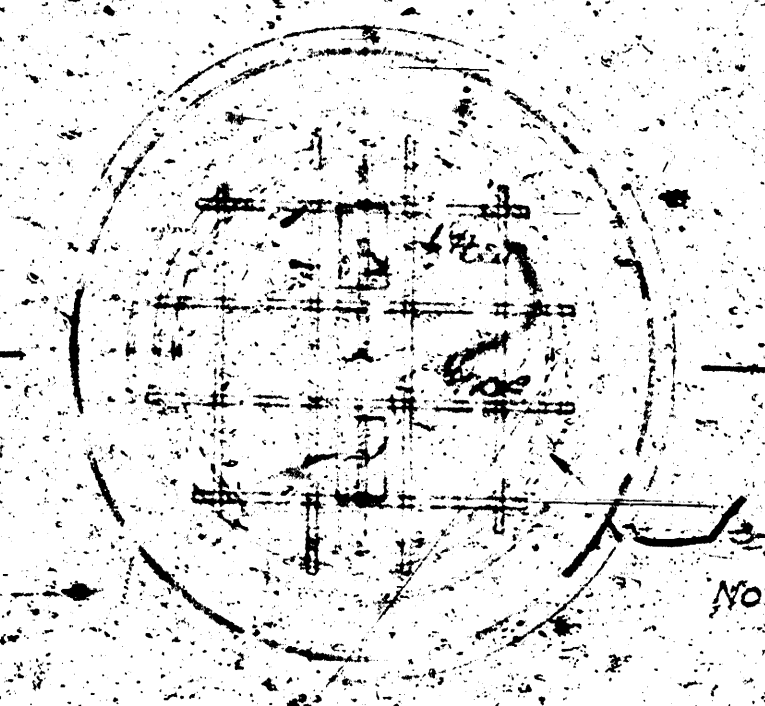

PLAN

Note: Factory built rings & covers,
A.C.S.I. Std. or equal, as per
specifications may be used in
lieu of design indicated.

10-14-49	Added M. Hunkle & Stationing	1	5
Revised	Date	By	
WICHITA KANSAS WAR INDUSTRIES SEWER EXTENSION DISTRIBUTION STRUCTURE AND MANHOLE DETAILS BLACK & VEATCH CONSULTING ENGINEERS KANSAS CITY, MO AUGUST 1943			
DESIGNED	TRACER	SHEET	
DETAILS	CHECKED	2 OF 3	
APPROVED	DATE AUGUST		

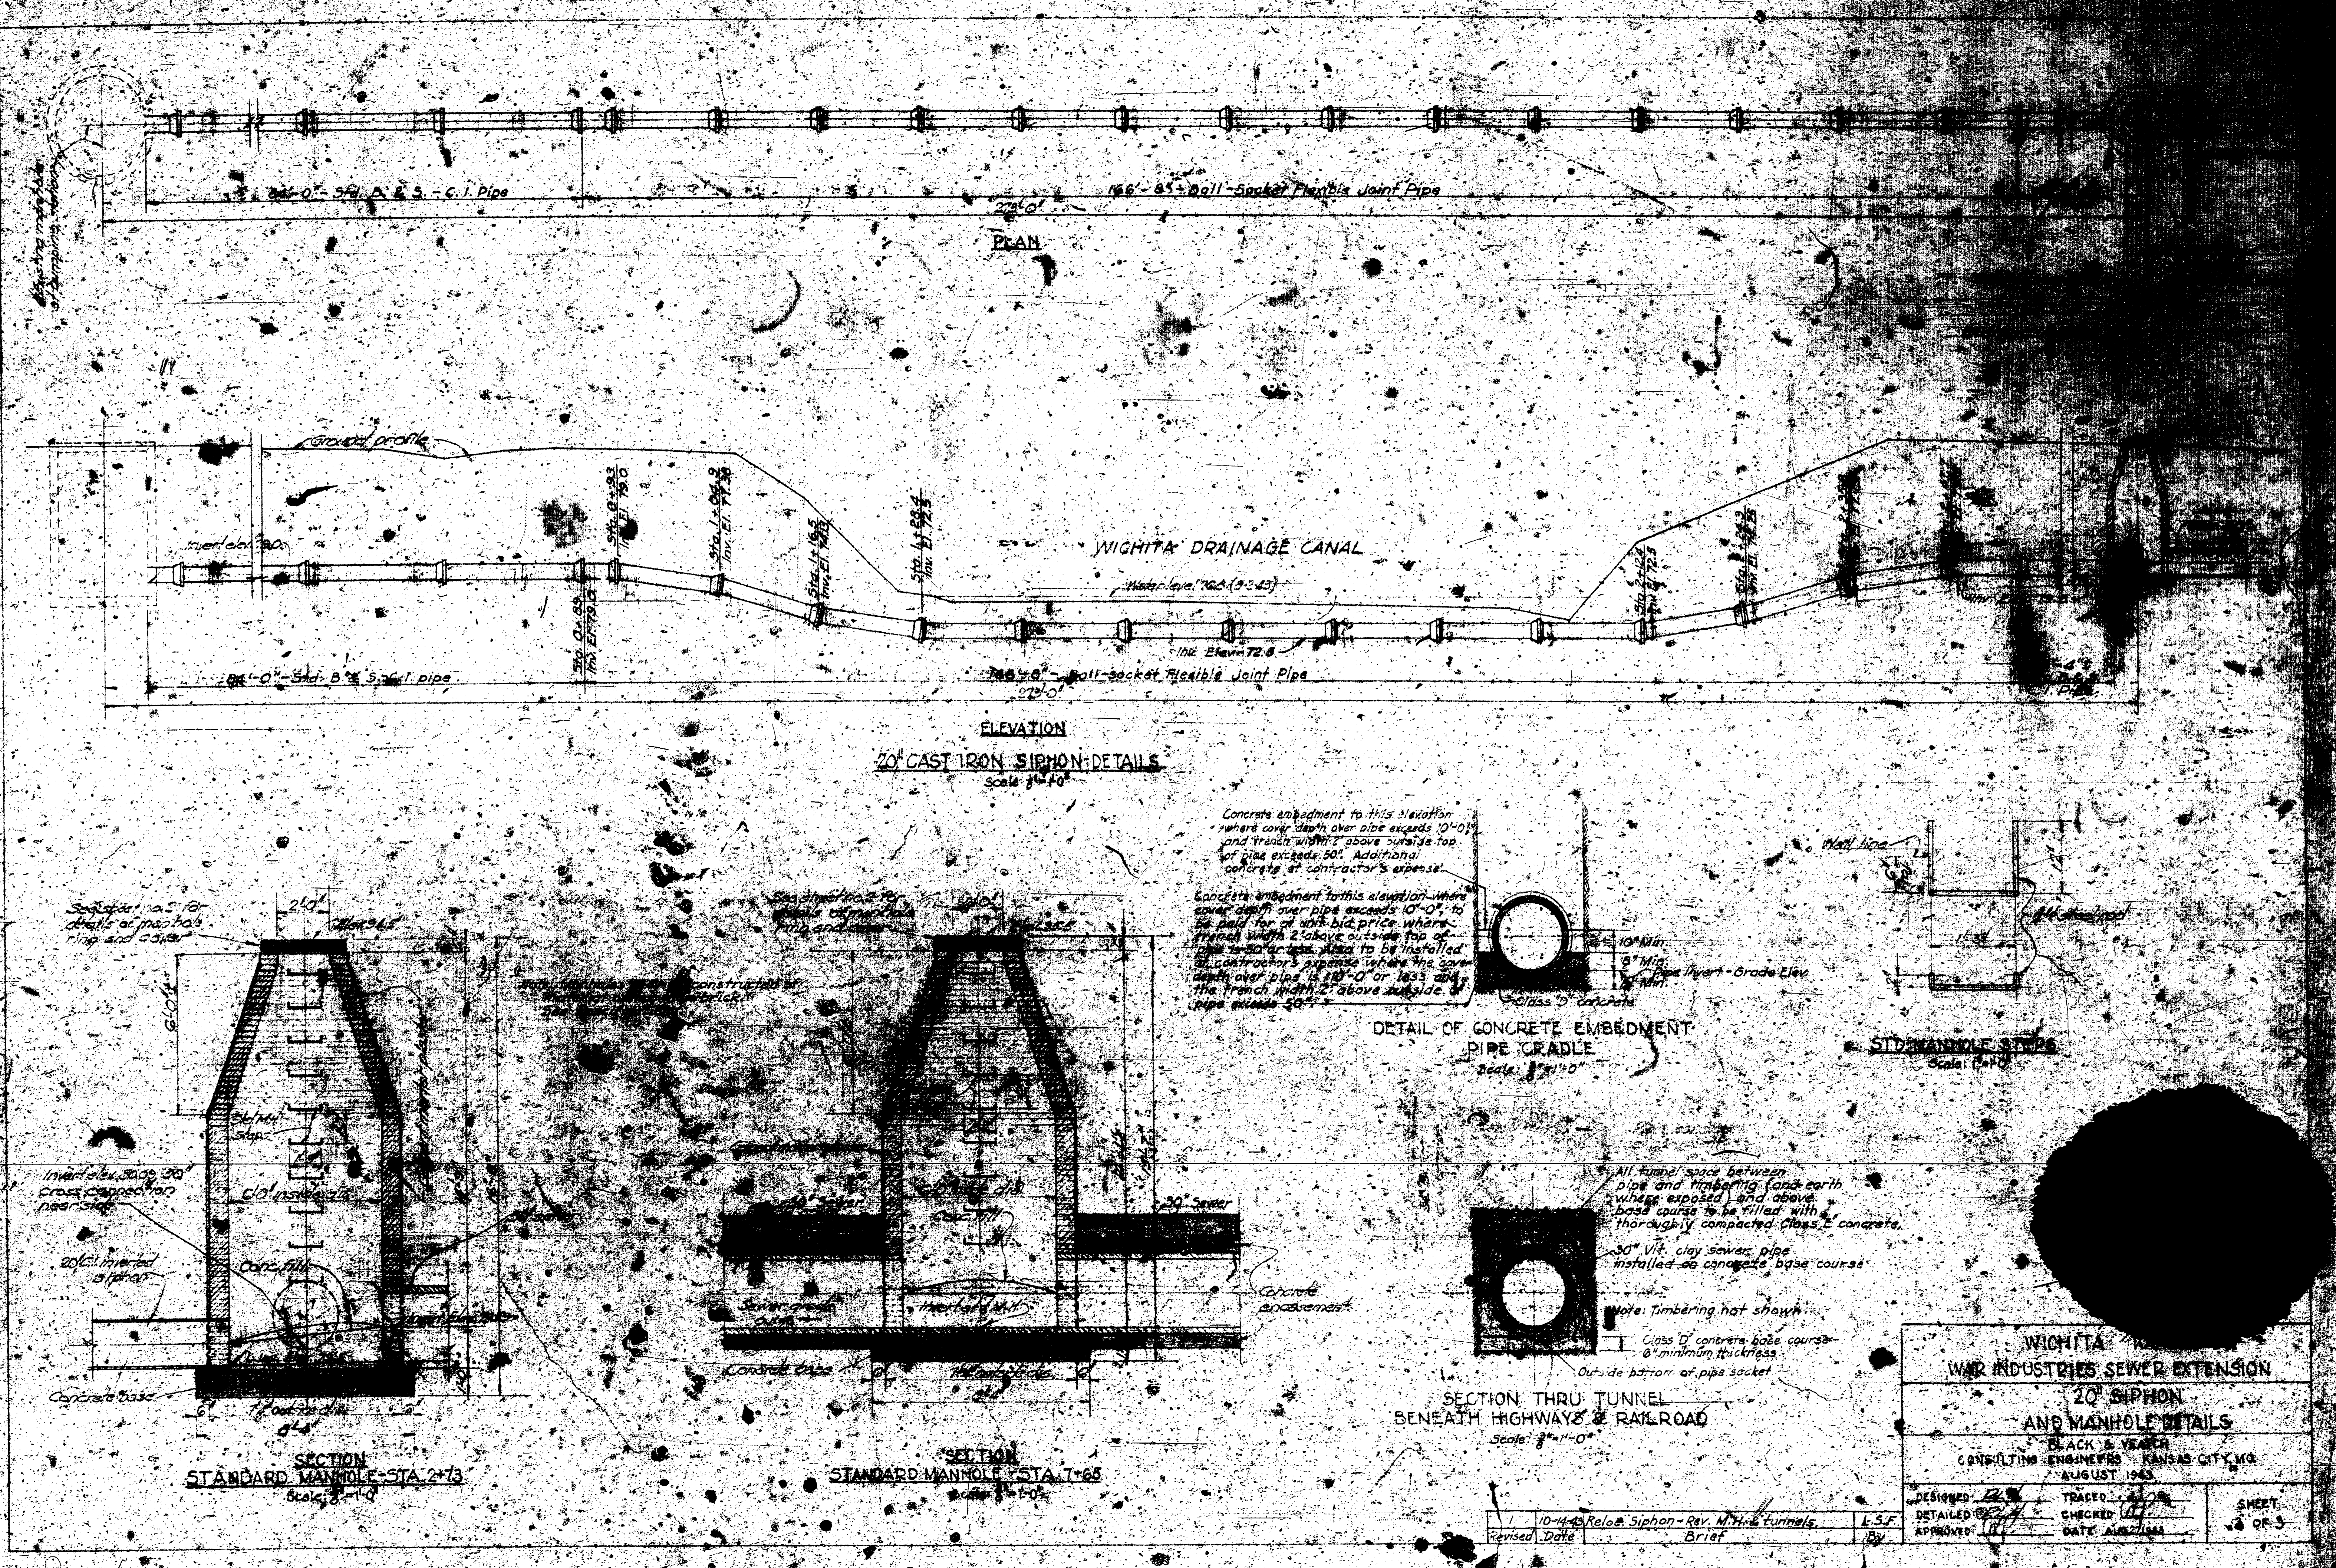

WICHITA			
WAR INDUSTRIES SEWER EXTENSION			
20" SIPHON			
AND MANHOLE DETAILS			
BLACK & VEATCH			
CONSULTING ENGINEERS KANSAS CITY, MO.			
AUGUST 1943			
DESIGNED BY	TRACED BY	SHEET	
DETAILED BY	CHECKED BY	48 OF 5	
APPROVED BY	DATE AUG 21 1944		

10-44-Reloc Siphon - Rev. N. H. H. Tunnels. L.S.F.
Revised Date Brief