


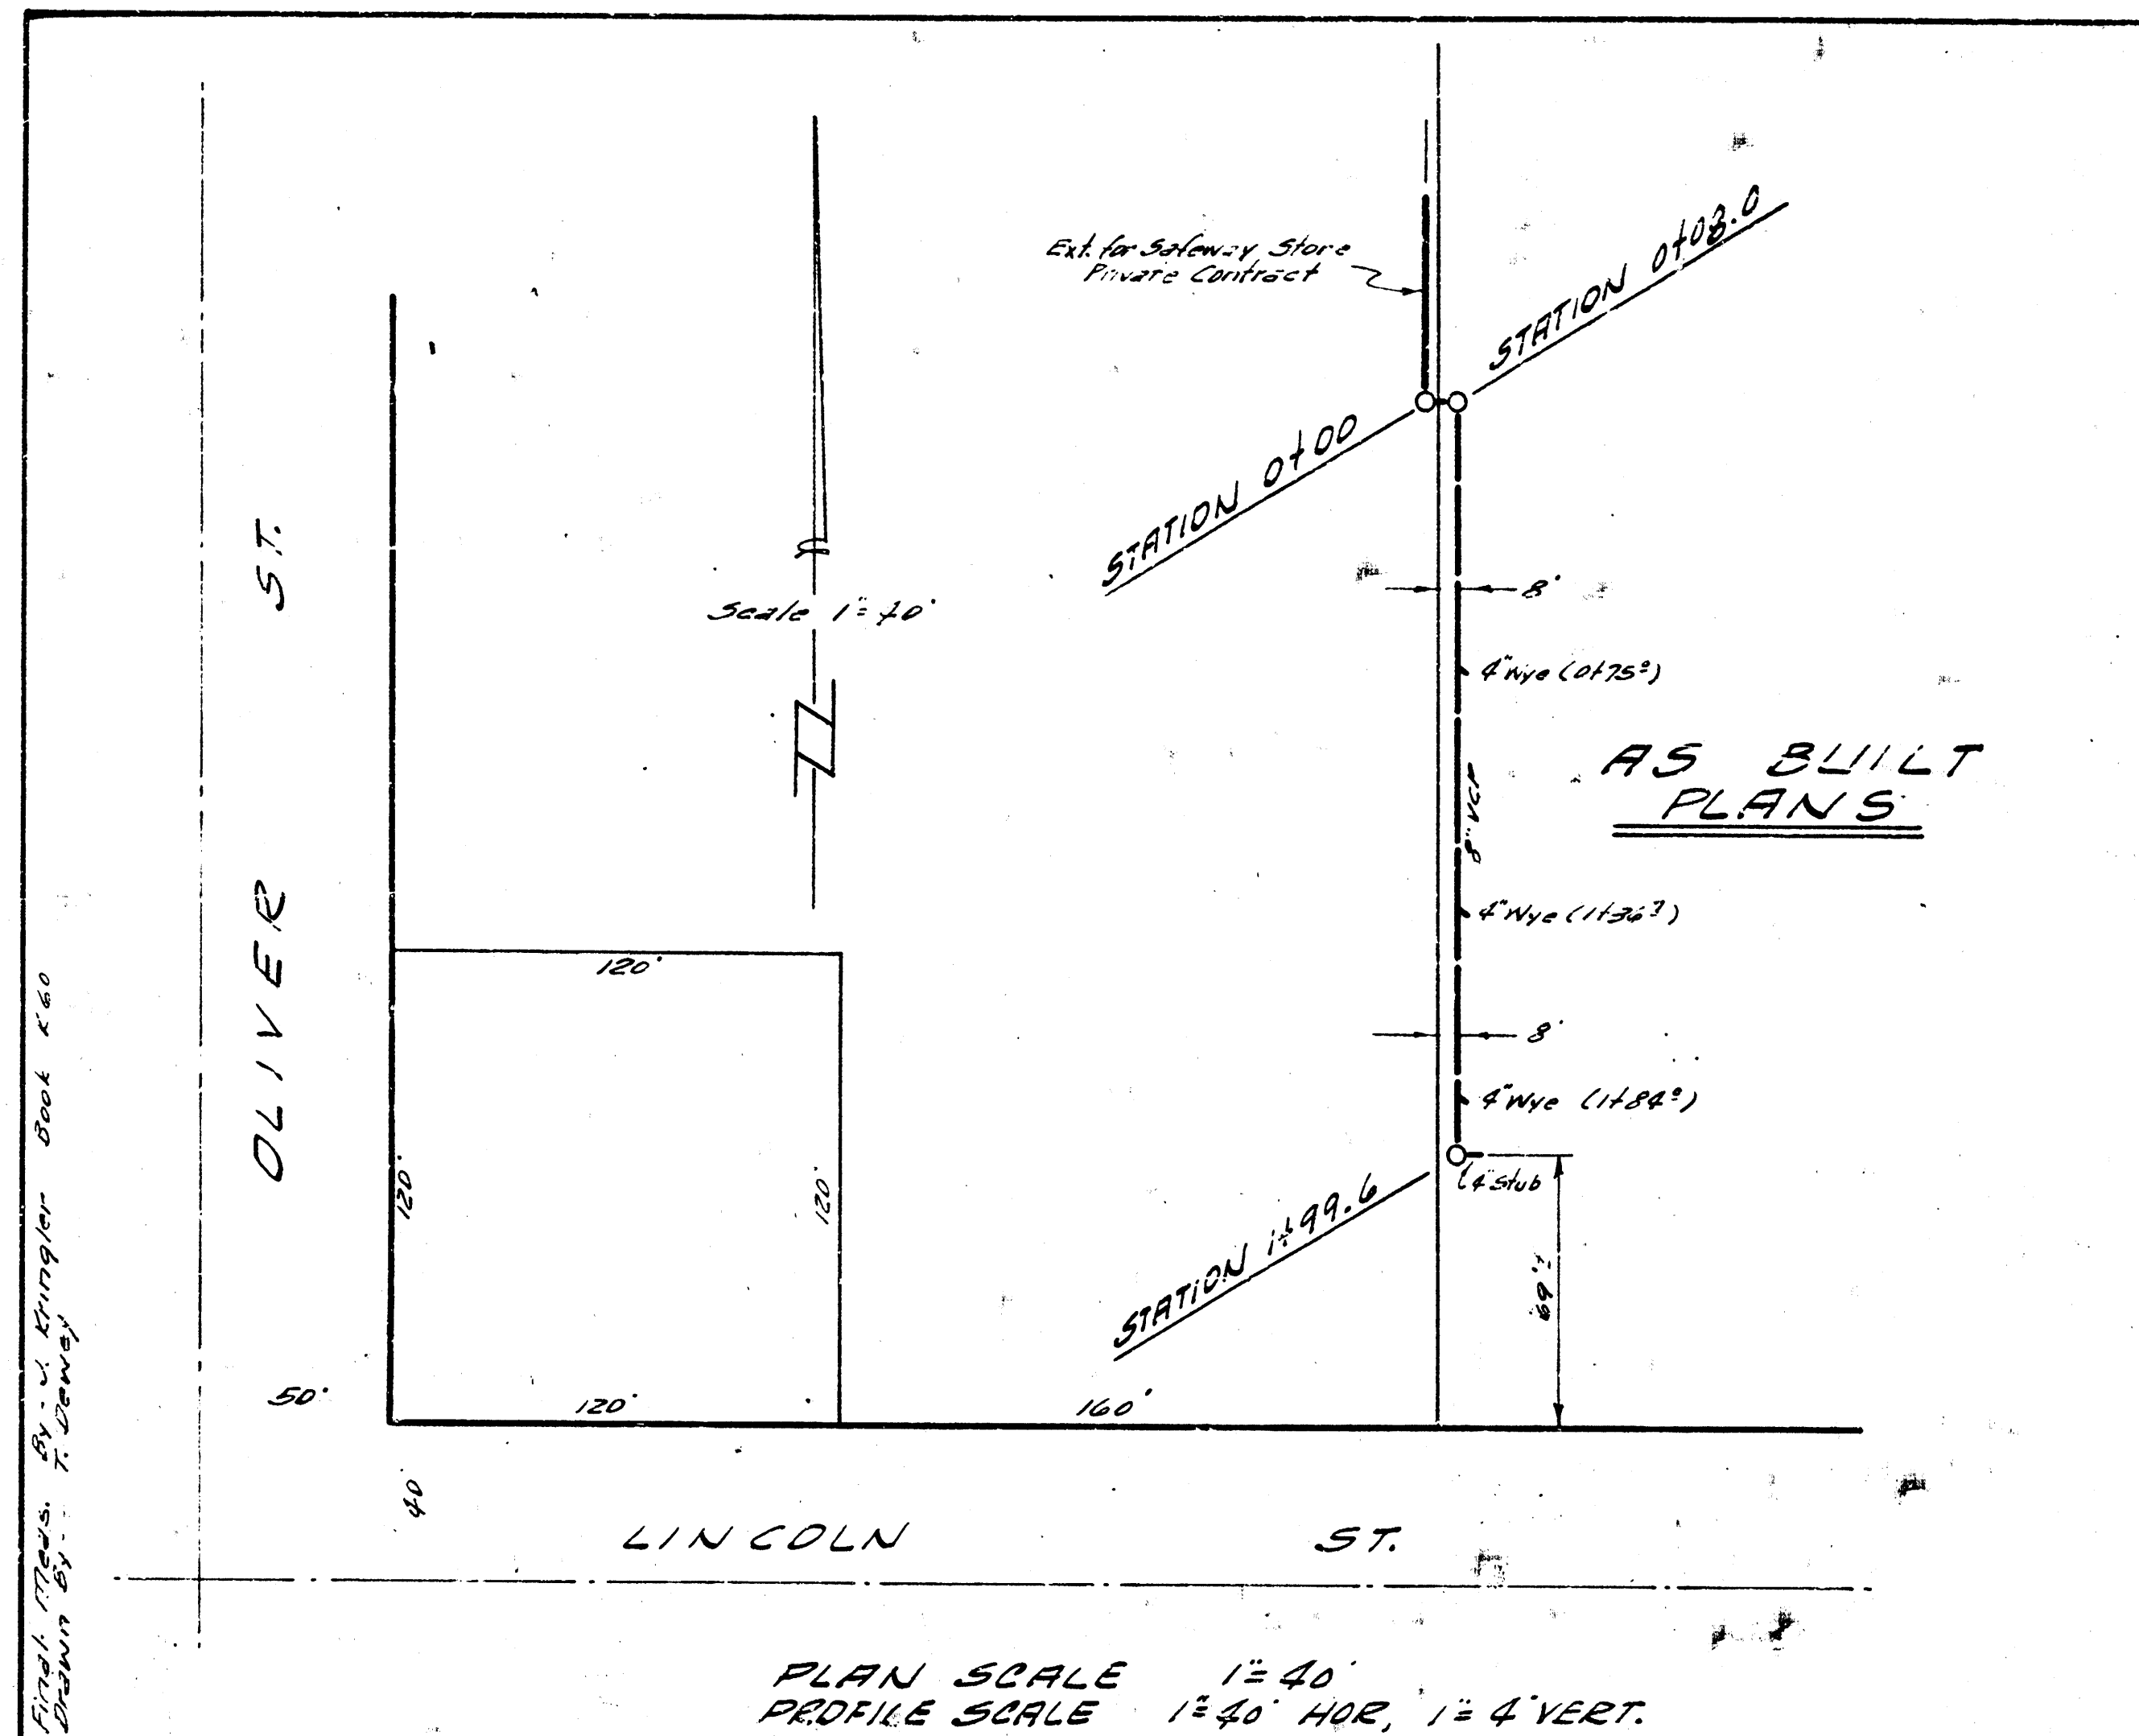


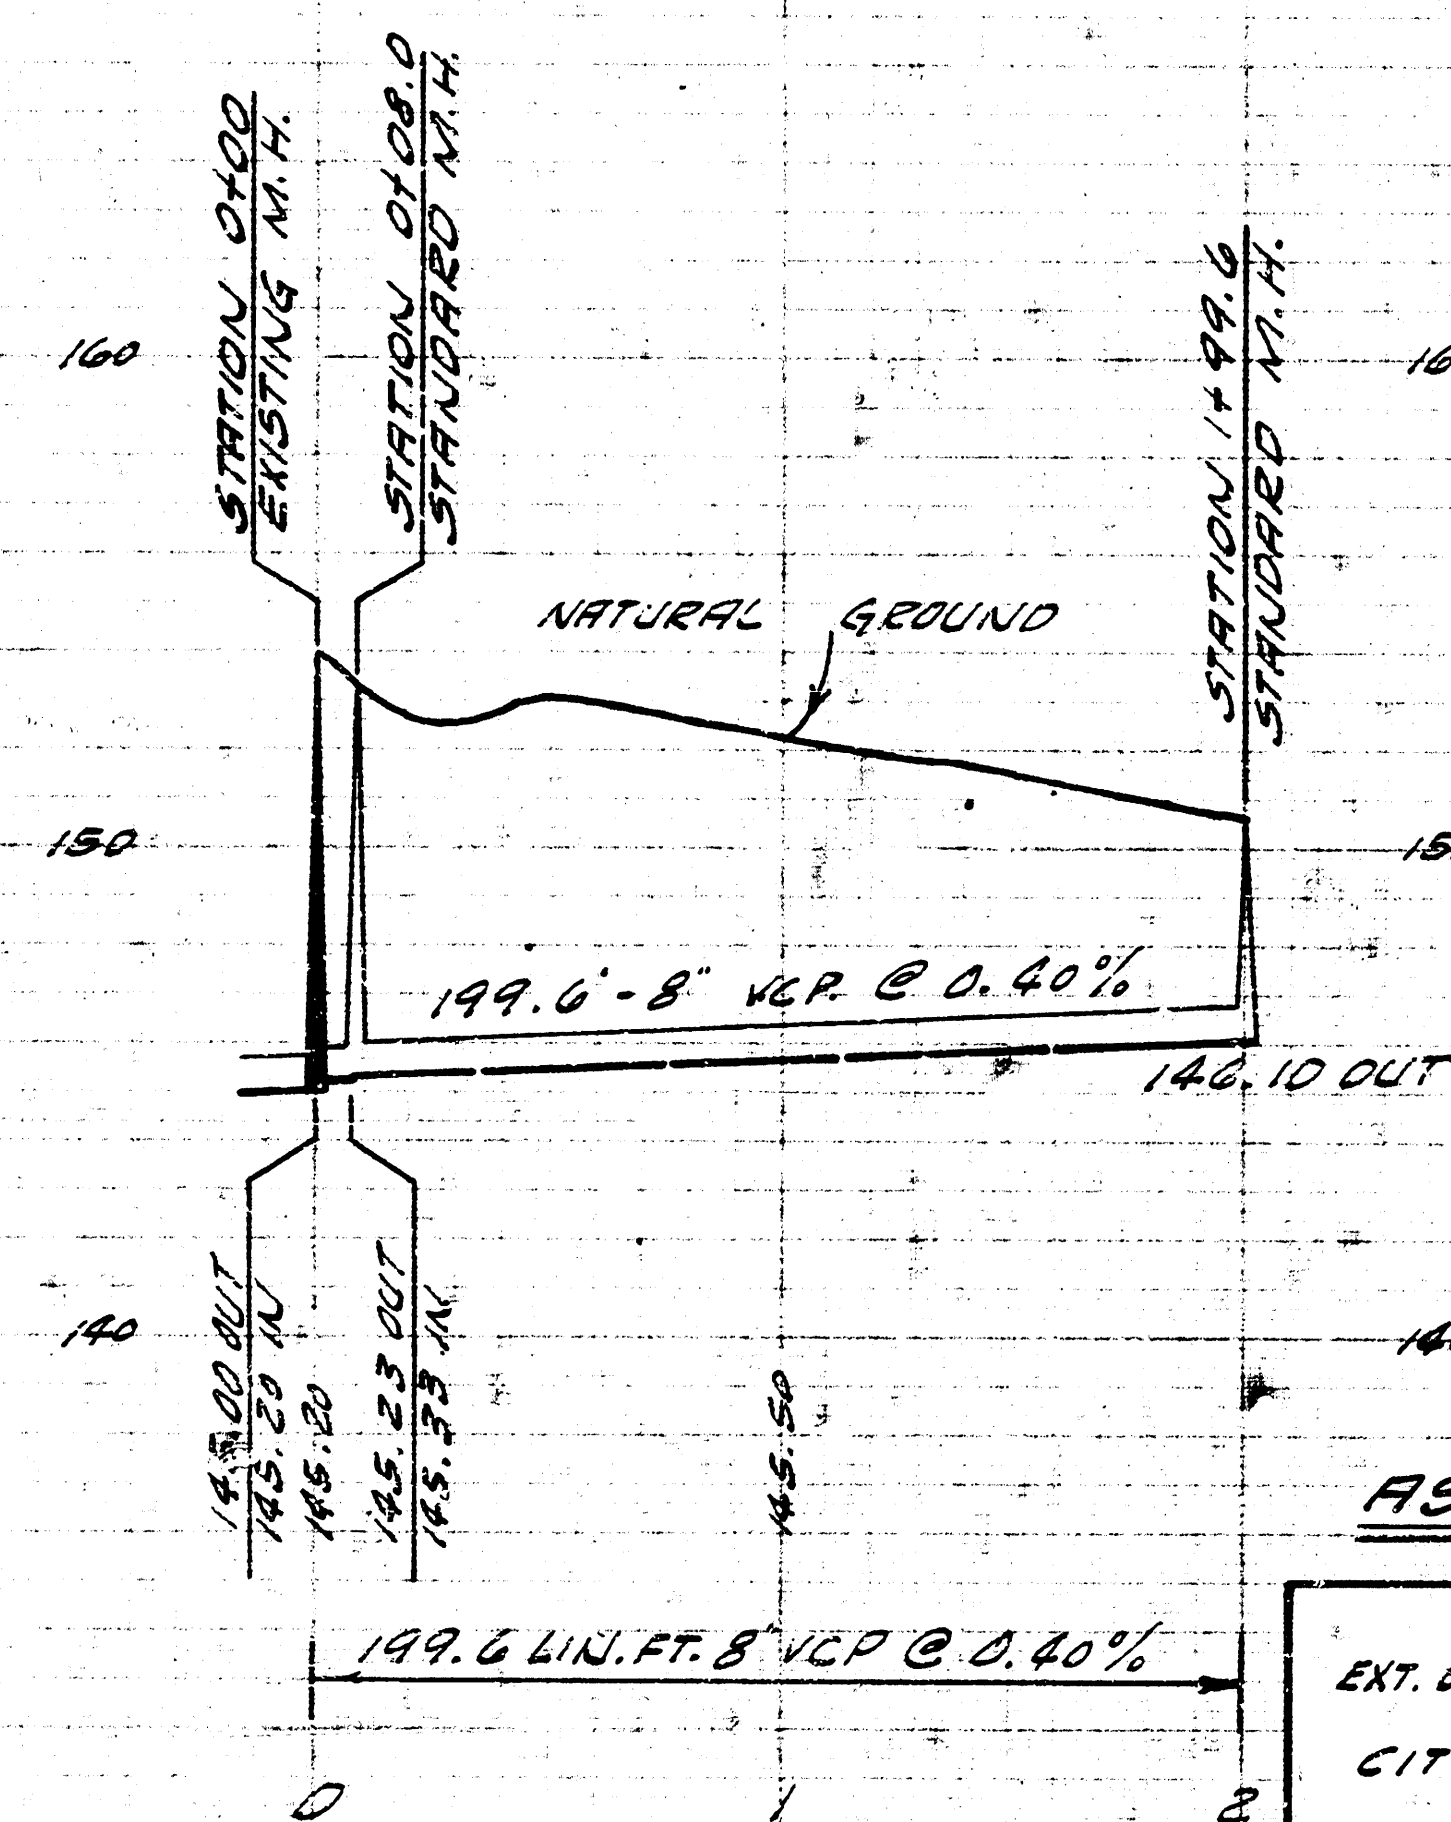

PLAN SCALE 1" = 40'
PROFILE SCALE 1" = 40' HOR, 1" = 4' VERT.

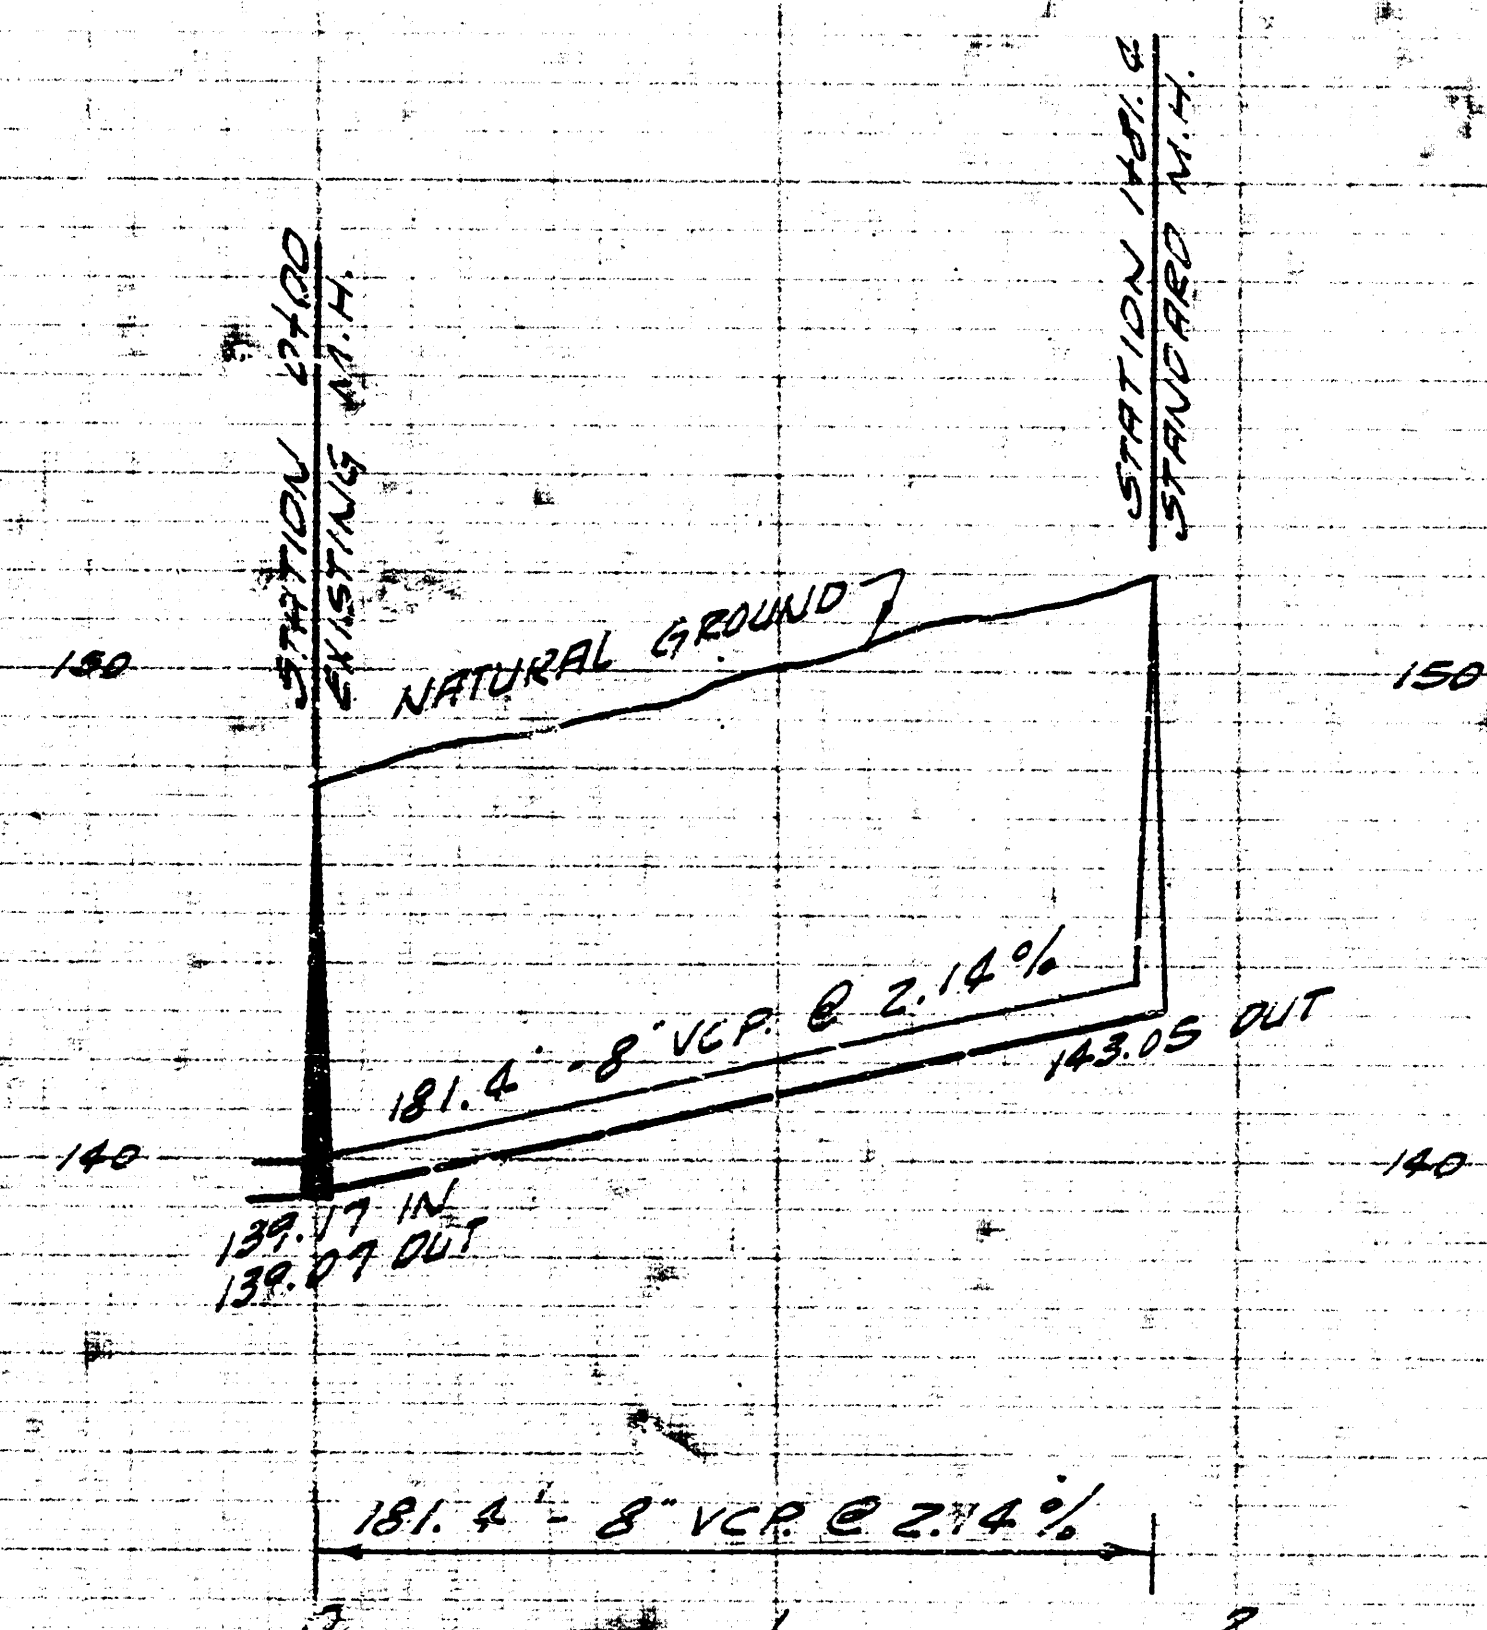

EXT. OF LAT. 33 DCS SS 12
CITY OF WICHITA, KANSAS
B.E. SMITH CITY ENGINEER
PRIVATE JOB. OCT. 1960

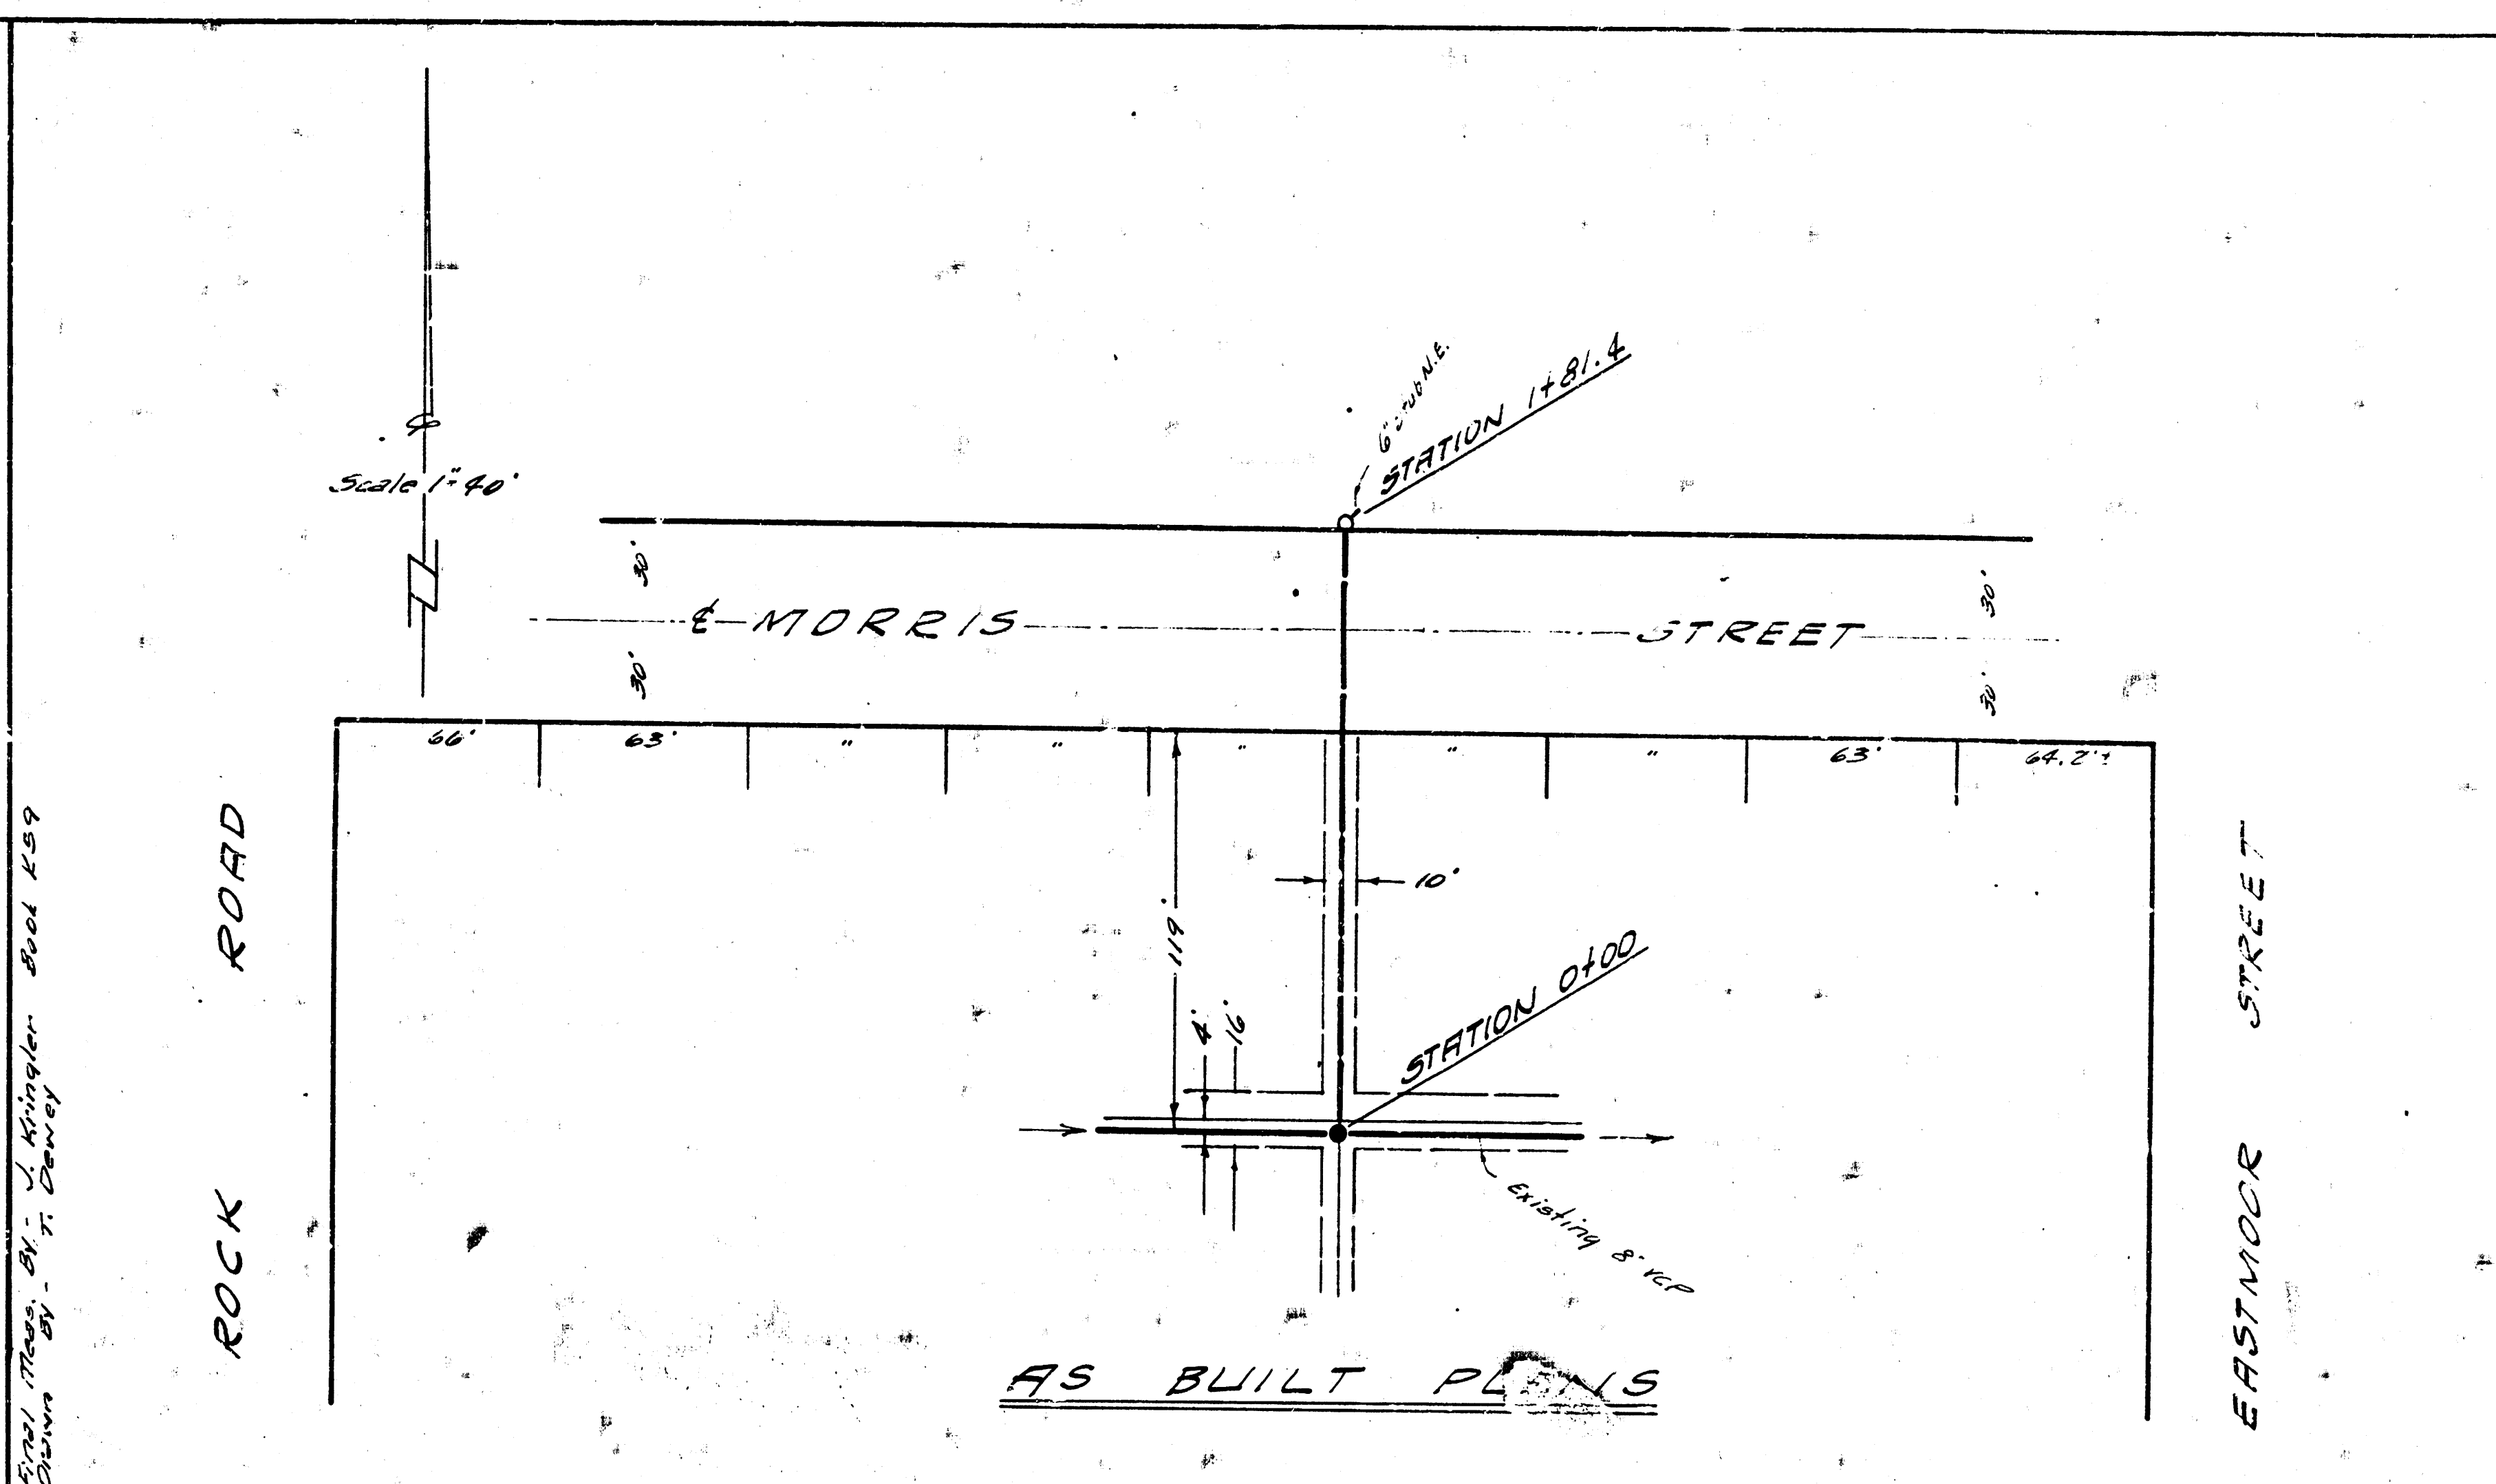

EXT. OF LATERAL 23 WIS
CITY OF WICHITA, KANSAS
B.E. SMITH CITY ENGINEER
PRIVATE JOB. OCT. 1960