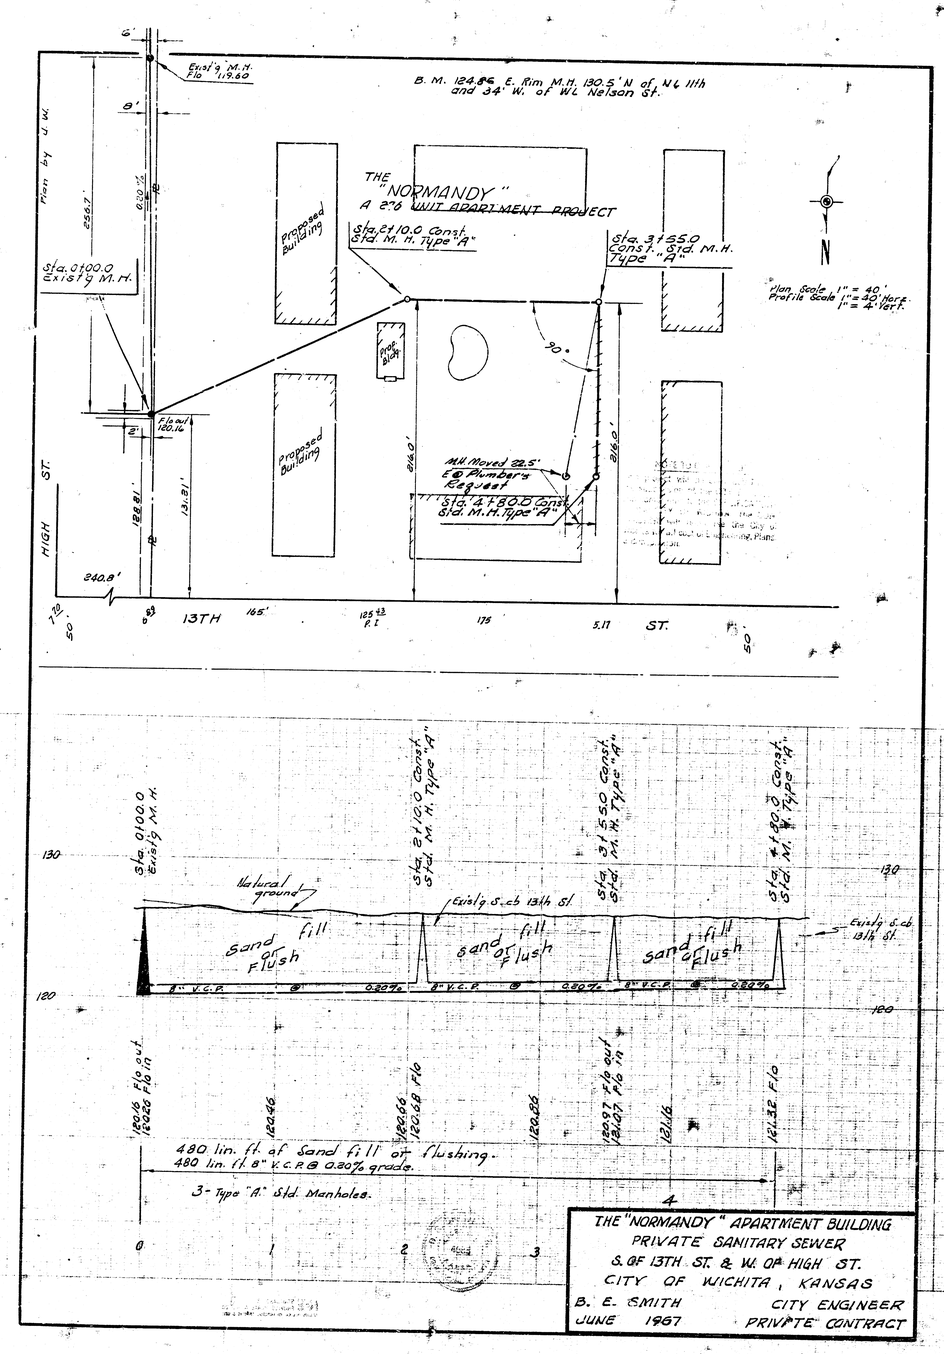
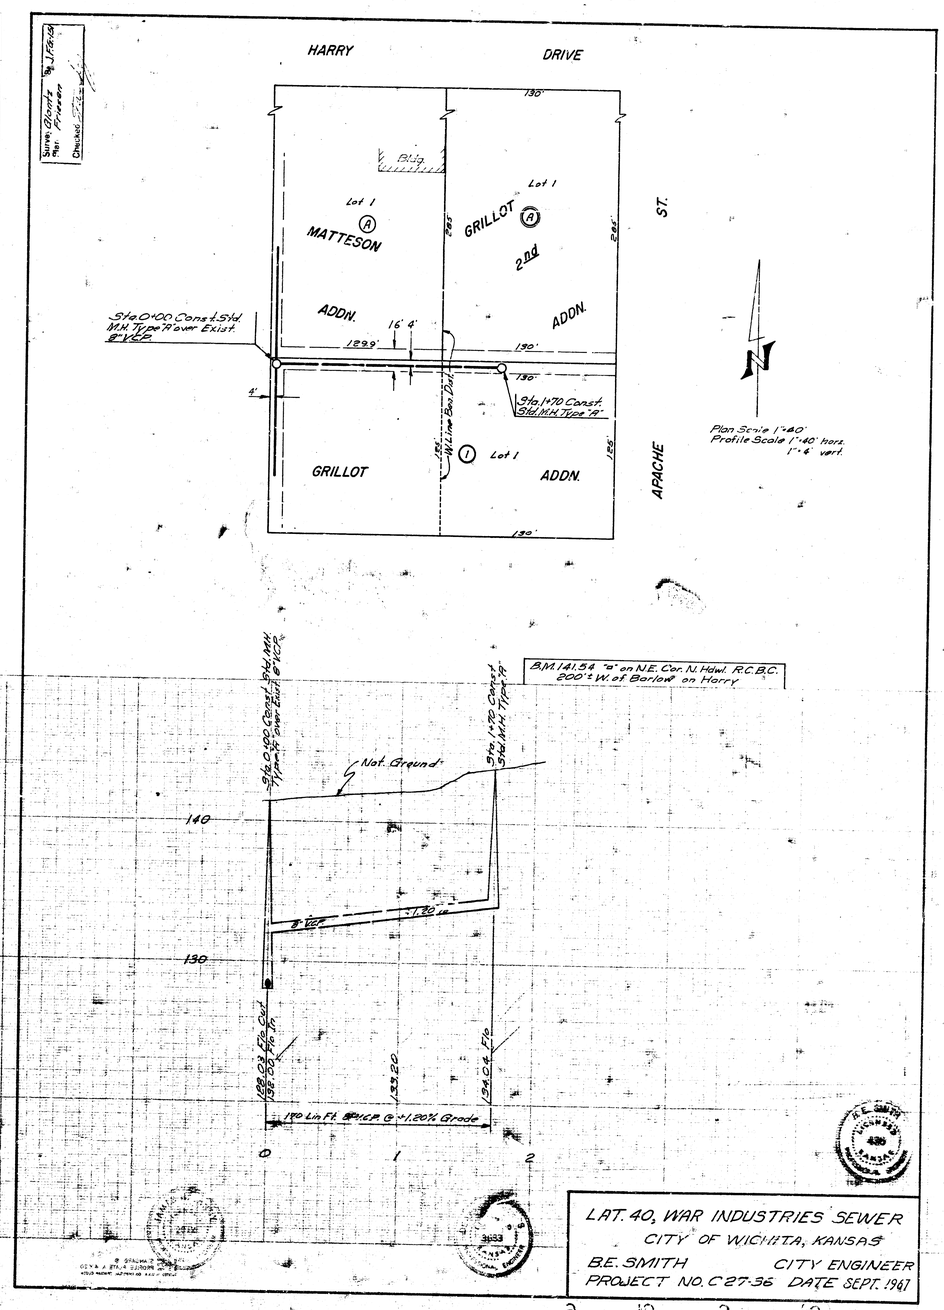

B. M. 124.85 E. Rim M.H. 130.5' N. of N.L. 11th and 34' W. of W.L. Nelson St.
Existing M.H. Flo 1,19.60
THE "NORMANDY"
A 276 UNIT APARTMENT PROJECT
Sta. 2+10.0 Const. Std. M.H. Type "A"
Sta. 3+55.0 Const. Std. M.H. Type "A"
Sta. 0+00.0 Existing M.H.
Proposed Building
Plot Plan
Plan Scale 1" = 40'
Profile Scale 1" = 40' Horz.
1" = 4' Vert.
90°
M.H. Moved 22.5' E @ Plumber's Request
Sta. 4+80.0 Const. Std. M.H. Type "A"
HIGH ST.
13TH
ST.
240.8'
165'
178'
Natural ground
Existing S.cb 13th St.
Sand fill or flush
8" V.C.P. @ 0.20%
Sta. 0+00.0 Existing M.H.
Sta. 2+10.0 Const. Std. M.H. Type "A"
Sta. 3+55.0 Const. Std. M.H. Type "A"
Sta. 4+80.0 Const. Std. M.H. Type "A"
480 lin. ft. of Sand fill or flushing.
480 lin. ft. 8" V.C.P. @ 0.20% grade.
3- Type "A" Std. Manholes.
THE "NORMANDY" APARTMENT BUILDING
PRIVATE SANITARY SEWER
S. OF 13TH ST. & W. OF HIGH ST.
CITY OF WICHITA, KANSAS
B. E. SMITH CITY ENGINEER
JUNE 1967 PRIVATE CONTRACT


HARRY DRIVE
APACHE ST.
Bldg.
Lot 1
MATTESON ADDN.
GRILLOT 2nd ADDN.
GRILLOT ADDN.
Sta. 0+00 Const. Std. M.H. Type "A" over Exist. 8" V.C.P.
Sta. 1+70 Const. Std. M.H. Type "A"
W. Line Sec. 20
Plan Scale 1"=40'
Profile Scale 1"=40' Horz.
1"=6' vert.
B.M. 1141.54 "a" on N.E. Cor. N. Howl. R.C.B.C. 200'± W. of Barlow on Harry
Sta. 0+00 Const. Std. M.H. Type "A" over Exist. 8" V.C.P.
Sta. 1+70 Const. Std. M.H. Type "A"
Nat. Ground
8" V.C.P. @ 1.20%
170 Lin. Ft. 8" V.C.P. @ +1.20% Grade
LAT. 40, WAR INDUSTRIES SEWER
CITY OF WICHITA, KANSAS
B.E. SMITH CITY ENGINEER
PROJECT NO. C 27-36 DATE SEPT. 1967