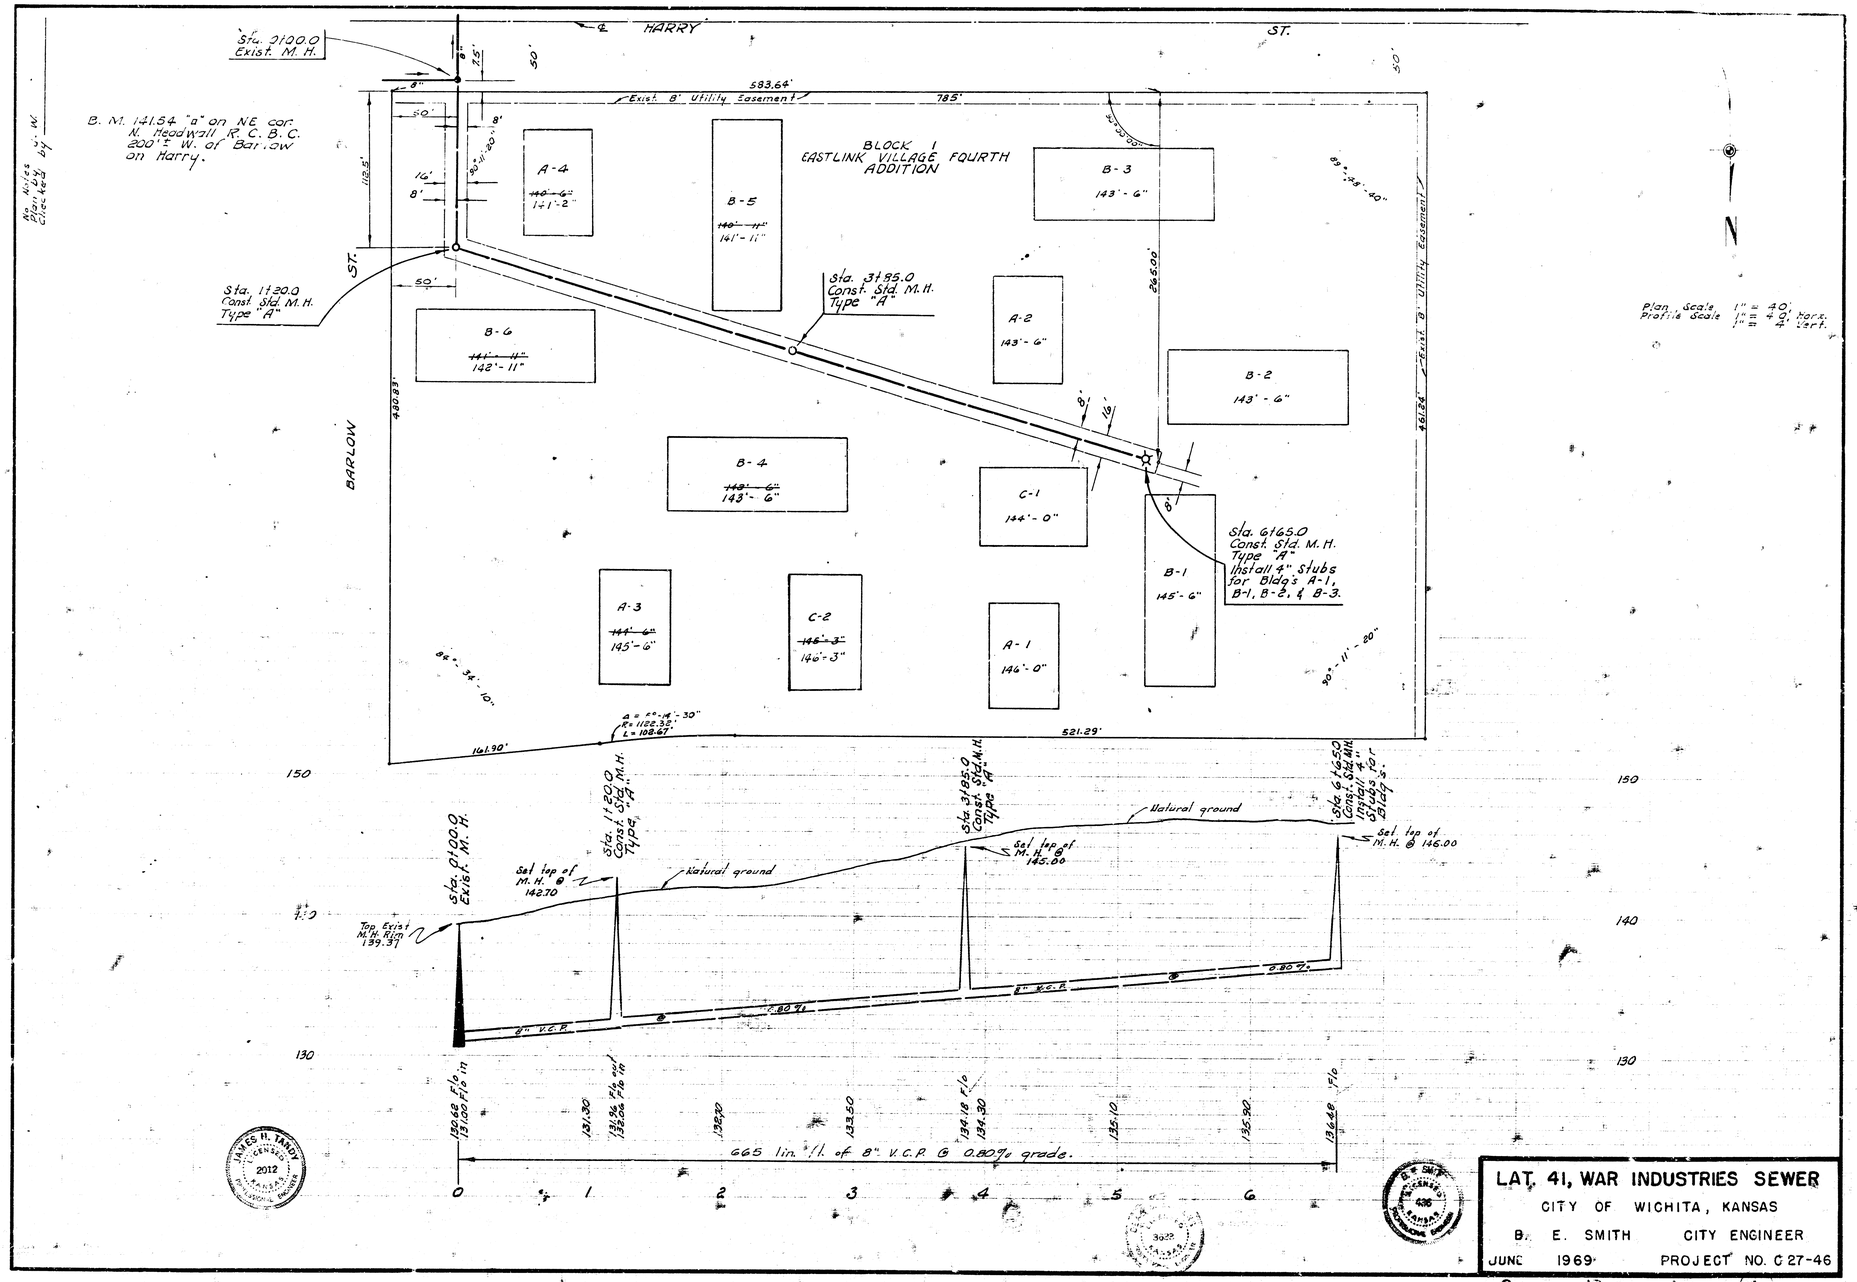

JAMES H. TANDY
LICENSED
2012
KANSAS
PROFESSIONAL ENGINEER

B. E. SMITH
LICENSED
436
KANSAS
PROFESSIONAL ENGINEER

3922
REGISTERED
KANSAS

LAT. 41, WAR INDUSTRIES SEWER

CITY OF WICHITA, KANSAS

B. E. SMITH CITY ENGINEER

JUNE 1969 PROJECT NO. C 27-46