


NOTE TO CONTRACTOR
 This project will be constructed under the supervision of the CITY ENGINEER and conform to the SPECIFICATIONS of the CITY OF WICHITA. The CONTRACTOR will reimburse the City of Wichita for all cost of engineering, plans, and inspection.

Date 11-24-53
 Drawn by McLean
 Checked by T. J. C. Moore
 Plotted by

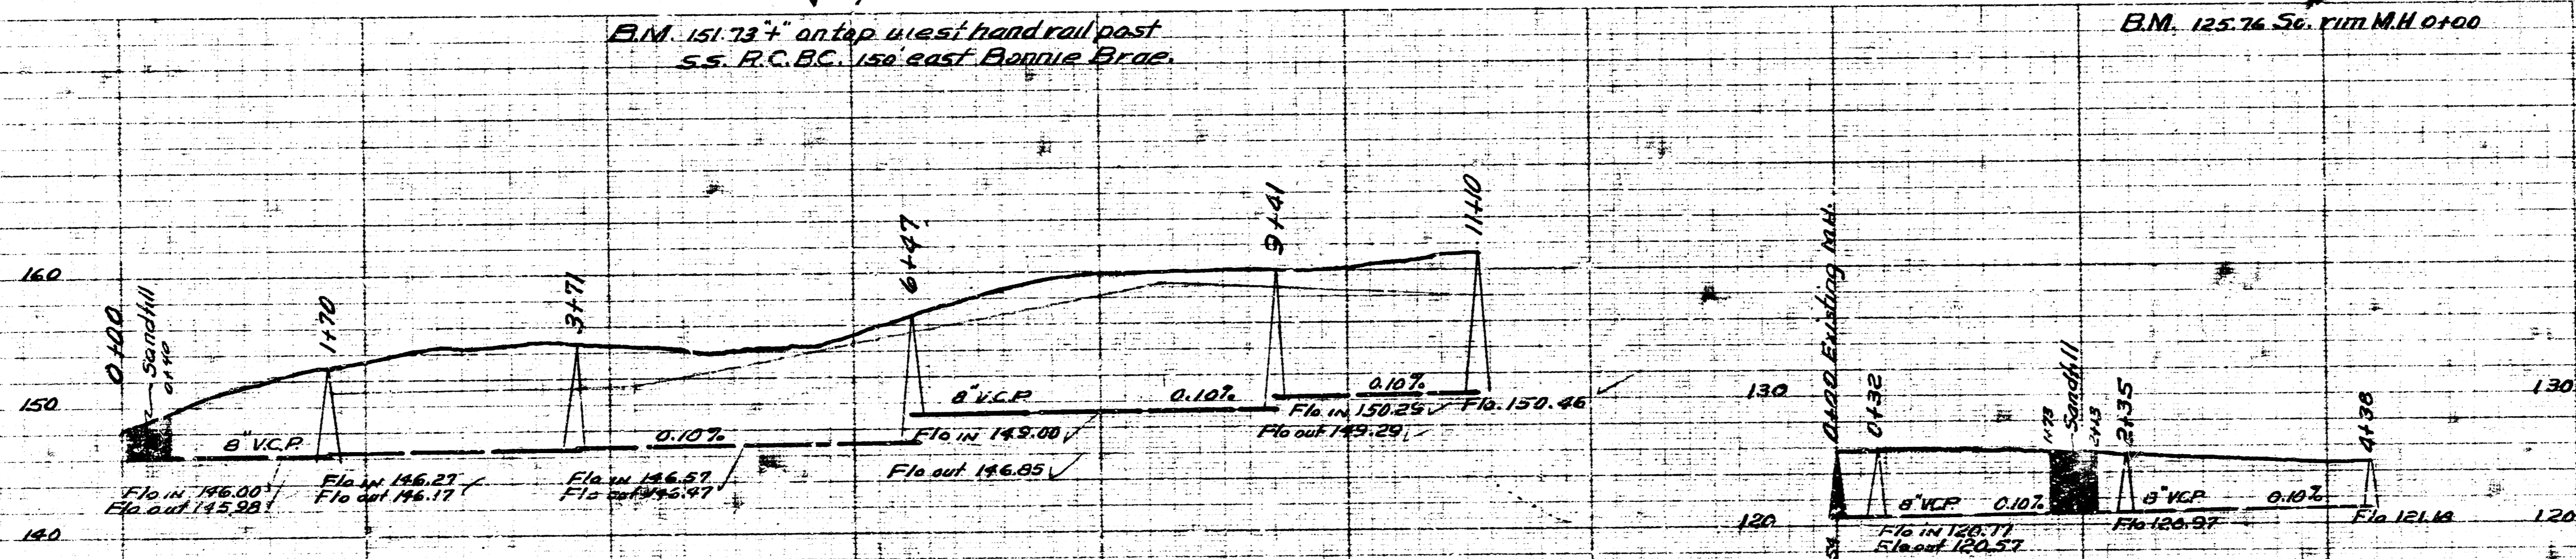

Engineer Note: Check elev. of ^{sewer} at the house on lot 19 if it can be serviced with a 6" line at the rear of the lot. Disregard the 6" stub in Bonnie Brae.

LAT. 5 WLS
 CITY OF WICHITA KANSAS
 BE SMITH CITY ENGINEER
 Proj. No. C-23-59

HENRY ROE CLOUD SCHOOL
 CITY OF WICHITA KANSAS
 PRIVATE SEWER
 BE SMITH CITY ENGINEER