

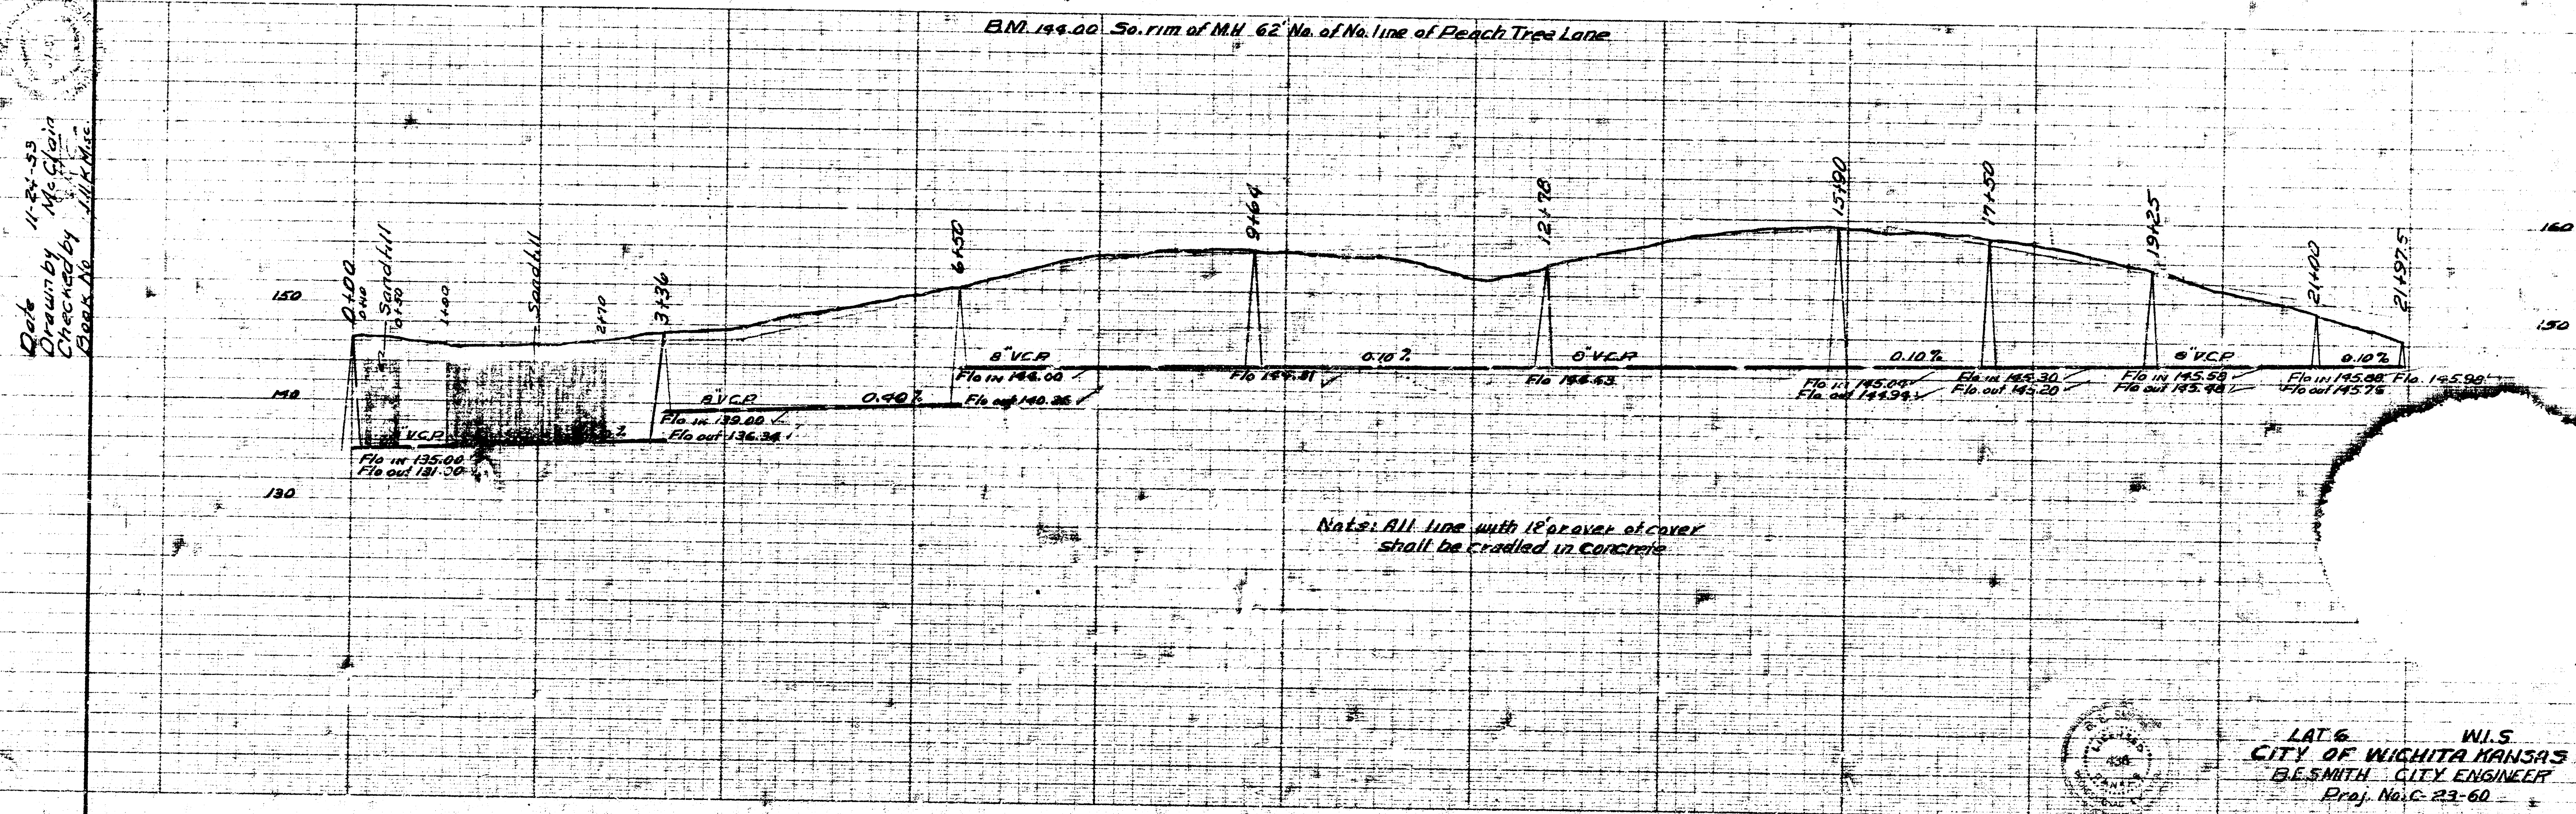


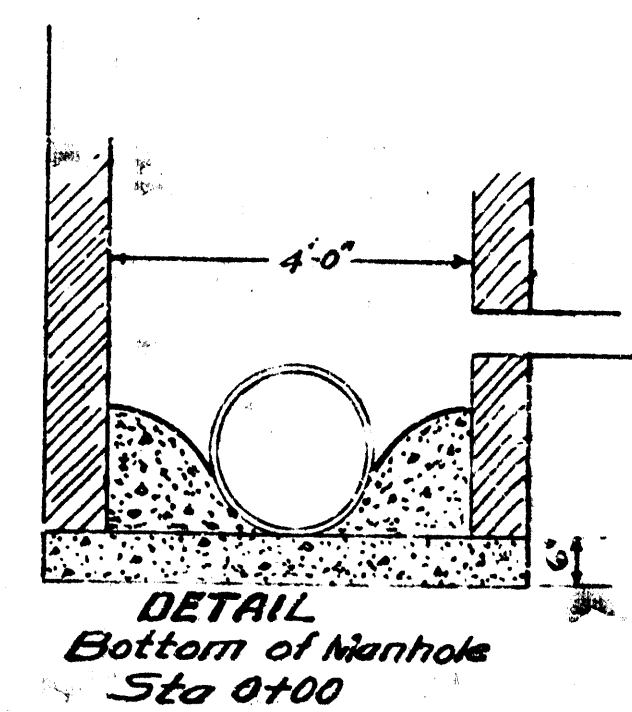

Date 11-24-53
 Drawn by McElain
 Checked by [Signature]
 Plans by [Signature]

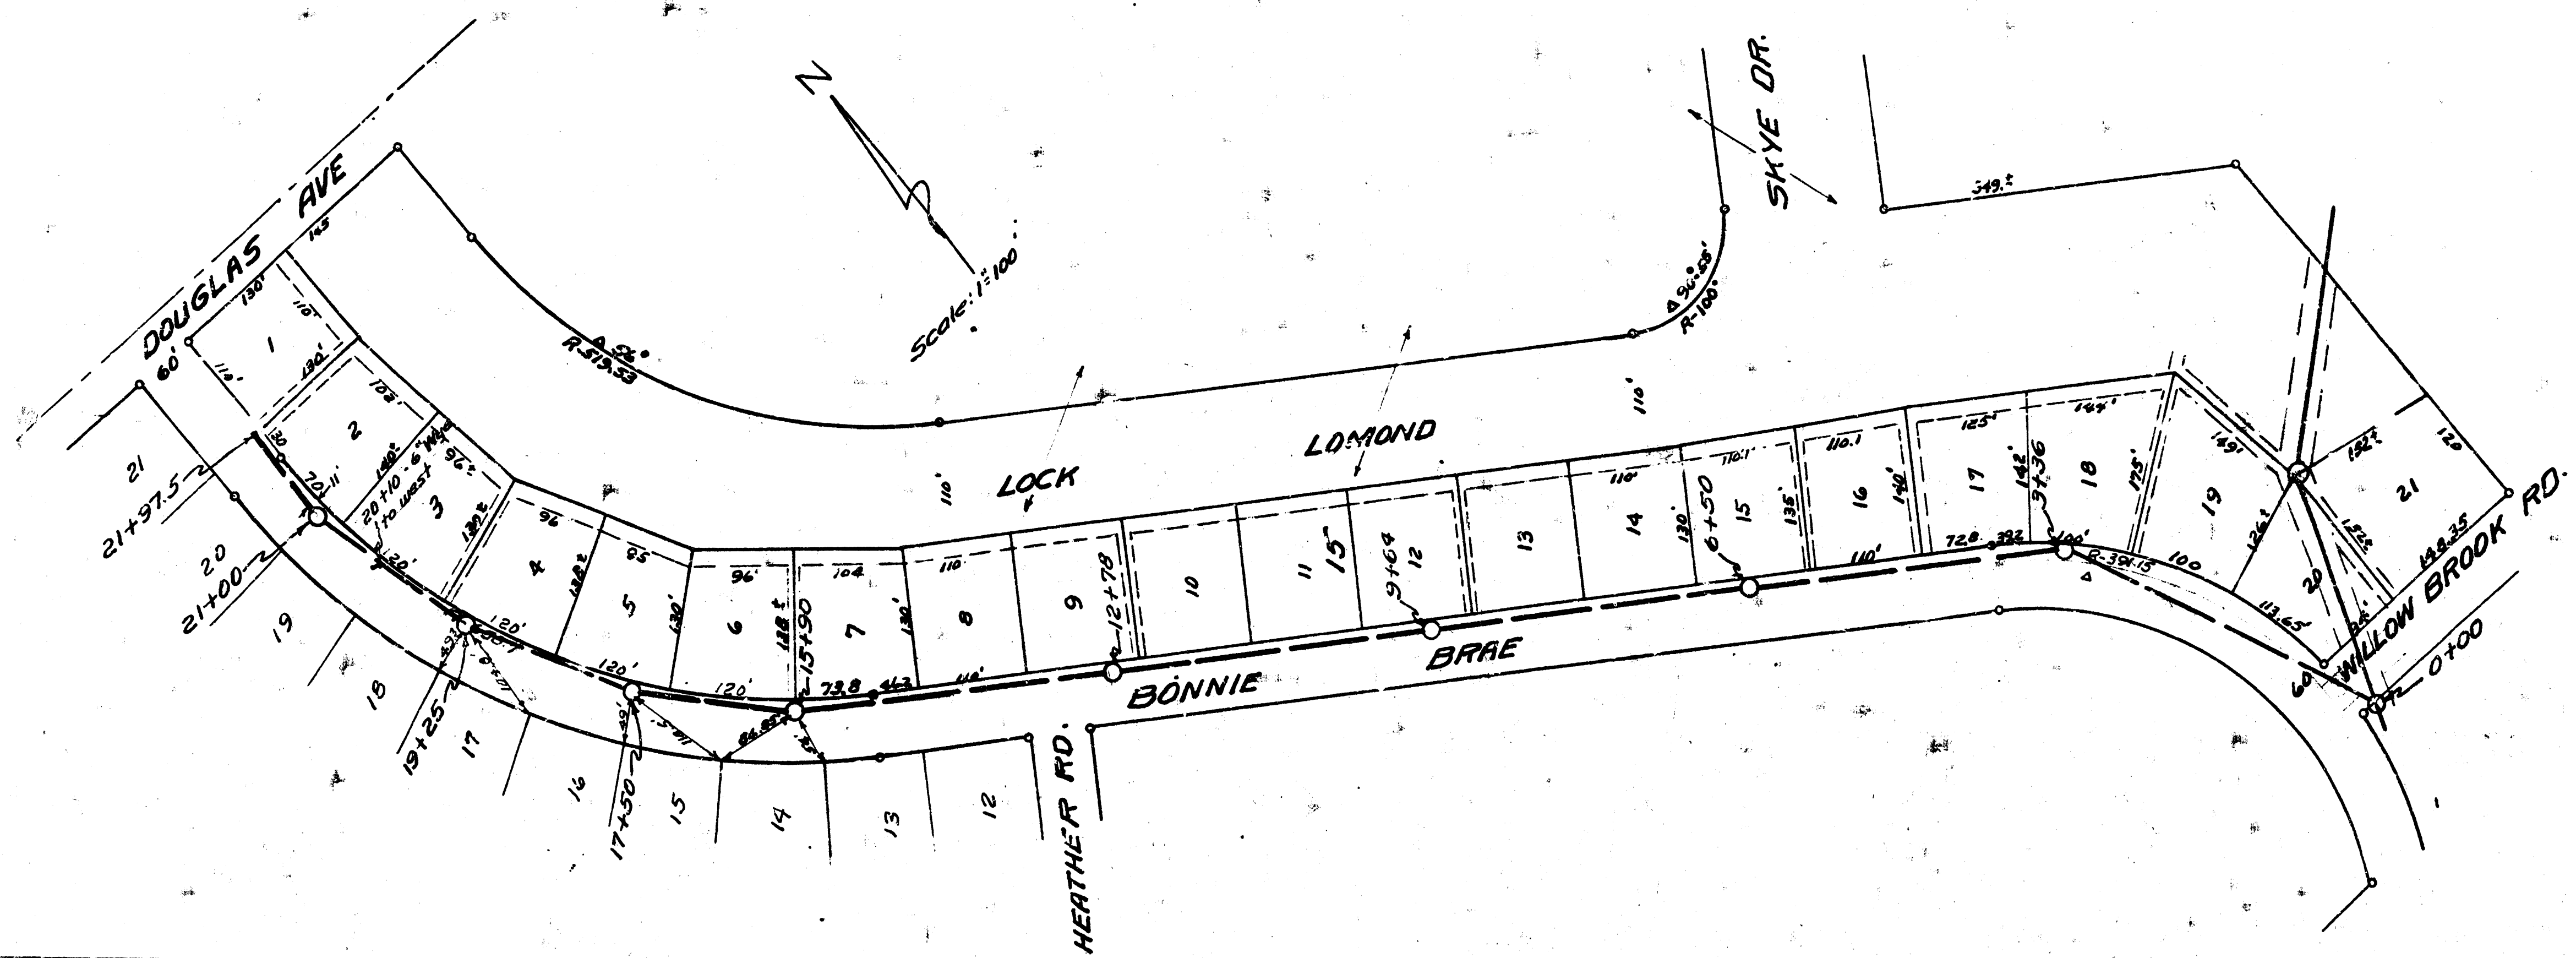

W.S.
 CITY OF WICHITA, KANSAS
 B. SMITH, CITY ENGINEER
 Proj. No. C-23-60