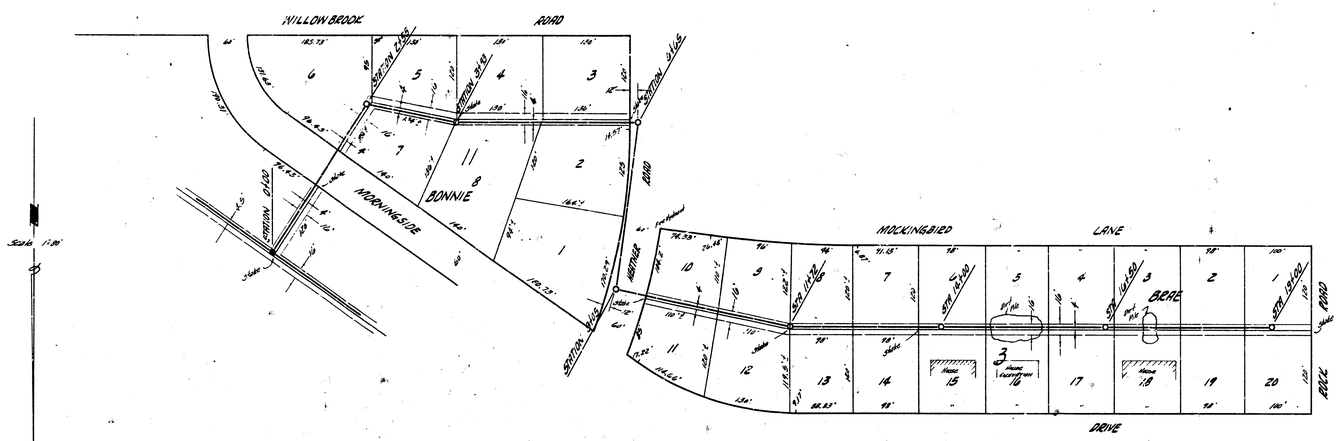


LATERAL 19 W. I. S.
CITY OF WICHITA, KANSAS
B.E. SMITH CITY ENGINEER
PROJ. NO. C28-196 DATE DEC 1958

3 3 3 (17)