


D.M. 155.58 R.R. SPIKE E.S. P.P. SE ROCK RD. & CLAY,  
 S.M. 144.58 CITY STANDARD NW COR. ROCK ROAD & LINCOLN.

PLAN SCALE 1" = 40'  
 PROFILE SCALE 1" = 40' HOR. 1" = 4' VERTICAL

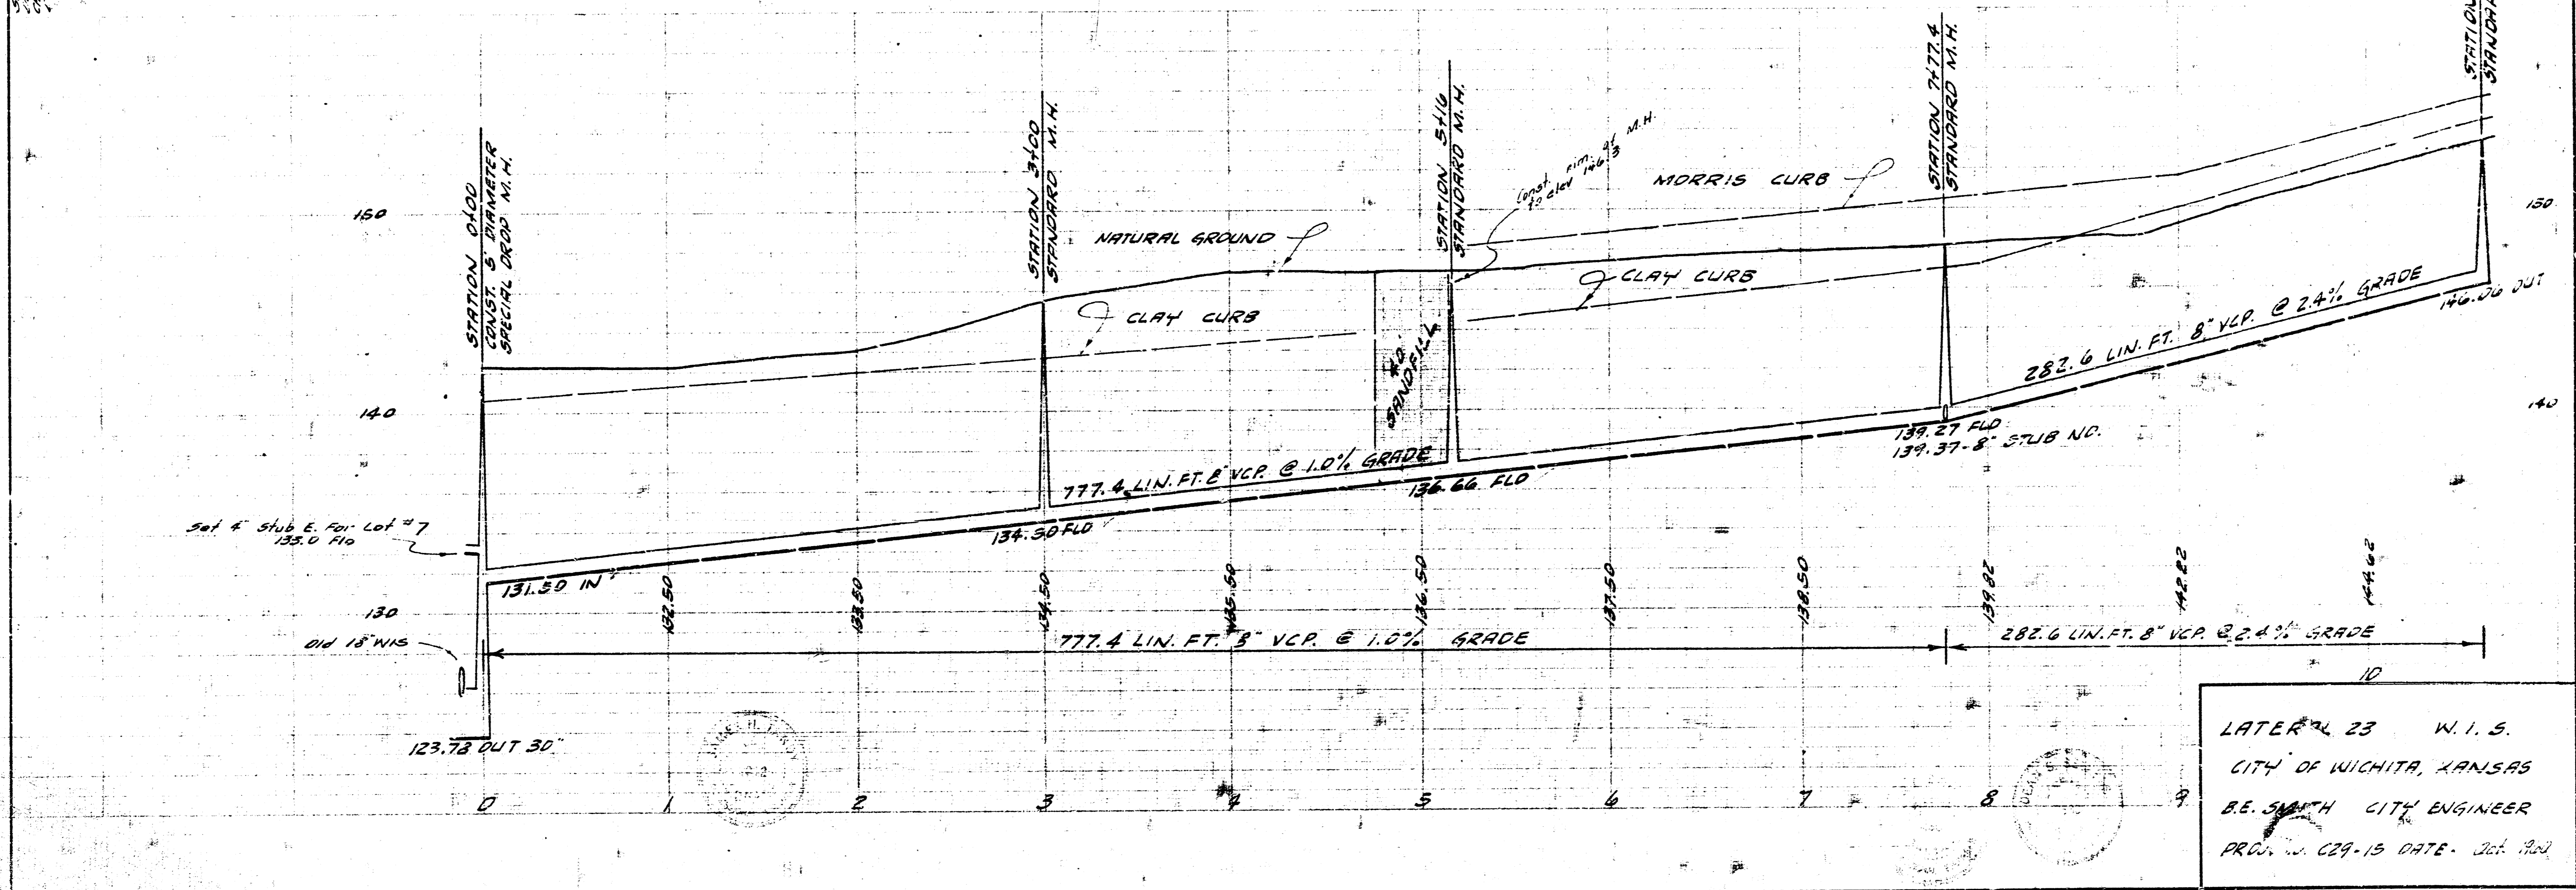

LATE 23 W.I.S.  
 CITY OF WICHITA, KANSAS  
 B.E. SMITH CITY ENGINEER  
