


BM = 123.69 City Std Oliver & George Washington Blvd.
44.2' West of ℄ Oliver and 55' NE of center G.W.B.

BM = 121.75 Brass Plug NW corner walk East side bridge on Oliver between George Washington Blvd. & Pawnee

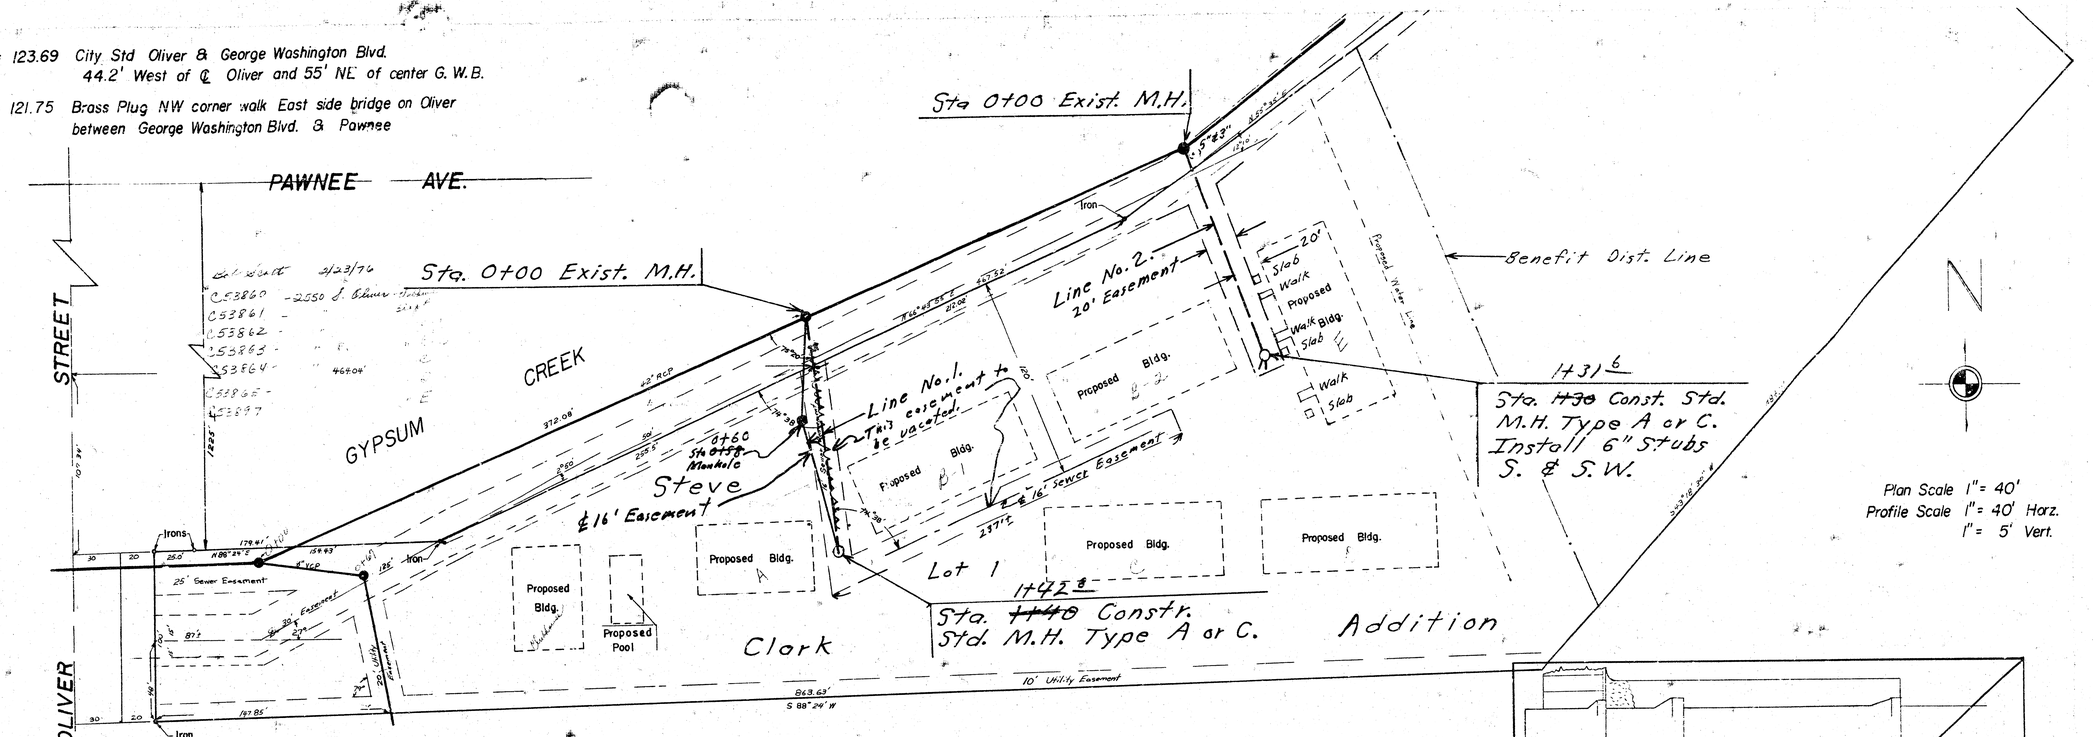

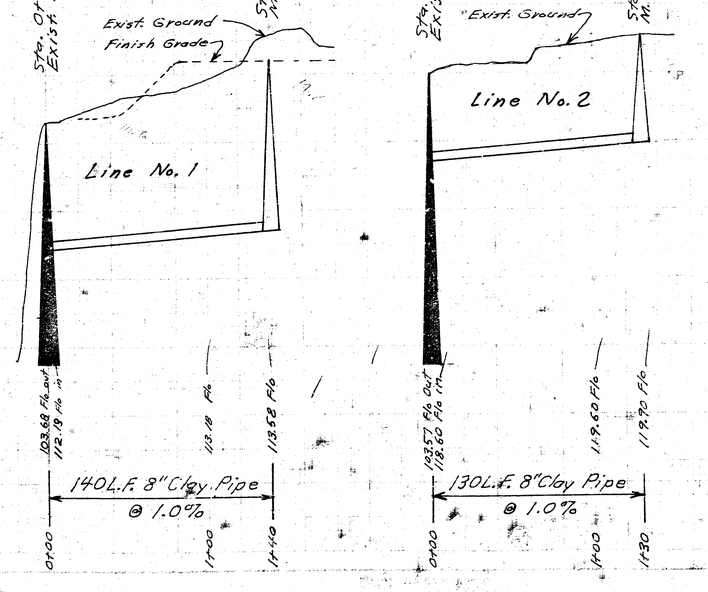

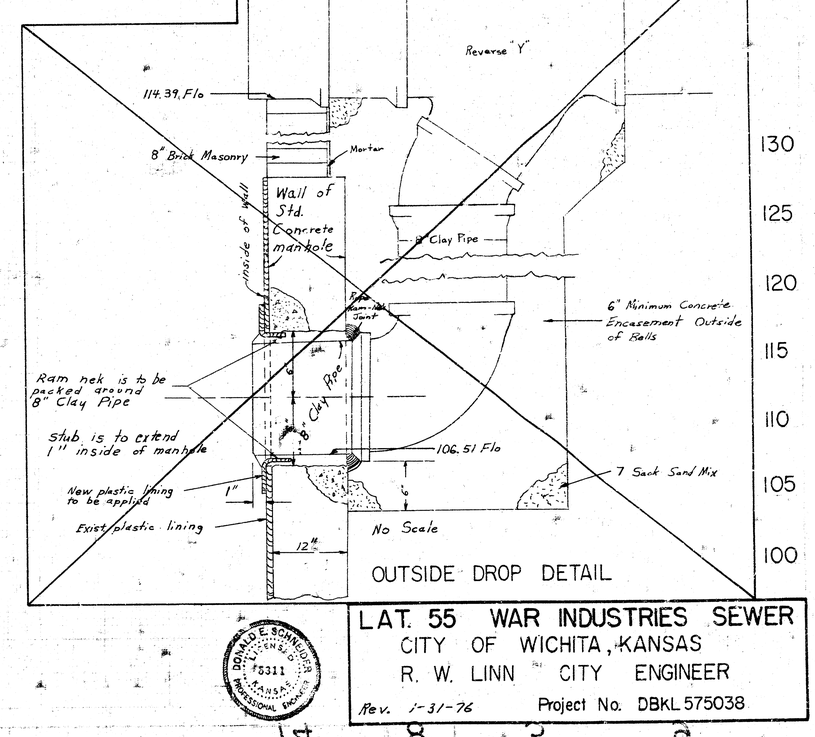

DONALD E. SCHNEIDER LICENSED 15311 KANSAS PROFESSIONAL ENGINEER

LAT. 55 WAR INDUSTRIES SEWER
CITY OF WICHITA, KANSAS
R. W. LINN CITY ENGINEER
Rev. 1-31-76 Project No. DBKL 575038

As Built 3-11-76