
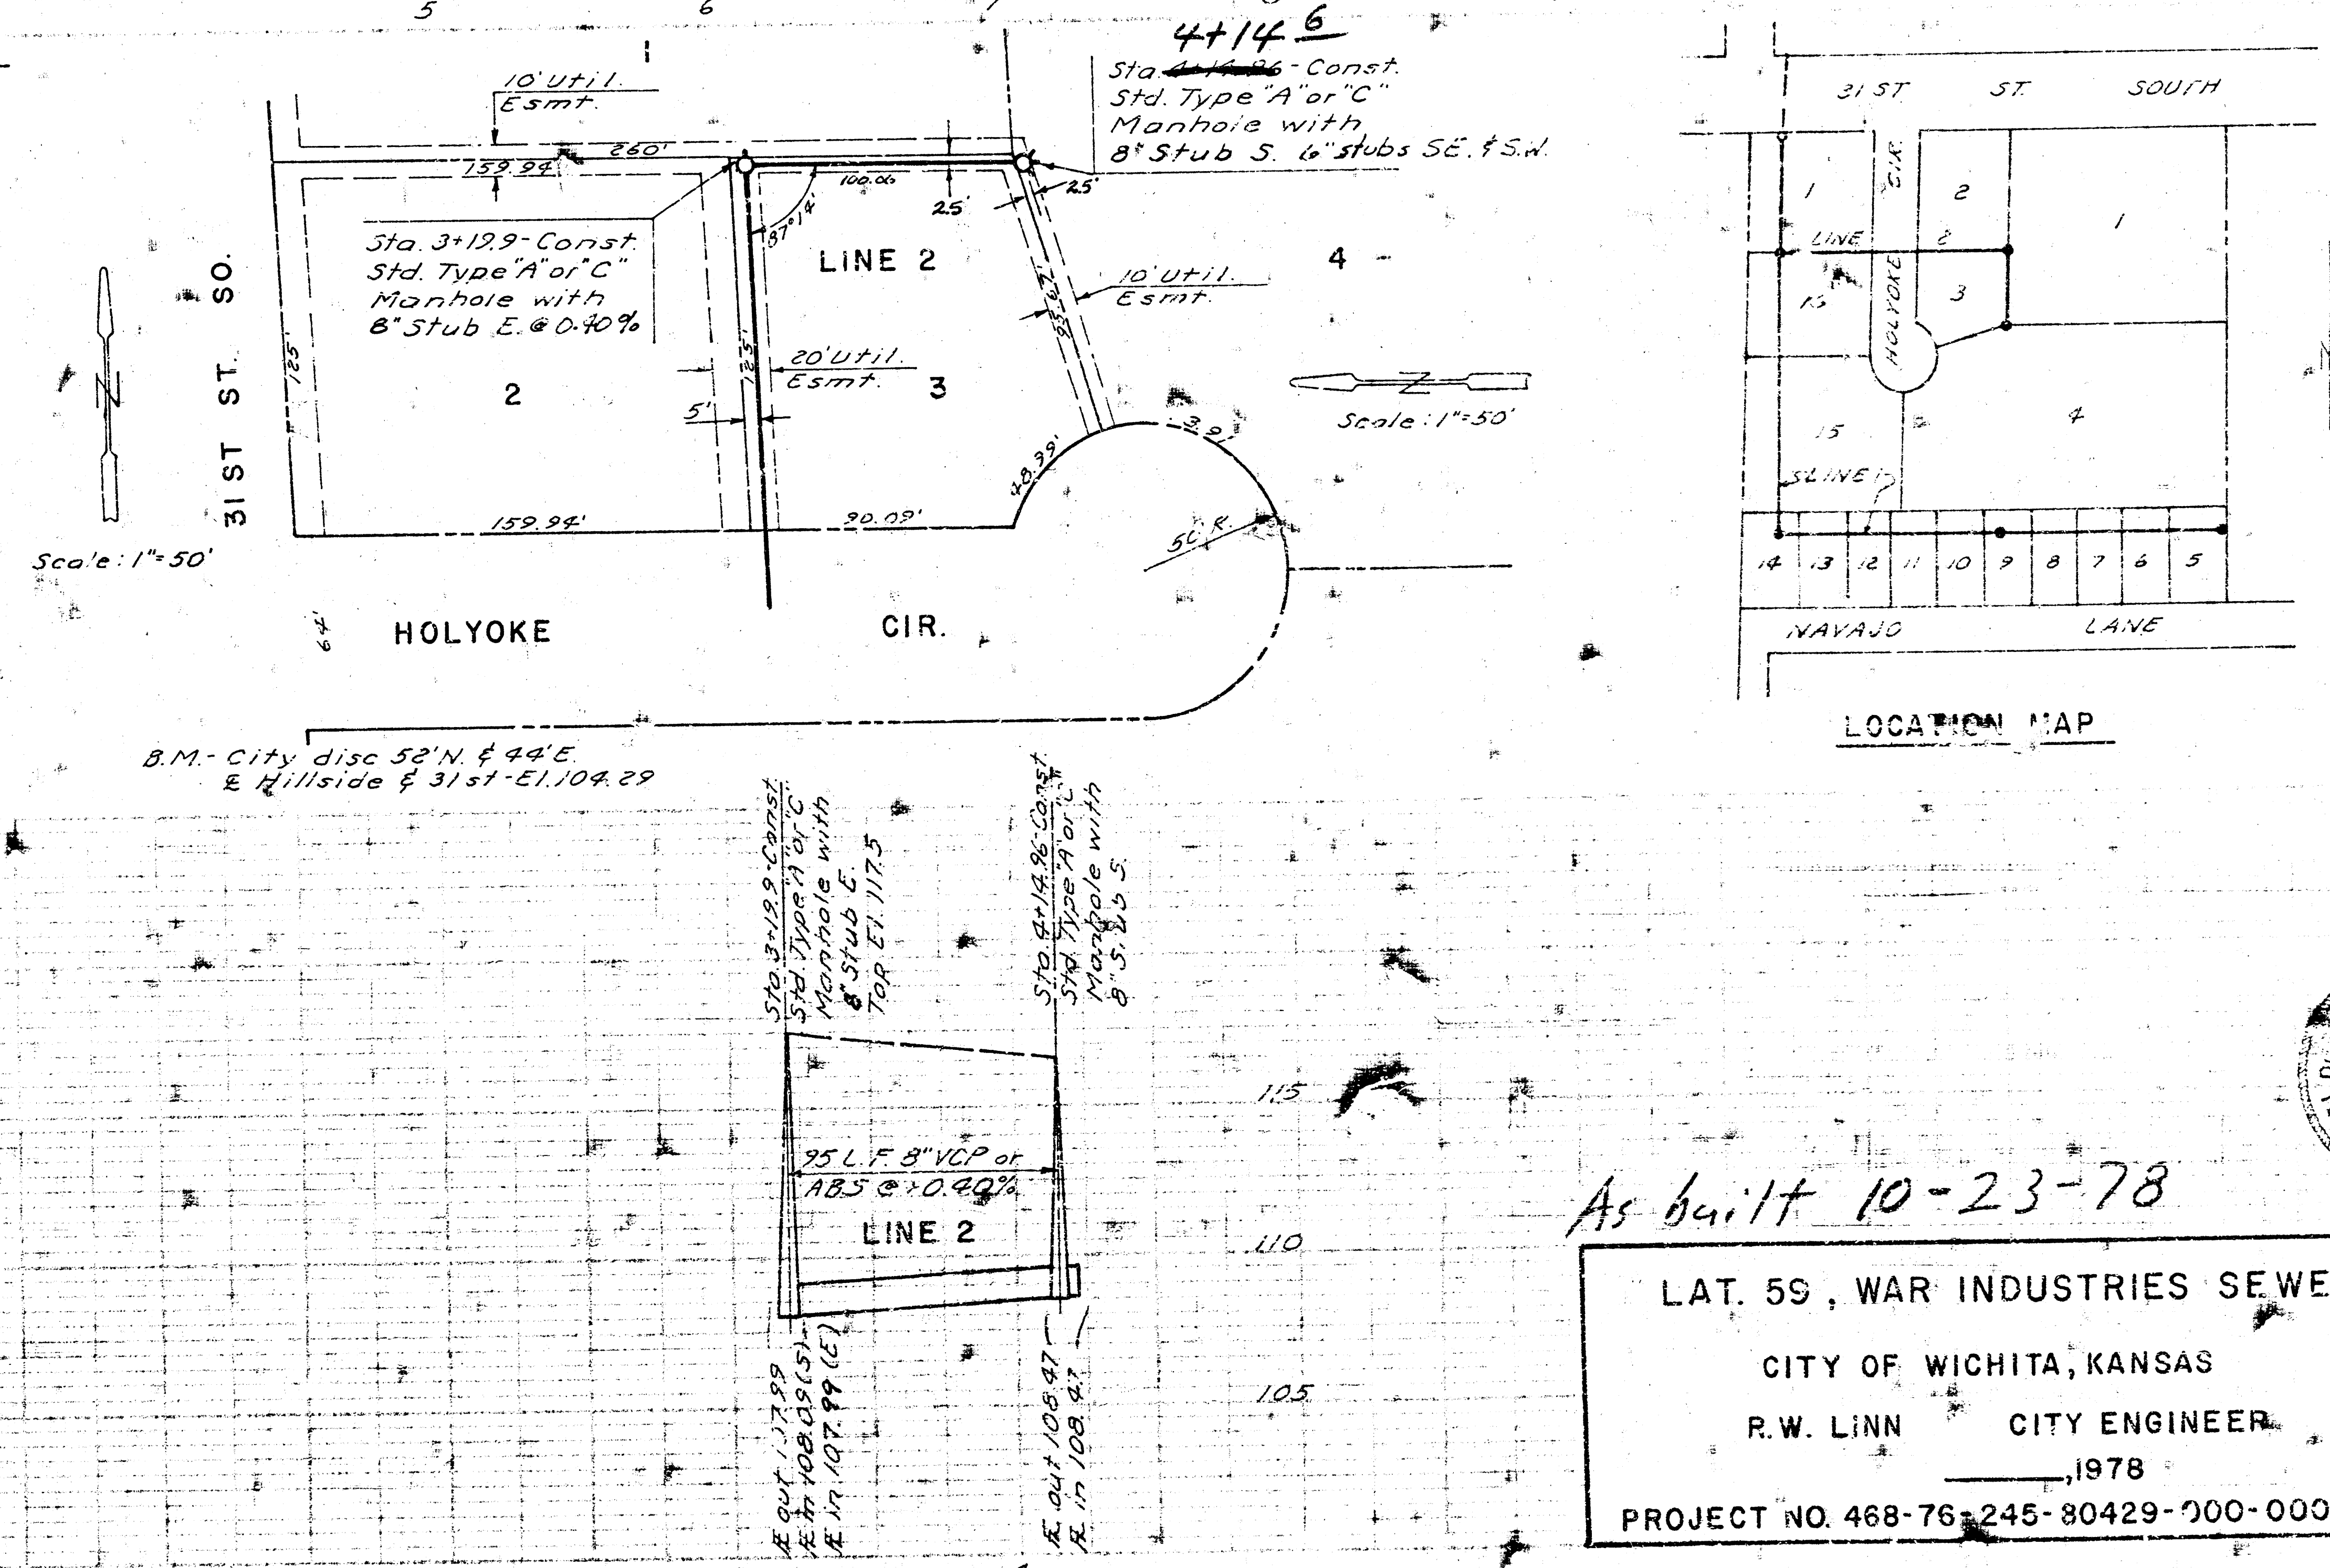
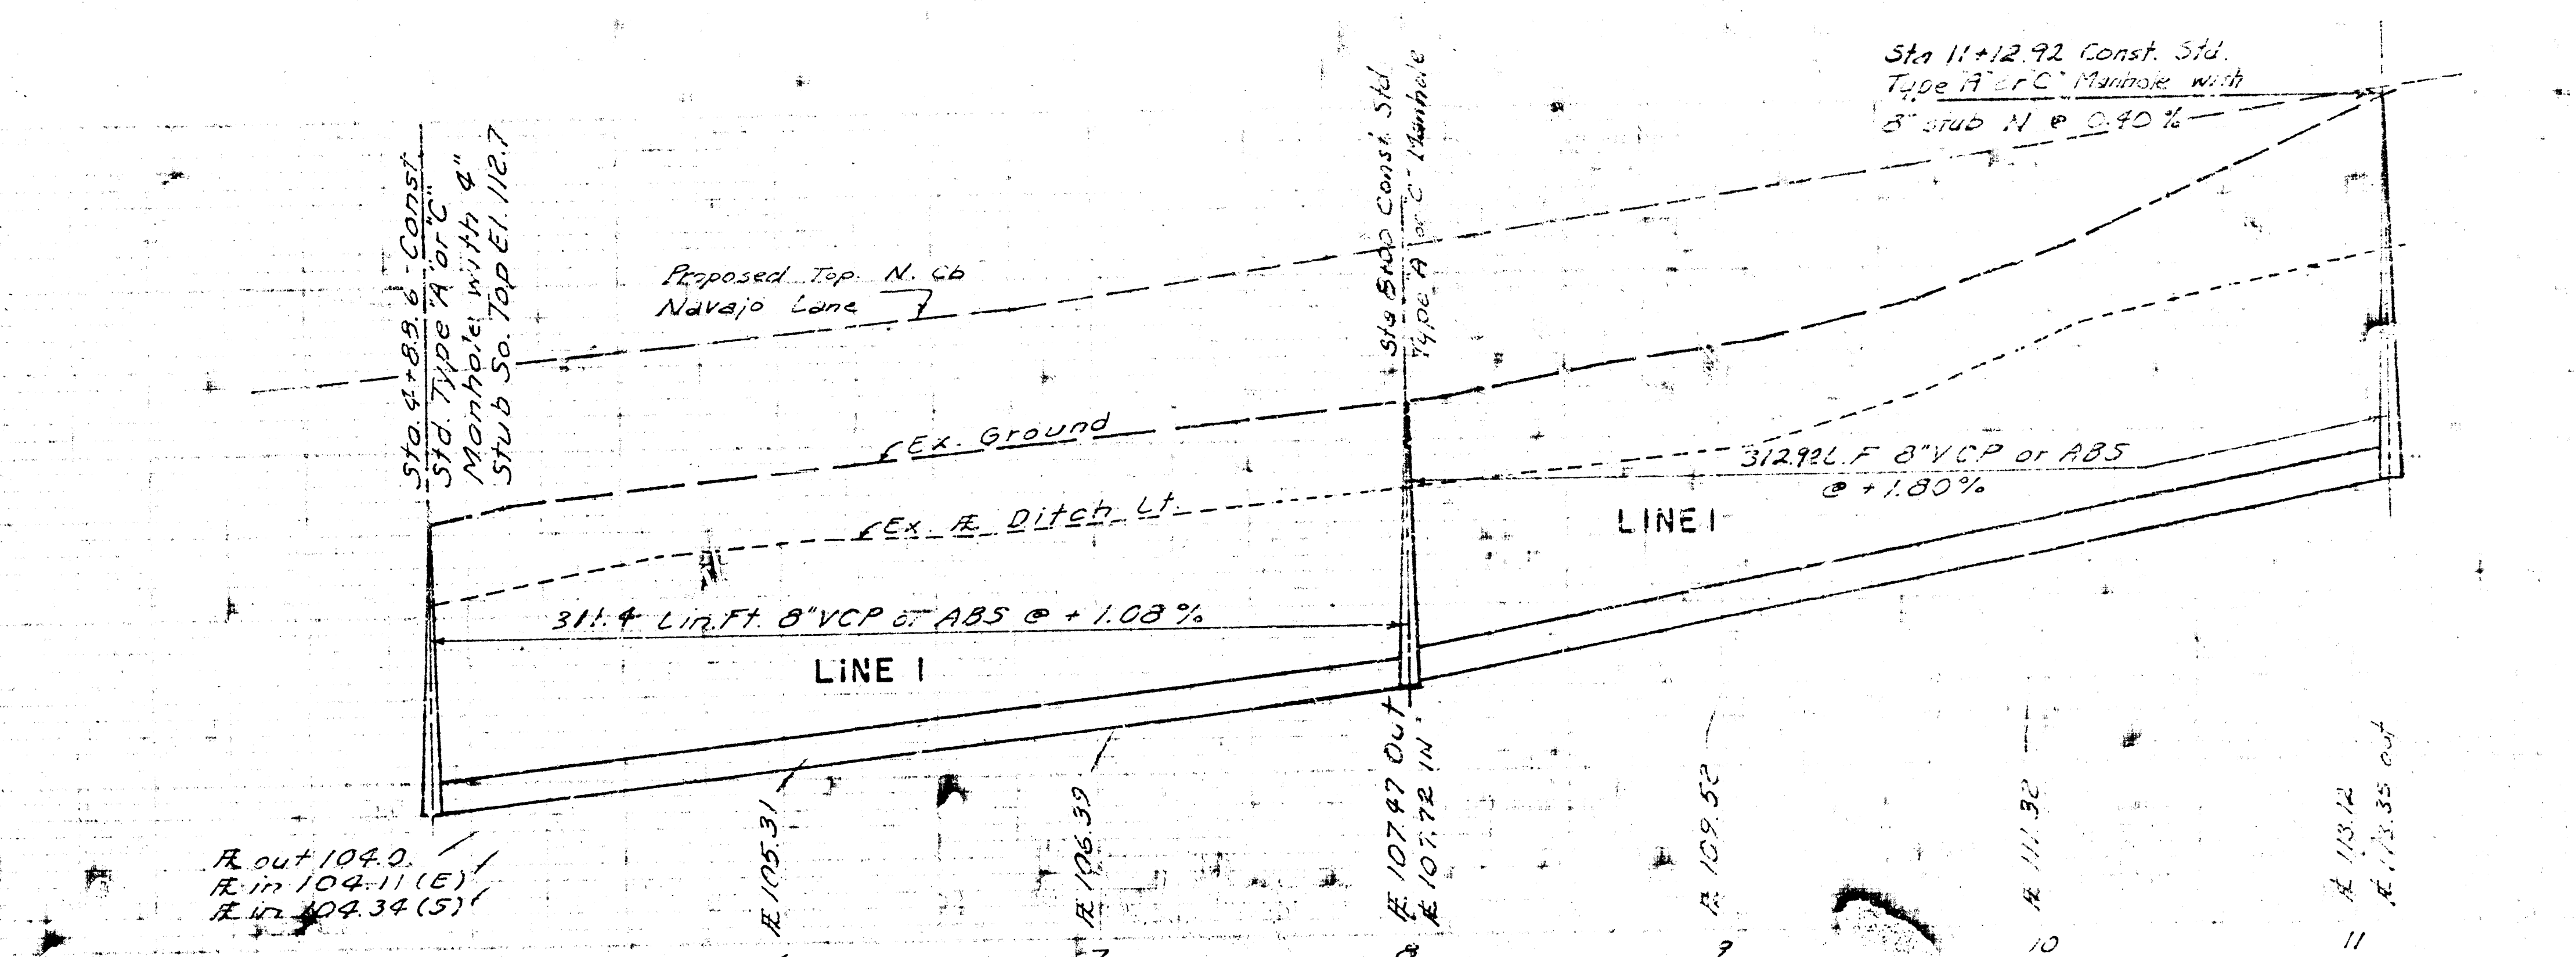


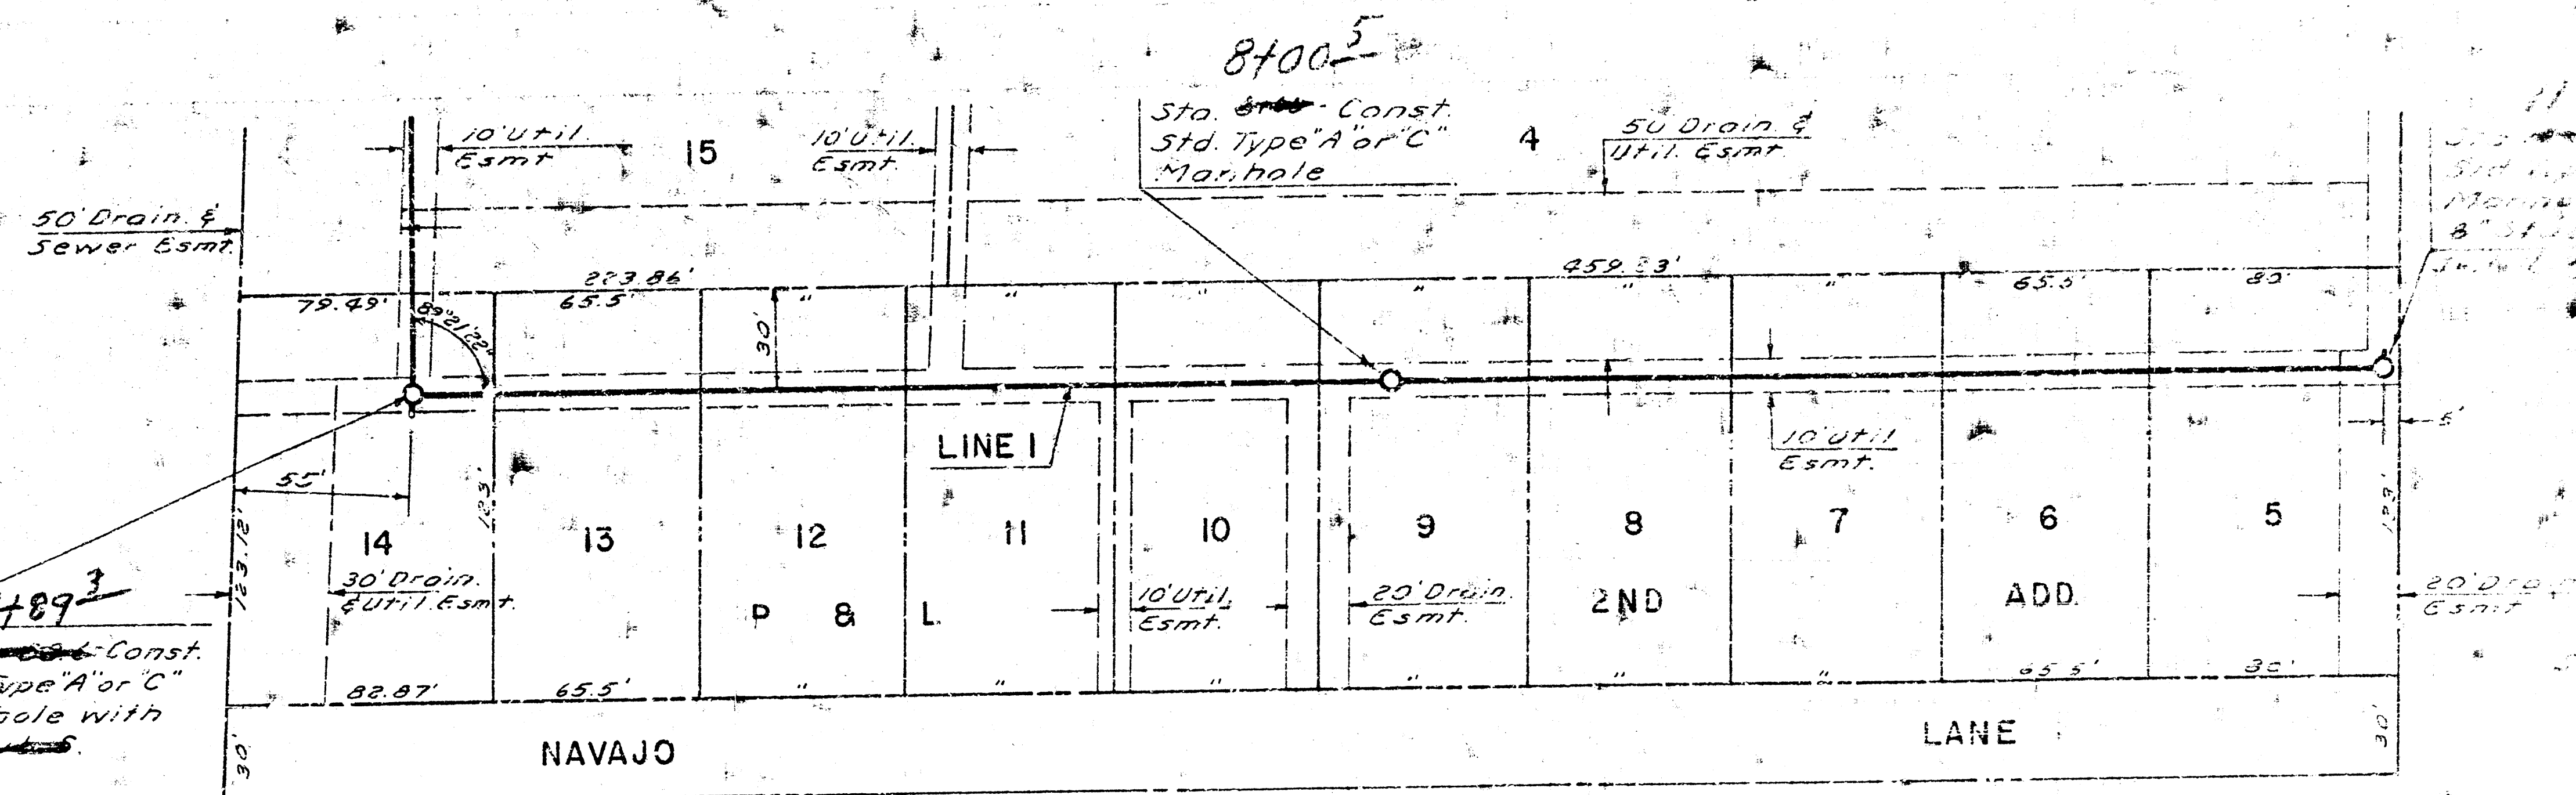

LAT. 59, WAR INDUSTRIES SEWER
CITY OF WICHITA, KANSAS
R.W. LINN CITY ENGINEER.
_____, 1978
PROJECT NO. 468-76-245-80429-000-000-001