LATERAL 71, WAR INDUSTRIES SEWER

Project no. 468-76-245-81138-000-000-001

CITY OF WICHITA, KANSAS
MIKE E. LINDEBAK CITY ENGINEER

As Built
8-84
7-85

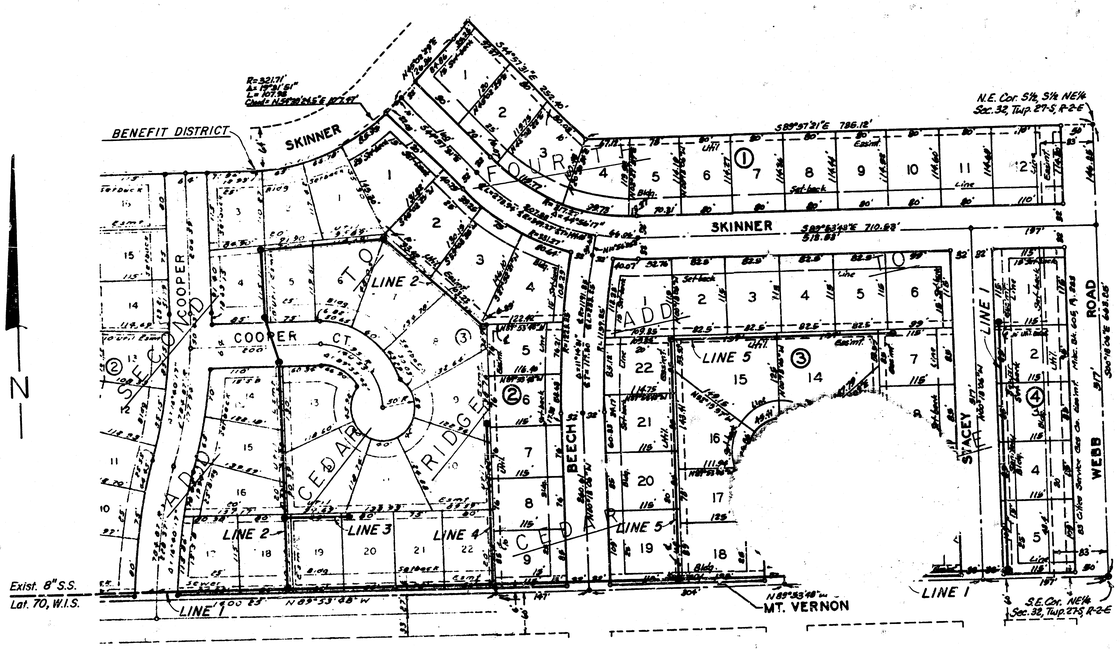

GENERAL NOTE

The Contractor shall be responsible for preserving property irons. The Contractor shall be required to re-establish any property irons which are destroyed or damaged by his construction operations. Such irons shall be re-established by a licensed land surveyor or a professional engineer in accordance with state laws.

M. BRENT WOOTEN LICENSED 8470 KANSAS PROFESSIONAL ENGINEER

MAY 1984 1 of 10 1/10

BAUGHMAN COMPANY, P.A.
SURVEYING & ENGINEERING
316/262-7271 • 330 LAURA • WICHITA, KANSAS 67211

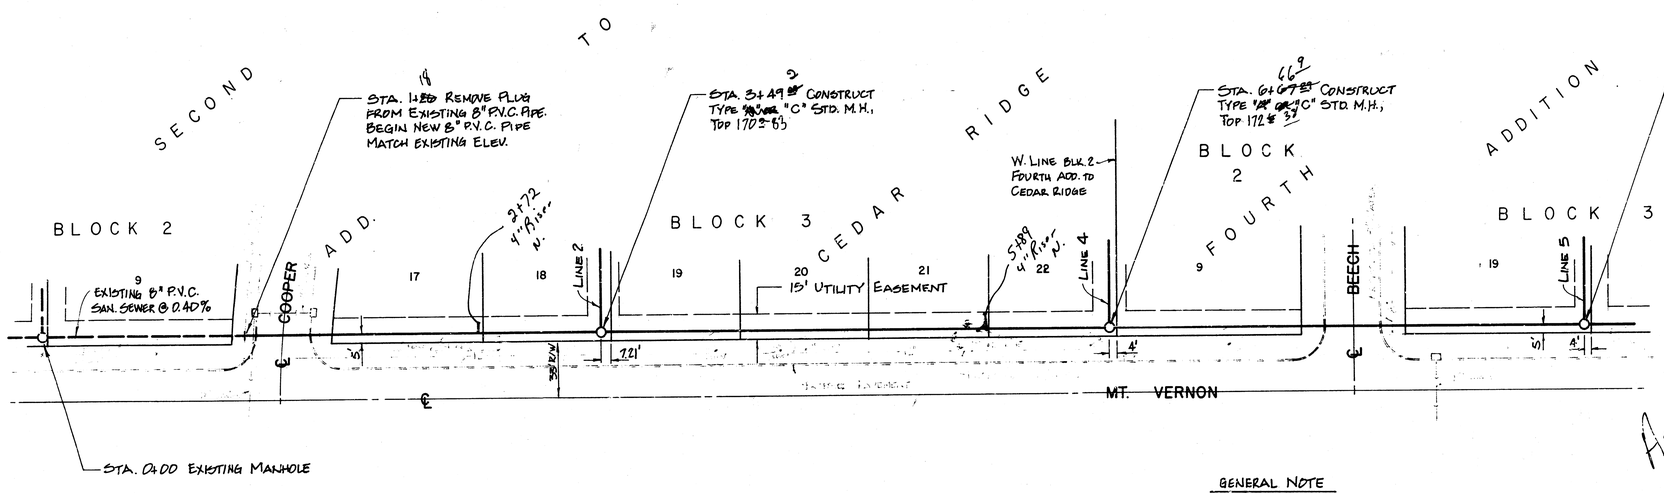

As Built 7-85 J.L.L.

N

GENERAL NOTE

TREES AND HEDGE TO BE REMOVED AS REQUIRED FOR CONSTRUCTION. COST OF REMOVAL SHALL BE INCIDENTAL TO L.F. OF PIPE.

BENCH MARK

CITY OF WICHITA STD. DISC
47' W. & 44' N. OF ℄ MT. VERNON & WEBB ROAD, ELEV. 1182.48

SCALE

PLAN - 1" = 40'

PROFILE - 1" = 40' HORZ.
1" = 5' VERT.

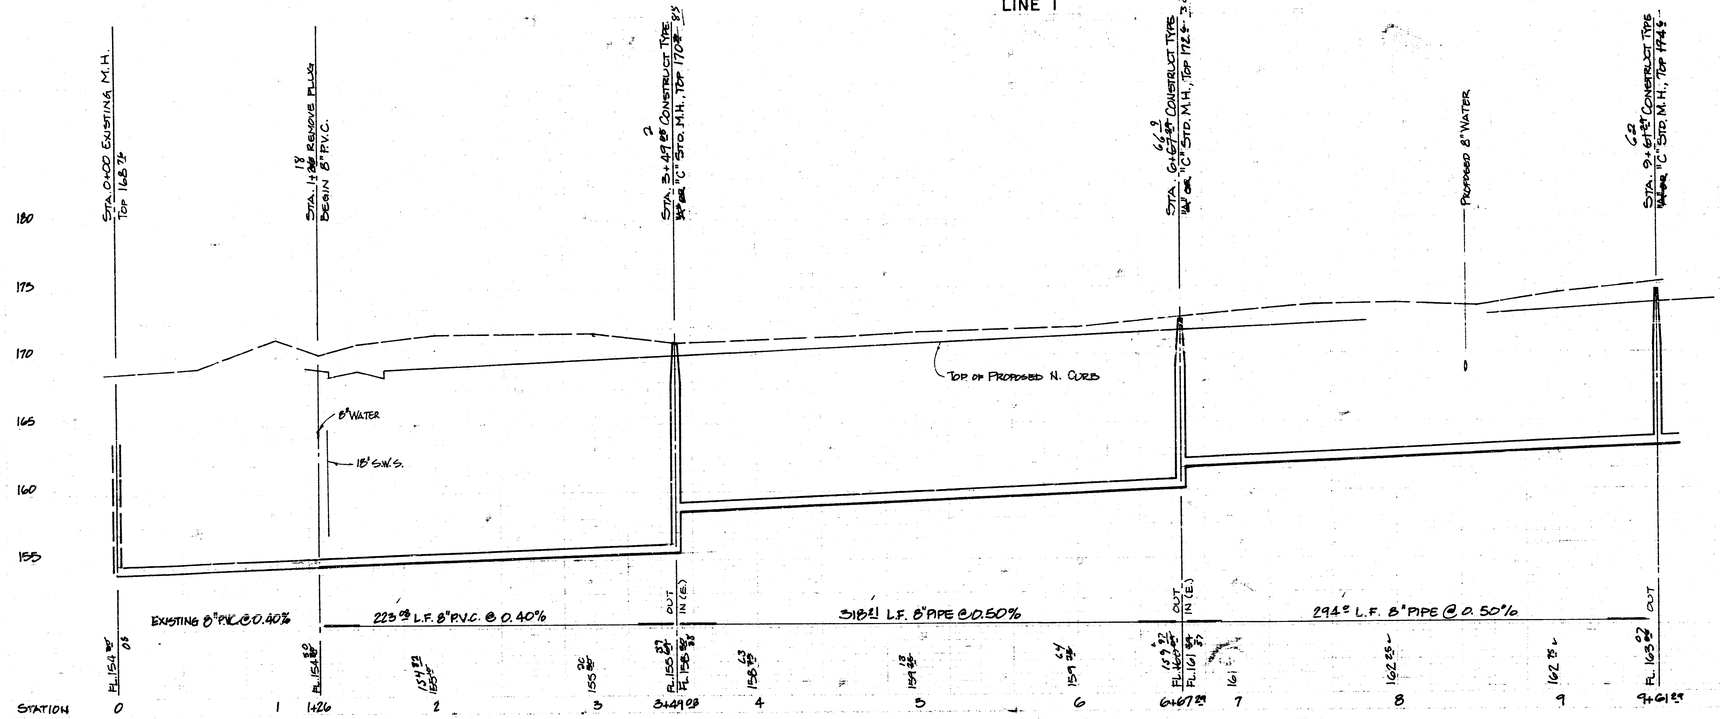

N. BRENT WOOTEN
LICENSED
8470
KANSAS
PROFESSIONAL ENGINEER

LATERAL 71
WAR INDUSTRIES SEWER

City of Wichita, Kansas

Project no. 468-76-245-81138-000-000-001

BAUGHMAN COMPANY, P.A.
SURVEYING & ENGINEERING
316/262-7271 • 330 LAURA • WICHITA, KANSAS 67211

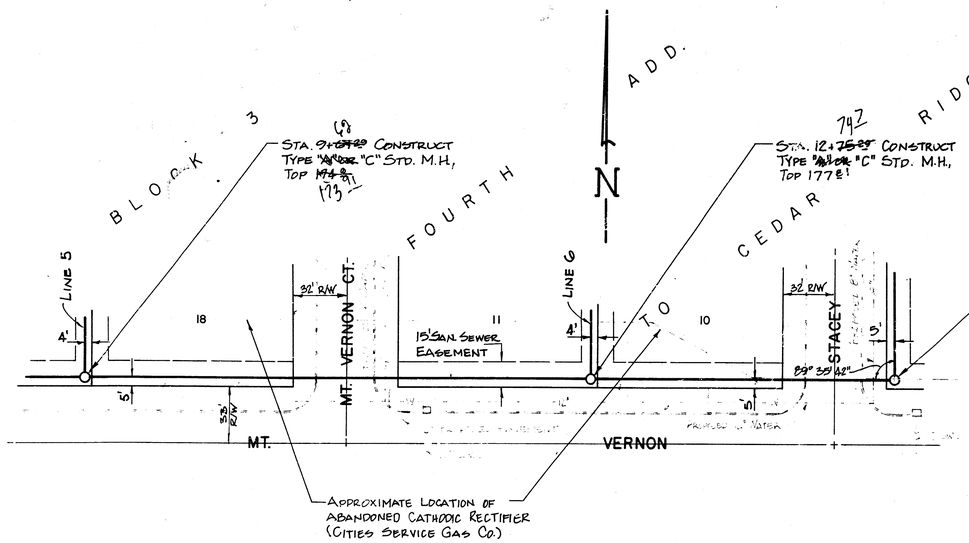

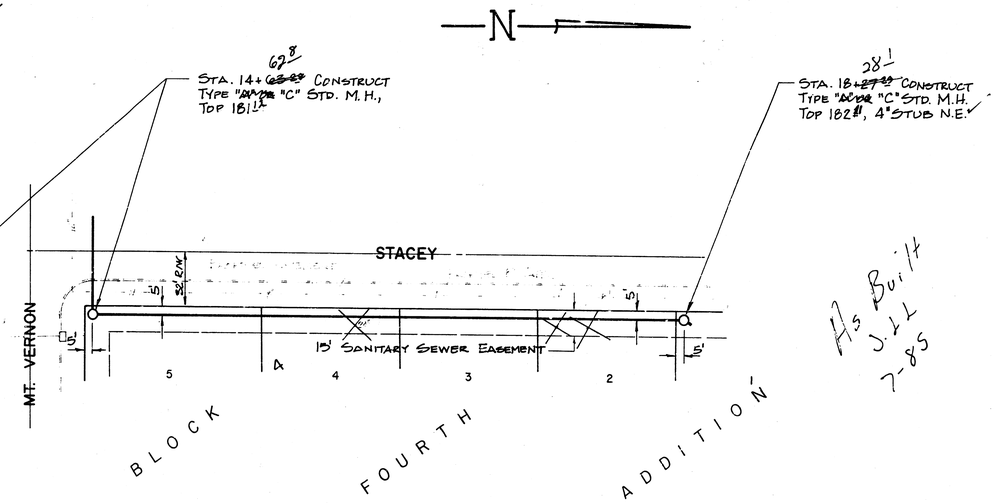

SCALE

PLAN - 1" = 40'

PROFILE - 1" = 40' HORZ.
1" = 5' VERT.

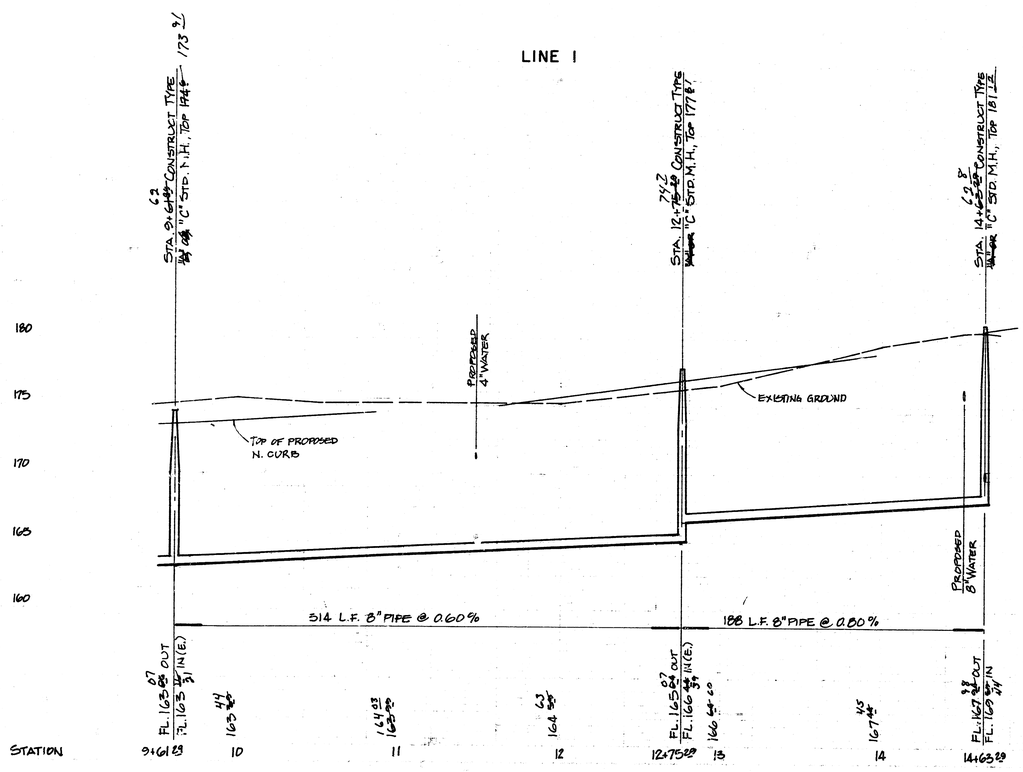

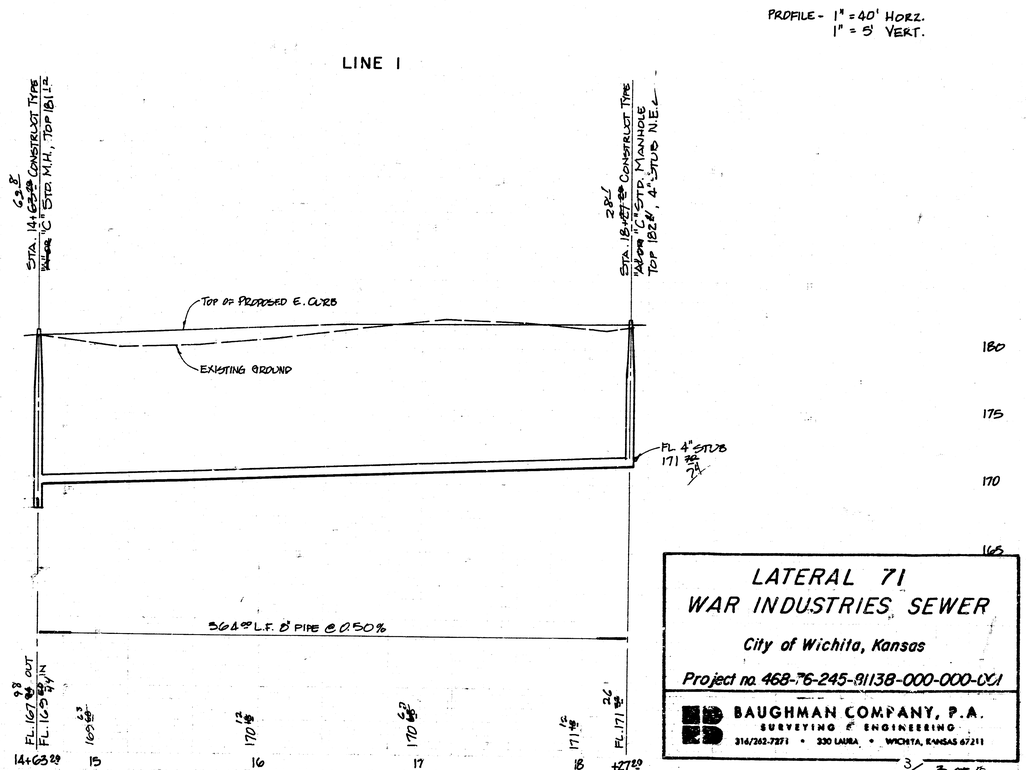

LATERAL 71
WAR INDUSTRIES SEWER

City of Wichita, Kansas

Project no. 468-76-245-91138-000-000-001

BAUGHMAN COMPANY, P.A.
SURVEYING & ENGINEERING
316/262-7271 • 330 LAURA • WICHITA, KANSAS 67211

3/10

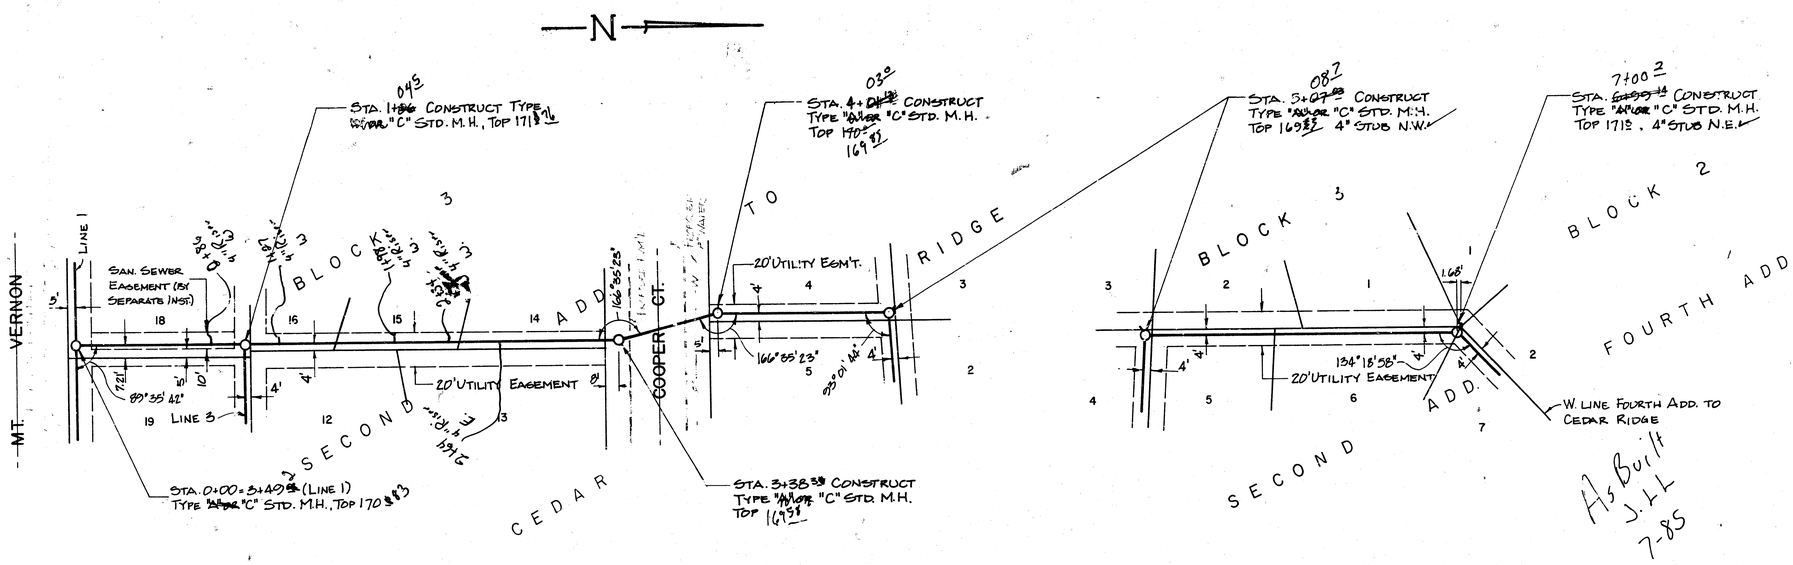

As Built
J.T.L
7-85

SCALE

PLAN - 1" = 40'

PROFILE - 1" = 40' HORZ.
1" = 5' VERT.

LINE 2

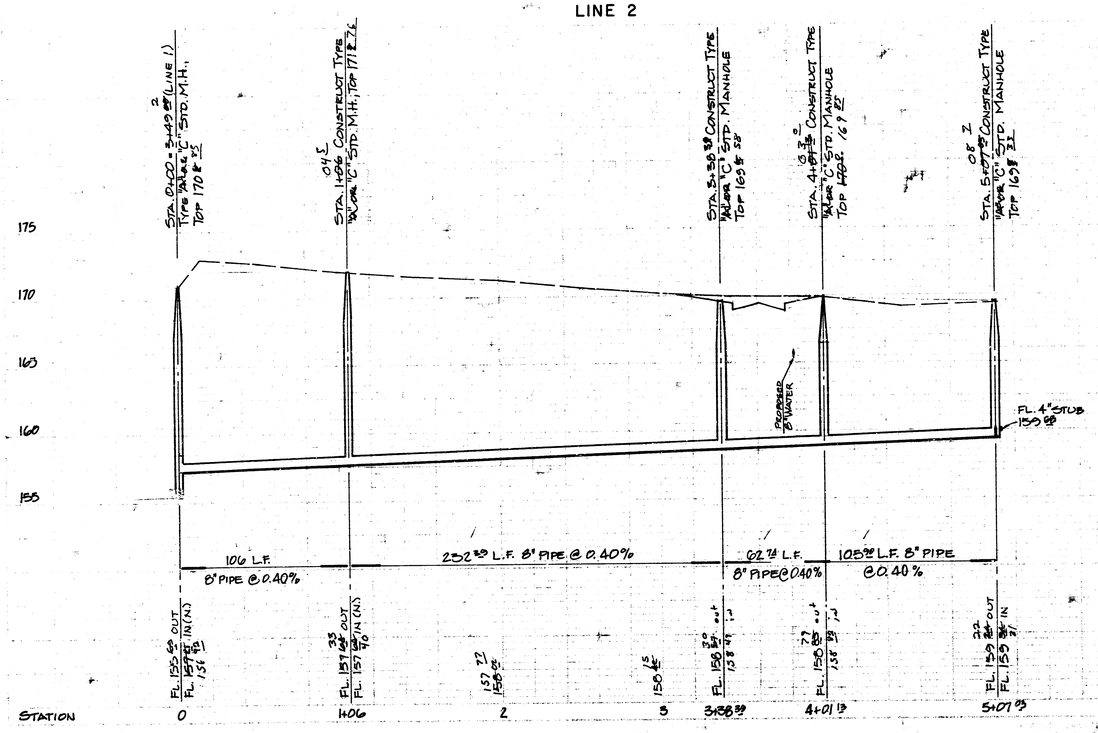

LINE 2

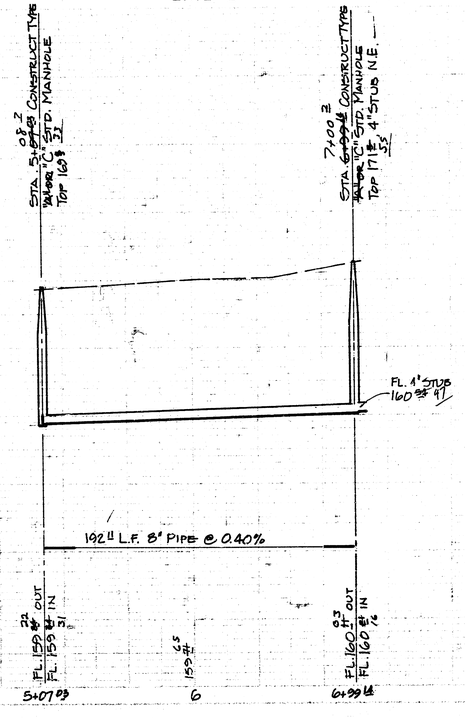

LATERAL 71
WAR INDUSTRIES SEWER

City of Wichita, Kansas

Project no. 468-75-245-81138-000-000-001

BAUGHMAN COMPANY, P.A.
SURVEYING & ENGINEERING
316/262-7271 • 330 LAURA • WICHITA, KANSAS 67211

4/10

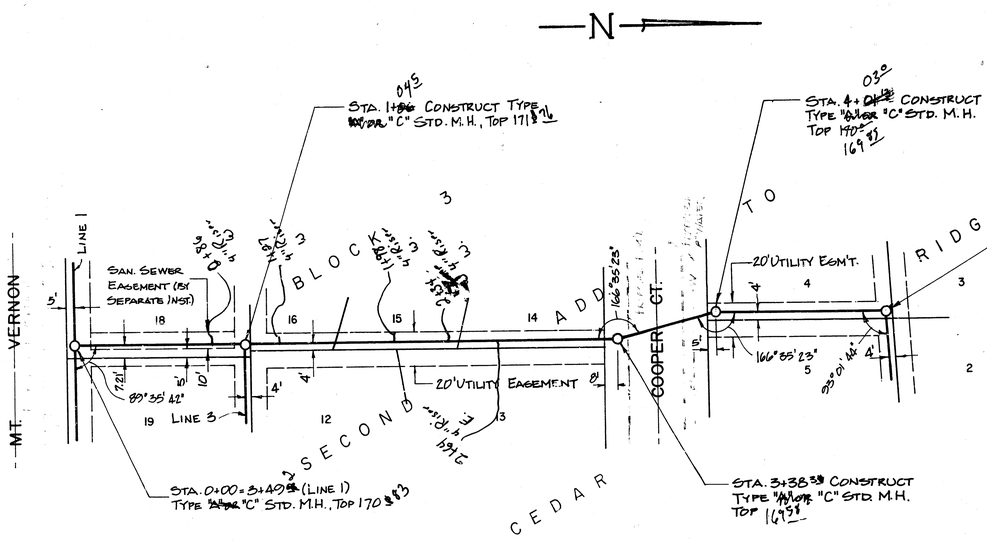

SCALE

PLAN - 1" = 40'

PROFILE - 1" = 40' HORZ.
1" = 5' VERT.

LINE 2

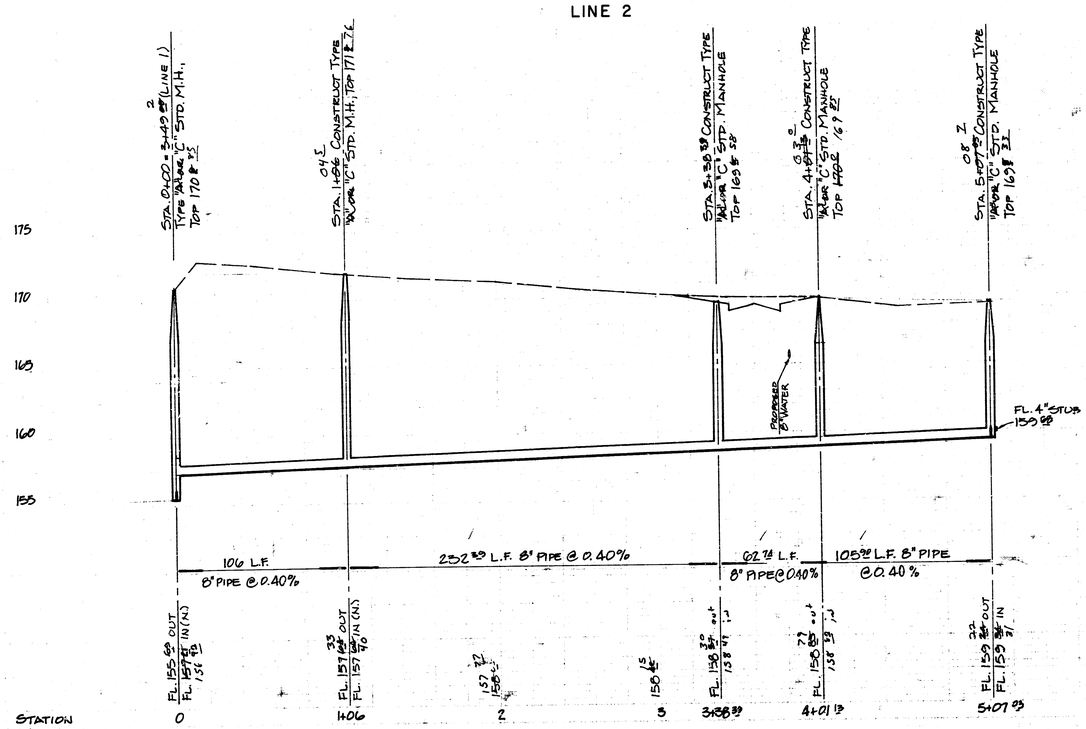

LINE 2

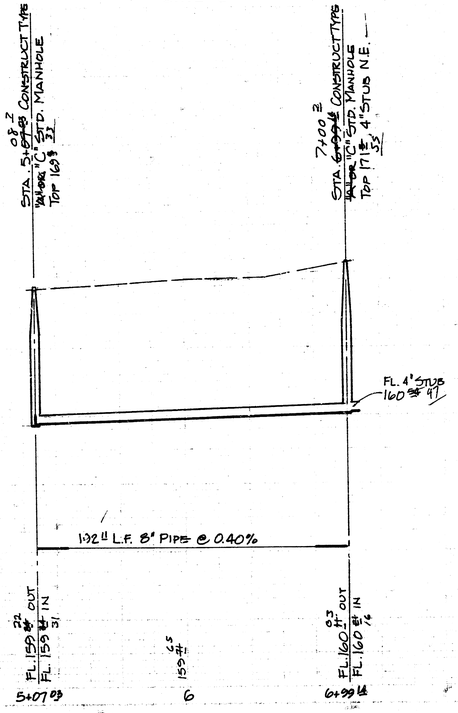

LATERAL 71
WAR INDUSTRIES SEWER

City of Wichita, Kansas

Project no. 468-76-245-81138-000-000-001

BAUGHMAN COMPANY, P.A.
SURVEYING & ENGINEERING
316/262-7271 • 330 LAURA • WICHITA, KANSAS 67211

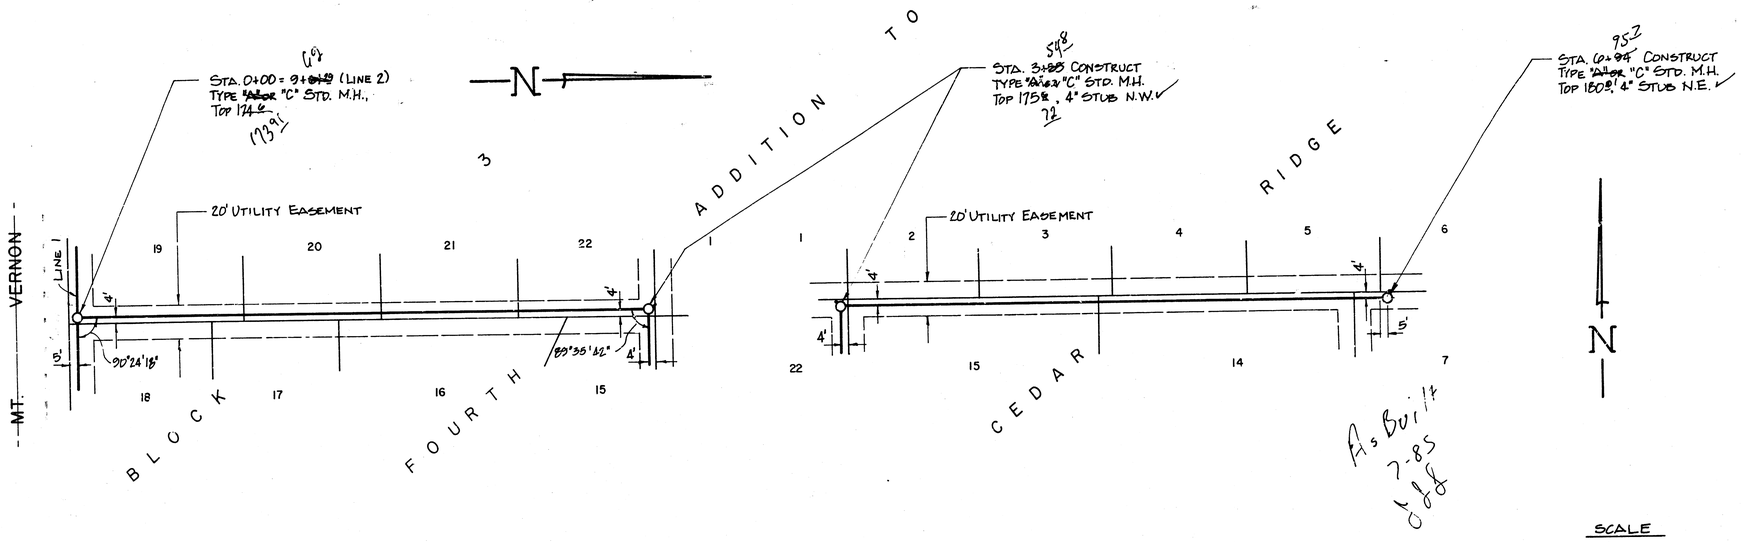

As Built
7-85

SCALE

PLAN - 1" = 40'

PROFILE - 1" = 40' HORZ.
1" = 5' VERT.

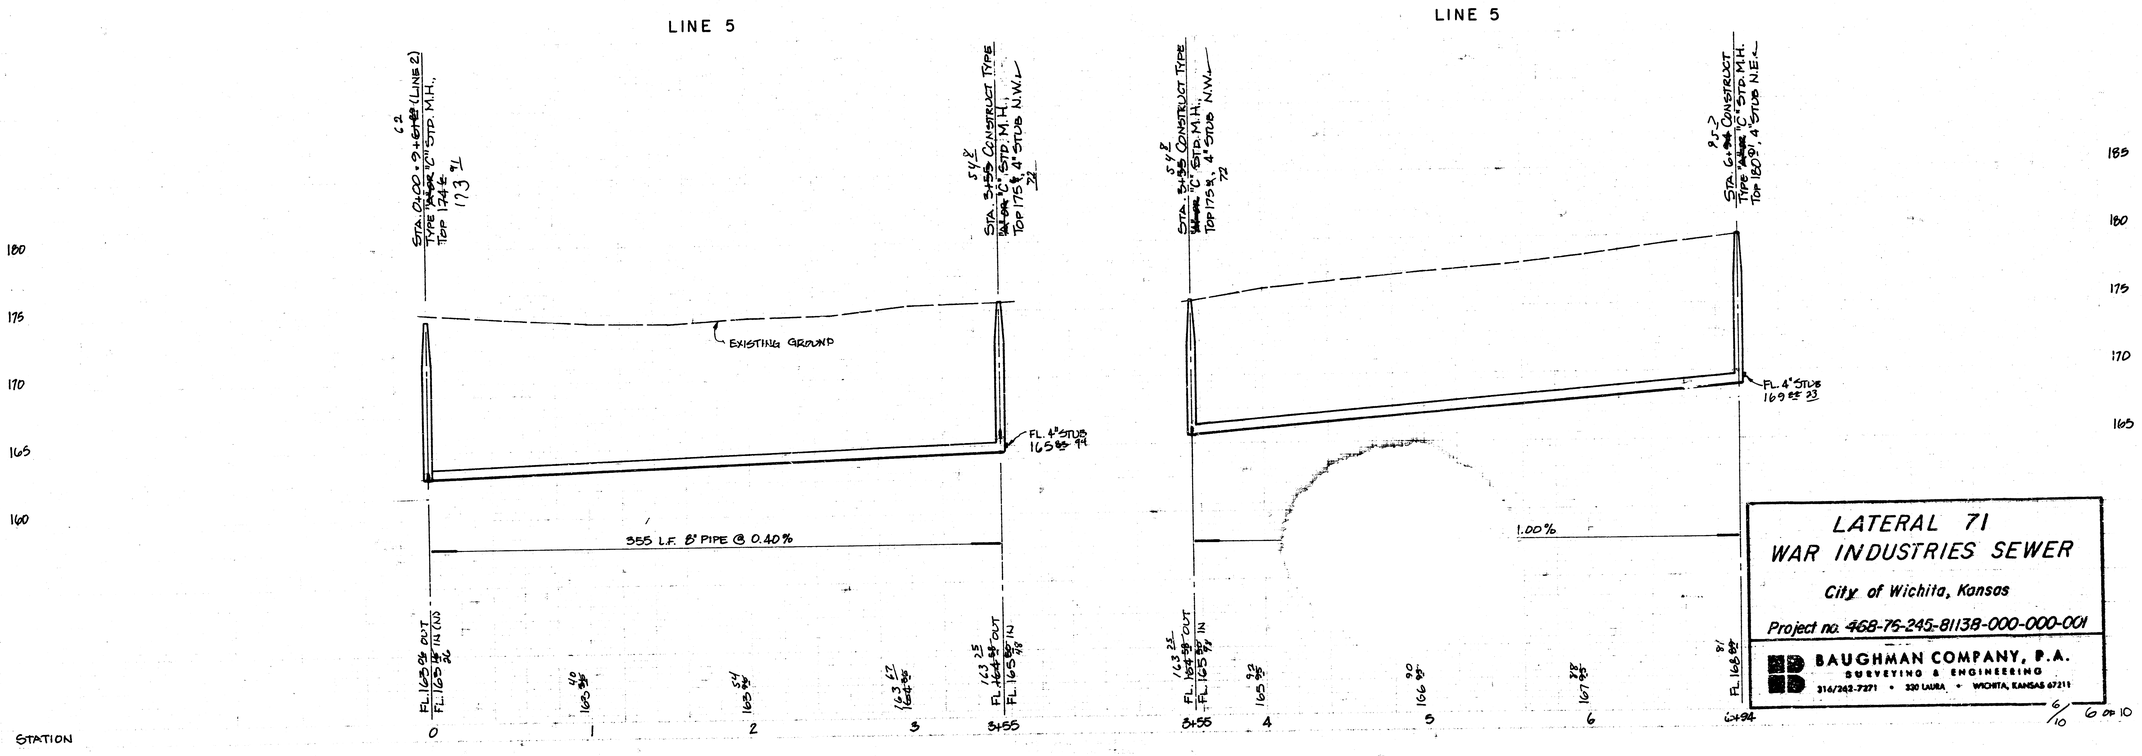

LATERAL 71
WAR INDUSTRIES SEWER

City of Wichita, Kansas

Project no. 468-76-245-81138-000-000-001

BAUGHMAN COMPANY, P.A.
SURVEYING & ENGINEERING
316/262-7271 • 330 LAURA • WICHITA, KANSAS 67211

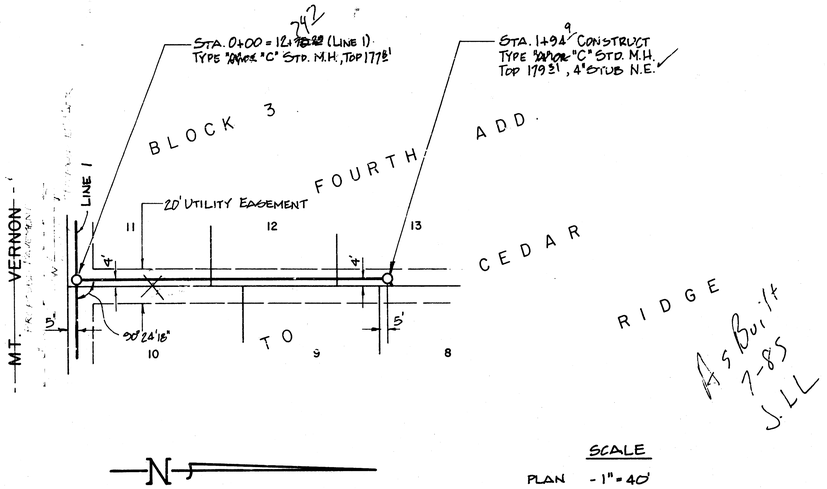

As Built
7-85
JLL

SCALE

PLAN - 1" = 40'

PROFILE - 1" = 40' HORZ.
1" = 5' VERT.

LINE 6

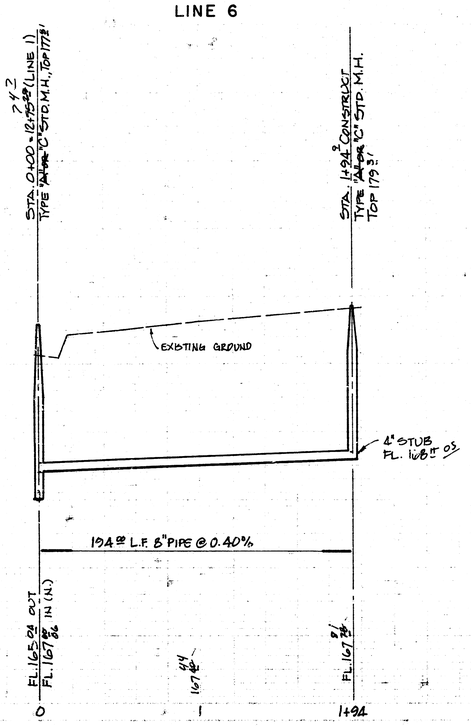

LATERAL 71
WAR INDUSTRIES SEWER

City of Wichita, Kansas

Project no. 468-76-245-81138-000-000-001

BAUGHMAN COMPANY, P.A.
SURVEYING & ENGINEERING
316/262-7271 • 330 LAURA • WICHITA, KANSAS 67211

7/10

REVISED APRIL, 1980

VERTICAL RISER DETAIL

ADOPTED AS STANDARD DESIGN BY

CITY OF WICHITA, KANSAS

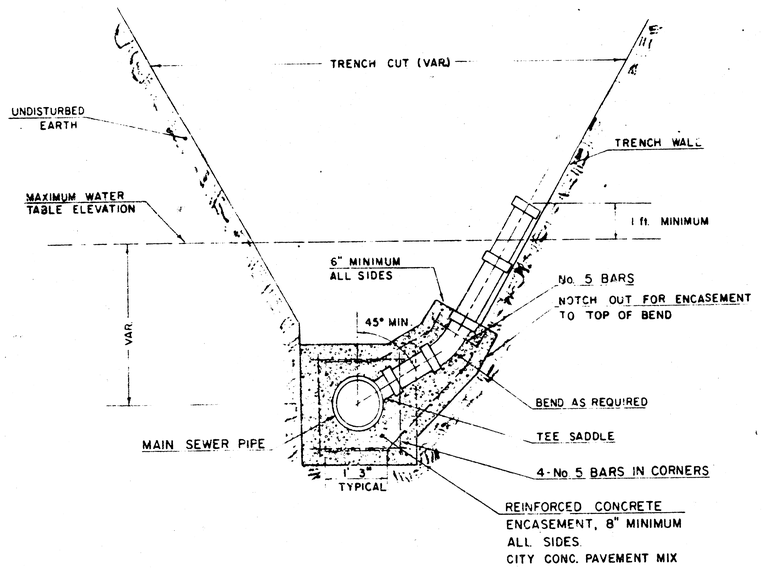

TYPICAL RISER FOR SLOPING TRENCH WALLS

NOTE:
TOP OF 4" OR 6" RISER PIPE TO BE EXTENDED TO AN ELEVATION OF 1 ft. MINIMUM ABOVE THE WATER TABLE ELEVATION, WHEN WATER EXISTS, OR TO AN ELEVATION SUITABLE FOR PROVIDING SERVICE TO THE LOT TO BE SERVED AND THEN PLUGGED.

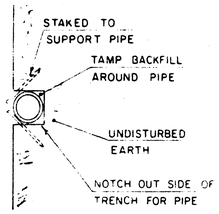

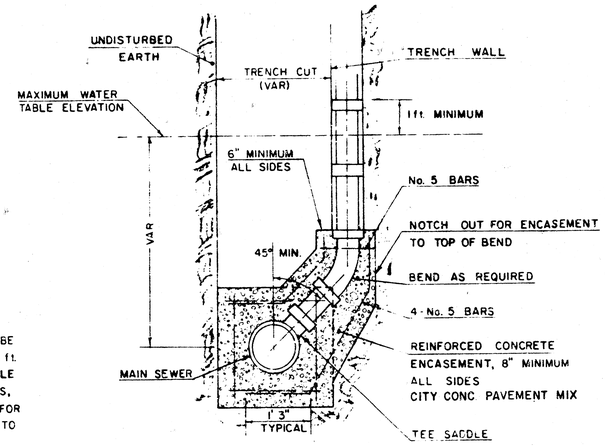

TYPICAL RISER FOR VERTICAL TRENCH WALLS

GENERAL

RISERS SHALL BE INSTALLED TO SERVE ALL LOTS OR TRACTS OF MAIN SEWER AS SHOWN ON THE PLANS. RISERS SHALL BE ADDED TO ALLOW FOR FUTURE CONNECTIONS AS DIRECTED BY THE ENGINEER. ALL RISERS SHALL BE INSTALLED AT RIGHT ANGLES TO THE MAIN SEWER LINE AND PARALLEL TO EACH OTHER, UNLESS OTHERWISE DIRECTED BY THE ENGINEER. LOCATIONS OF RISERS SHALL BE ADJUSTED AS NECESSARY TO AVOID OBSTRUCTIONS OR DIFFICULT EXCAVATION CONDITIONS. LOCATIONS OF RISERS TO SERVE DEVELOPED PROPERTY SHALL BE APPROVED BY THE WATER WASTEWATER DEPARTMENT. RISERS SHALL BE INSTALLED AT THE LOCATIONS OF MANHOLES WHERE SHOWN ON THE PLANS, OR AS DIRECTED BY THE ENGINEER. THE INVERT ELEVATION OF THE TEE AT THE END OF THE MANHOLE PIPE STUB AND THE INVERT ELEVATION OF THE MAIN SEWER LINE SHALL BE EXCEPTIONS AND MANHOLE PIPE STUBS SHALL NOT BE SET BELOW AN ELEVATION WHICH WILL PERMIT THE TOP OF THE INSIDE OF THE PIPE TO MATCH THE TOP OF THE INSIDE OF THE MAIN SEWER PIPE. PIPE STUBS AND RISERS INSTALLED TO SERVE COMMERCIAL OR INDUSTRIAL PROPERTY SHALL BE 6 INCH. PIPE STUBS AND RISERS INSTALLED TO SERVE RESIDENTIAL PROPERTY MAY BE EITHER 4 INCH OR 6 INCH DEPENDING UPON THE AVAILABLE HEAD AND THE SIZE OF THE LOT AS DETERMINED BY THE FIELD ENGINEER. ENCASEMENT OF VITRIFIED CLAY MAIN SEWER PIPE SHALL EXTEND 6 INCHES BEYOND JOINT IN THE MAIN SEWER CLAY PIPE ON EACH SIDE OF THE RISER INSTALLATION. ENCASEMENT OF A.S.T.M. C900 CLASS 150 PLASTIC OR P.V.C. MAIN SEWER PIPE SHALL EXTEND A MINIMUM OF 6 INCHES BEYOND SIDES OF THE CLAY ENCASEMENT FOR THE RISER. FOUR INCH AND SIX INCH RISER PIPE SHALL BE ENCASED IN CONCRETE TO THE SIDE OF THE TRENCH AS INDICATED ON THE DRAWINGS. FOUR INCH AND SIX INCH CLAY PIPE USED FOR RISERS SHALL BE EXTRA STRENGTH PIPE CONFORMING TO THE REQUIREMENTS OF THE LATEST REVISION OF A.S.T.M. DESIGNATION C700. COMPRESSION JOINTS AS SPECIFIED FOR CLAY PIPE IN THE STANDARD SPECIFICATIONS. FOUR INCH AND SIX INCH A.S.T.M. P.V.C. PIPE SHALL BE PIPE APPROVED FOR USE IN THE CITY OF WICHITA PLUMBING AND MECHANICAL INSPECTION DIVISION OF THE DEPARTMENT OF HOUSING AND ECONOMIC DEVELOPMENT. LOCATIONS OF THE TOPS OF THE RISERS SHALL BE MARKED BY FASTENING TREES COLORED PLASTIC TAPE TO THE END OF THE RISER WHICH SHALL BE EXTENDED TO THE GROUND SURFACE AS THE EXCAVATION IS BACKFILLED SUCH THAT THE COLORED TAPE WILL BE VISIBLE WHEN THE PROJECT IS COMPLETED. THE ENDS OF THE RISER PIPE AND MANHOLE STUBS SHALL BE CAPPED WITH APPROVED PLASTIC CAPS FURNISHED BY THE MANUFACTURER OF THE PIPE. CONNECTIONS TO MAIN SEWER PIPE AND BACKFILLING RISER PIPE SHALL BE APPROVED BY THE ENGINEER.

FURNISHING AND INSTALLING RISERS SHALL BE PAID FOR AT THE UNIT PRICES BID FOR PIPE, OF PIPE AND REINFORCED CONCRETE ENCASEMENT FOR THE VARIOUS MAIN SEWER PIPE SIZES INDICATED. SUCH PRICES SHALL INCLUDE ALL COSTS FOR COMPLETION OF THIS ITEM INCLUDING SADDLES, BENDS, CONCRETE, REINFORCING STEEL, CAPS OR PLUGS AND ALL OTHER NECESSARY MATERIALS OR WORK. CONCRETE ENCASEMENT OF THE RISER PIPE TO THE TOP OF THE BEND AS SHOWN ON THE DRAWINGS WILL NOT BE PAID FOR DIRECTLY AND THE COST FOR THIS WORK SHALL BE CONSIDERED AS SUBSIDIARY TO THE OTHER ITEM OF WORK.

THE PROJECT INSPECTOR SHALL REPORT ON INSPECTOR CARDS THE LOCATION OF ALL RISERS CONSTRUCTED AS MEASURED FROM THE NEAREST MANHOLE, THE DIRECTION OF SERVICE, THE ELEVATION OF THE TOP OF THE RISER AND THE PAVEMENT TYPES INVOLVED. THE PROJECT INSPECTOR SHALL ALSO REPORT ON INSPECTOR CARDS THE LOCATION, DIRECTION OF SERVICE, AND SIZE OF ALL STUBS INSTALLED IN MANHOLES.

LATERAL 71
WAR INDUSTRIES SEWER
City of Wichita, Kansas
Project no. 468-76-245/ 31138-000-000-001

BAUGHMAN COMPANY, P.A.
SURVEYING & ENGINEERING
316/942-7271 • 320 LAURA • WICHITA, KANSAS 67211

8/10

P.C. 5-25

P-C 5-55

SECOND ADDITION TO CEDAR RIDGE

WICHITA, KANSAS

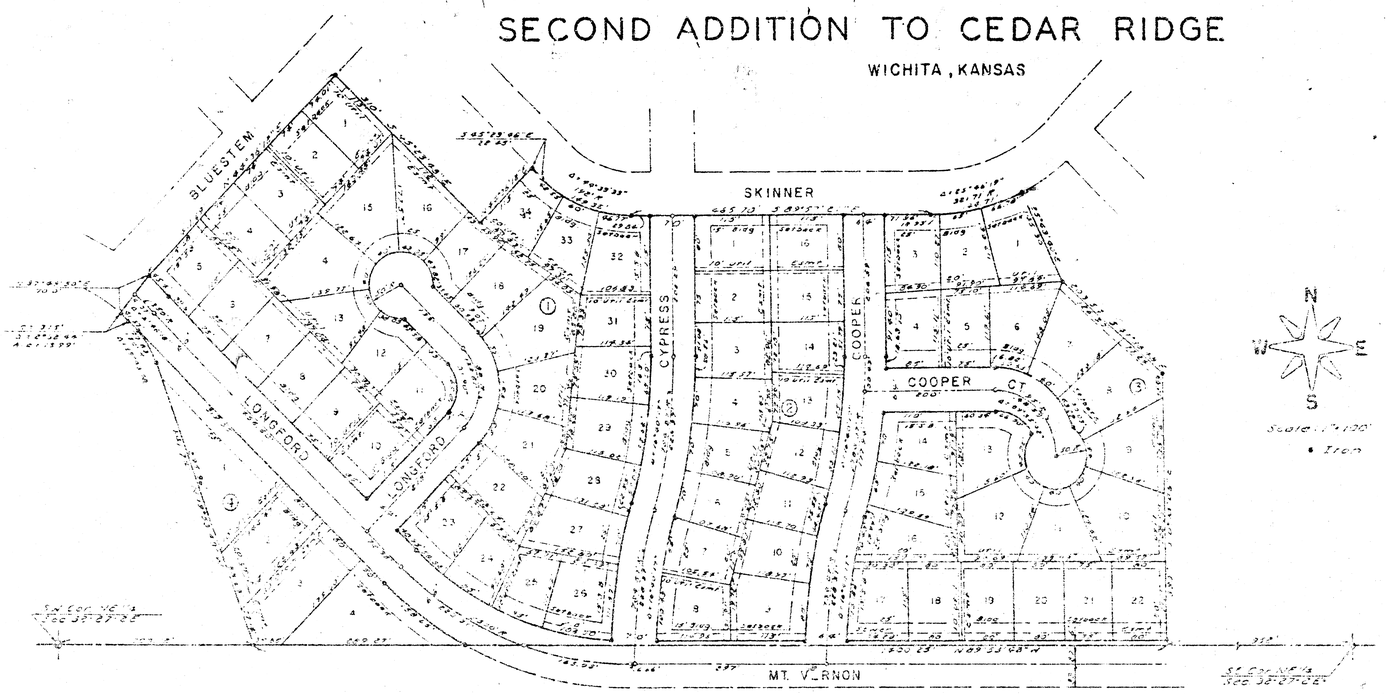

State of Kansas } S.S.
Sedgwick County }

We, Baugman Company, P.A., Surveyors in aforesaid county and state do hereby certify that we have surveyed and platted "SECOND ADDITION TO CEDAR RIDGE", Wichita, Kansas, and that the accompanying plat is a true and correct exhibit of the properly surveyed, described as a replat of Lot 3, Blk 2 of Fourth Addition to Cherry Creek Hills, Wichita, Kansas, and all that part of the NE¼ of Section 32, T21S, R2E of the 6th P.M., Sedgwick County, Kansas, lying south and east of the Fourth Addition to Cherry Creek Hills, Wichita, Kansas, south of First Addition to Cedar Ridge, Wichita, Kansas, east of Hedgecliff Addition, Wichita, Kansas, and west of the following described line: Beginning at a point on the south line of said NE¼, said point being 952 feet west of the SE corner thereof; thence N01°18'05"W, parallel with the east line of said NE¼, 335 feet; thence N47° 38'48"W, 203.54 feet; thence N25°43'40"W, 1953.0 feet to the south line of Skinner St. as platted in said First Addition to Cedar Ridge.

Date June 12, 1981 Baugman Company, P.A.

John E. Lundeberg Surveyor

Know all men by these presants, that we, the undersigned, have caused the land described in the surveyors certificate to be platted into lots, blocks and streets to be known as "SECOND ADDITION TO CEDAR RIDGE", Wichita, Kansas. The easements are hereby granted as indicated for the construction and maintenance of public utilities. The streets are hereby dedicated to and for the use of the public.

Cherry Creek Development, Inc.

Clifford A. Nies President

State of Kansas } S.S.
Sedgwick County }

The foregoing instrument was acknowledged before me this 10 day of June, 1981, by Cherry Creek Development, Inc., by Clifford A. Nies, President. In testimony whereof, I have hereunto set my hand and affixed my notarial seal the day and year above written.

Notary Public

My Commission Expires 5/12

This plat of "SECOND ADDITION TO CEDAR RIDGE", Wichita, Kansas, has been submitted to and approved by the Wichita-Sedgwick County Metropolitan Area Planning Commission, Wichita, Kansas. Dated this 7th day of July, 1980.

Wichita-Sedgwick County Metropolitan Area Planning Commission

William L. Riebel, Chairman

Robert A. Larkin Secretary

This plat approved and all dedications shown hereon accepted by the Board of City Commissioners, Wichita, Kansas, this ___ day of ___, 1981.

___ Mayor

___ City Clerk

This plat approved and all dedications shown hereon accepted by the Board of County Commissioners, Sedgwick County, Kansas, this 1st day of July, 1981

___ Chairman

___ Commissioner

___ Commissioner

Dorothy E. White County Clerk

Entered on transfer record this 2nd day of July, 1981

Dorothy E. White County Clerk

State of Kansas } S.S.
Sedgwick County }

This is to certify that this plat has been filed for record in the Office of the Register of Deeds this ___ day of ___, 1981, at ___ o'clock, ___ M., and is duly recorded.

Doris R. Wescott Register of Deeds

Pat Rawlins Deputy

SECOND ADDITION TO CEDAR RIDGE

3 of 10 9/10

FOURTH ADDITION TO CEDAR RIDGE

WICHITA, KANSAS

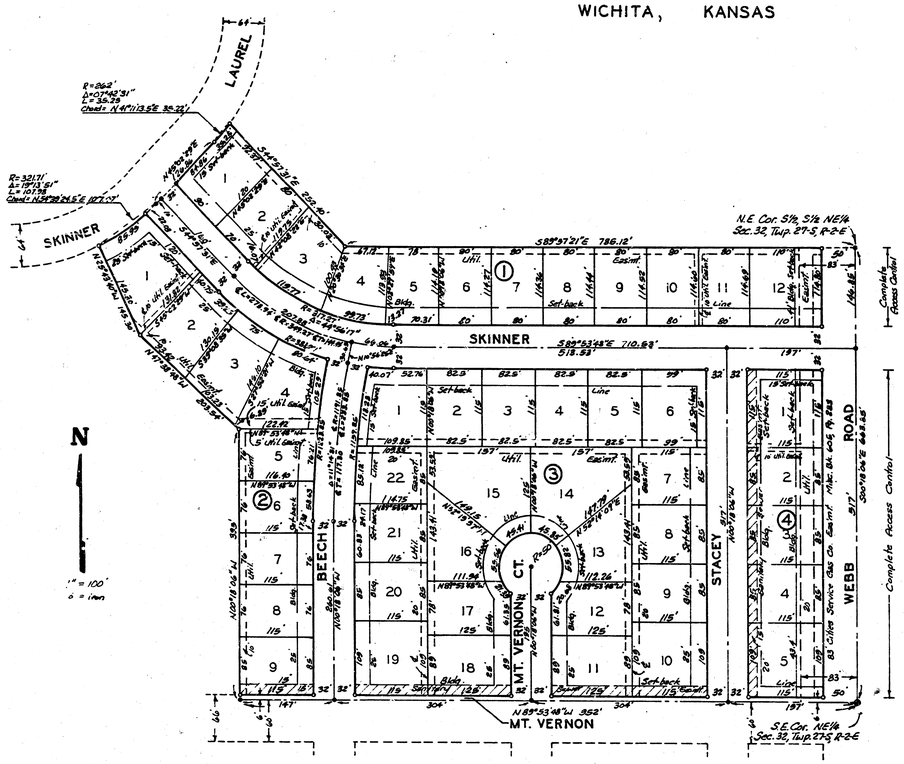

State of Kansas } S.S.
Sedgwick County }

We, Baughman Company, P.A. Surveyors in aforesaid county and state do hereby certify that we have surveyed and platted "FOURTH ADDITION TO CEDAR RIDGE" Wichita Kansas and that the accompanying plat is a true and correct exhibit of the property surveyed, described as and being a replat of Lot 1, Block 2 and Lots 1 and 2, Block 3 and part of Skinner as platted in First Addition to Cedar Ridge, Wichita Kansas and part of the S½ of the NE¼ of Sec. 32, Twp. 27S, R-2E of the 6th. P.M., Sedgwick County, Kansas, all being described as follows:
Beginning at the S.E. Corner of said NE¼; thence N 89°53'48"W, along the south line of said NE¼ 952 feet; thence N 00°18'06"W, parallel with the east line of said NE¼ 395 feet; thence N 47°38'48"W, 203.54 feet; thence N 25°43'40"W, 145.30 feet to a point on a curve to the left, having a radius of 321.71 feet, a central angle of 19°13'51" and an arc length of 107.98 feet; thence northeasterly, along said curve, having a chord bearing N 54°39'24.5"E, 107.47 feet to the point of tangency of said curve; thence N 45°02'29"E, along the tangent of said curve, 126.86 feet to the point of curvature of a curve to the left, having a radius of 262 feet; thence northeasterly along said curve, through a central angle of 07°42'31", an arc distance of 35.25 feet and having a chord bearing N 41°11'13.5"E, 35.22 feet; thence S 44°57'31"E, 252.40 feet to a point on the north line of the S½ of the S½ of said NE¼; thence S89°57'21"E, along the north line of the S½ of the S½ of said NE¼, 785.12 feet to the NE. Corner thereof; thence S 00°18'06"E, 663.85 feet to the place of beginning. Skinner Street being vacated by virtue of K.S.A. 12-512(b).

Baughman Company, P.A.

1-19-84
Date

William L. Korber Surveyor
William L. Korber

Know all men by these presents, that we the undersigned, have caused the land described in the surveyors certificate to be platted into Lots, Blocks and Streets to be known as "FOURTH ADDITION TO CEDAR RIDGE" Wichita, Kansas. Easements are hereby granted as indicated for the construction and maintenance of all public utilities. The streets are hereby dedicated to and for the use of the public. All abutters rights of access to or from Webb Rd. over and across the east line of Lot 12, Block 1, and the east line of Lots 1, 2, 3, 4 and 5, Block 2, are hereby granted to the City of Wichita, Kansas.

Cherry Creek Development, Inc.

Clifford A. Nies President
Clifford A. Nies

Equitable Owner
Red Oaks, Inc.

Stephen Russell President
Stephen Russell

State of Kansas } S.S.
Sedgwick County }

The foregoing instrument was acknowledged before me, this 3rd day of February 1984, by Clifford A. Nies, President of Cherry Creek Development, Inc., on behalf of the corporation and by Stephen Russell, President of Red Oaks, Inc., on behalf of the corporation.

Mark A. Savey Notary Public
Mark A. Savey

My Appt. Exp. 12 May 1984

This plat of "FOURTH ADDITION TO CEDAR RIDGE" Wichita Kansas, has been submitted to and approved by the Wichita-Sedgwick County Metropolitan Area Planning Commission, Wichita, Kansas.
Dated this 22nd day of MARCH 198 .

Wichita-Sedgwick County Metropolitan Area Planning Commission.

Robert F. Chisholm Chairman
Robert F. Chisholm

Robert A. Lakin Secretary
Robert A. Lakin

This plat approved and all dedications shown hereon accepted by the Board of Commissioners of Wichita, Kansas, this 3rd day of APRIL 1984.

Margalee Wright Mayor.
Margalee Wright

Donald E. Gisick City Clerk
Donald E. Gisick

This plat approved and all dedications shown hereon, accepted by the Board of Commissioners of Sedgwick County, Kansas, this 1st day of April 198 4.

Jack Spratt Chairman
Jack Spratt

Donald E. Gragg Commissioner
Donald E. Gragg

Tom Scott Commissioner
Tom Scott

Dorothy K. White County Clerk
Dorothy K. White

Entered on transfer record this 1st day of April 198 4.

Dorothy K. White County Clerk
Dorothy K. White

State of Kansas } S.S.
Sedgwick County }

This is to certify that this plat has been filed for record in the office of the Register of Deeds, this 1st day of April 198 4, at 3 o'clock P M; and is duly recorded.

Bette F. McCart Register of Deeds
Bette F. McCart

Pat Kettler Deputy
Pat Kettler

5-2 5-27

FOURTH ADDITION TO CEDAR RIDGE
14 4 3 50 10 of 10 10/10