

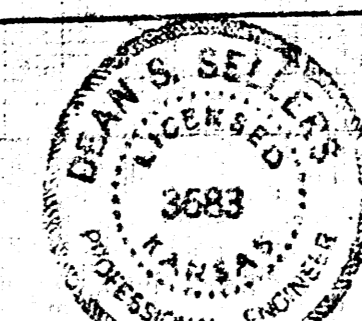
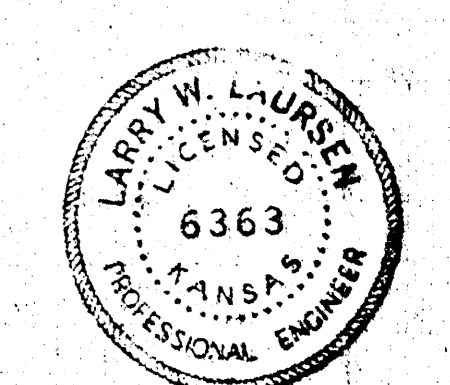
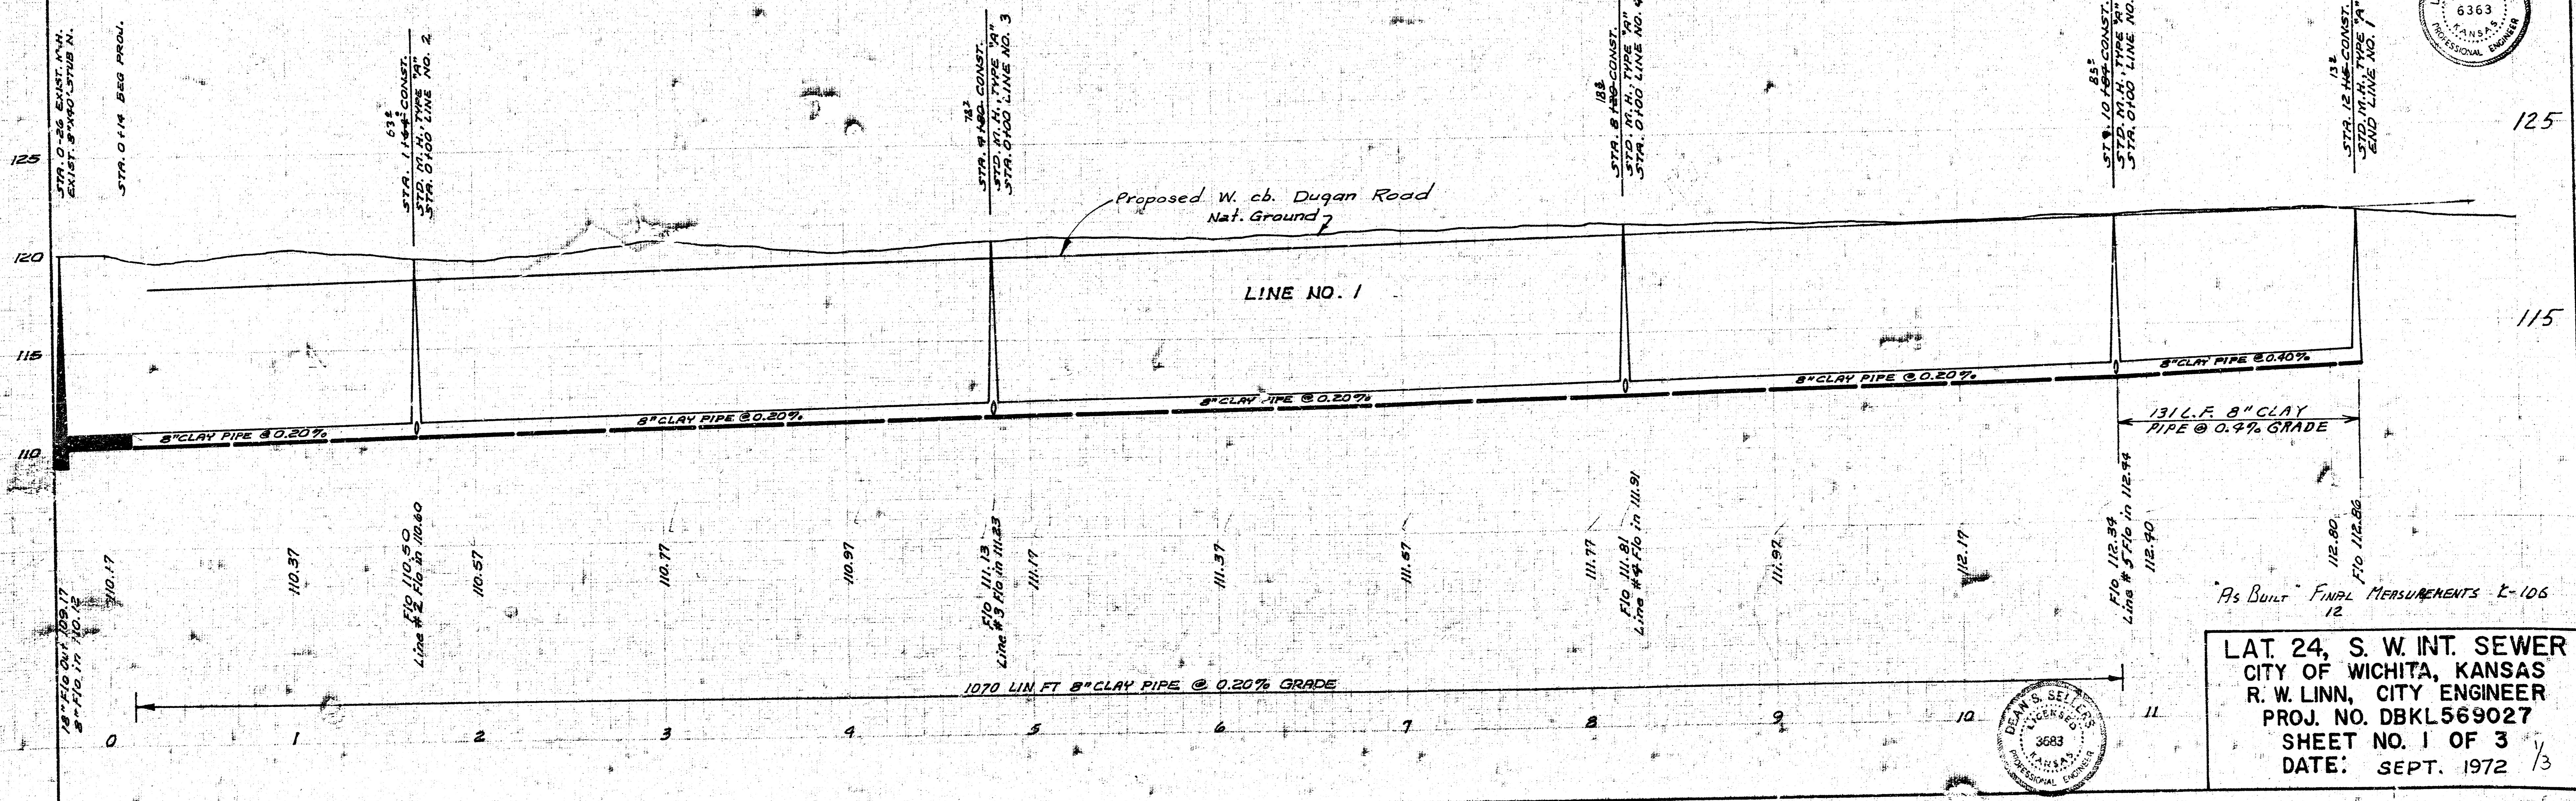
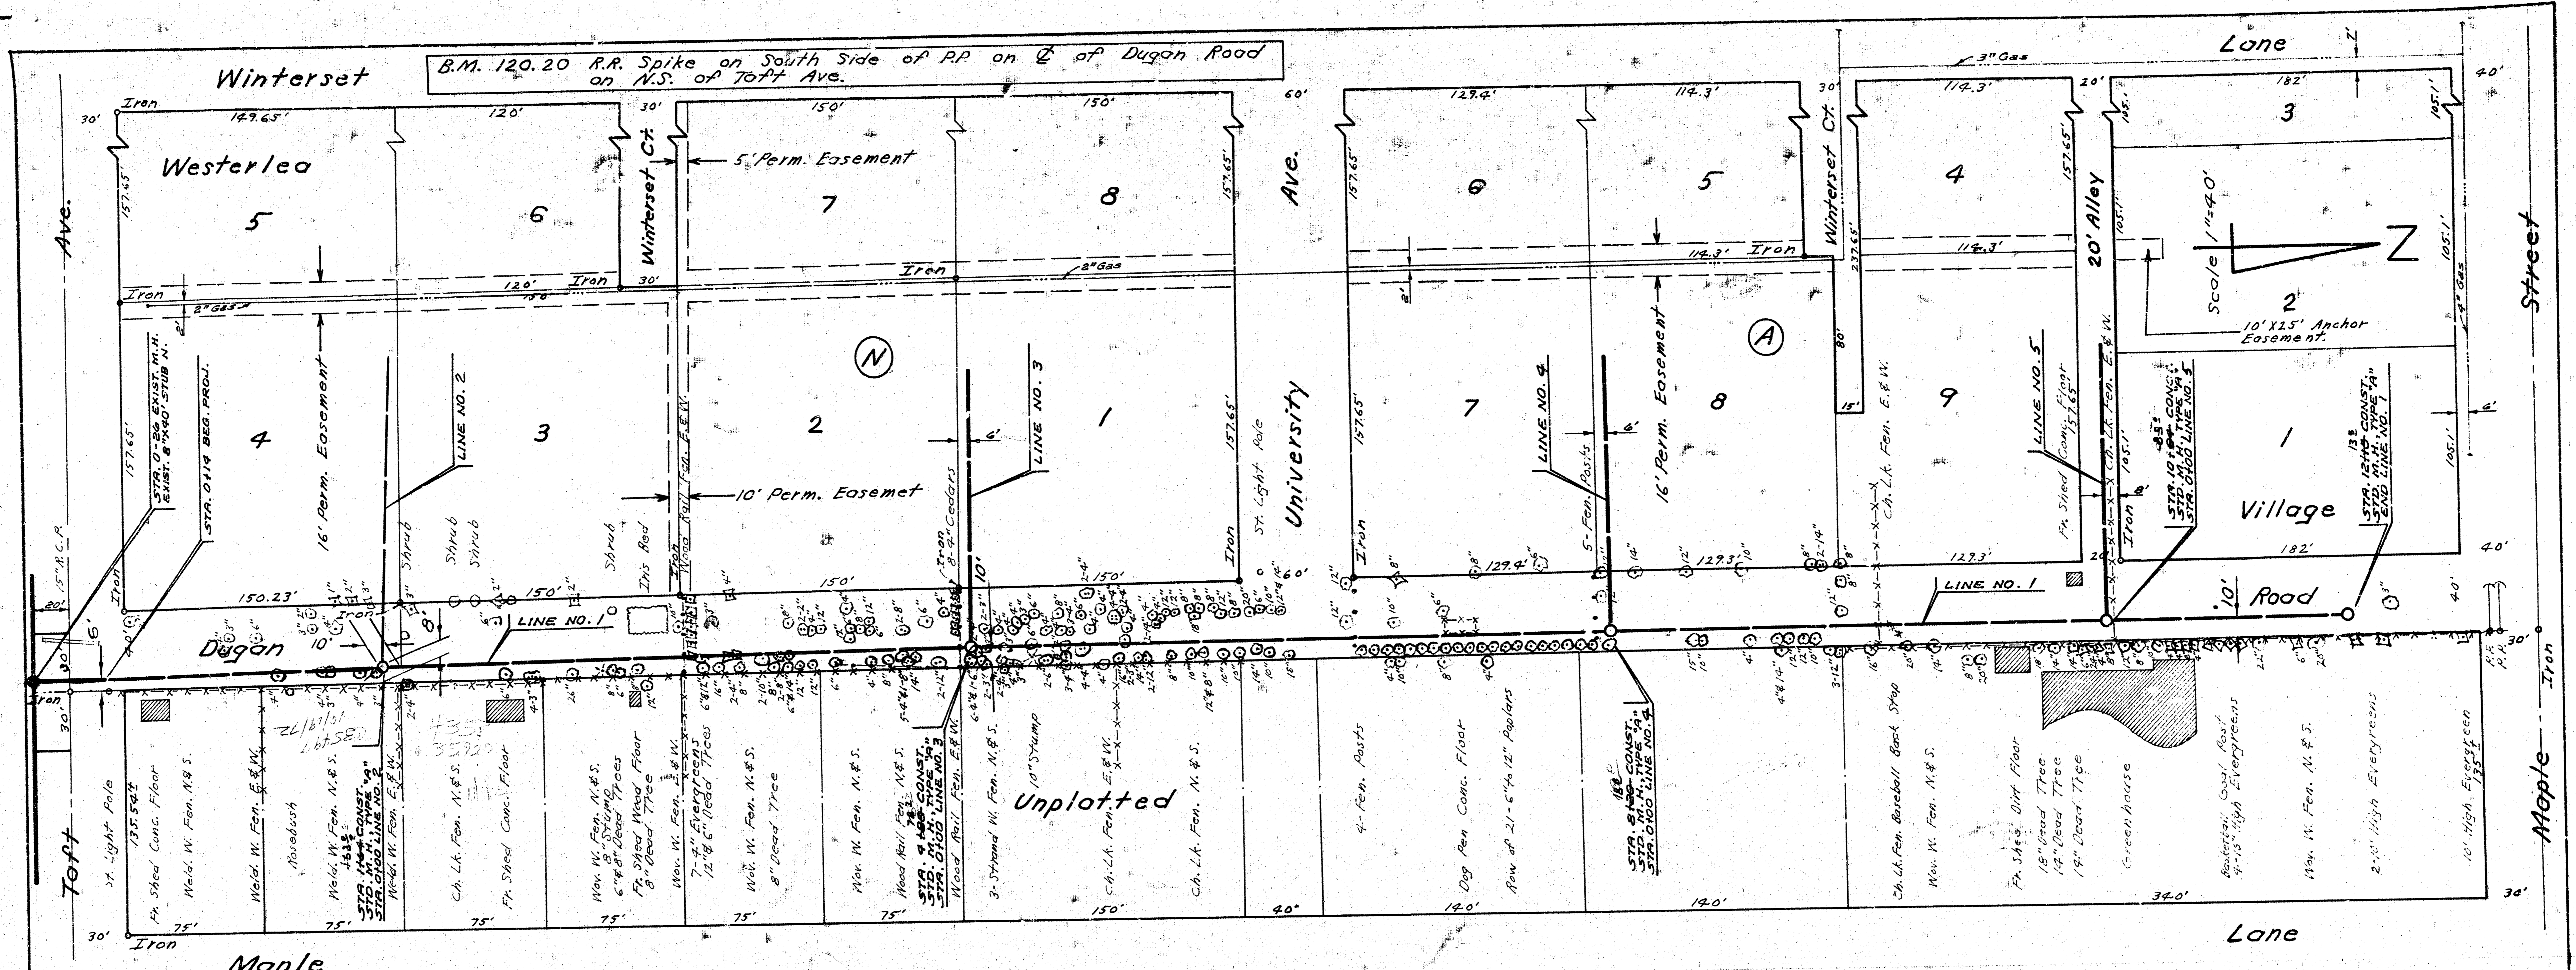




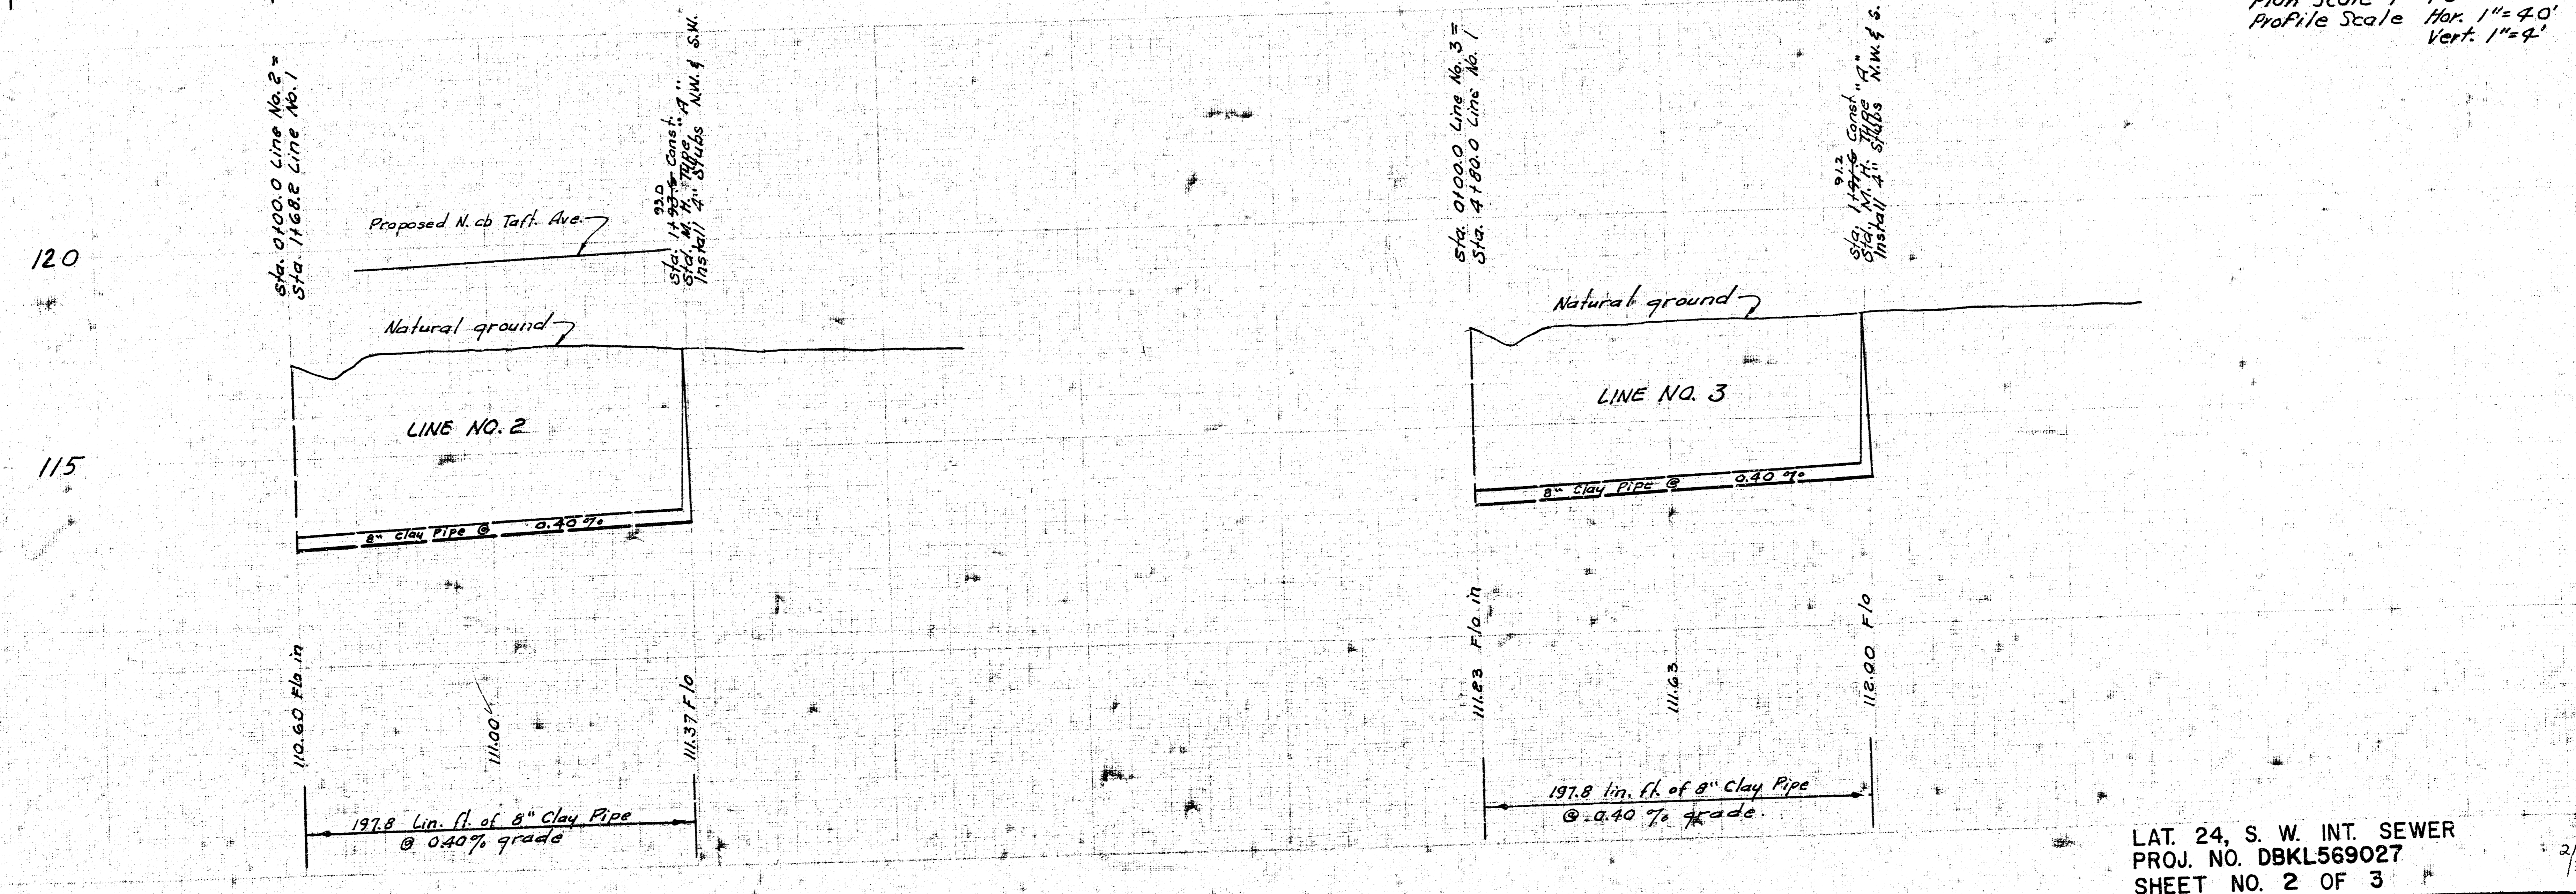

FILMED FROM THE BEST AVAILABLE COPY

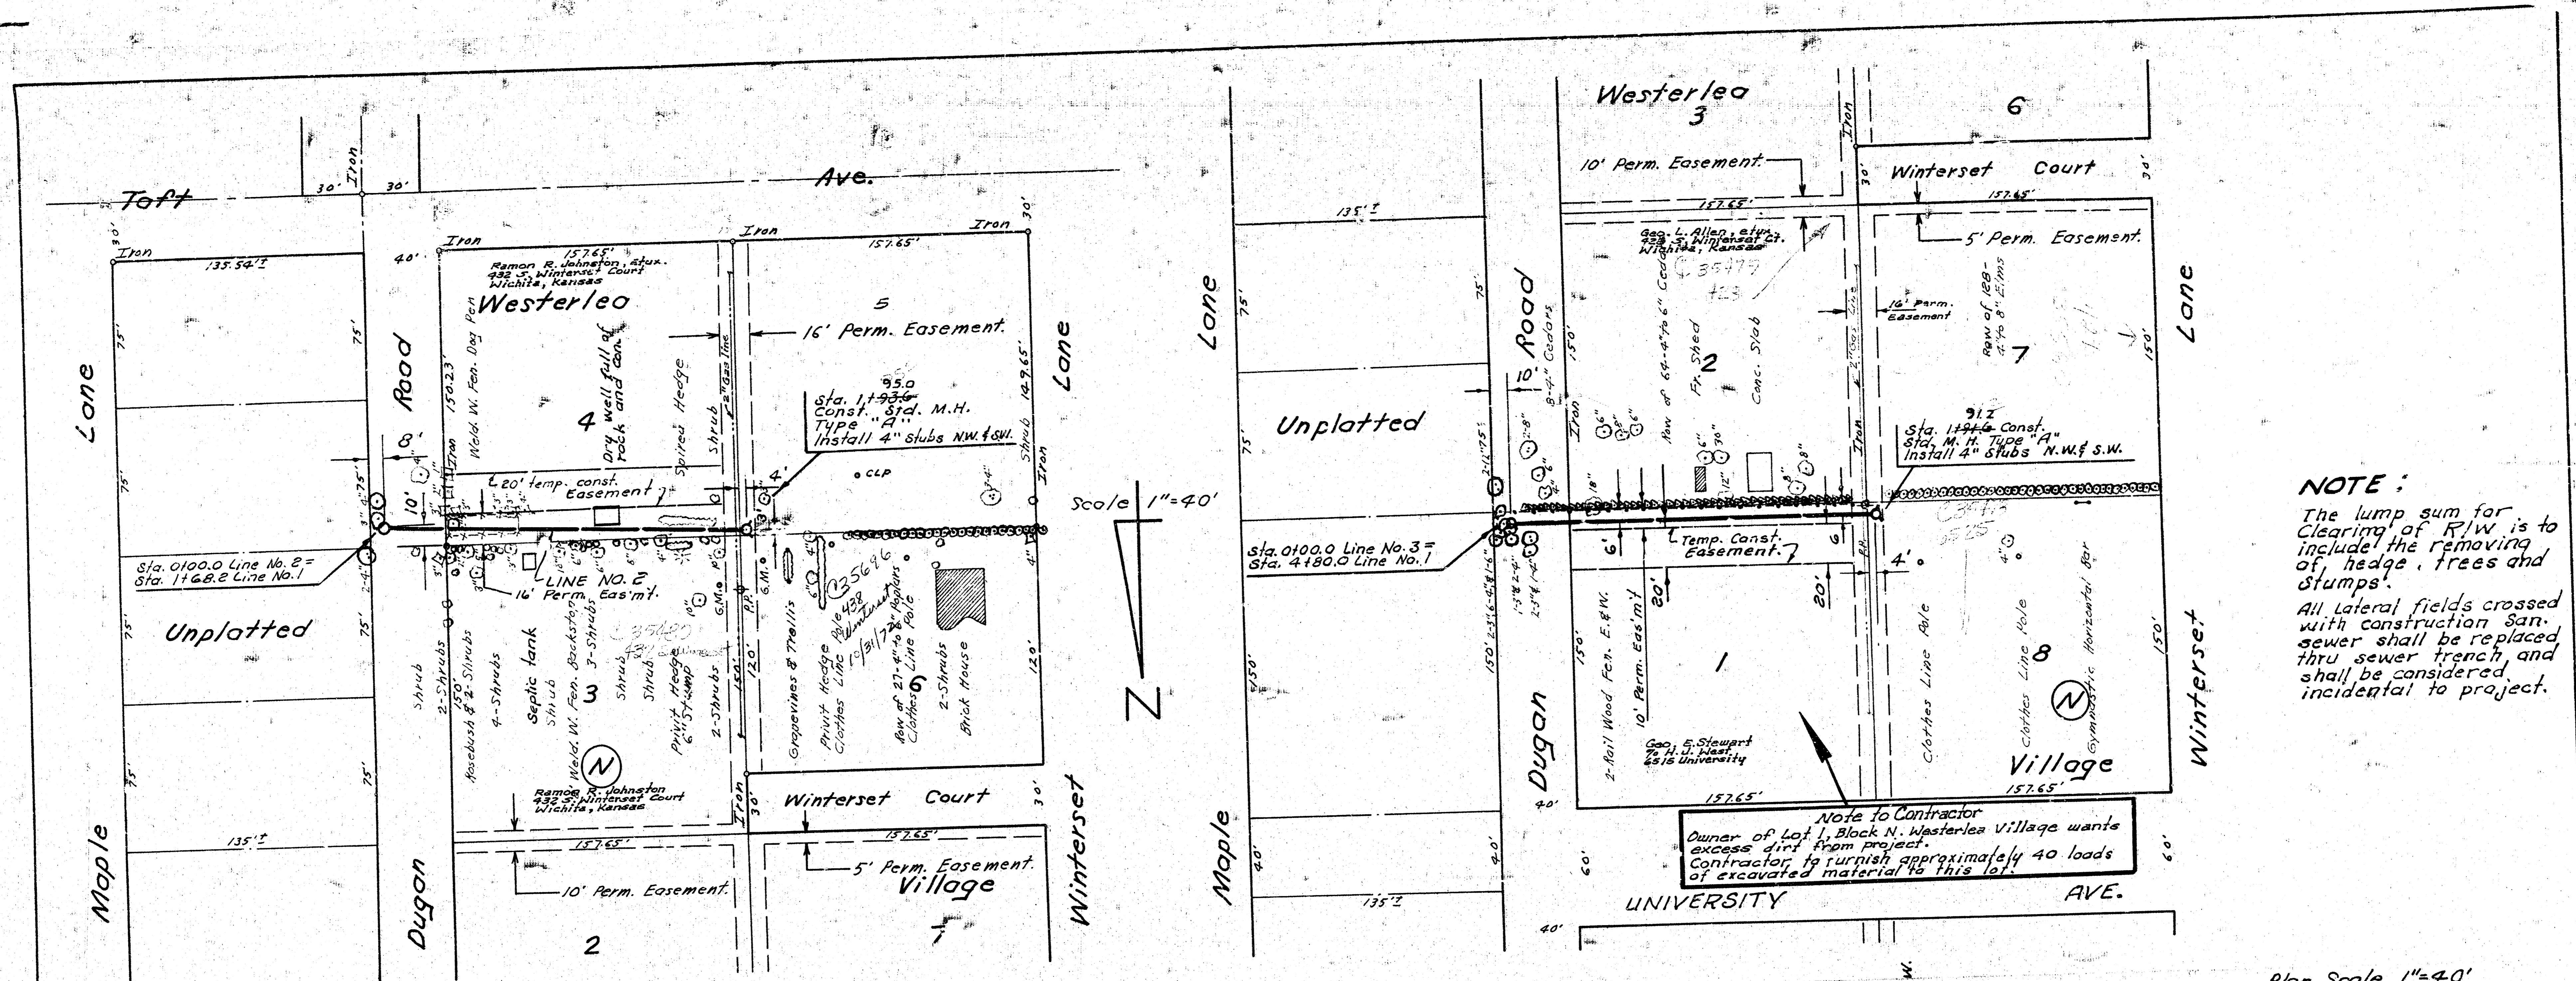


LAT. 24, S. W. INT. SEWER
 PROJ. NO. DBKL569027
 SHEET NO. 2 OF 3

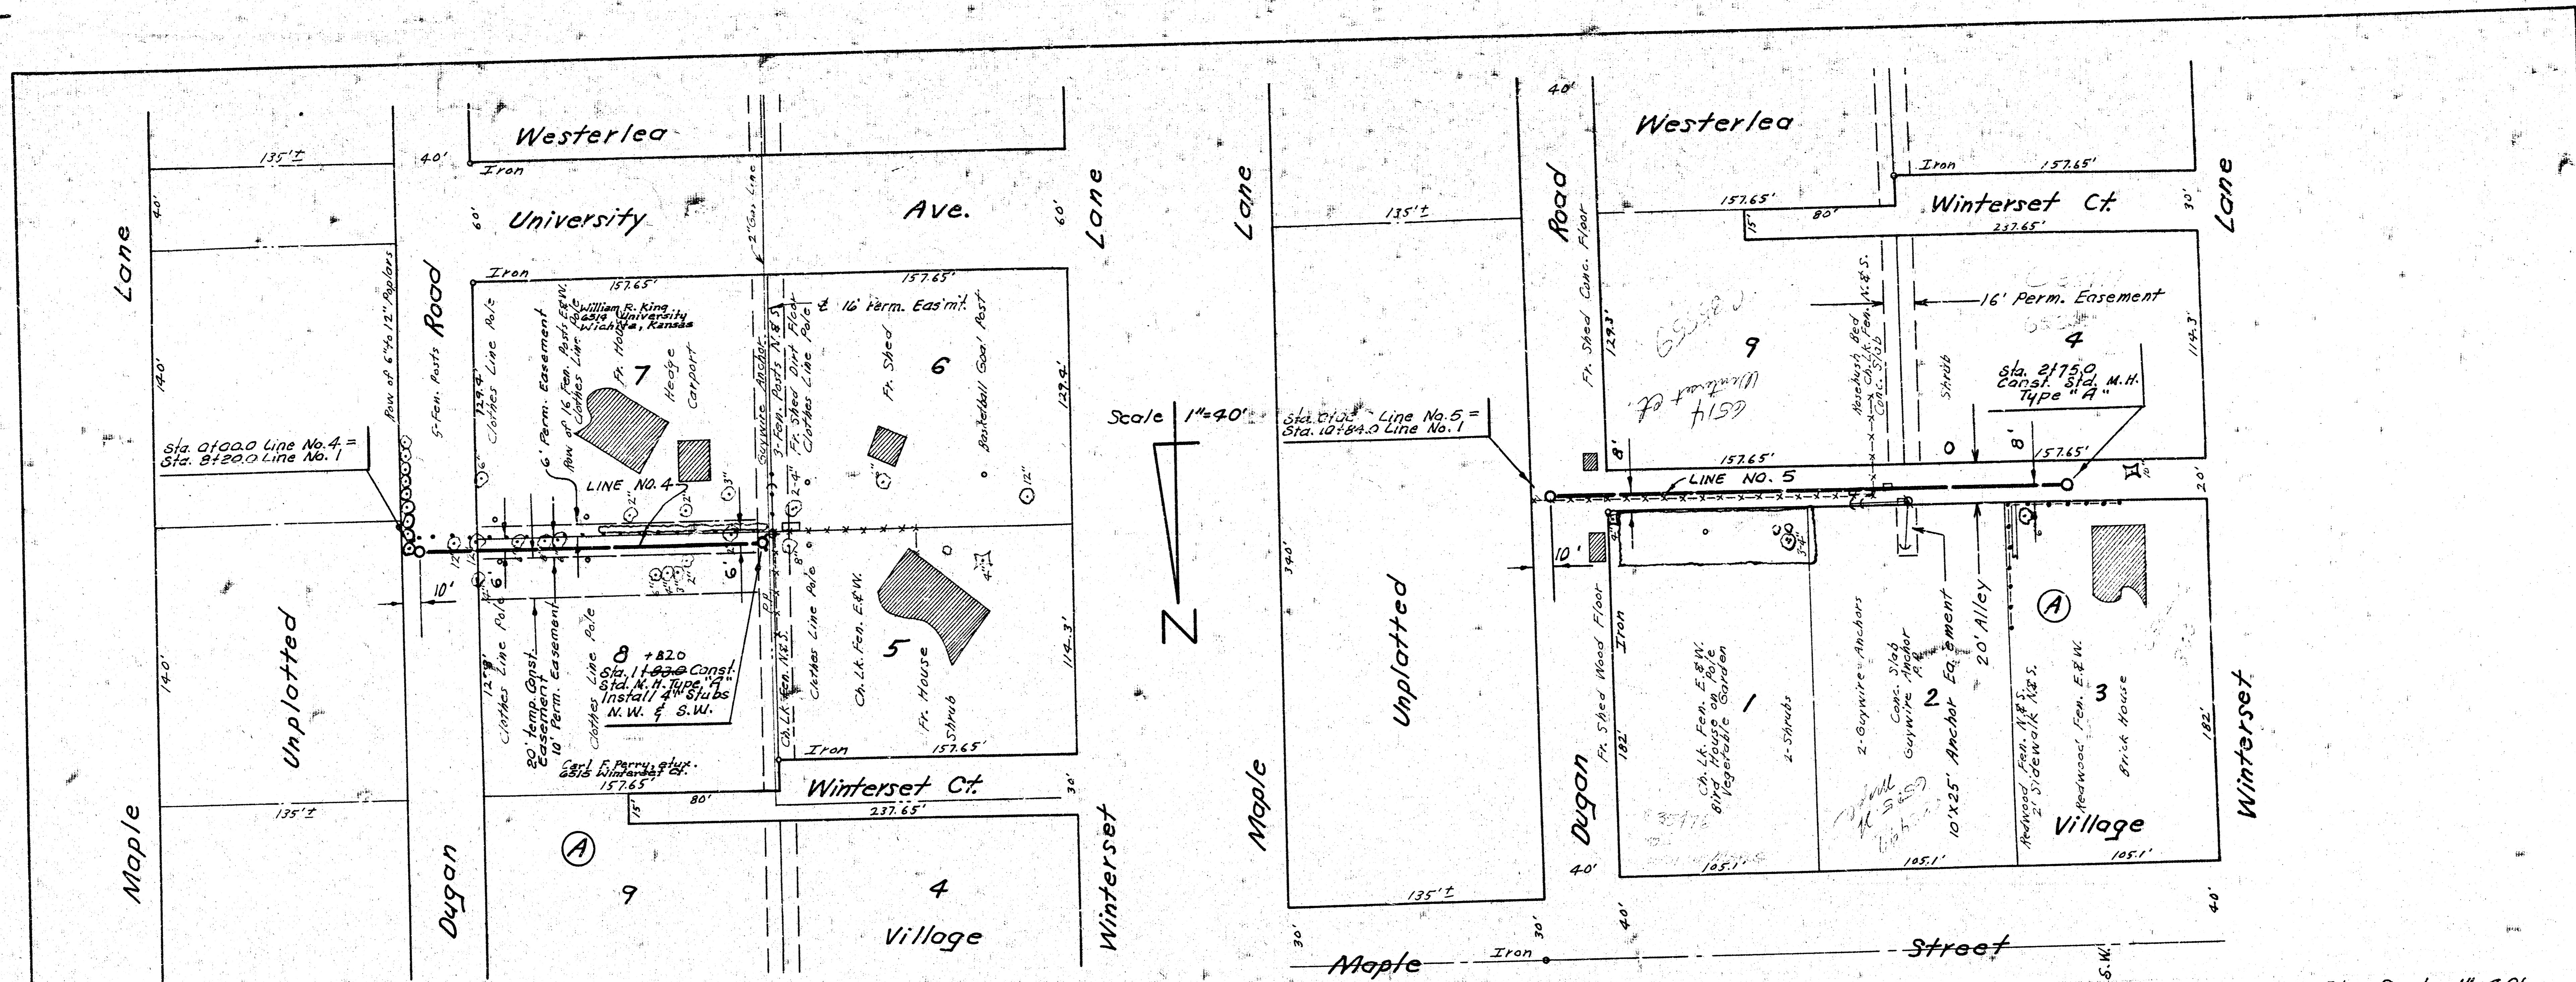

125
115


Sta. 0100.0 Line No. 4 =
Sta. 8120.0 Line No. 1

Install 4" Stubs NW & SW.

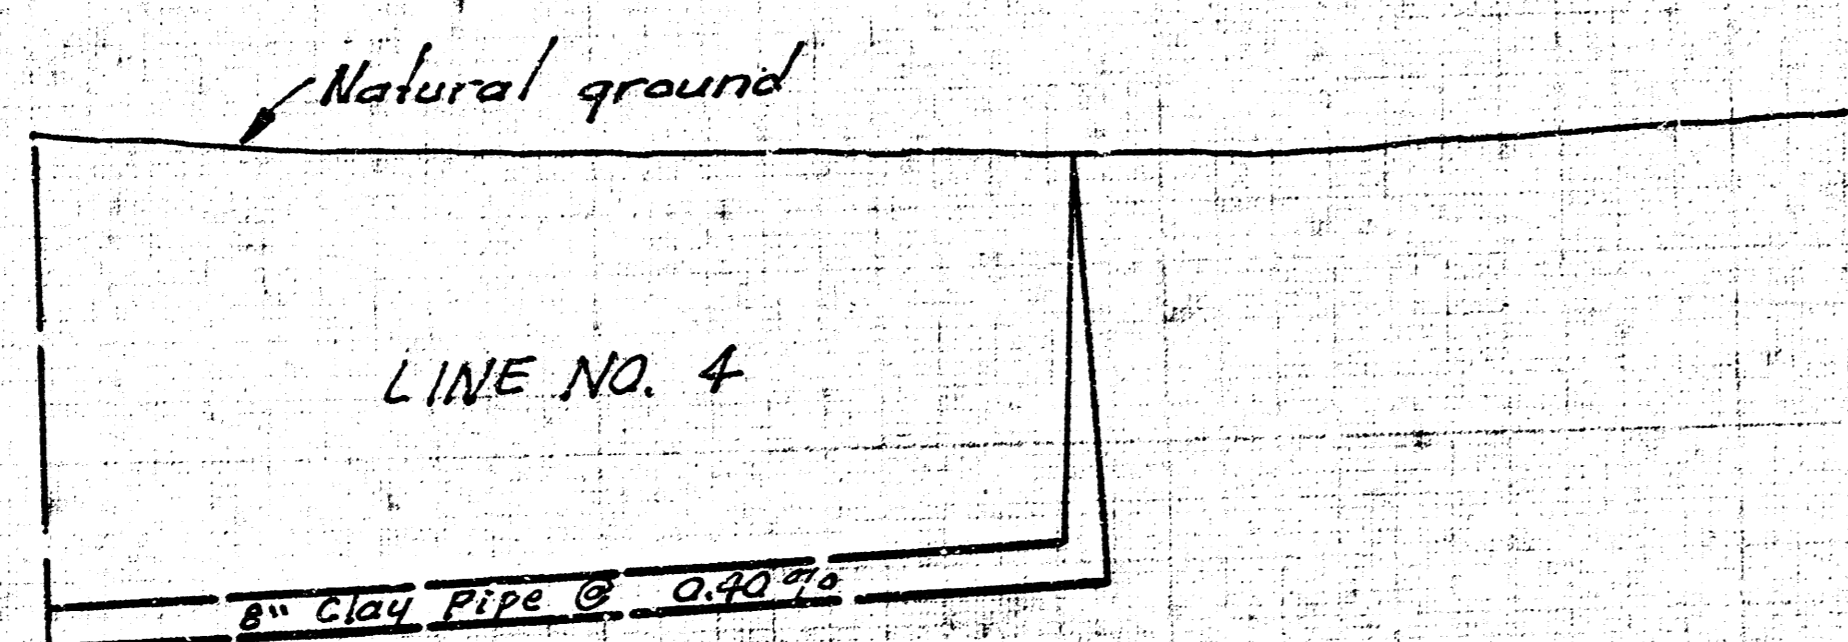

Sta. 0100.0 Line No. 5 =

Sta. 2175.0 Const.

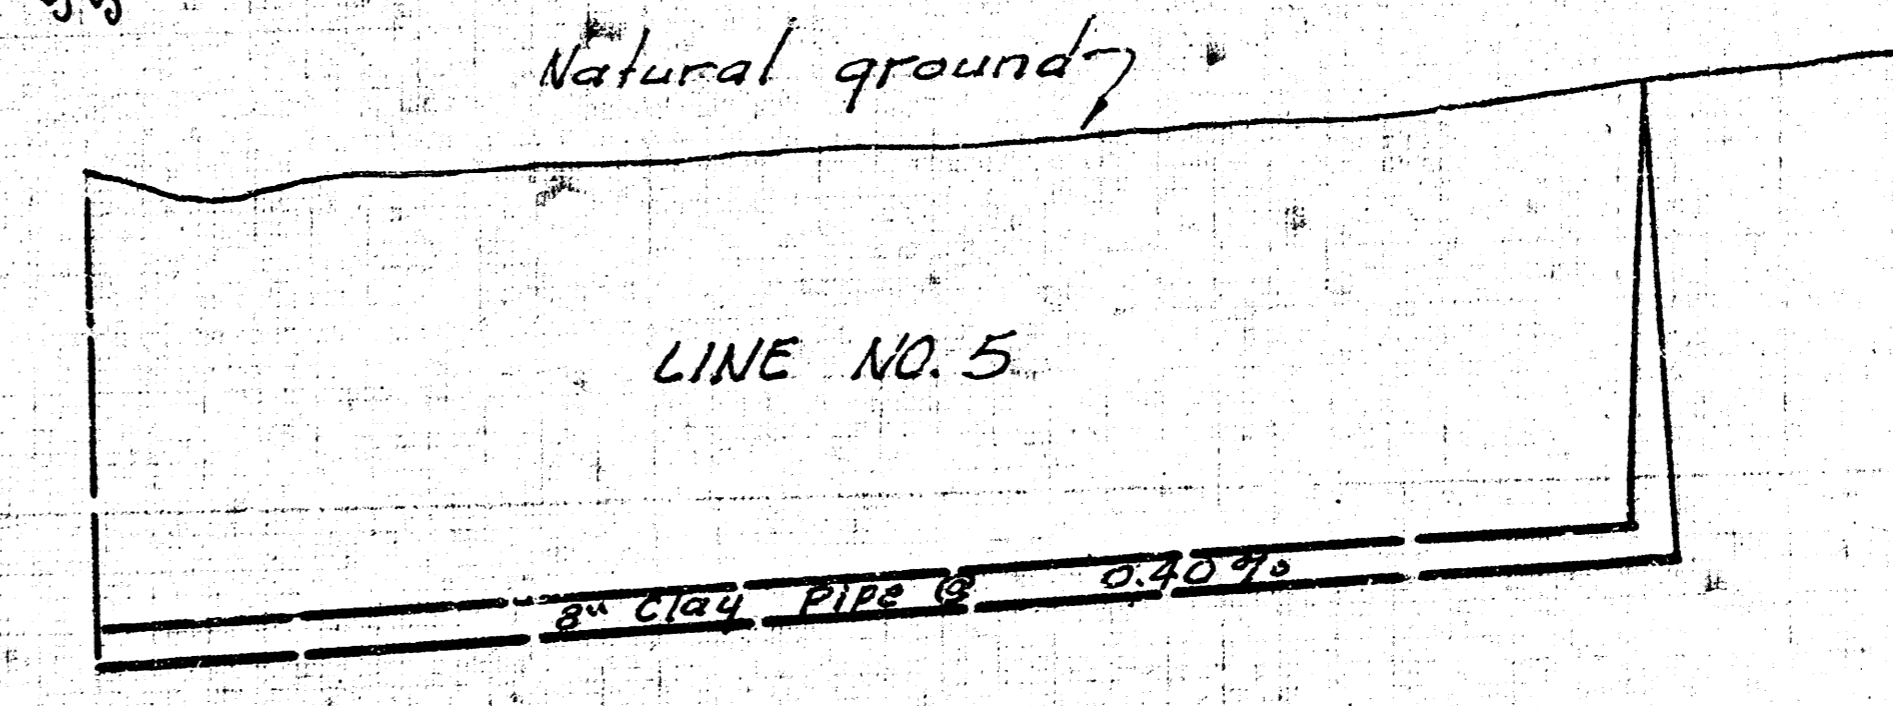

LAT. 24, S. W. INT. SEWER
PROJ. NO. DBKL569027
SHEET NO. 3 OF 3