




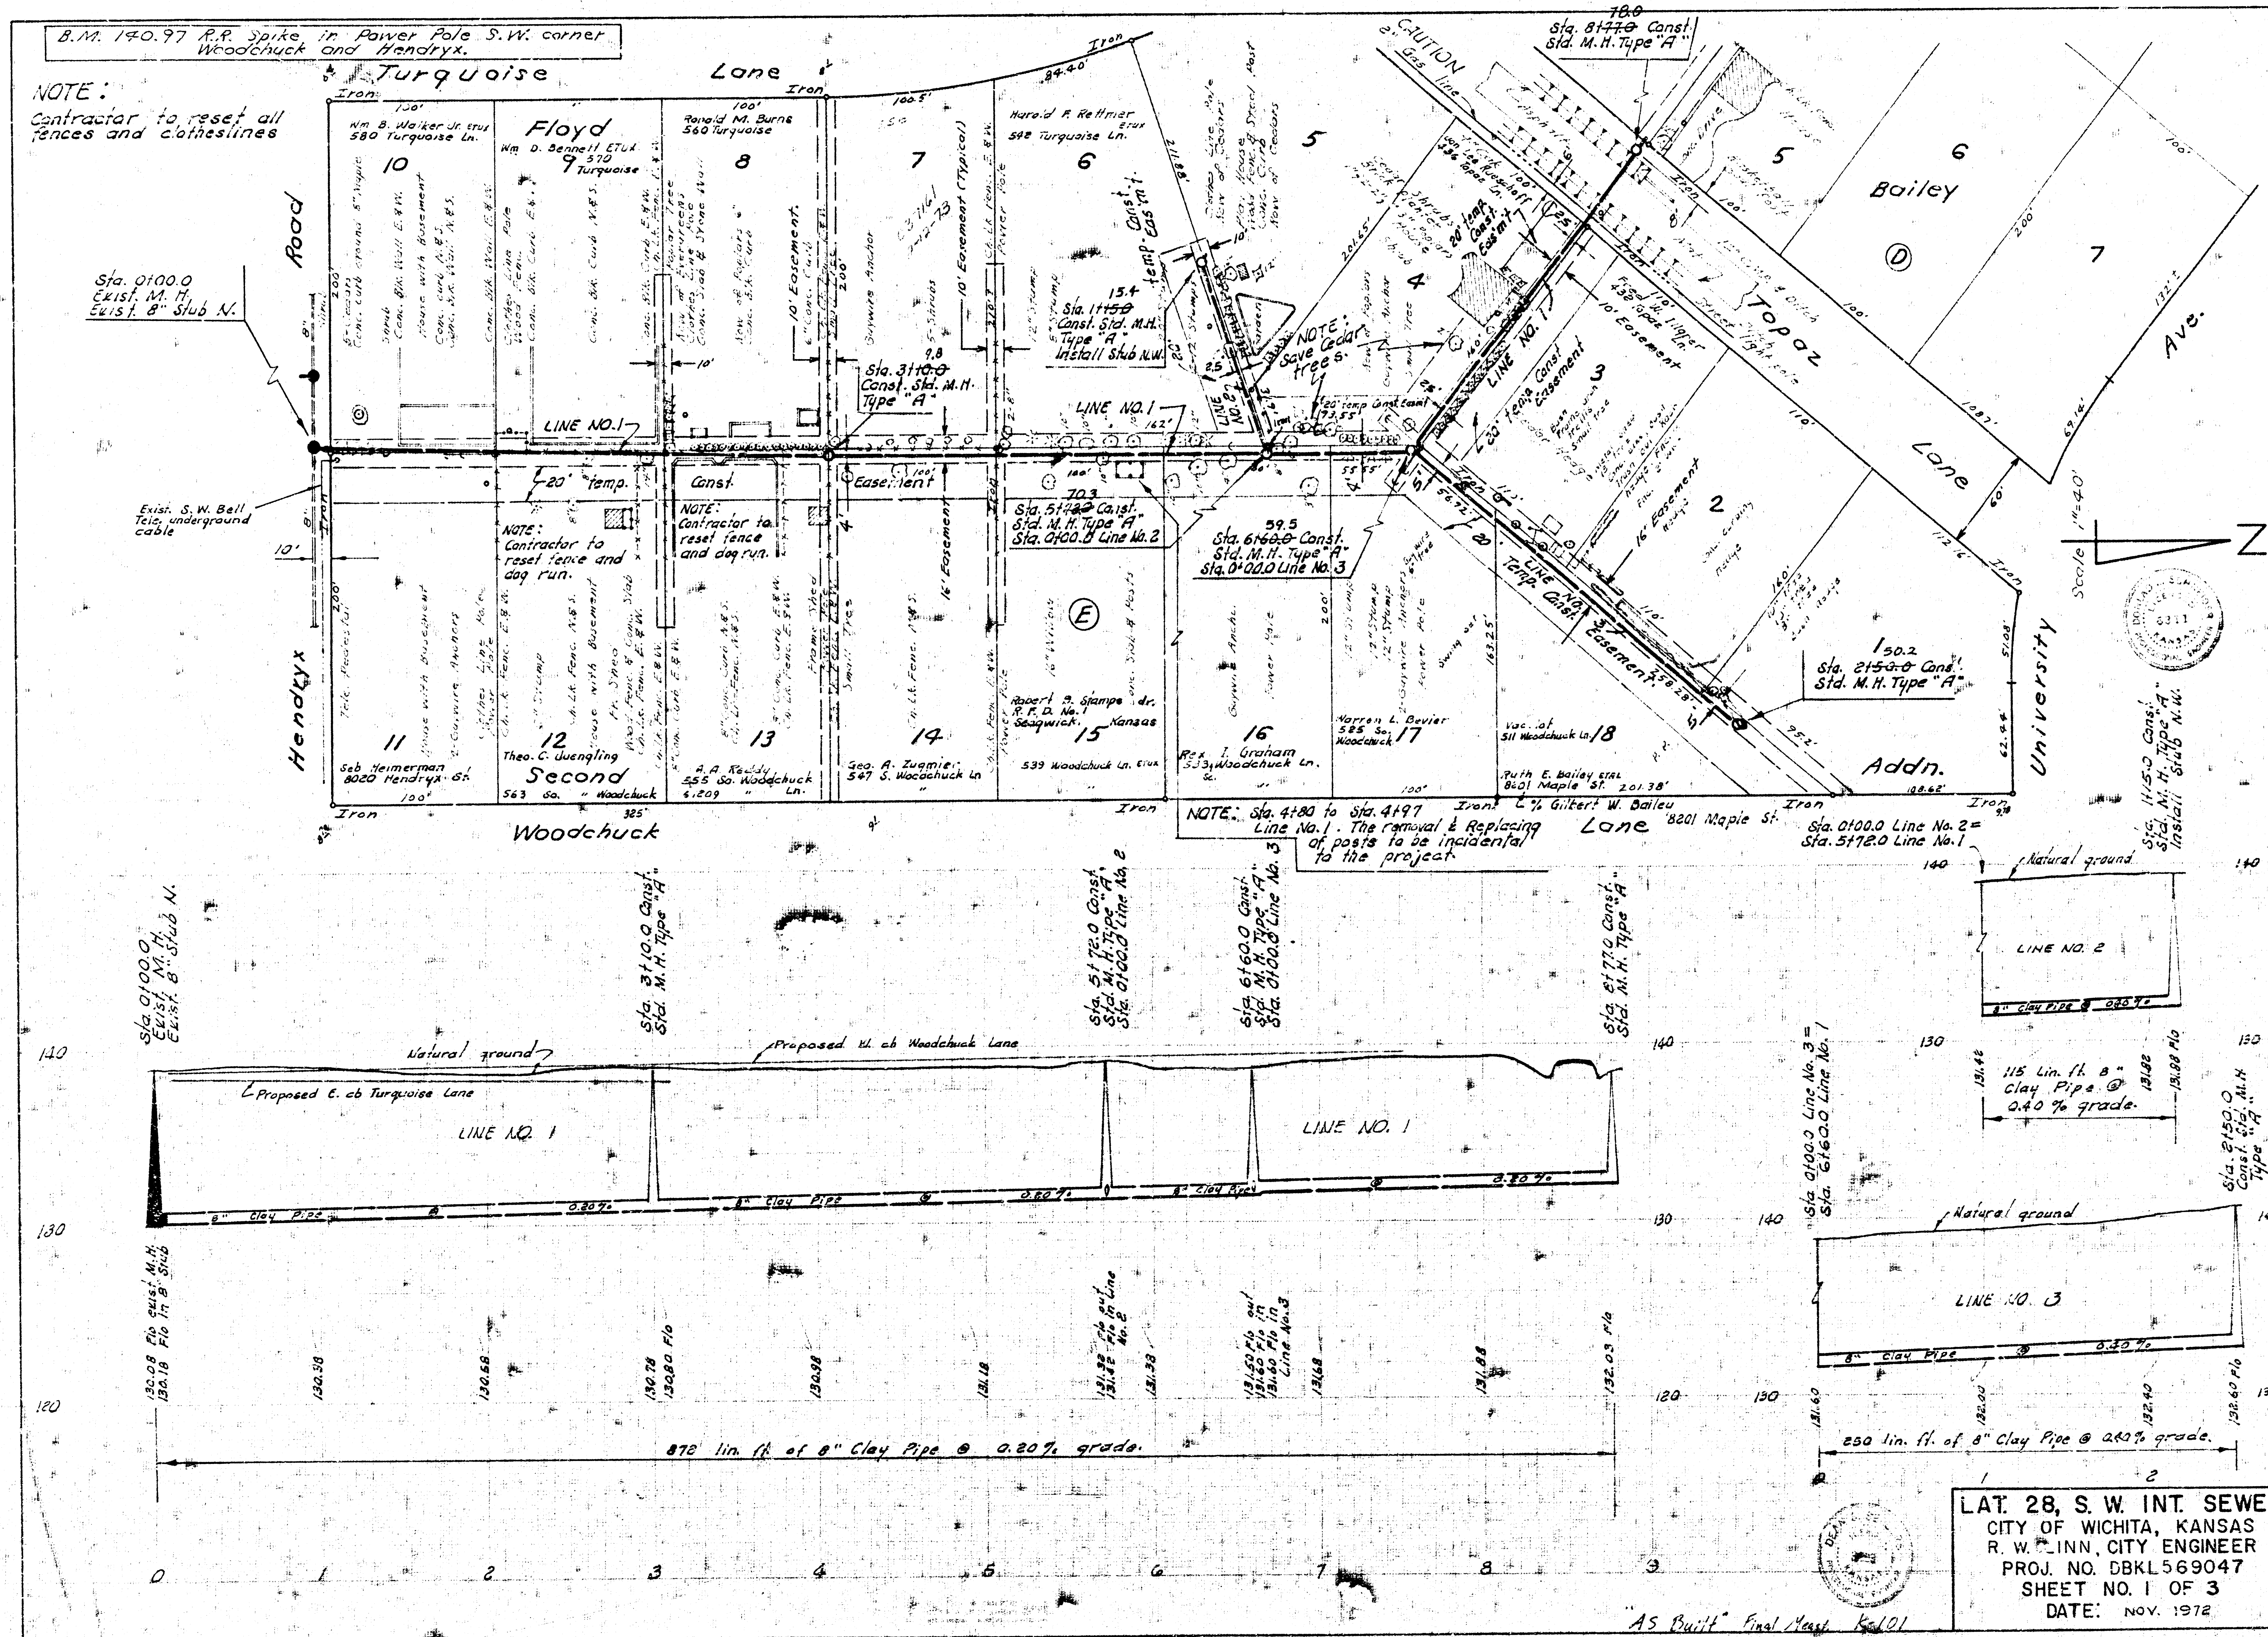

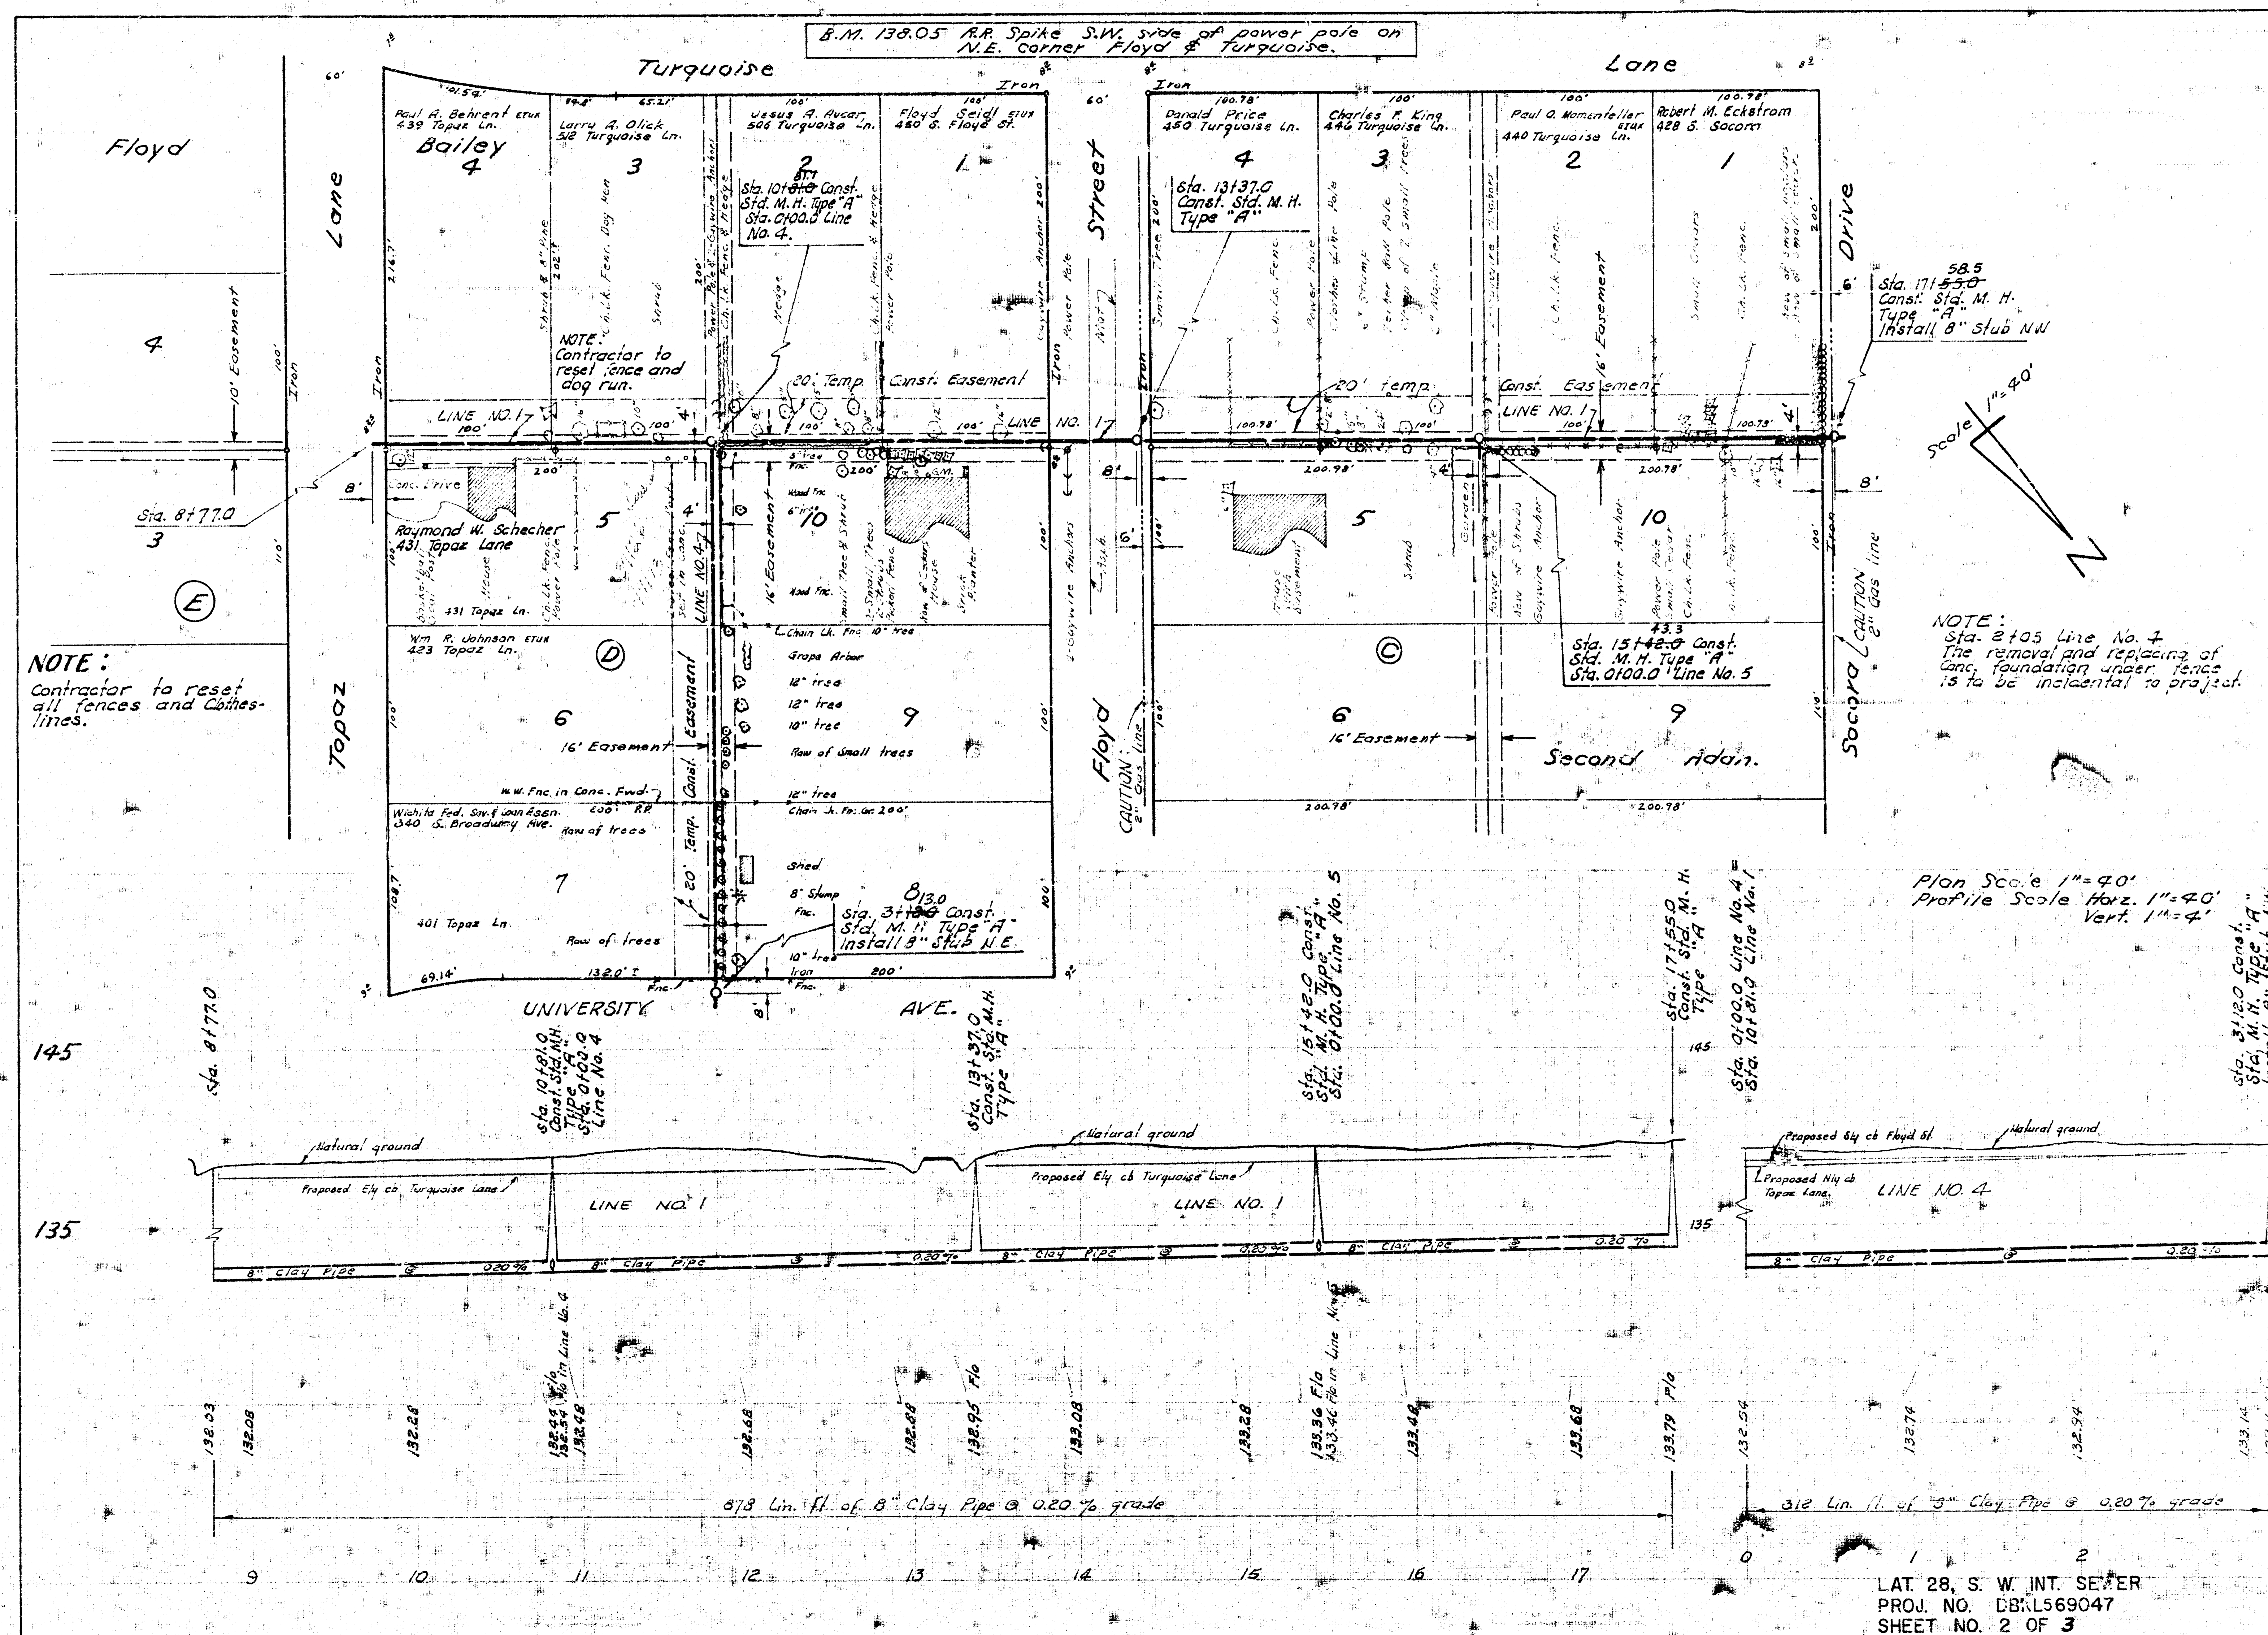

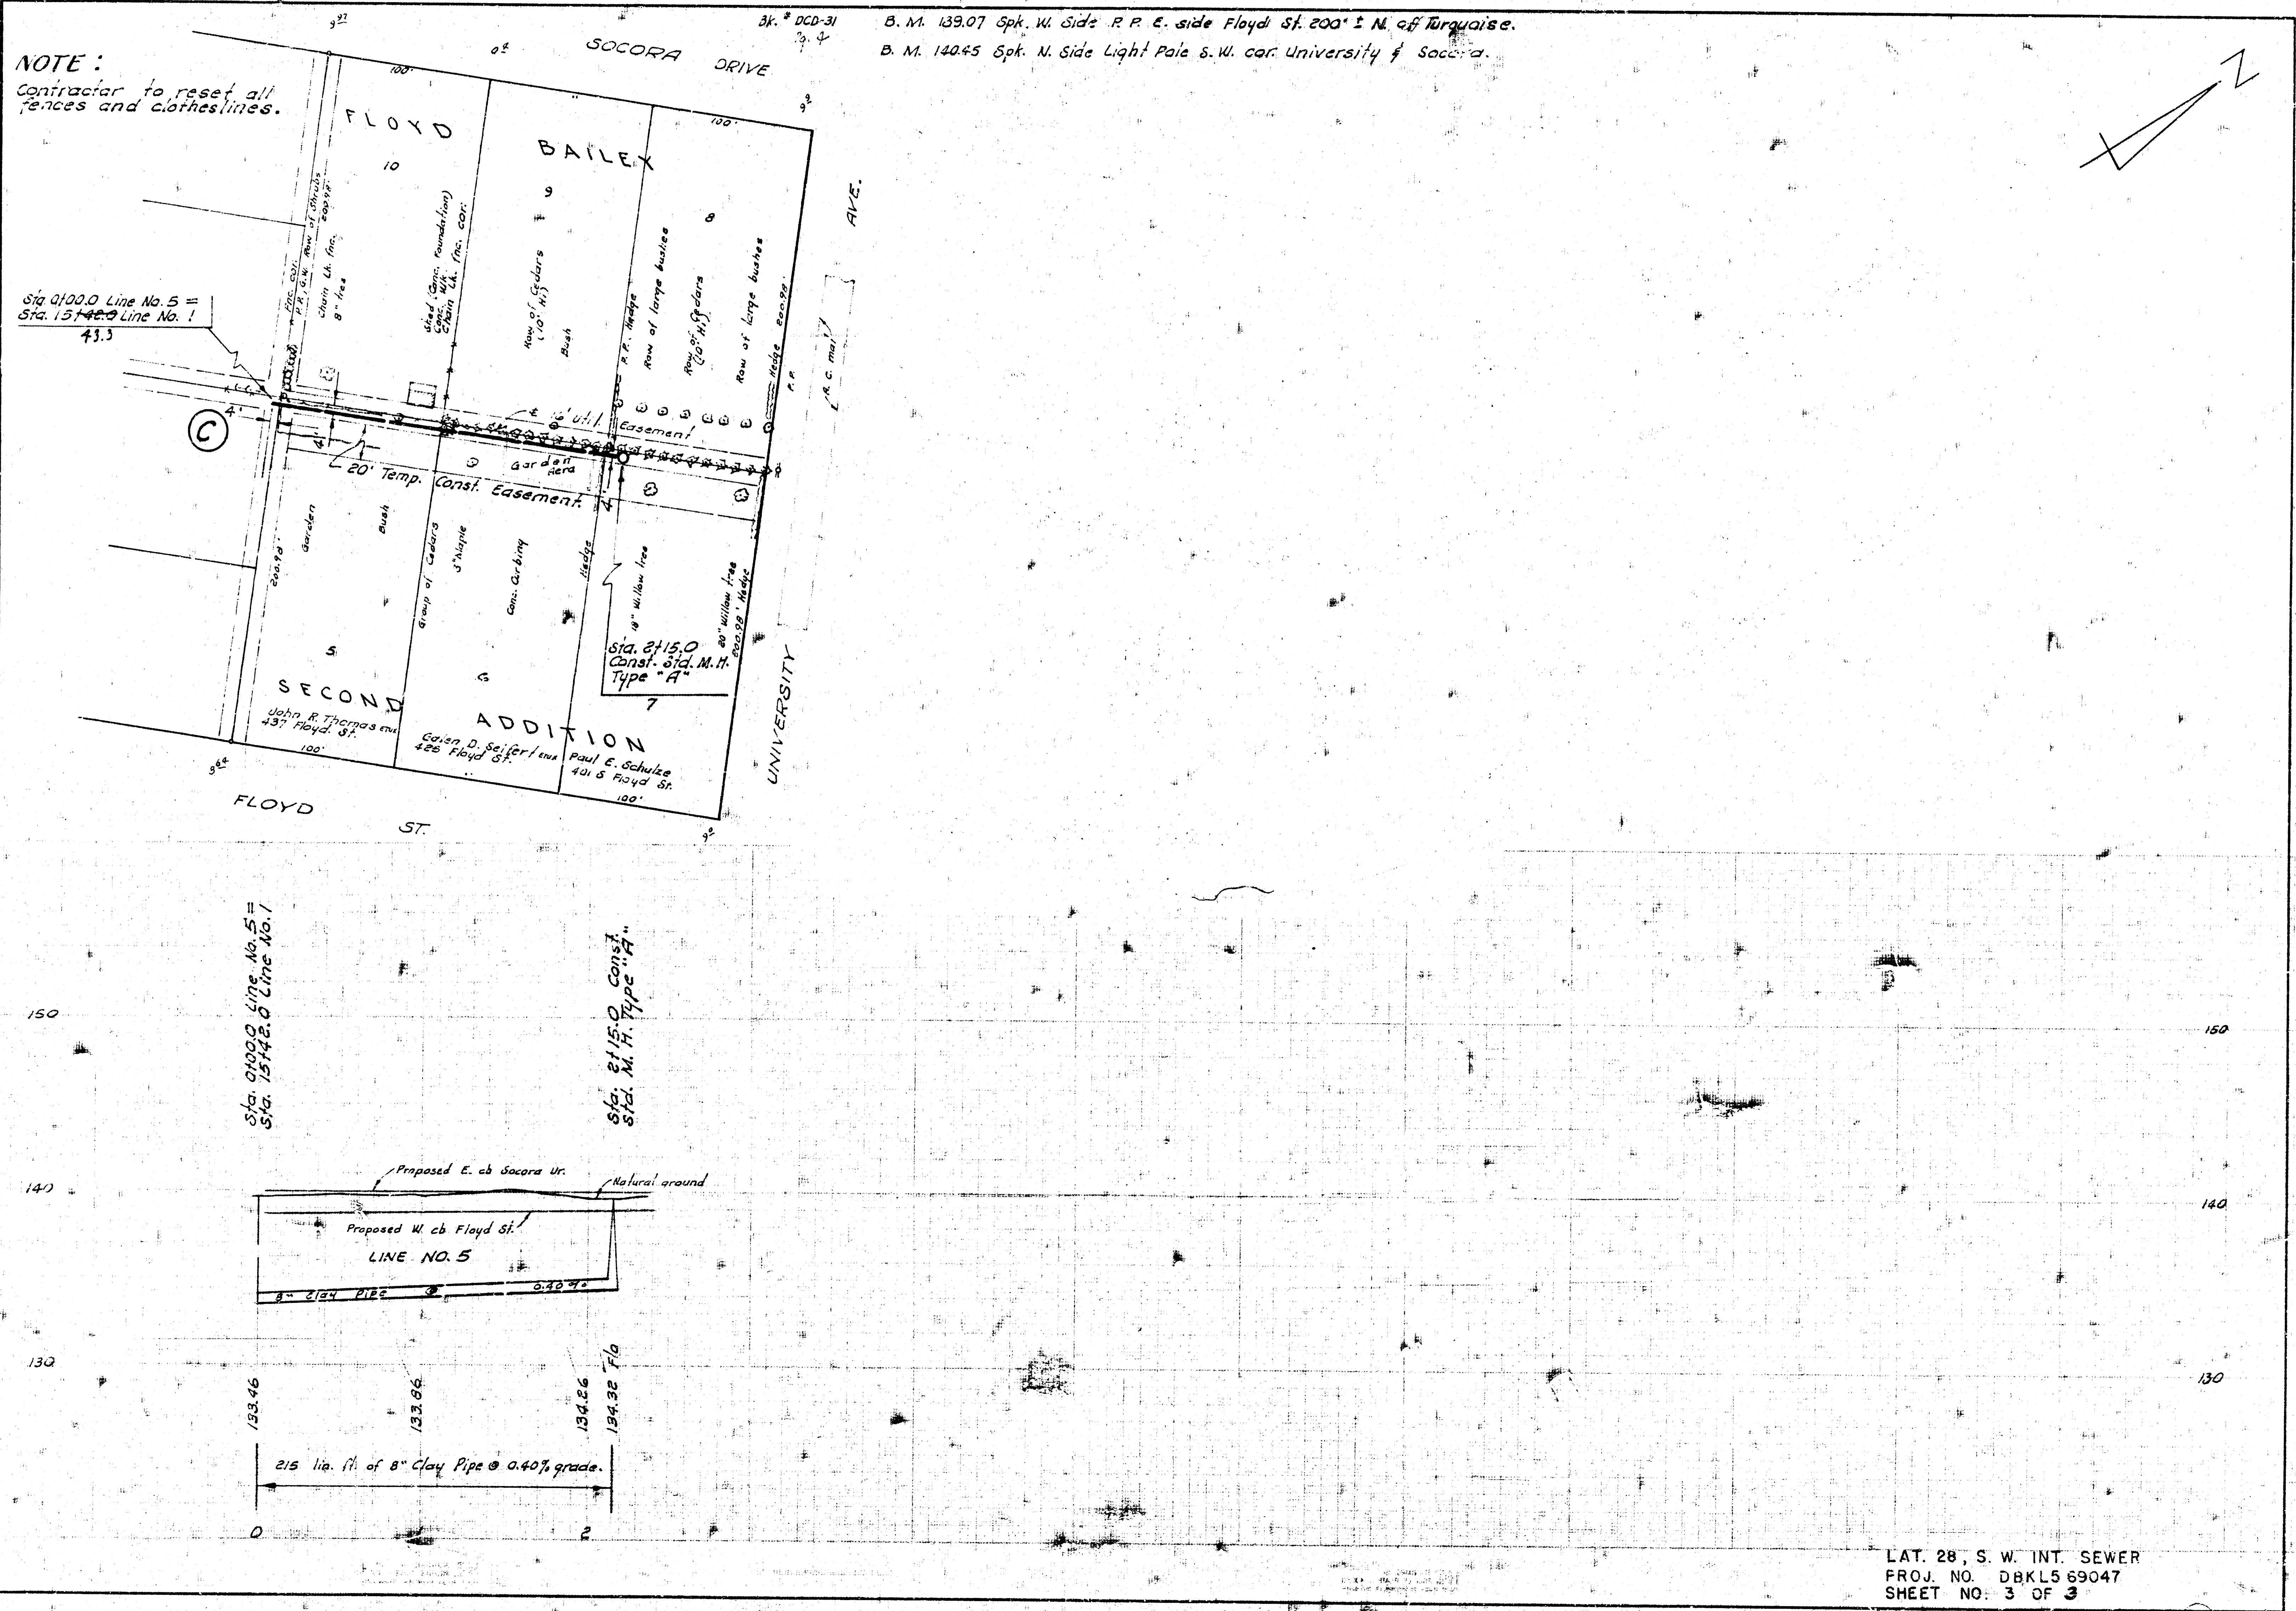

NOTE:
Contractor to reset all
fences and clotheslines.

Sta. 0100.0 Line No. 5 =

B. M. 139.07 Spk. W. Side R.R. E. side Floyd St. 200' E. N. of Turquoise.
B. M. 140.45 Spk. N. Side Light Pole S. W. cor. University & Socora.

LAT. 28, S. W. INT. SEWER
PROJ. NO. DBKL569047
SHEET NO. 3 OF 3