




Plan Scale: 1" = 40'
 Profile Scale: 1/4" = 10'
 1/8" = 5'

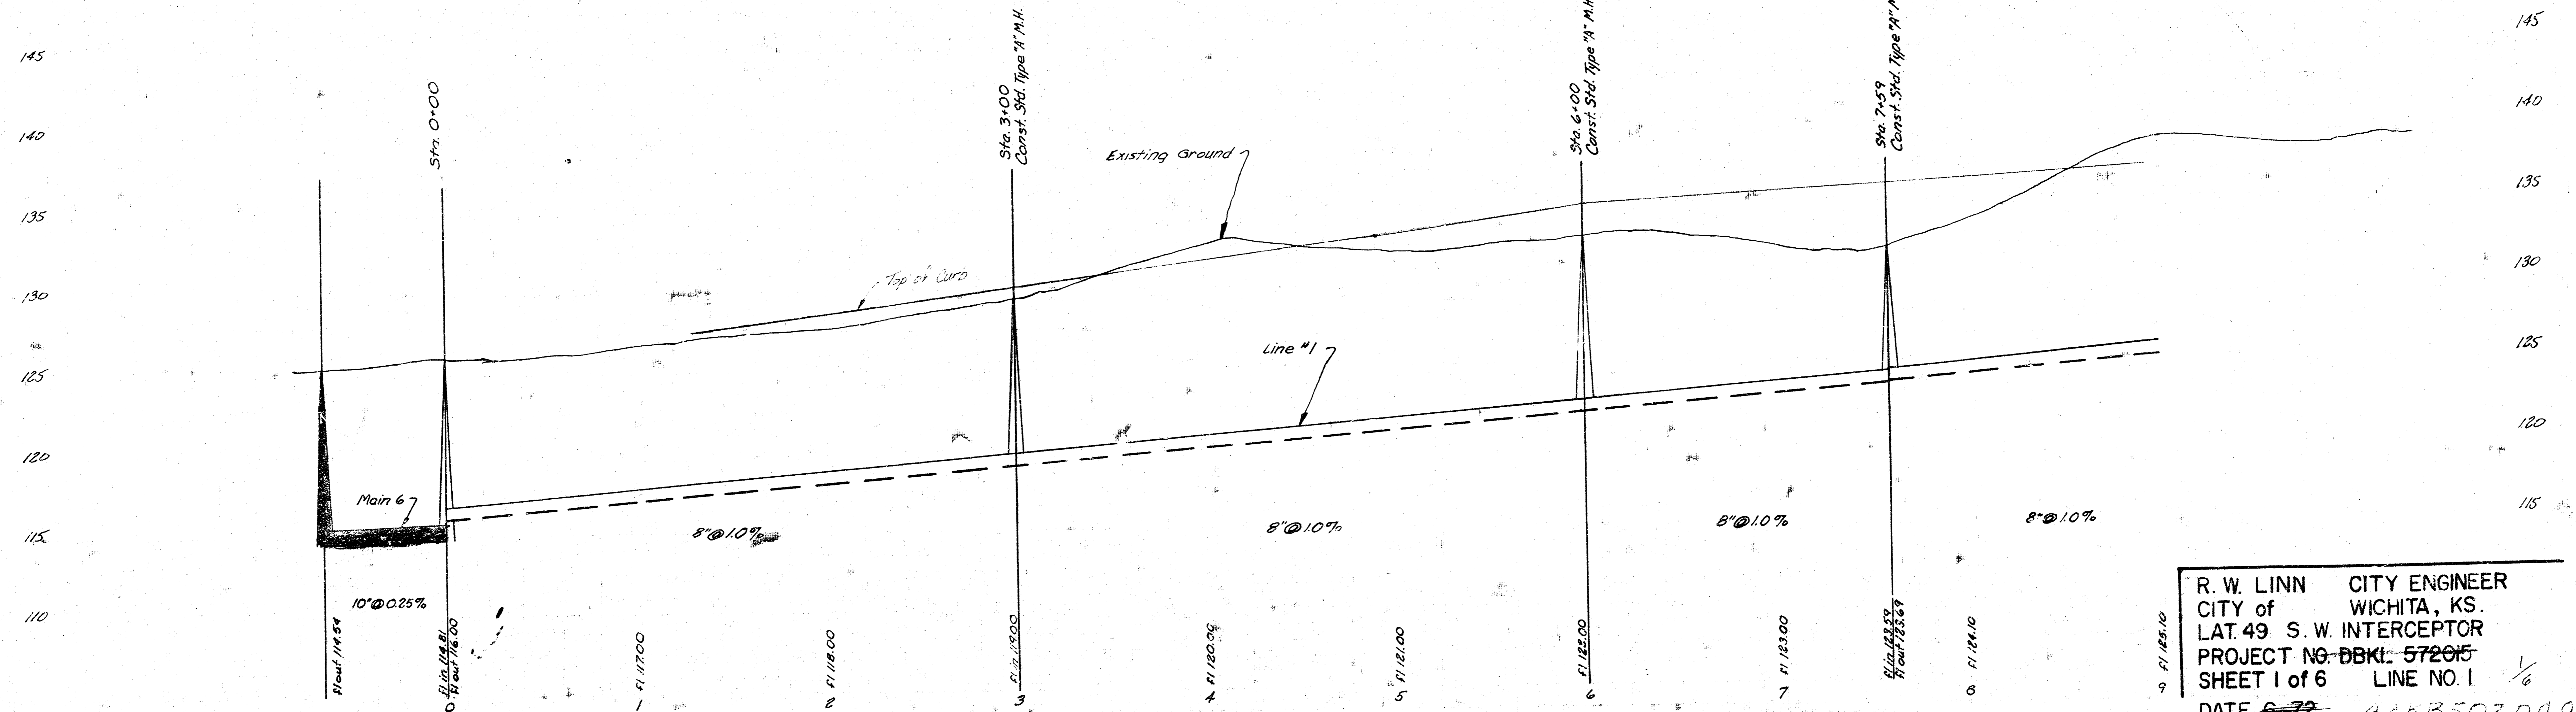


R. W. LINN CITY ENGINEER
 CITY of WICHITA, KS.
 LAT. 49 S. W. INTERCEPTOR
 PROJECT NO. DBKI-572015
 SHEET 1 of 6 LINE NO. 1
 DATE 6-72 AAK3502048

9-72

FILMED FROM THE BEST

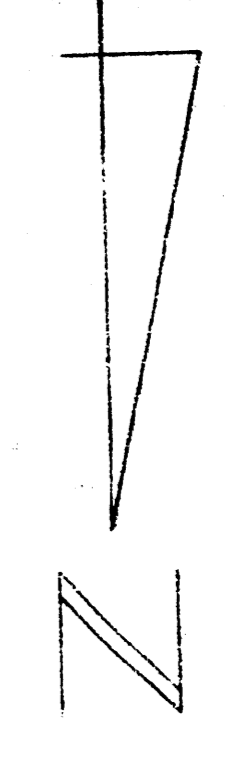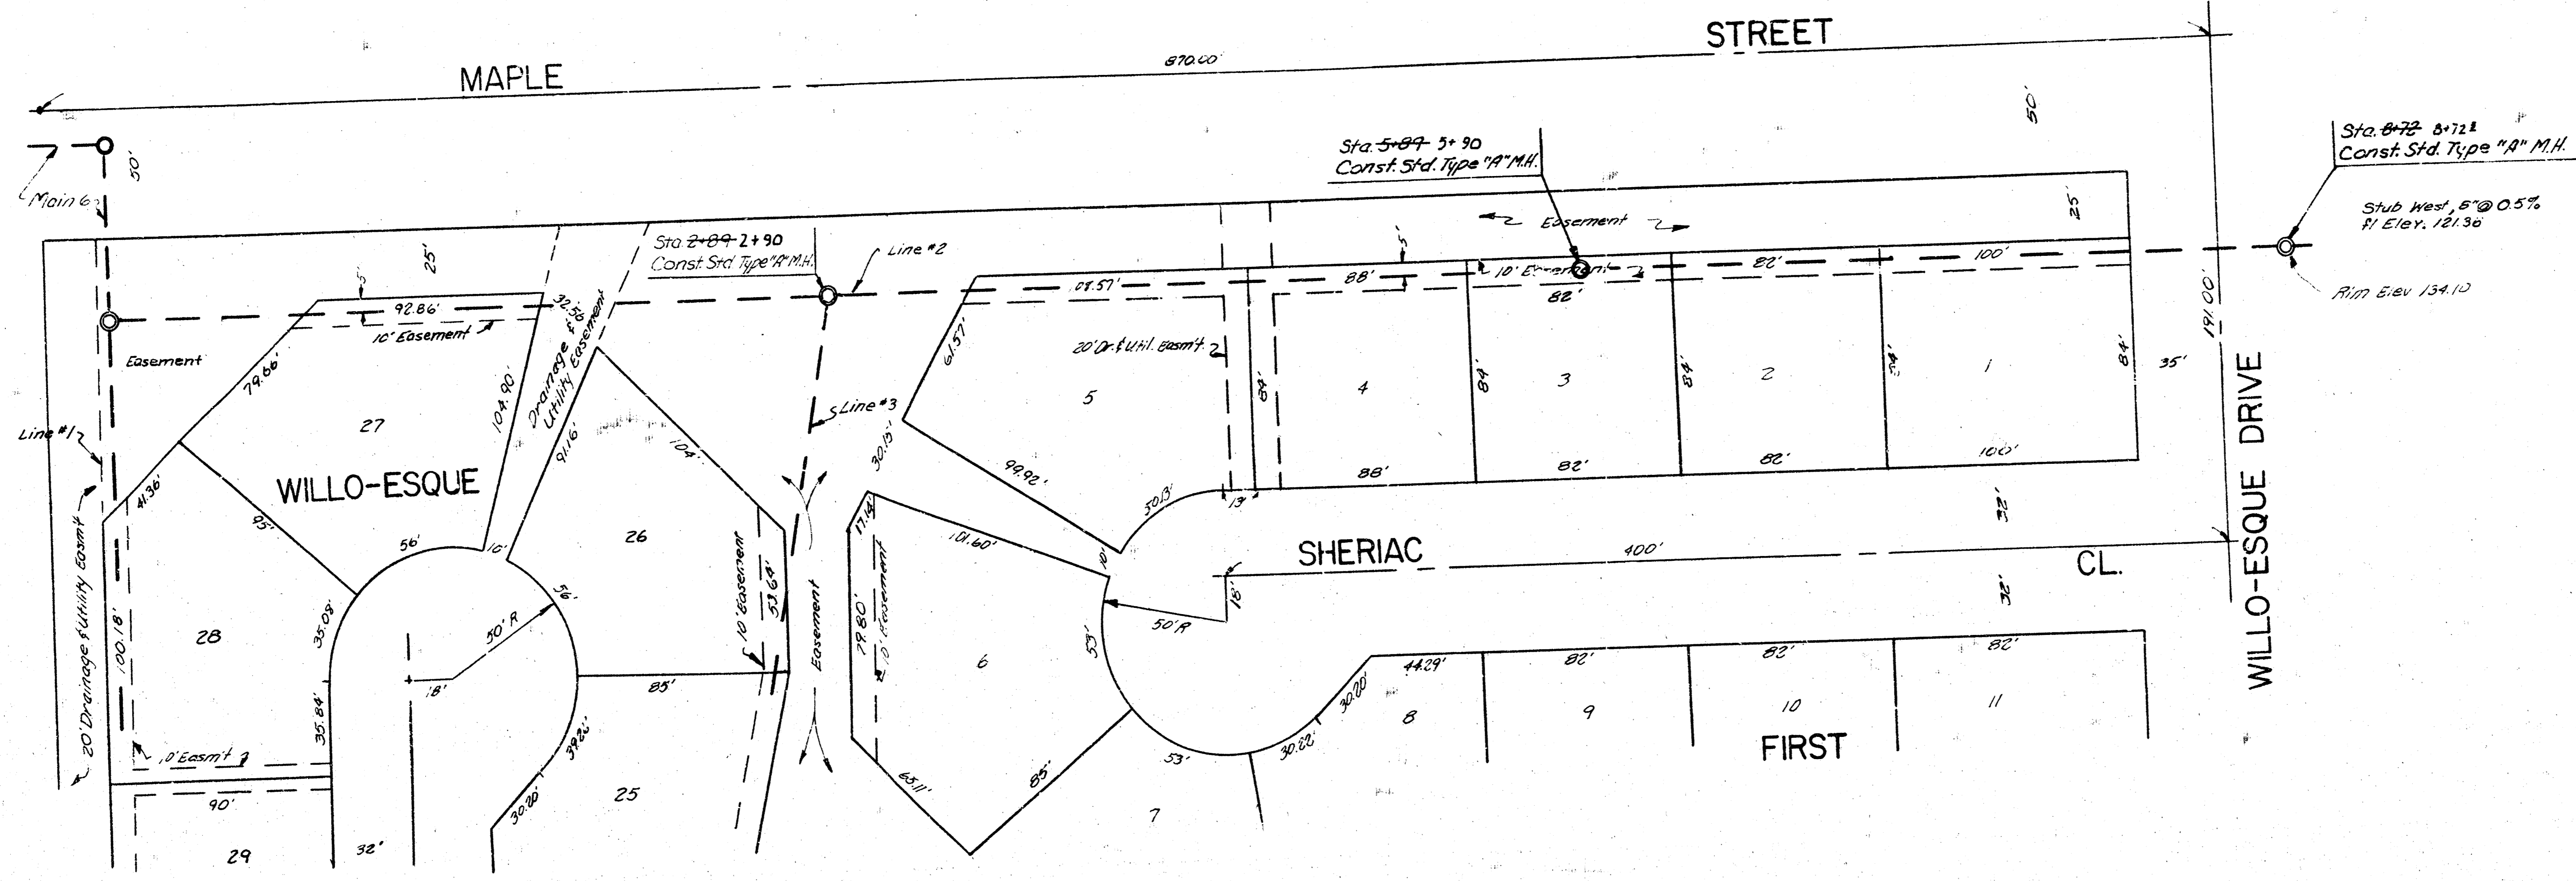



Plan Scale 1" = 40'
 Profile Scale Hor 1" = 40'
 Ver. 1" = 5'

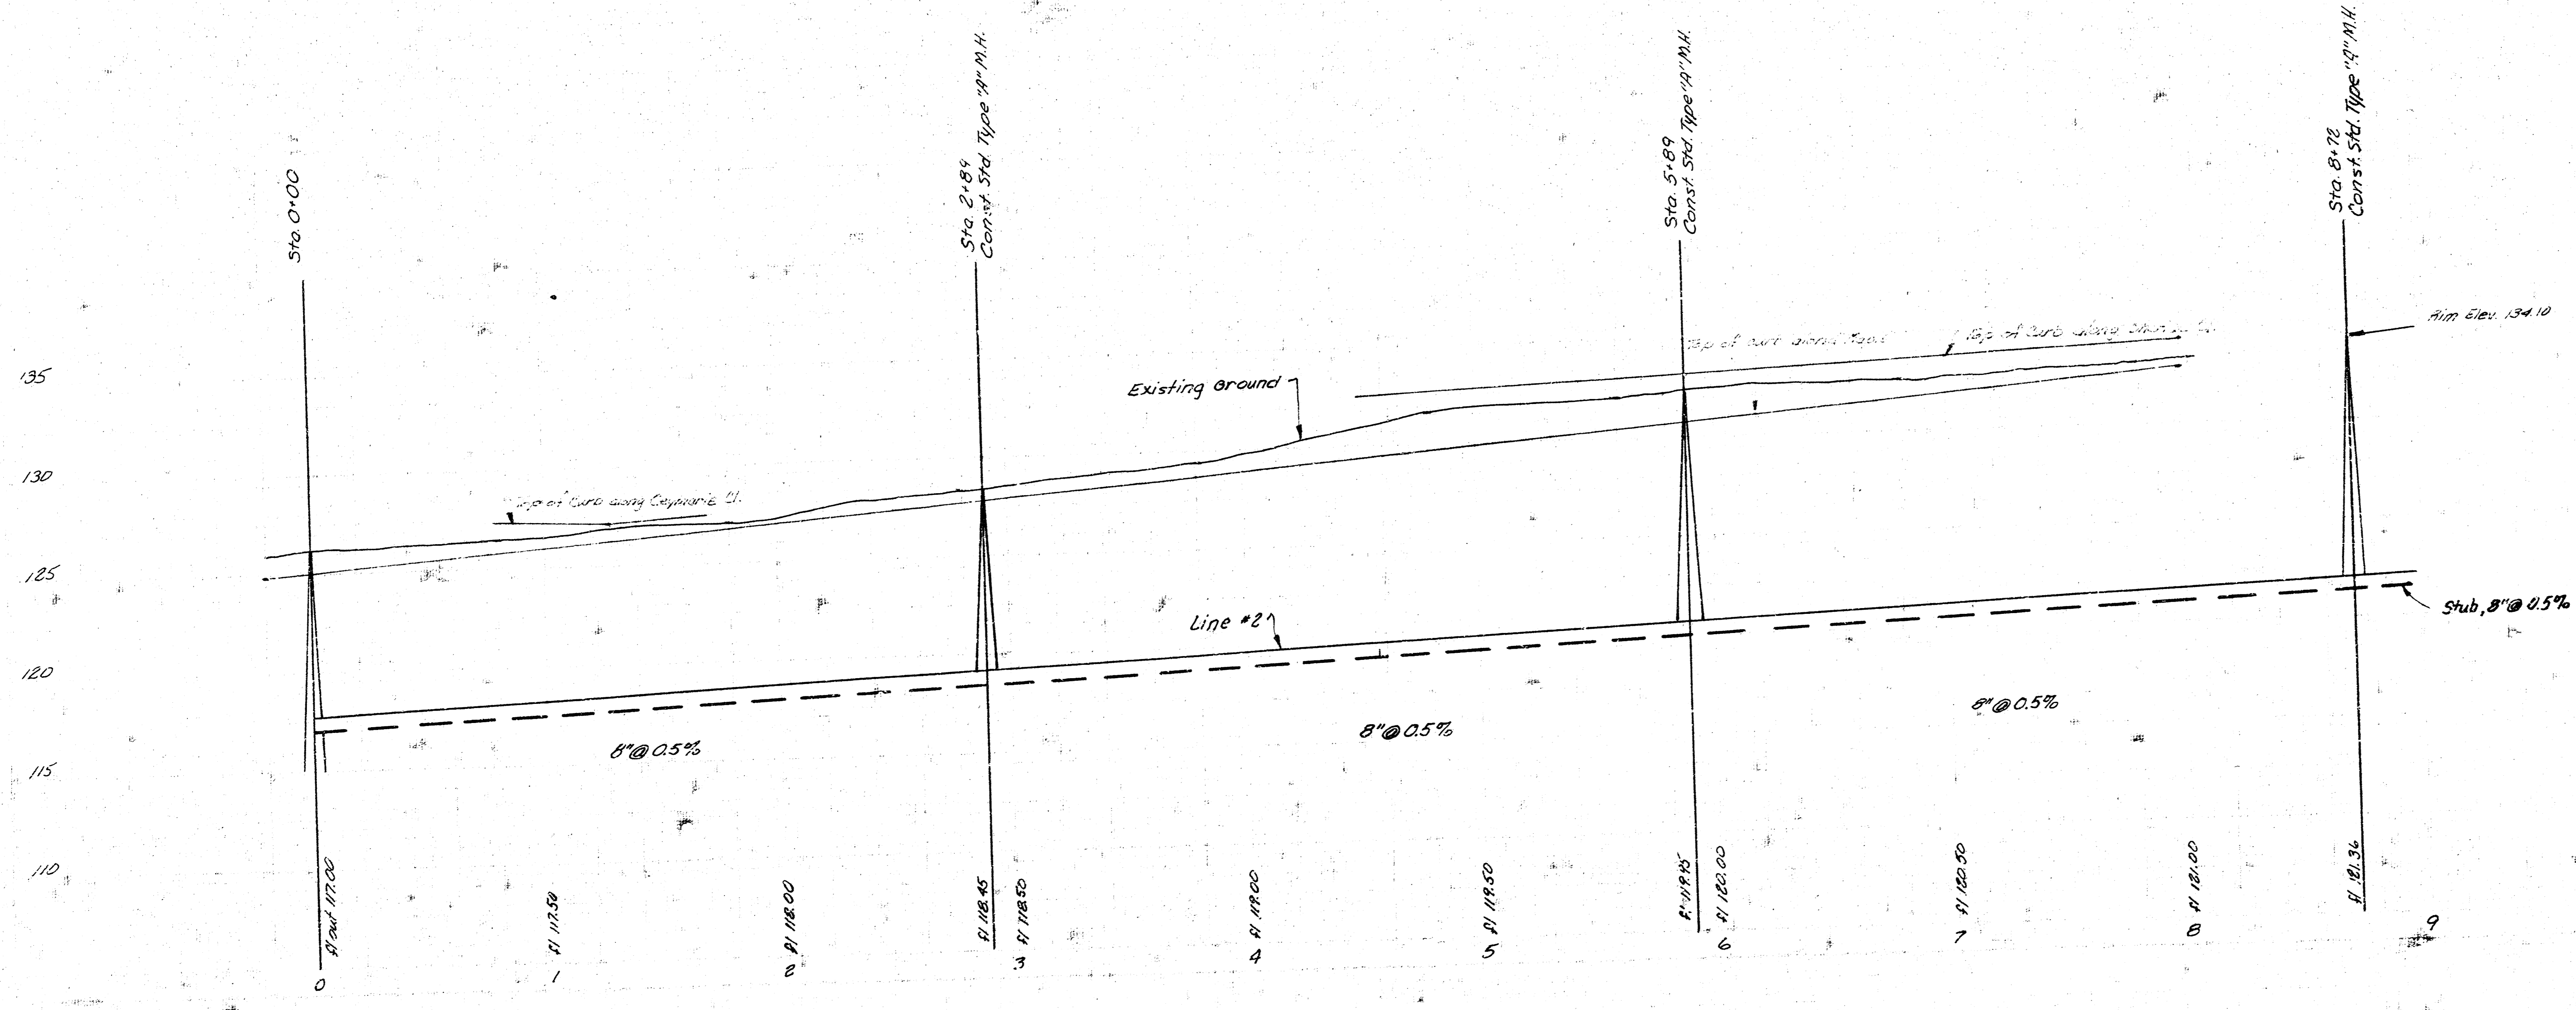


LAT. 49 S.W. INTERCEPTOR
 PROJ. NO. DKL 57205
 SHEET 3 of 6 LINE NO. 2

FILMED FROM THE BEST


B.M. 125.81 R.R. spike N. side power pole S side Maple, 10.0 E. of E.L. Ceymarie

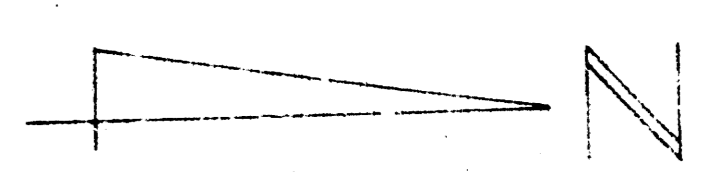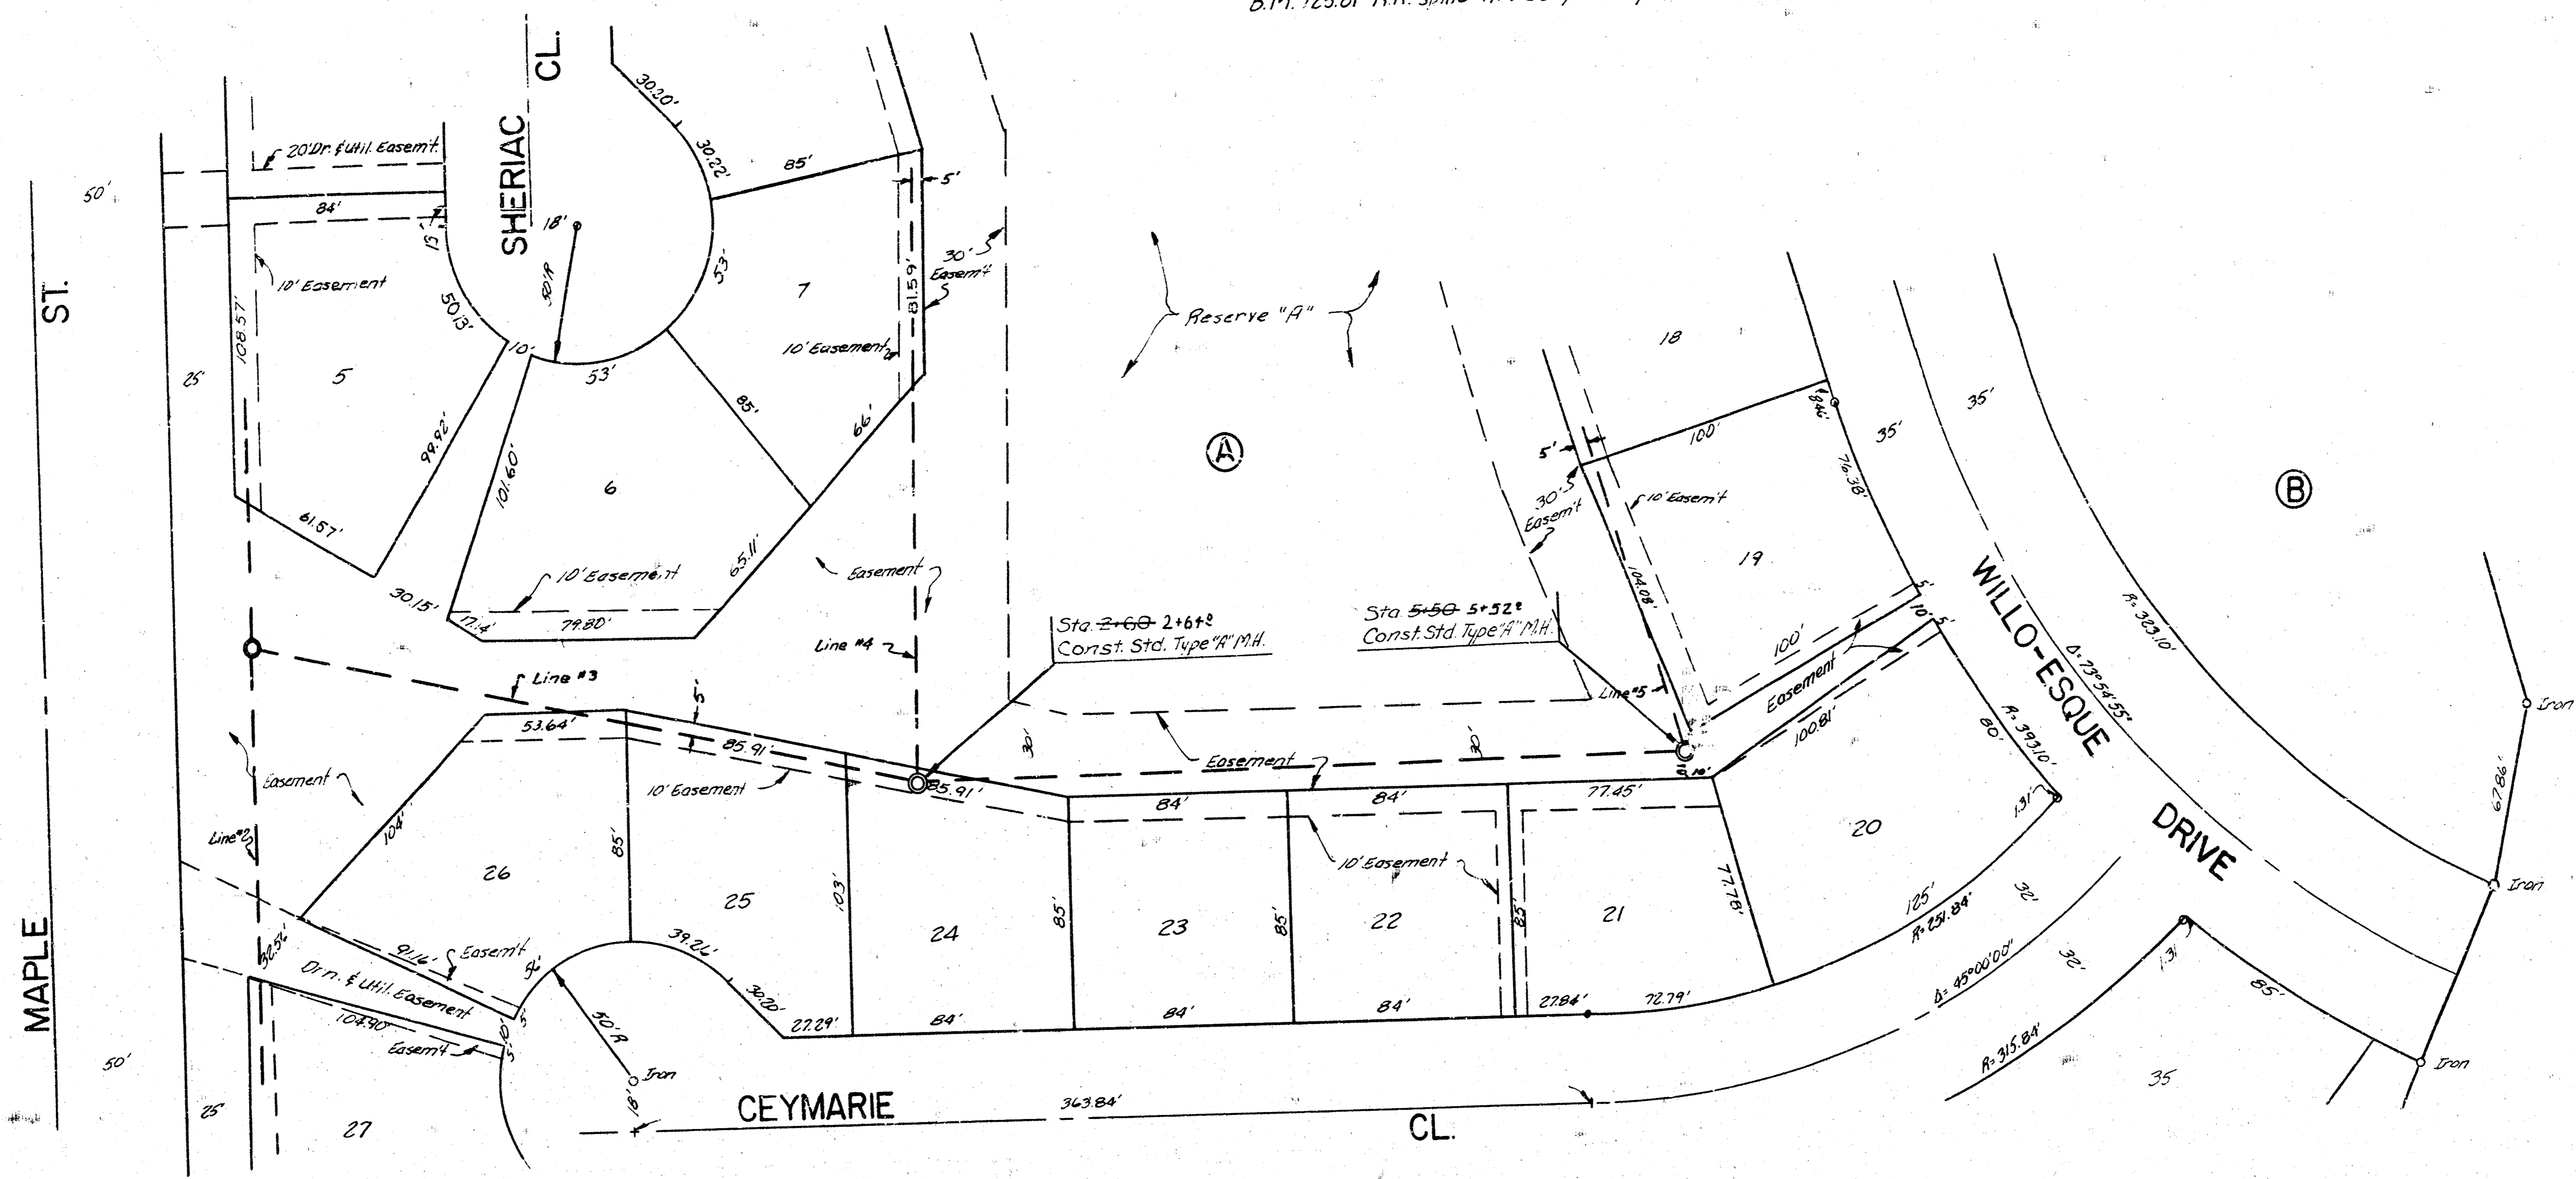

Plan Scale 1"=40'
 Profile Scale Hor 1"=40'
 Ver. 1"=5'

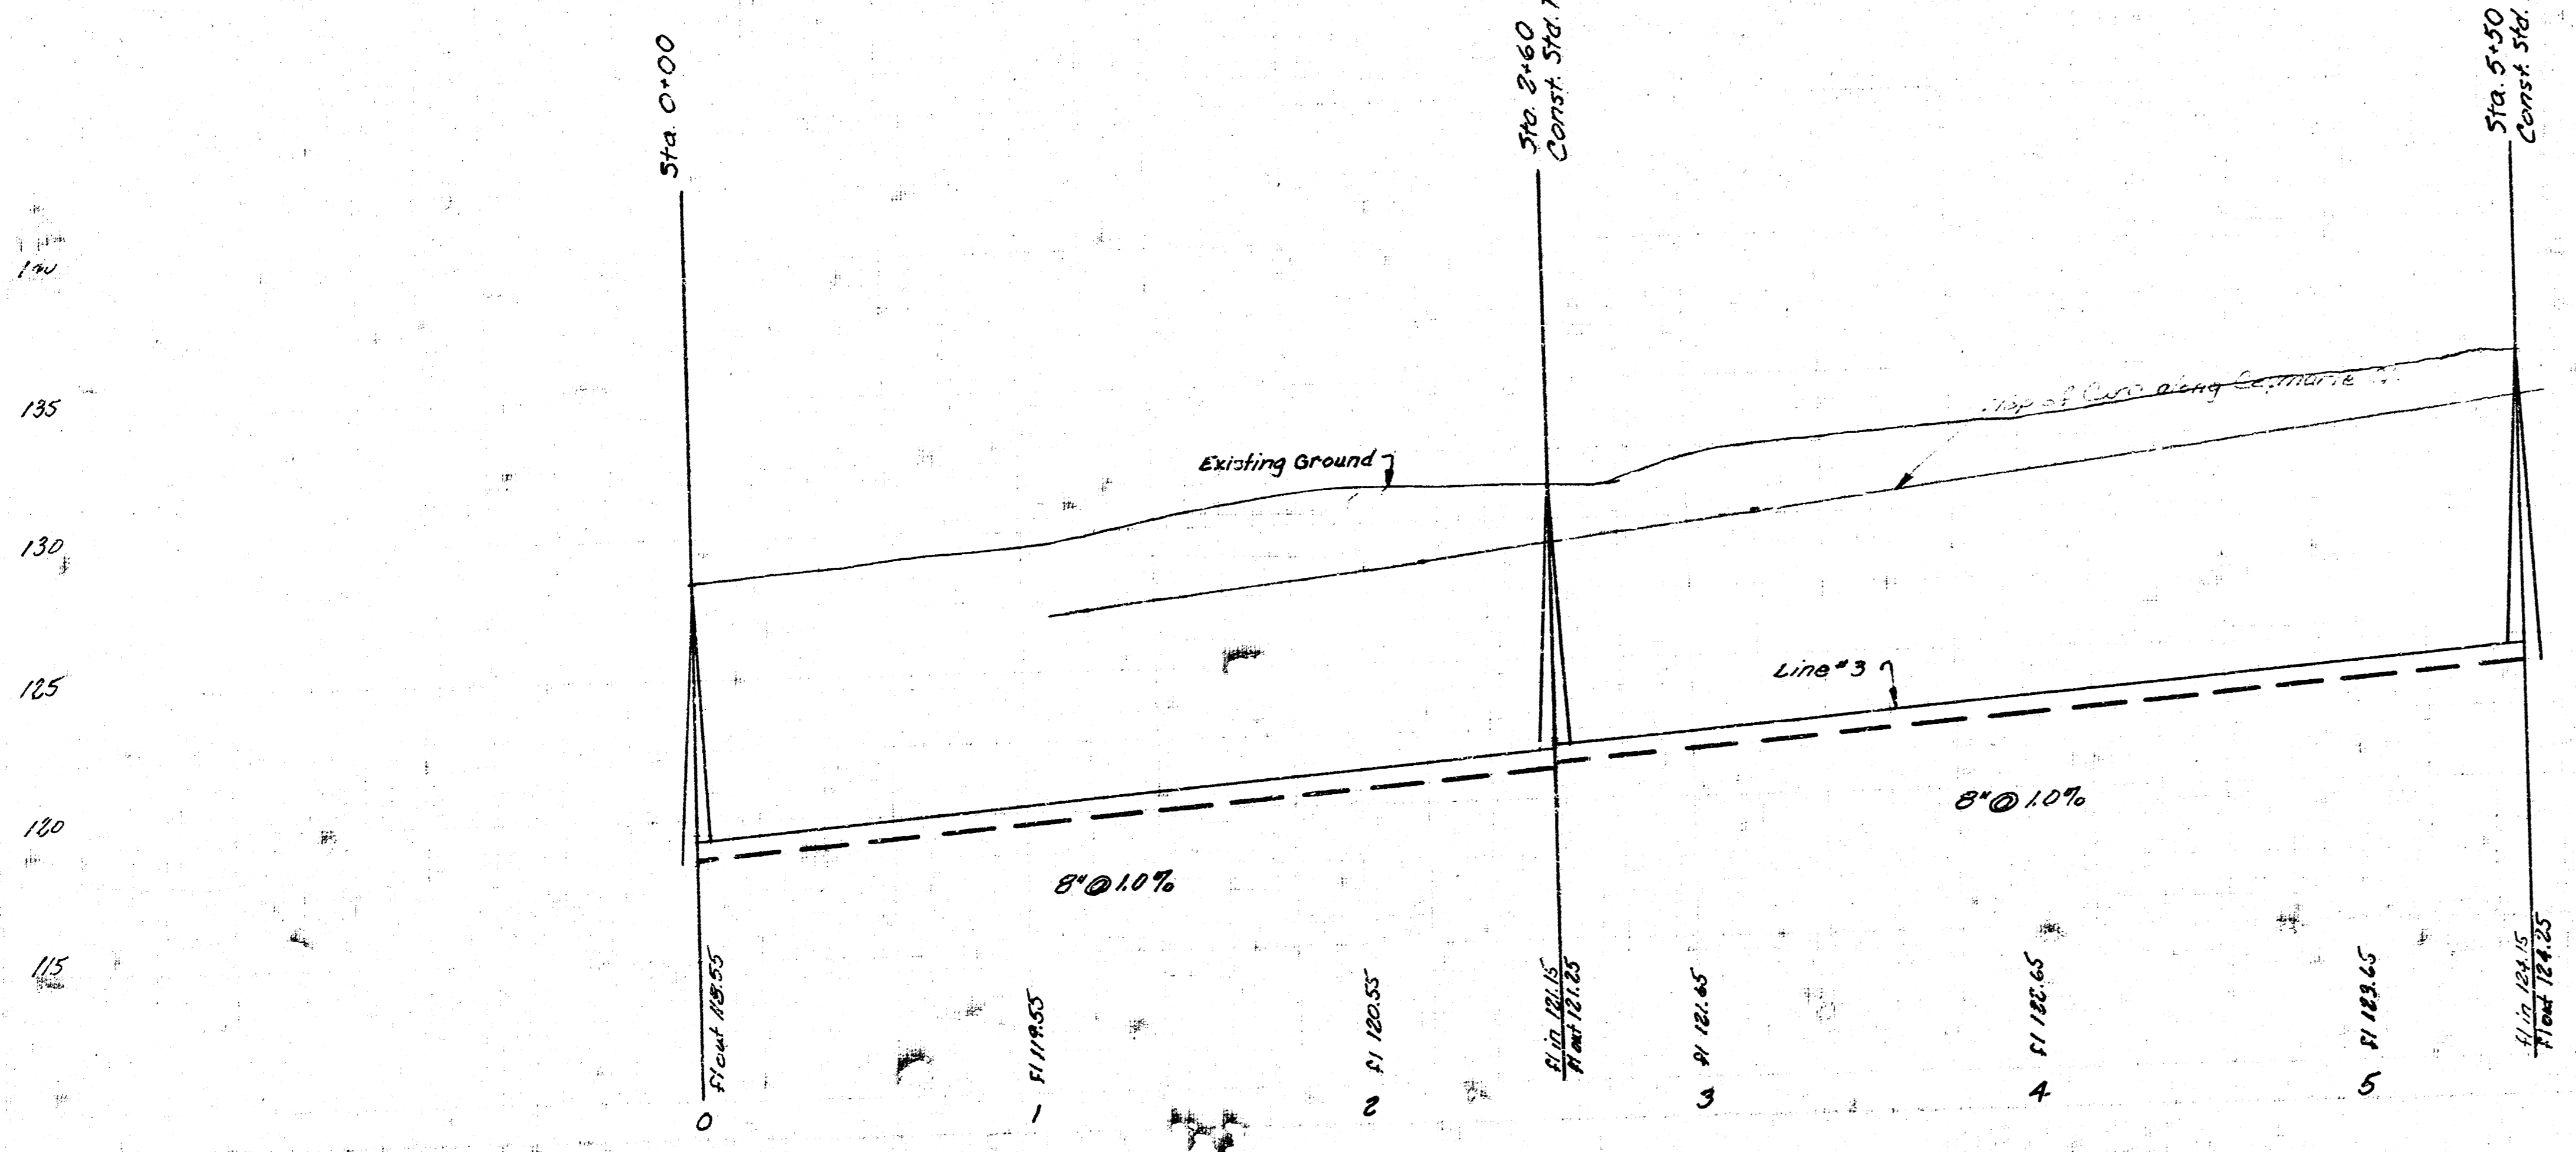

LAT 49 S.W. INTERCEPTOR
 PROJ. NO. ~~00K1572015~~
 SHEET 4 of 6 LINE NO.3

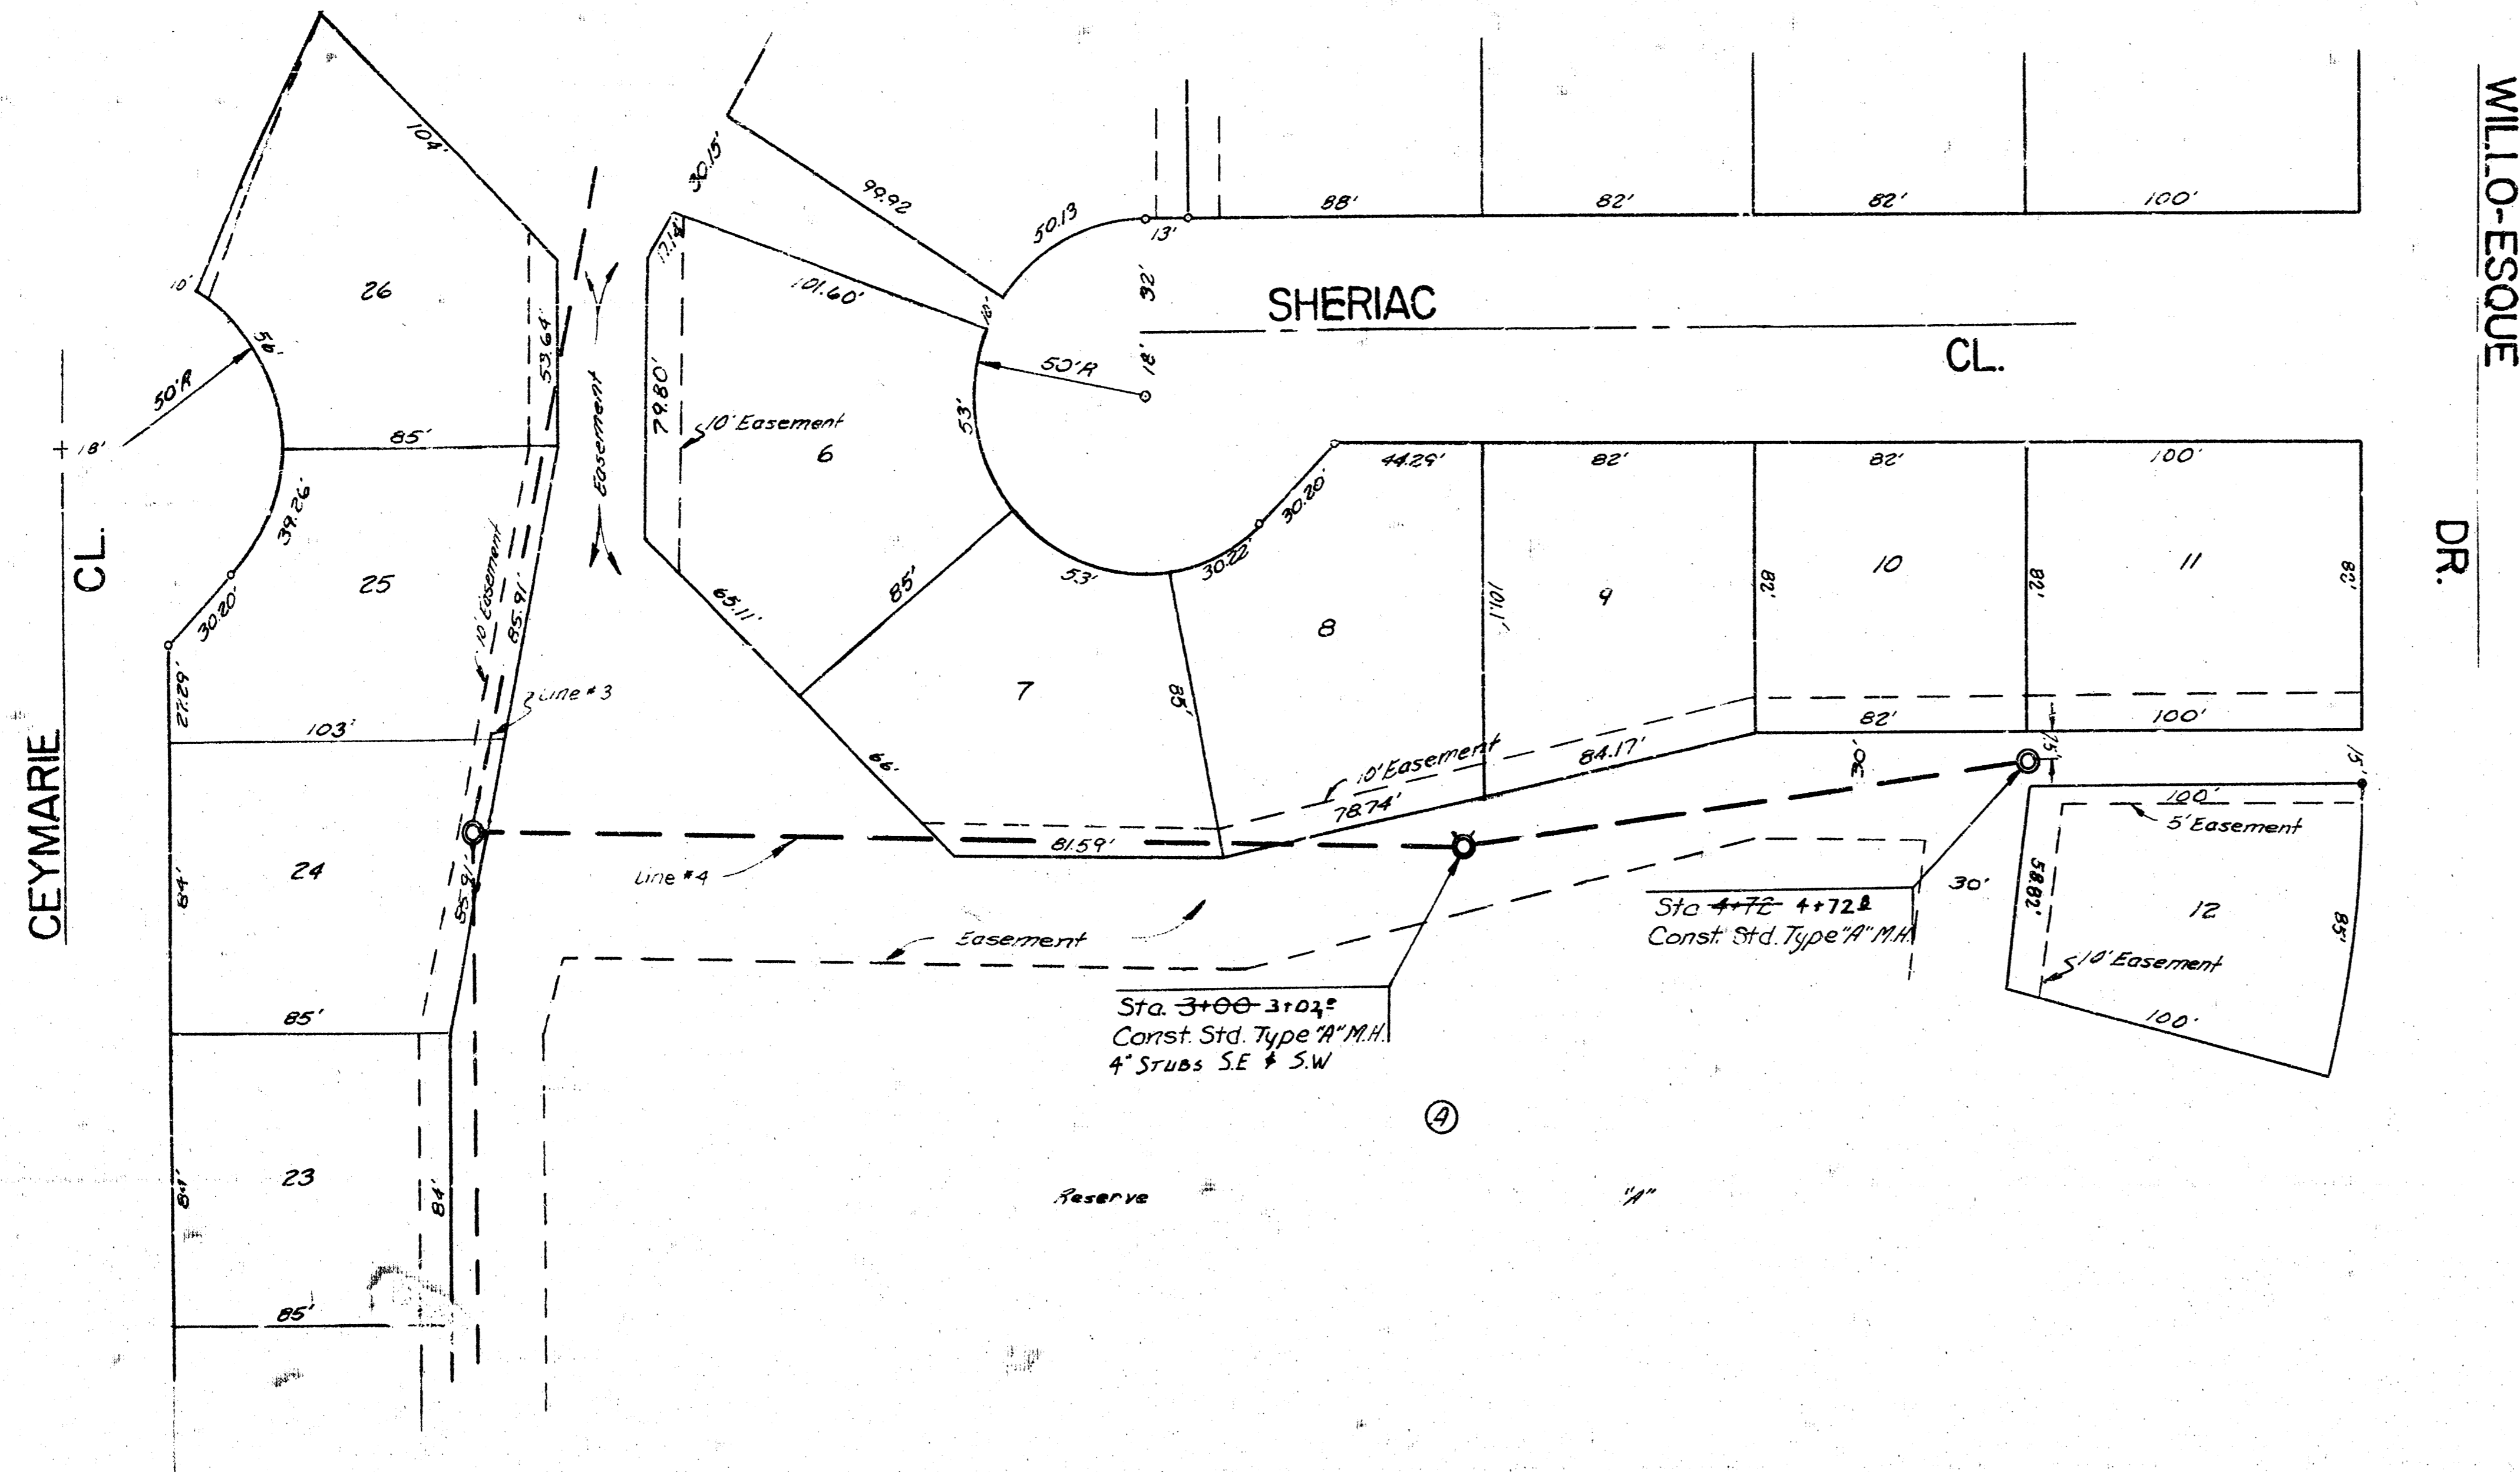

WILLO-ESQUE DR.



Plan Scale 1" = 40'
 Profile Scale Hor. 1" = 40'
 Profile Scale Ver. 1" = 5'

