


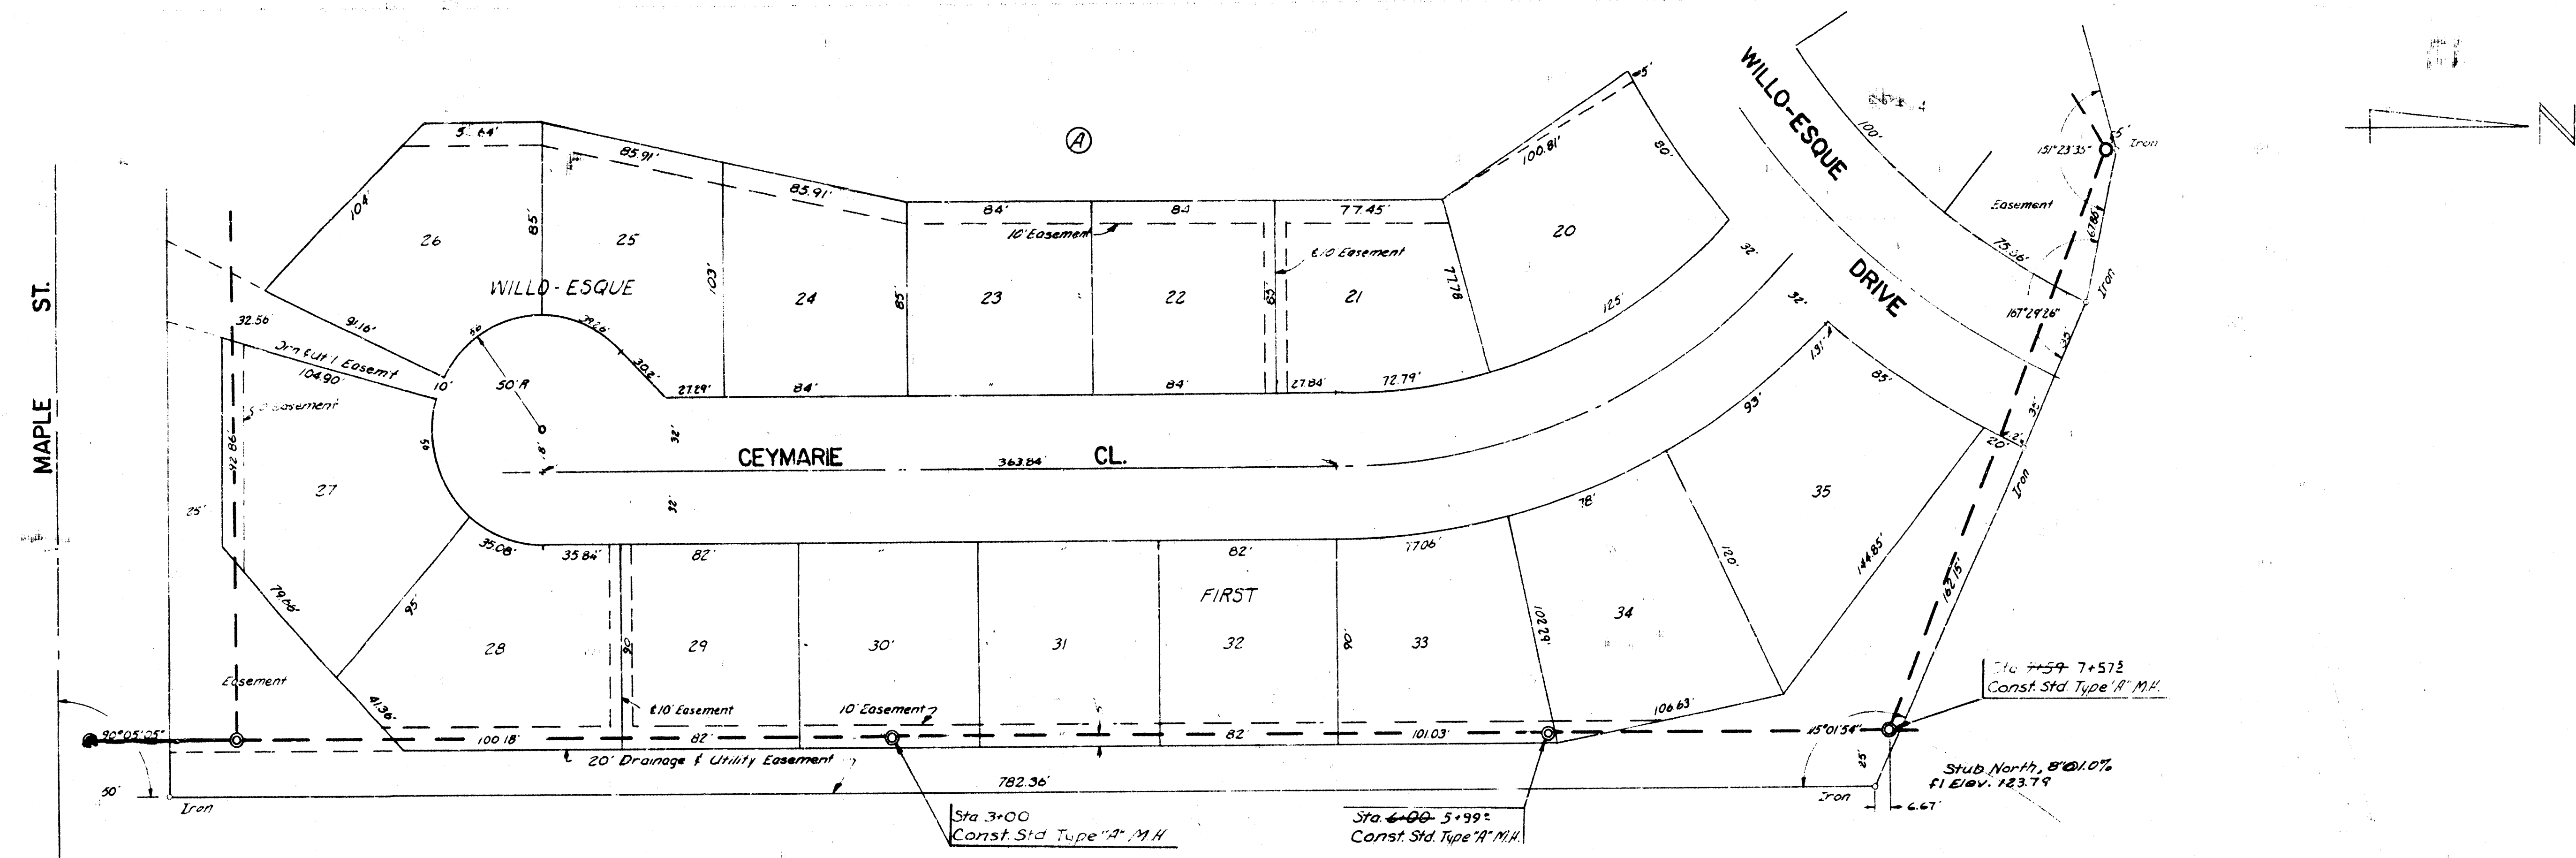


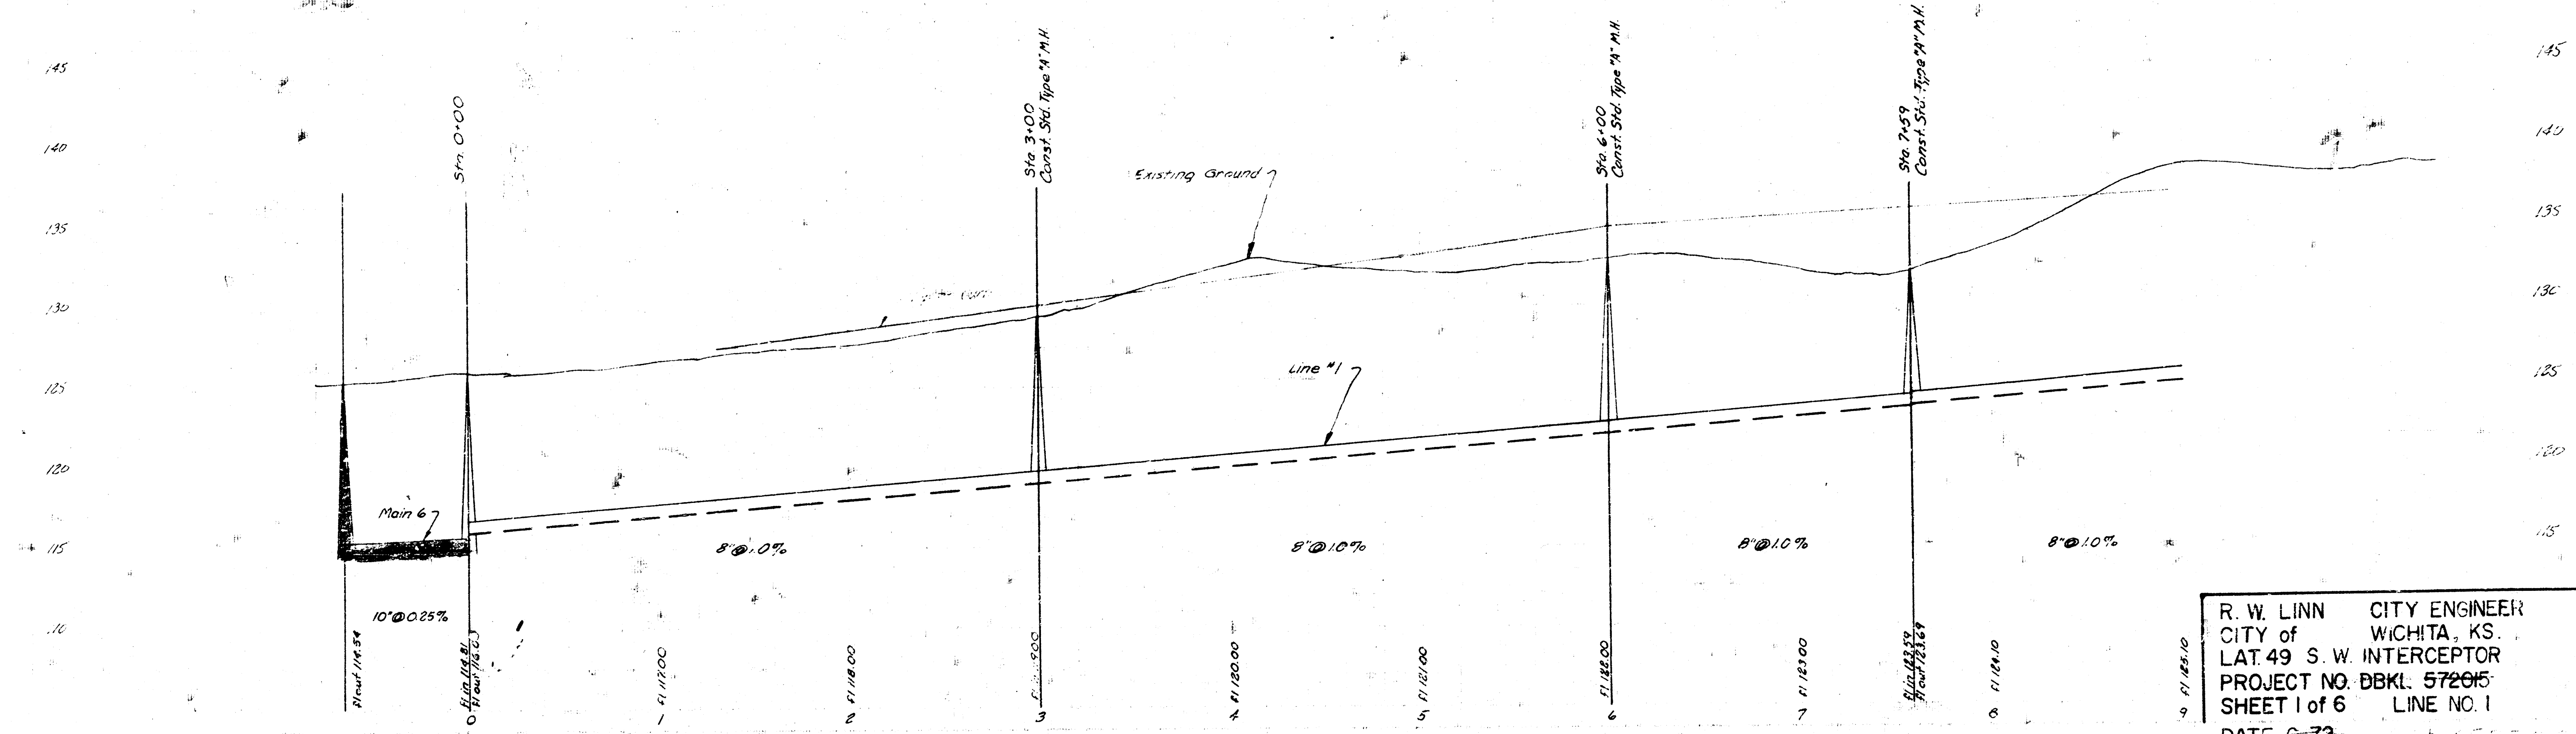


Plan Scale: 1"=40'
Profile Scale: 1"=10'

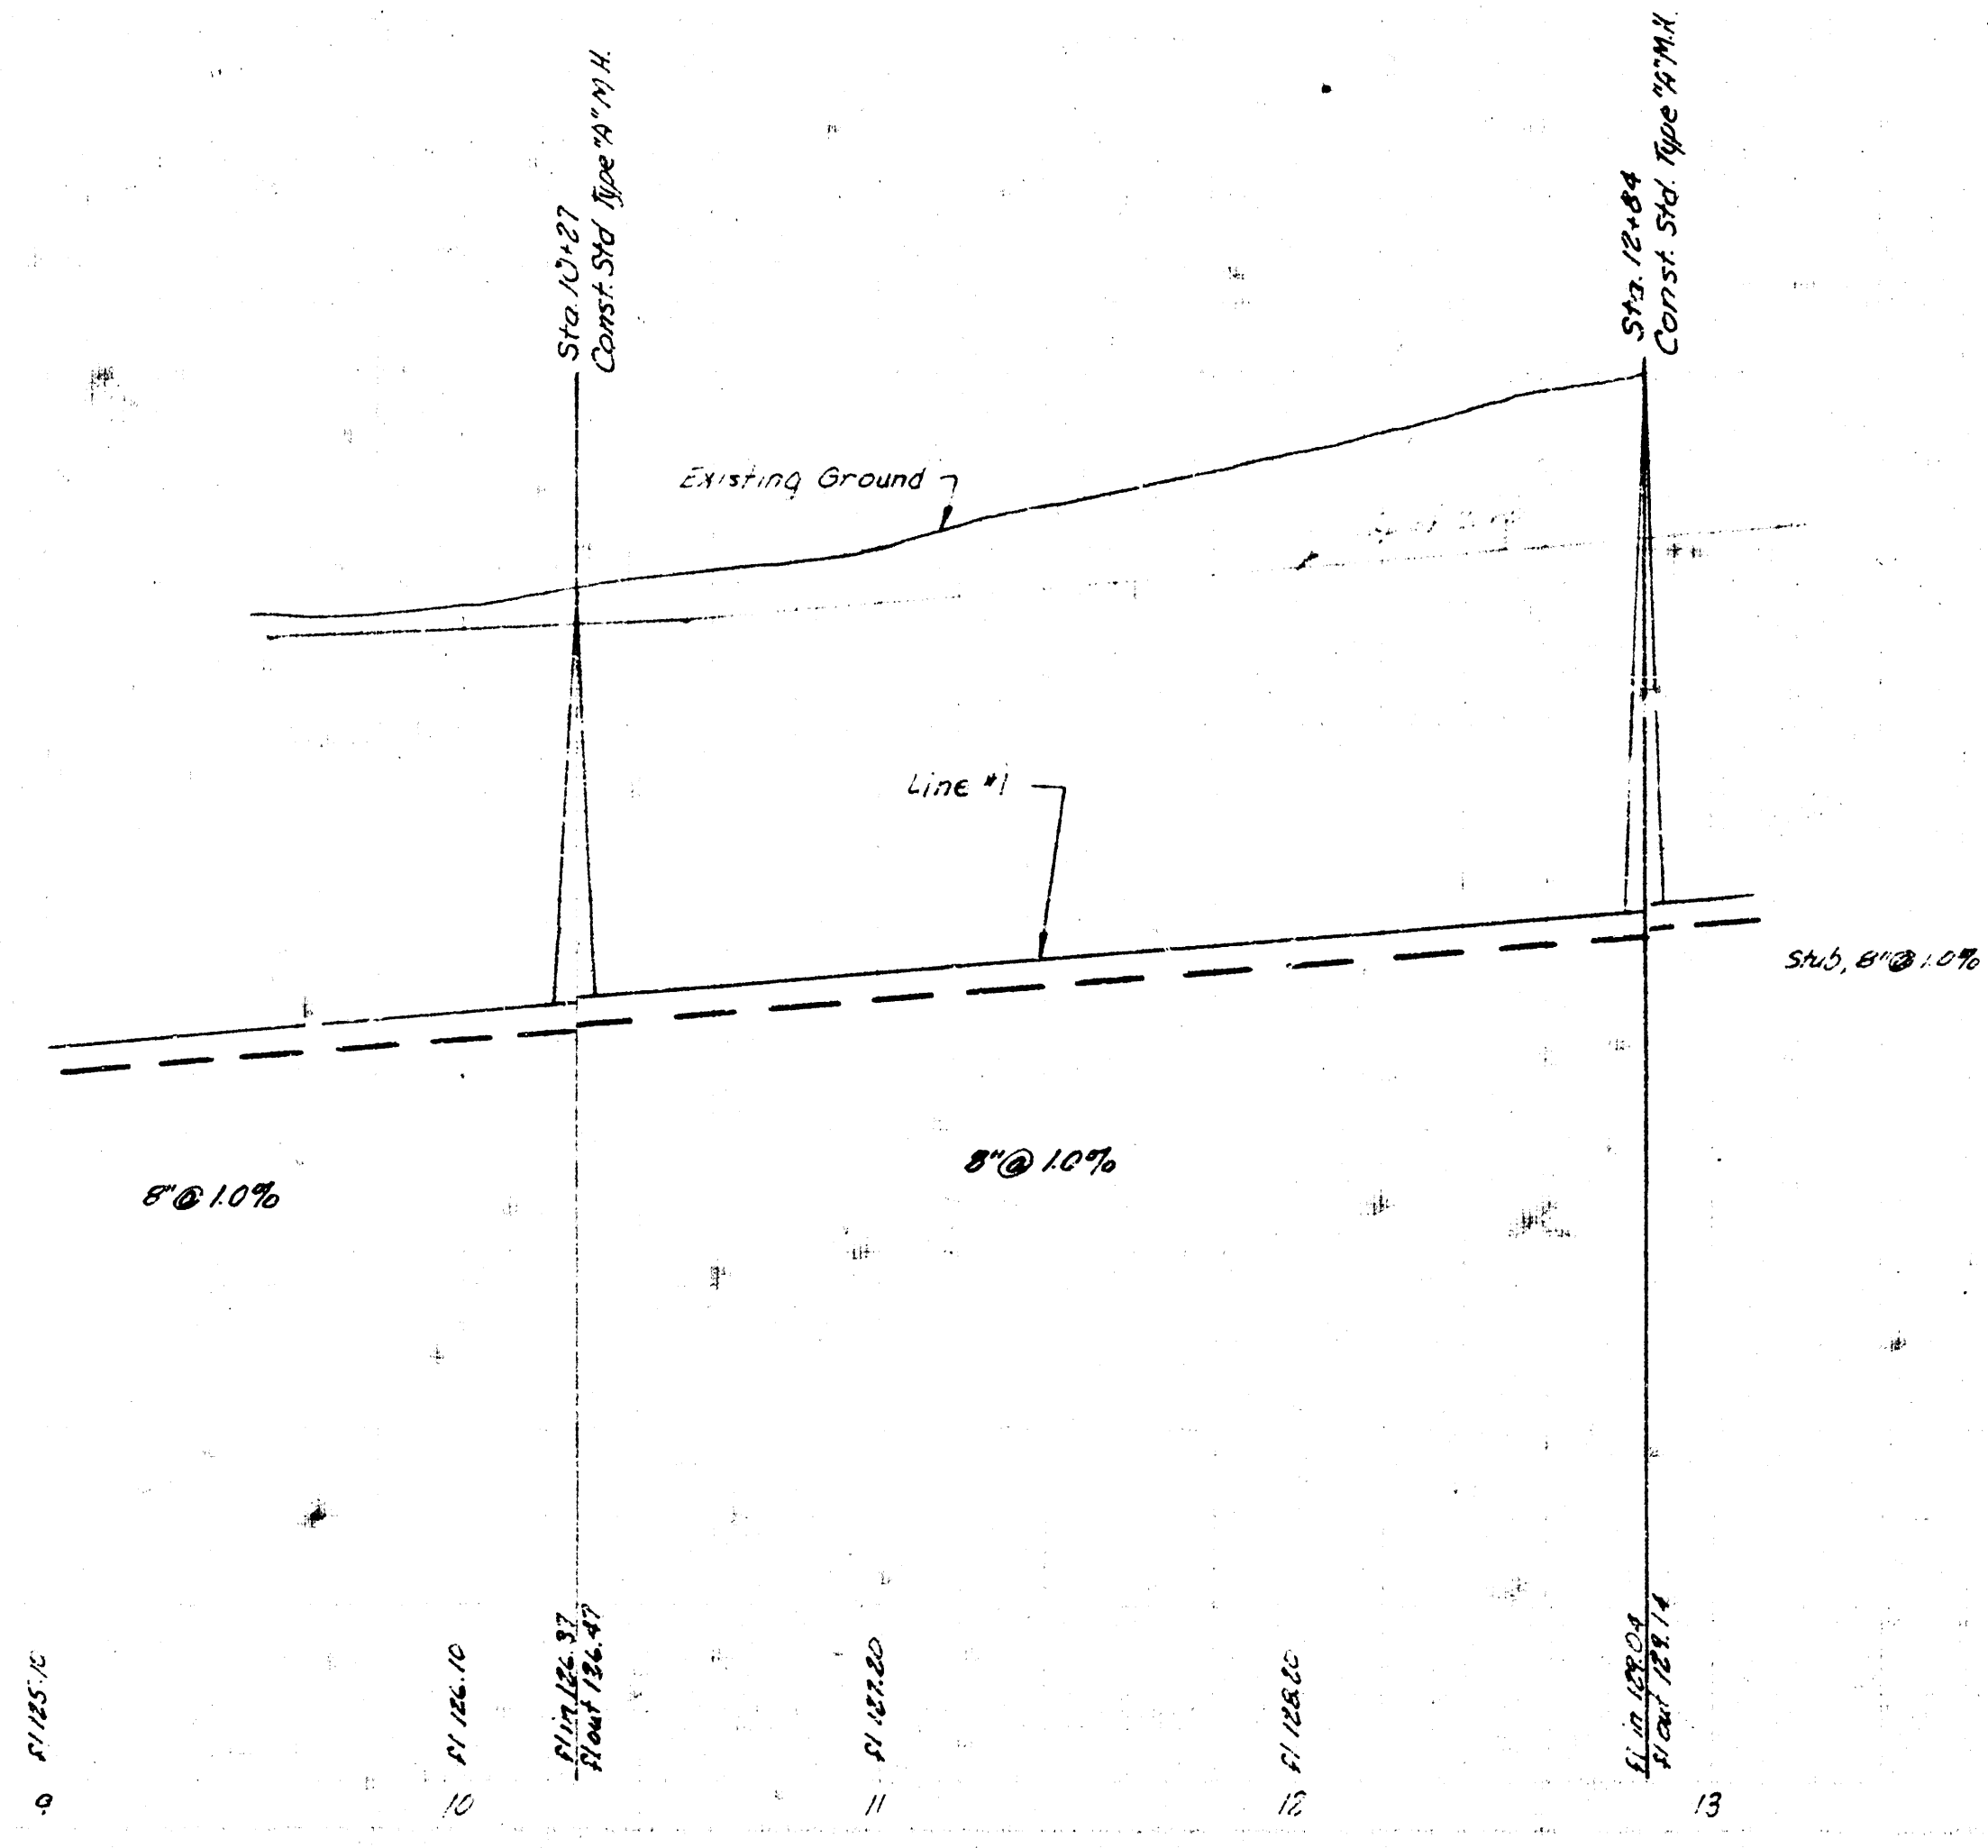

R. W. LINN CITY ENGINEER
CITY of WICHITA, KS
LAT. 49 S. W. INTERCEPTOR
PROJECT NO. DBKL 572015
SHEET 1 of 6 LINE NO. 1
DATE 6-72

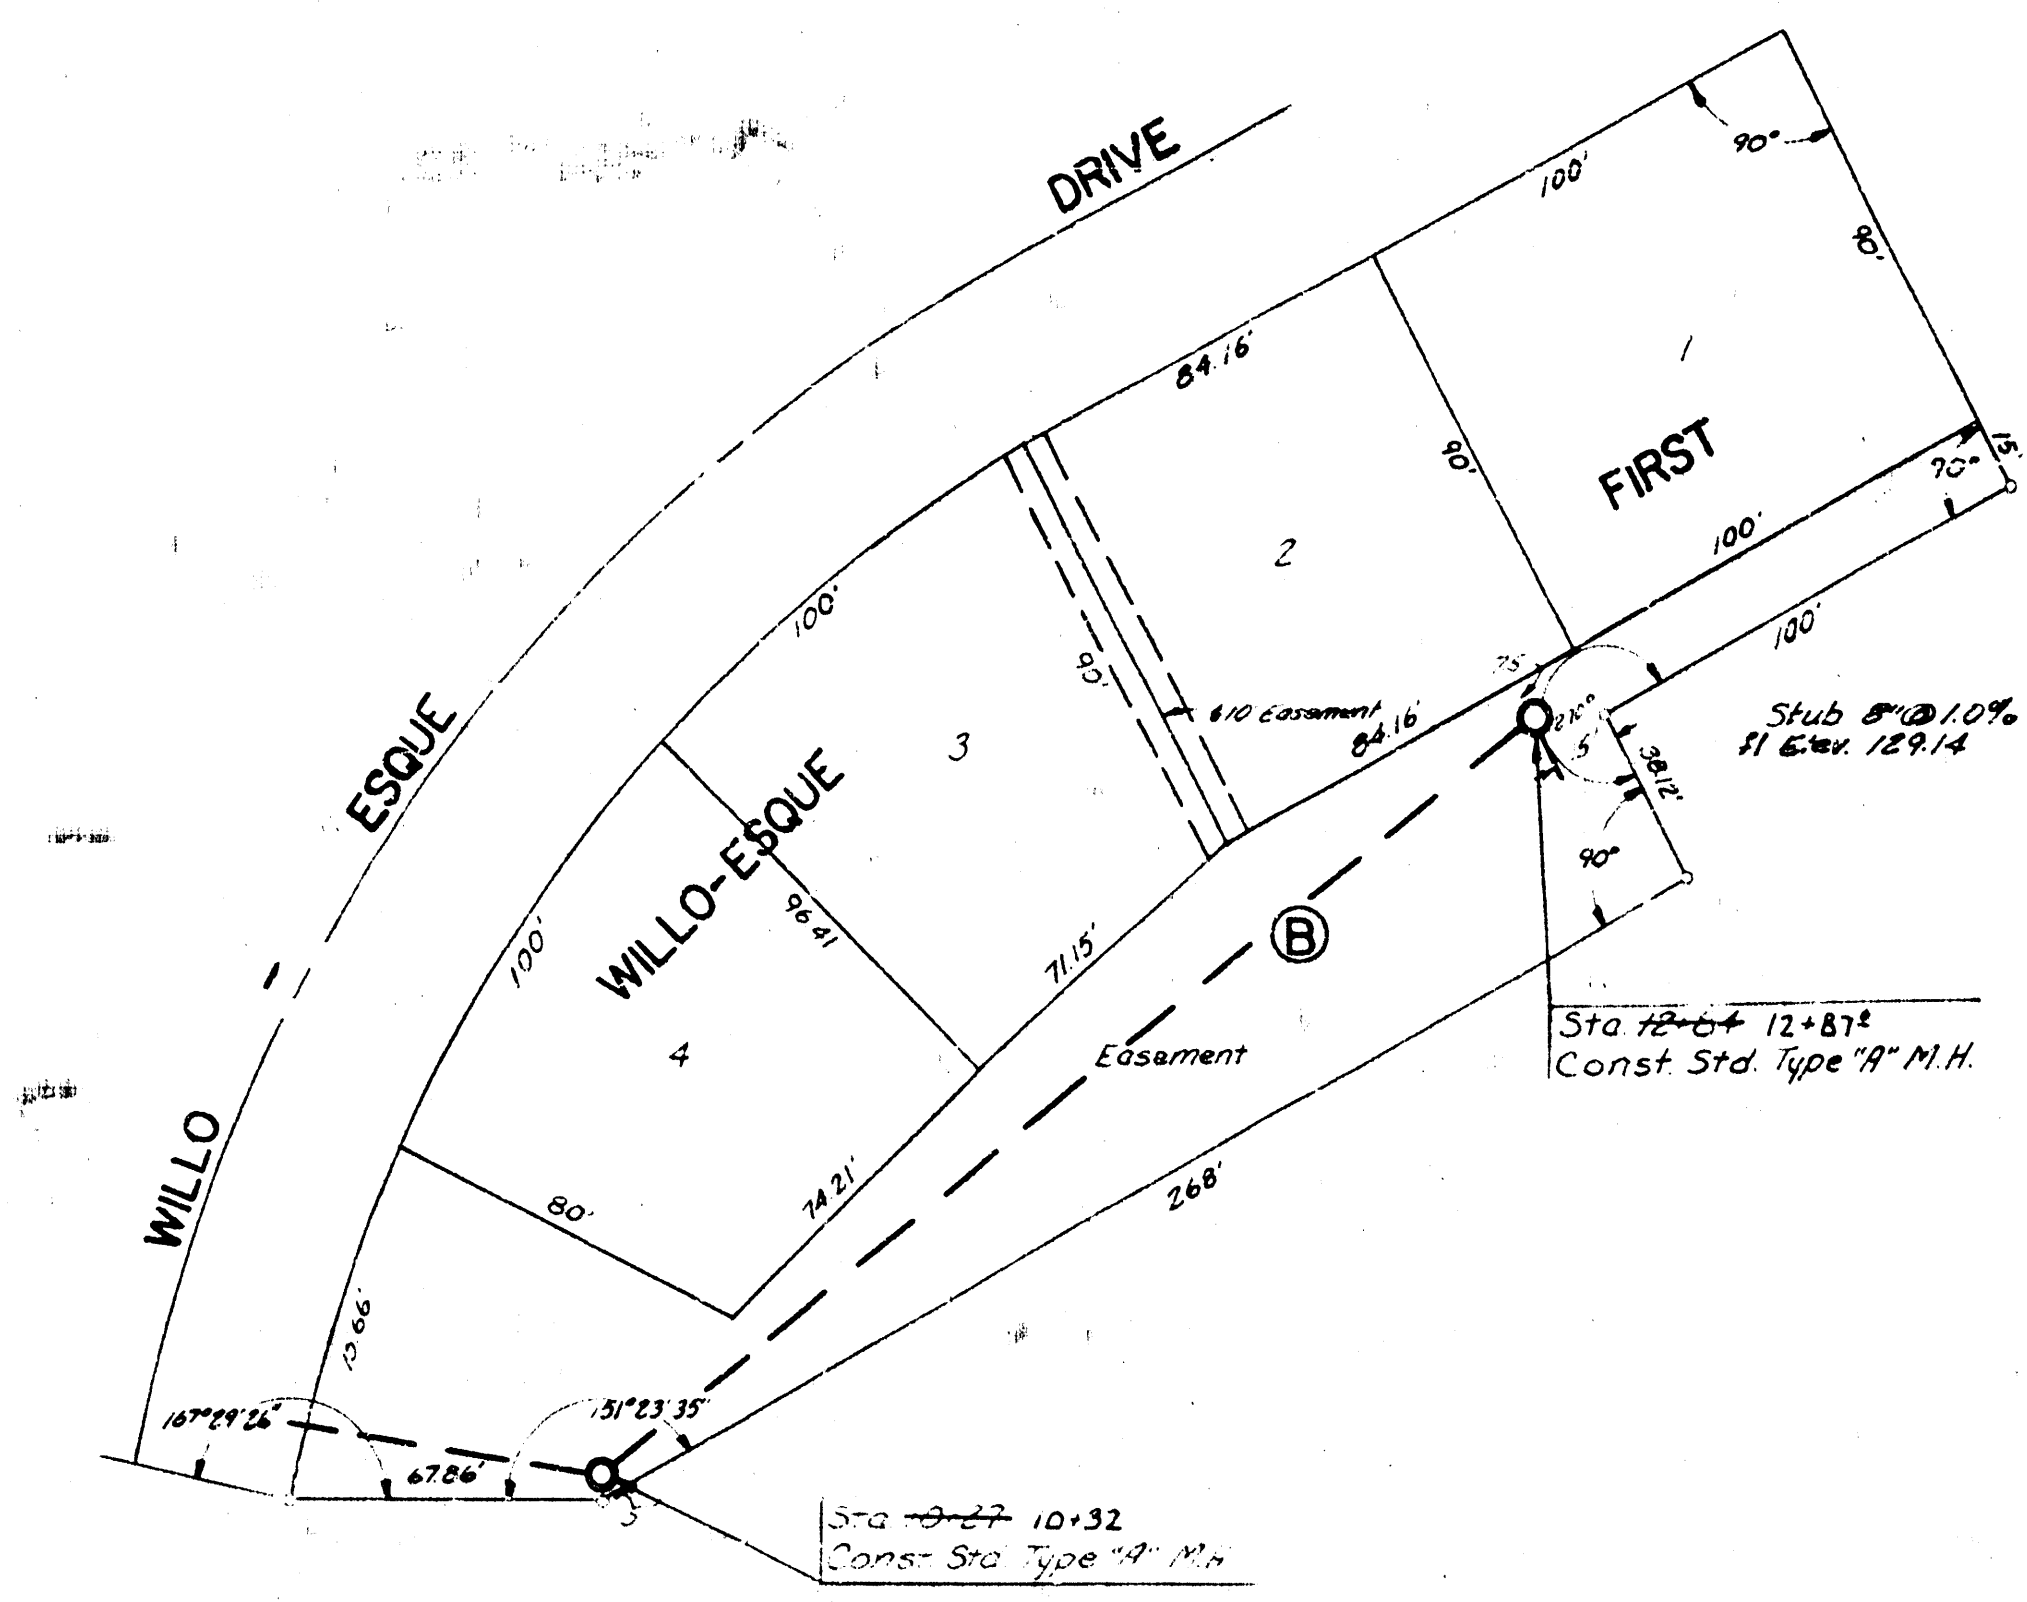

Plan Scale 1"=40'
Profile Scale 1"=4'

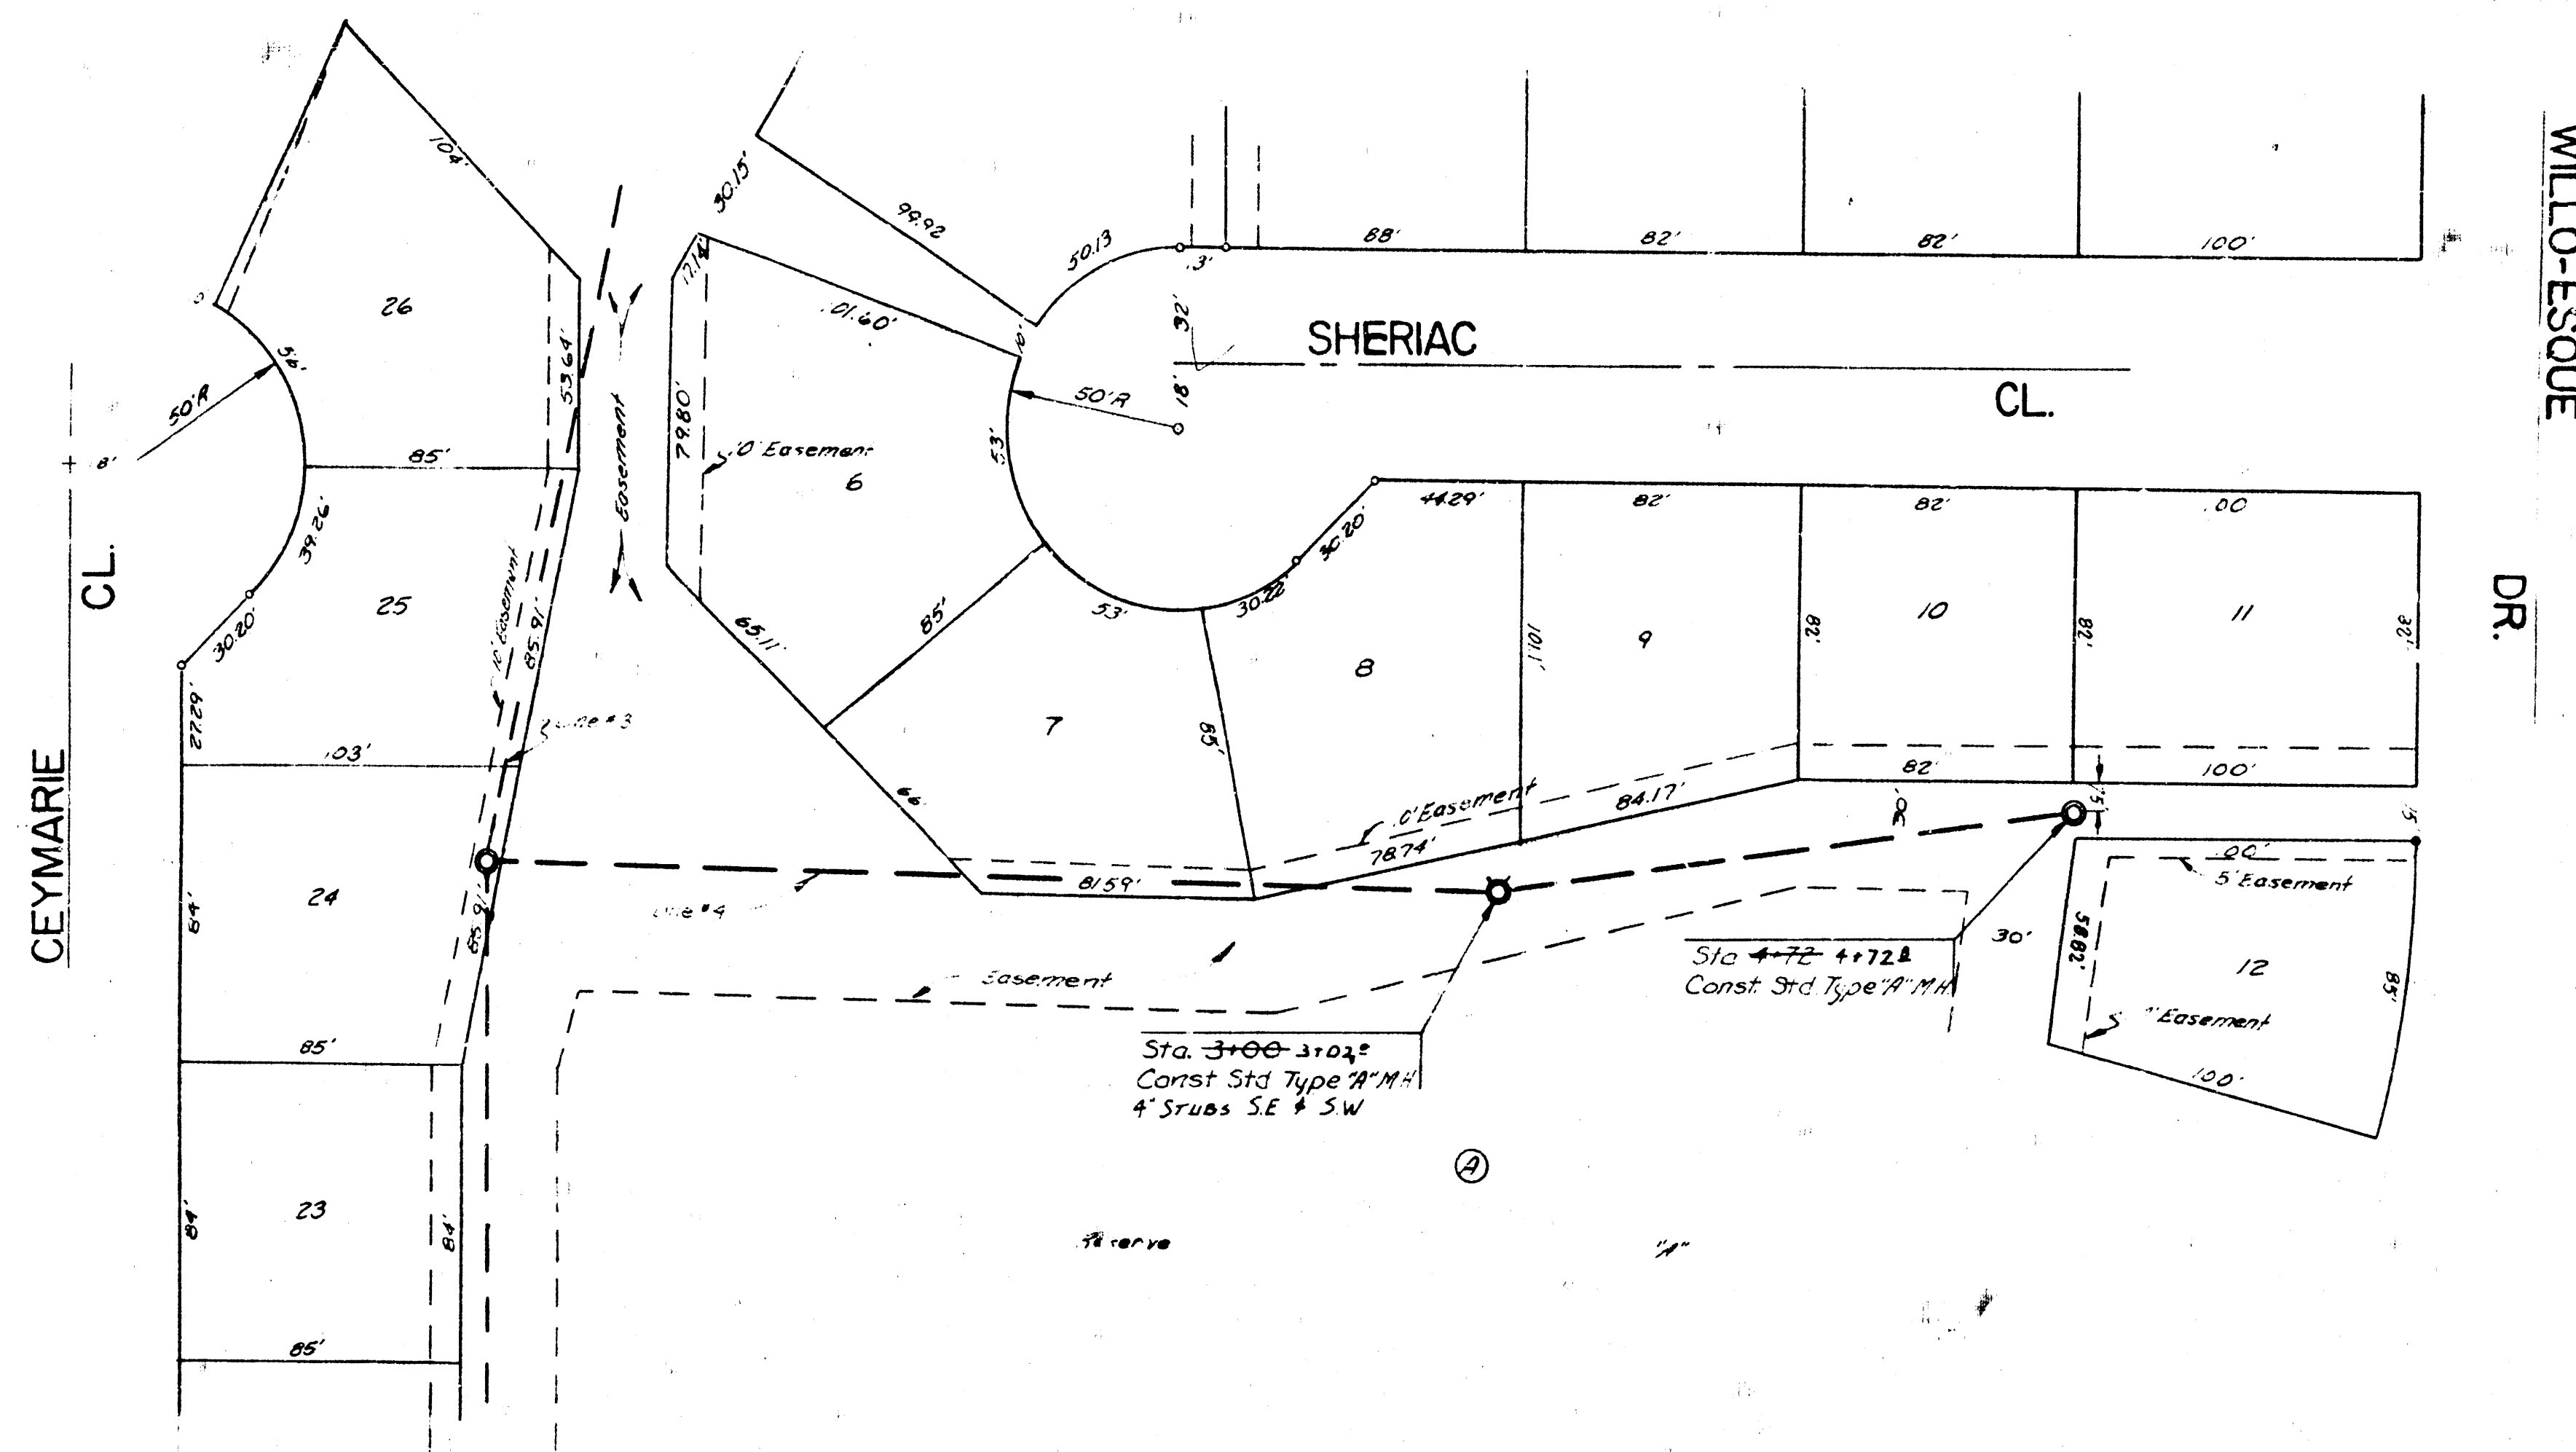


WILLO-ESQUE DR.

DR.





Plan Scale 1" = 40'
 Profile Scale Hor. 1" = 40'
 Profile Scale Ver. 1" = 5'

45
 40
 35
 30
 25
 20

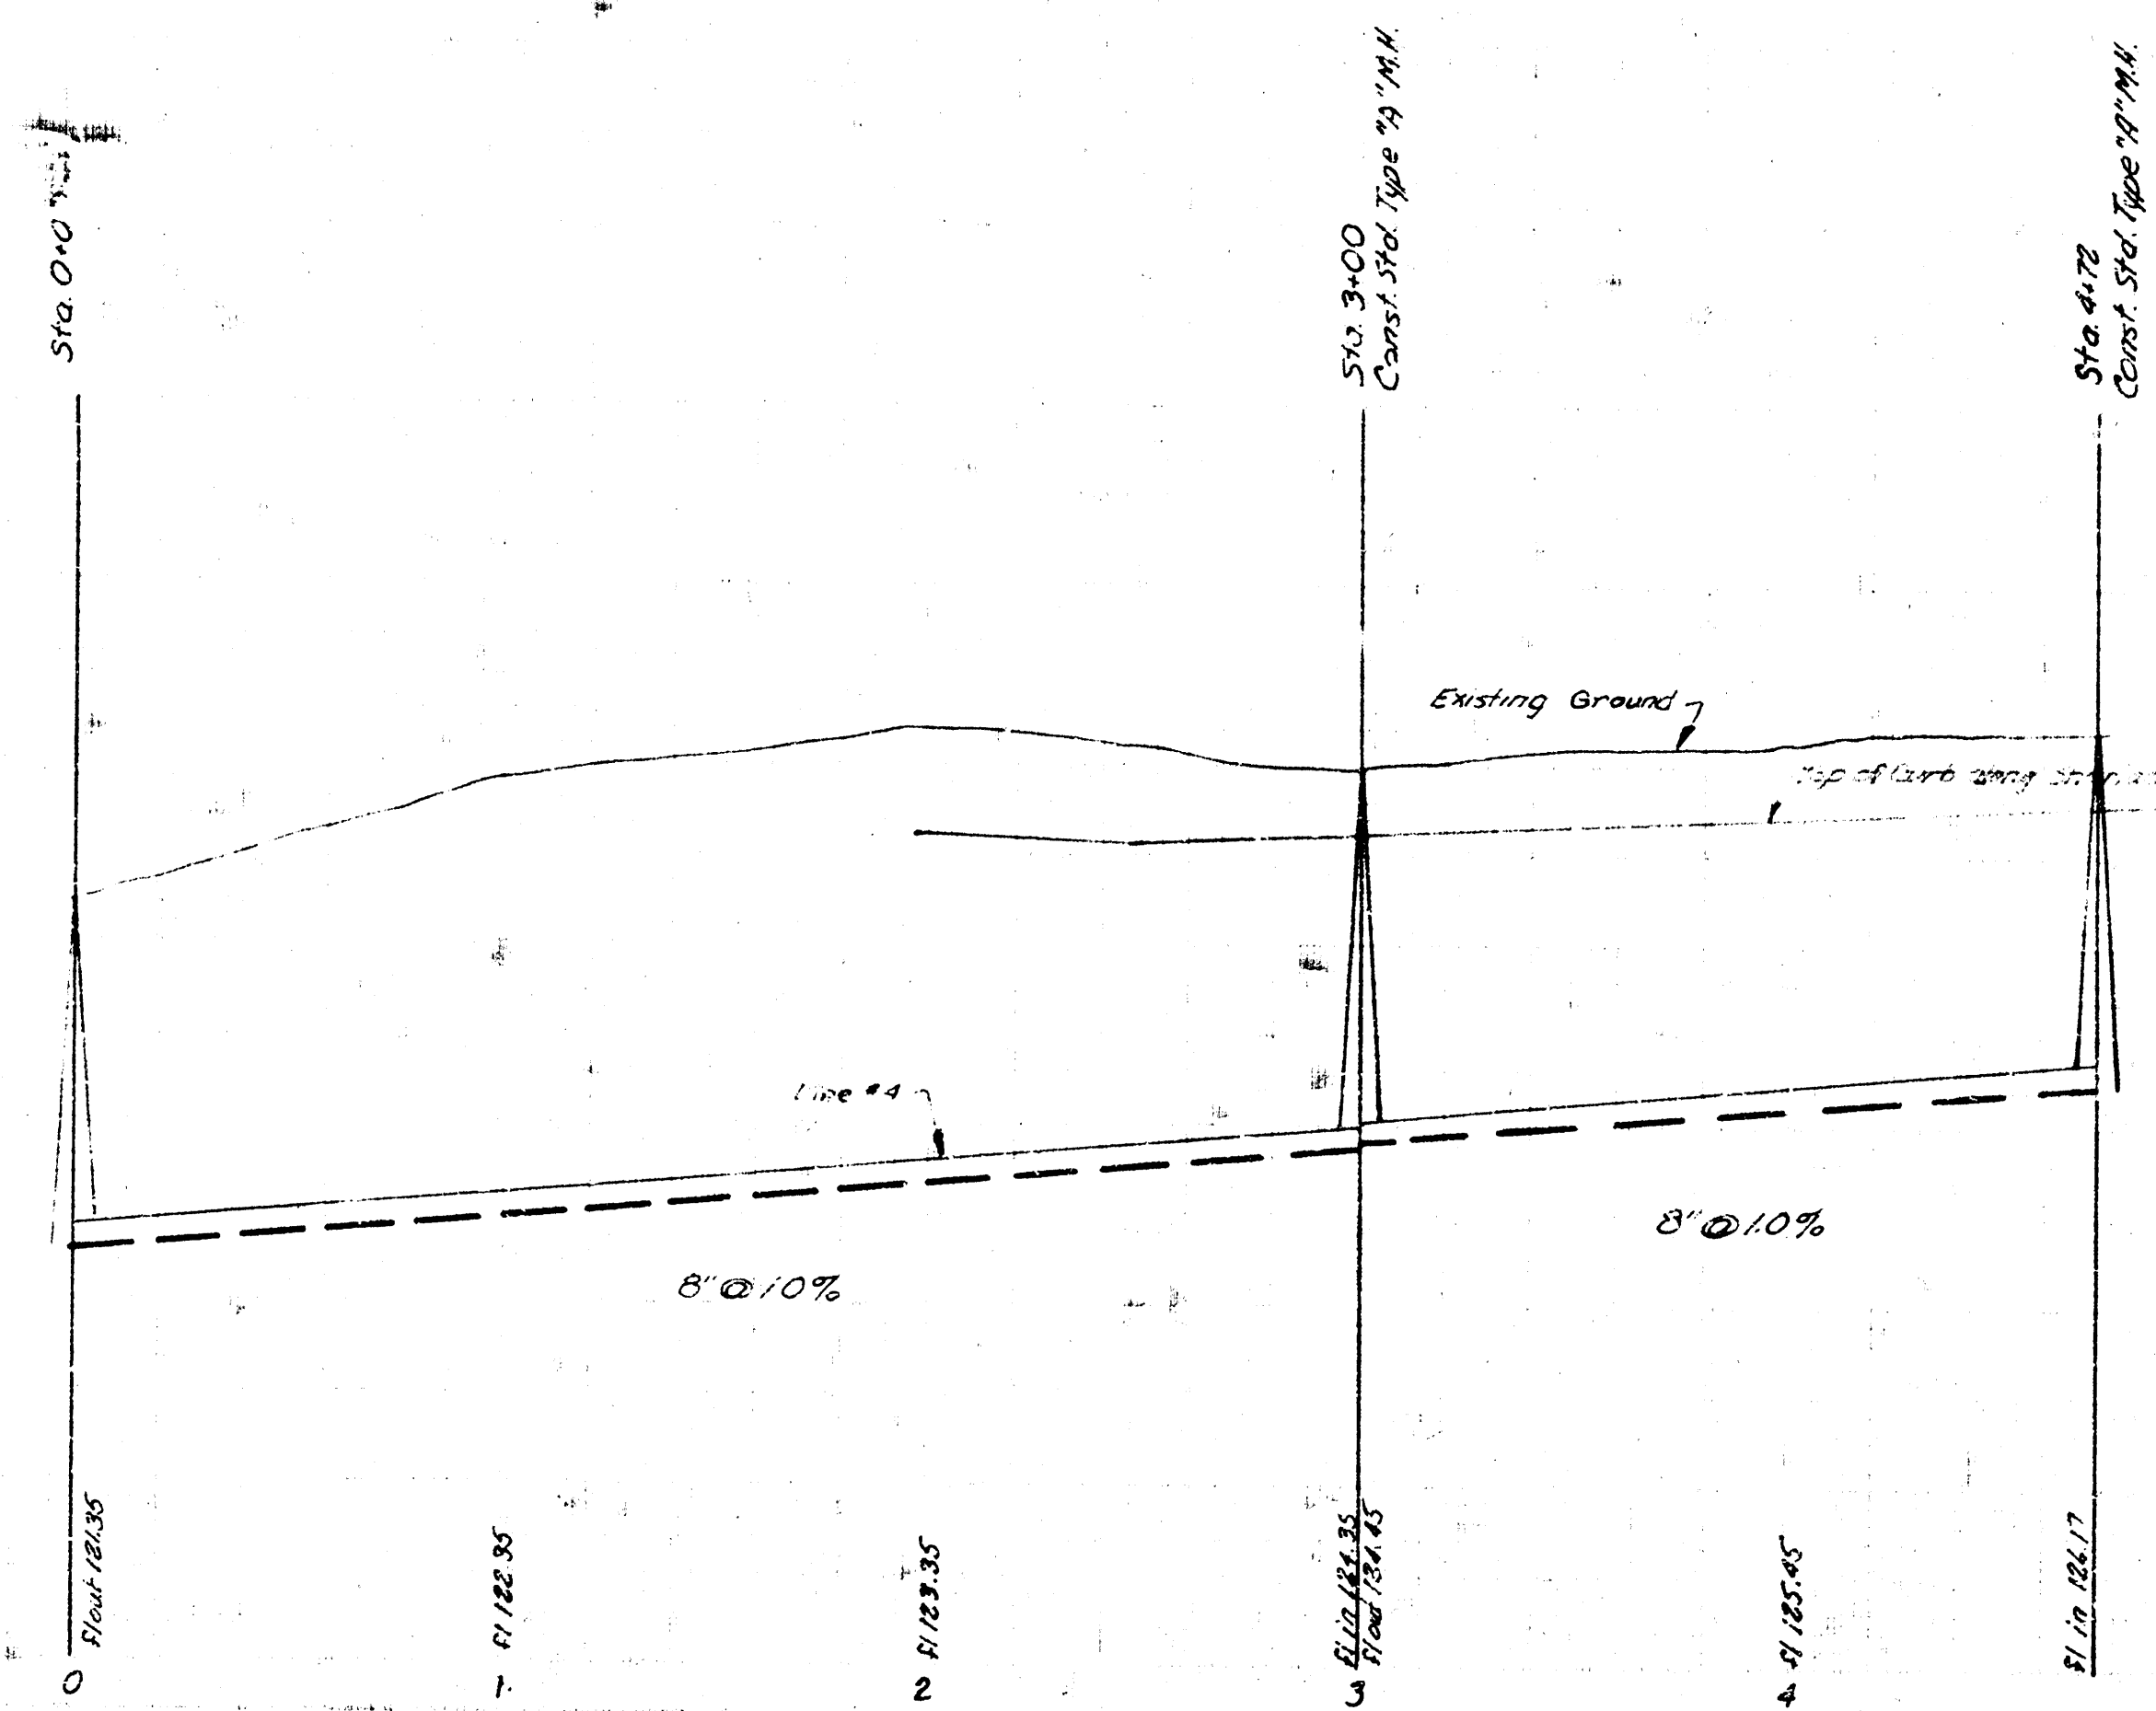

LAT. 49 S.W. INTERCEPTOR
 PROJECT NO. 00-017-015
 SHEET 5 of 6 LINE NO. 4

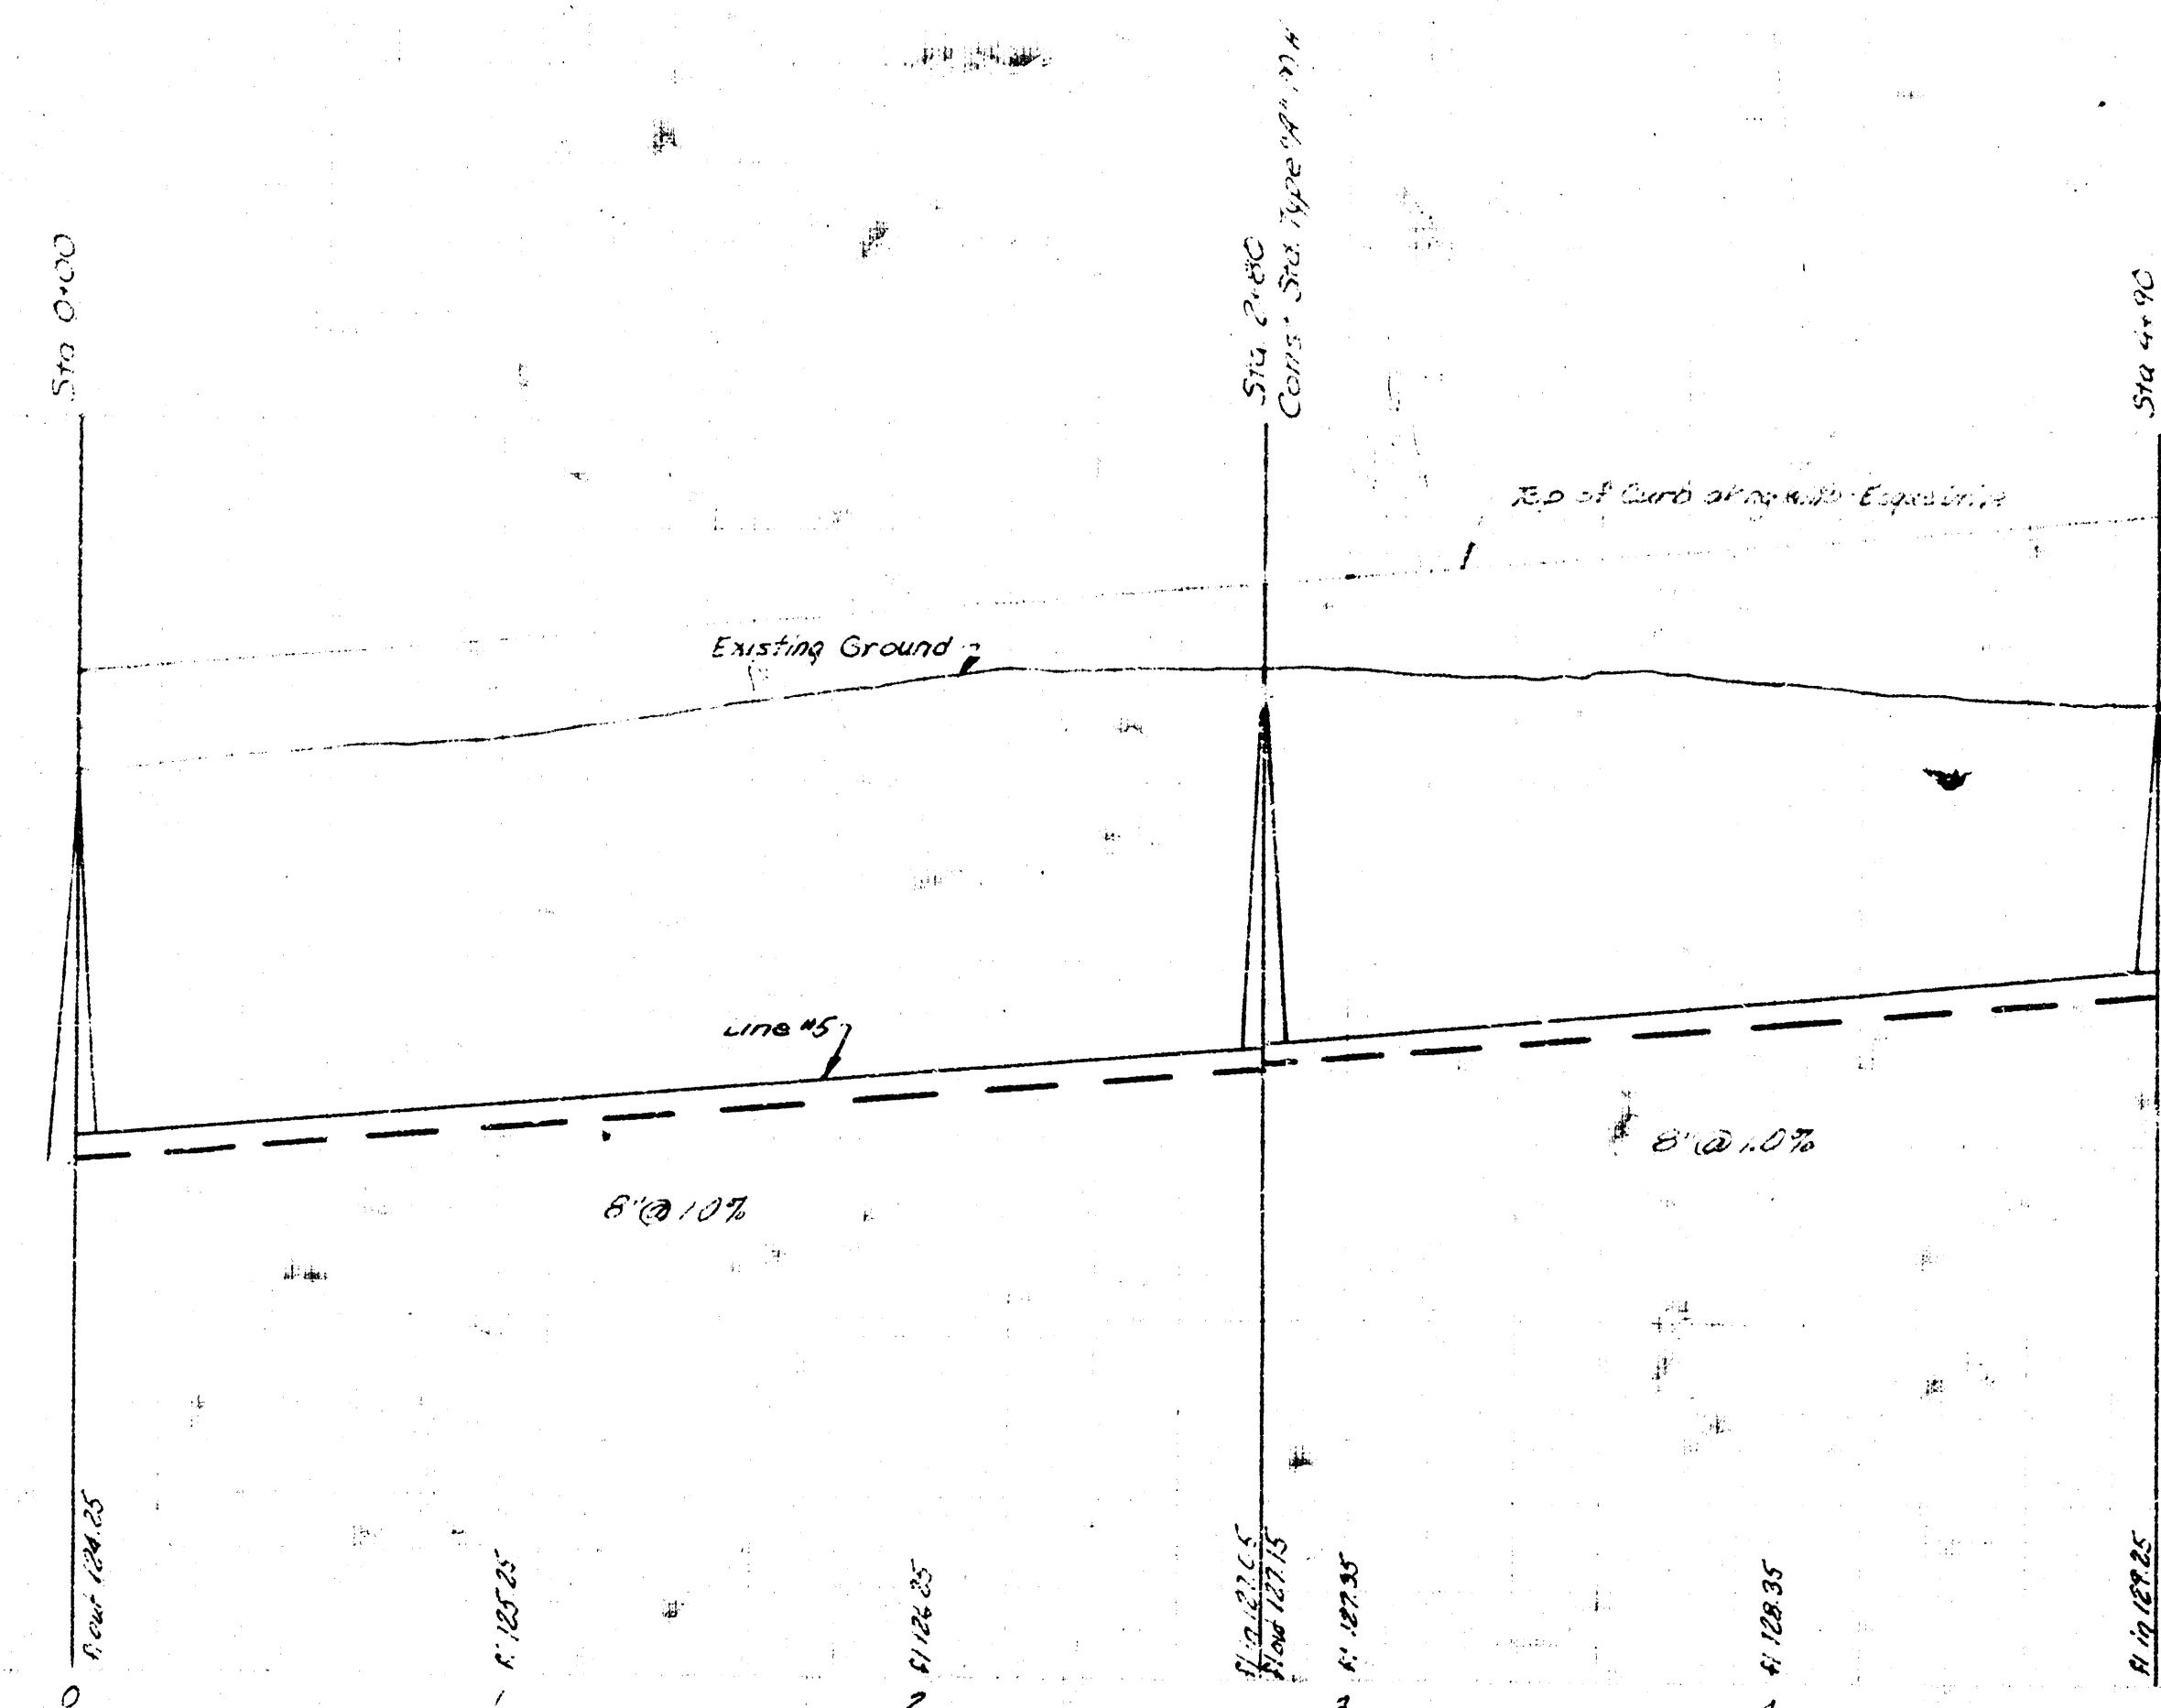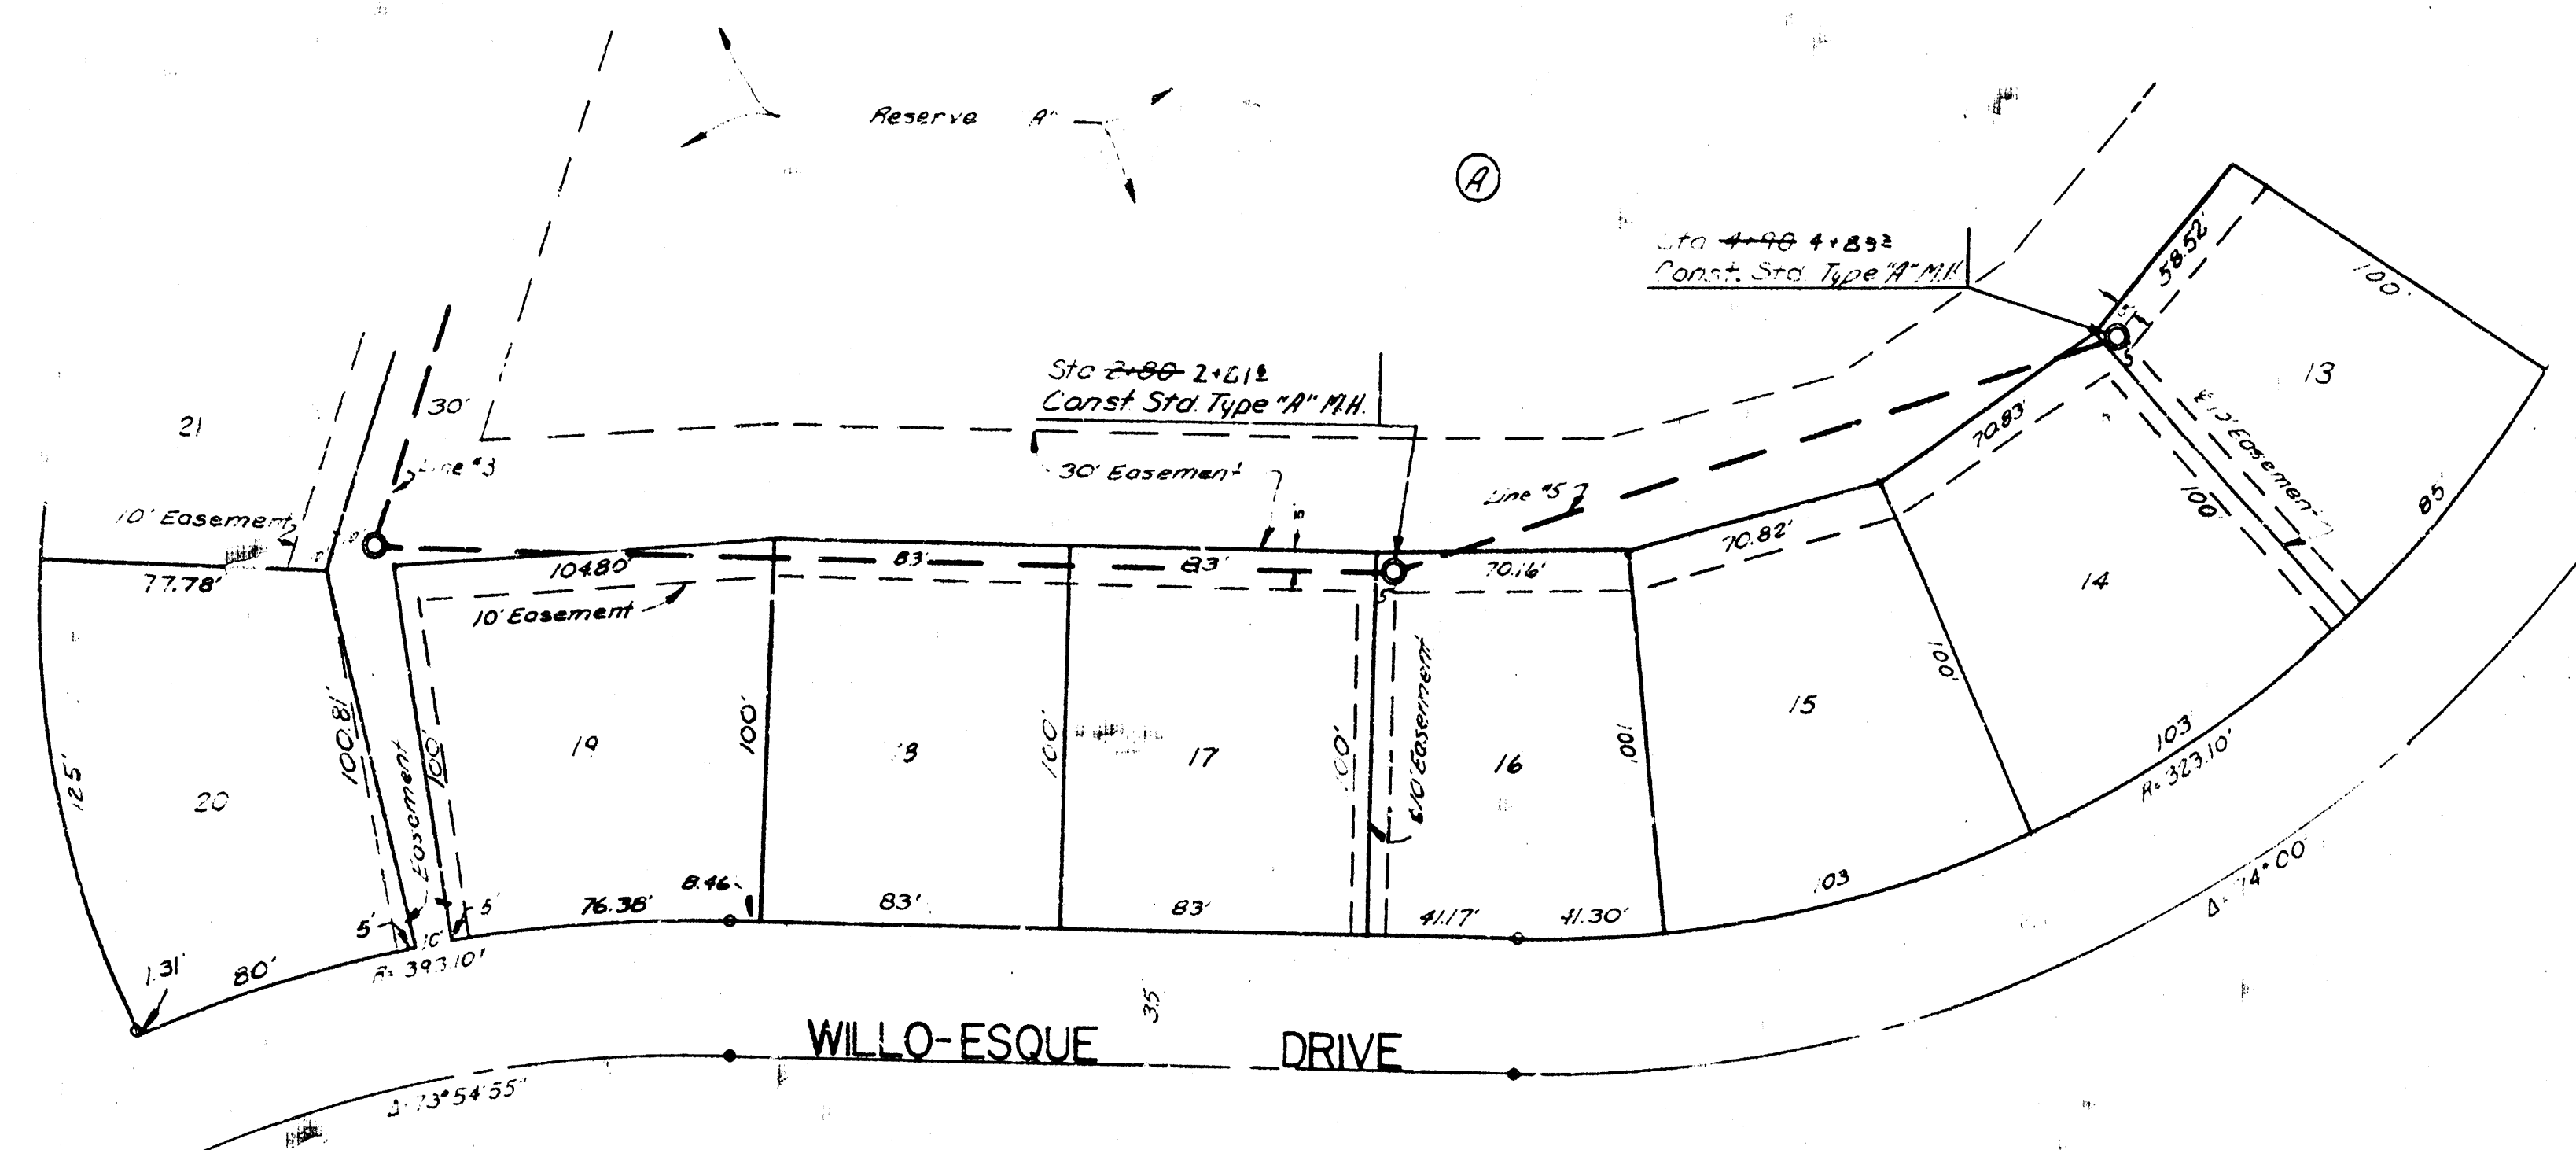

LAT. 49 S. W. INTERCEPTOR
PROJECT NO. ~~DDKLE572015~~
SHEET 6 of 6 LINE NO.5