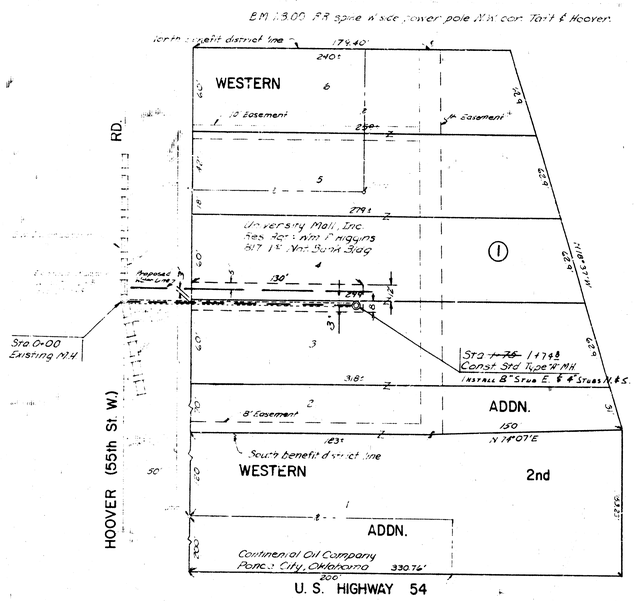

Note Contractor shall contact Ben Adkins of Derby Pipe Line Co. prior to crossing water utility pipeline on 13th St. W.

Note Field Engineer shall check stub's flow elevation prior to connection of sanitary sewer.

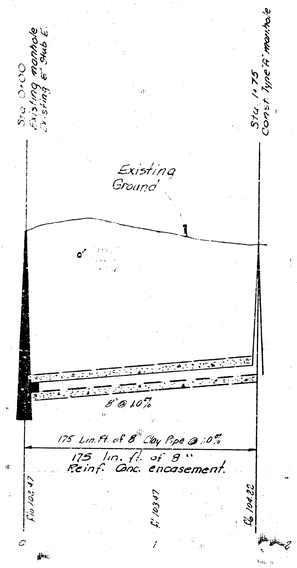

Plan Scale 1"=40'
Profile Scale Hor. 1"=40'
Profile Scale Ver. 1"=5'

"As Built" Final Measurements 4-28

LAT. 50 S.W. INTERCEPTOR
R. W. LINN CITY ENGINEER
CITY OF WICHITA, KS.
PROJ. NO. DBKL 572033
DATE 7-72

14 4 5 5