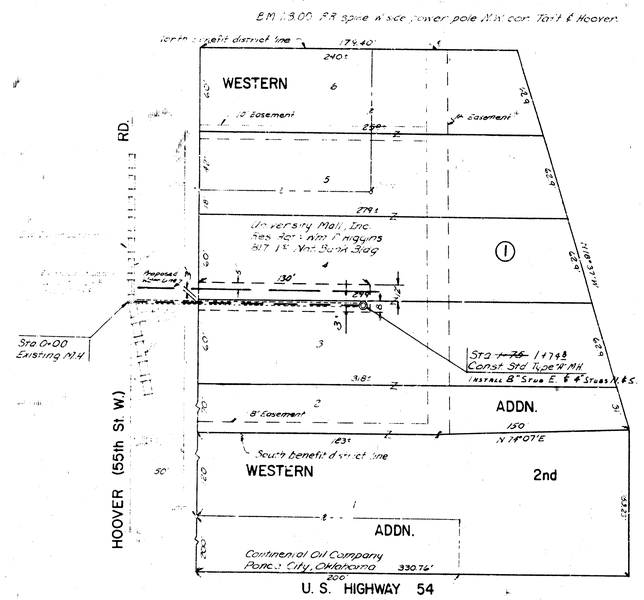

Note: Contractor shall contact Ben Adkins of Derby Pipe line Co. prior to crossing under Derby pipeline Ph. No. 776-1691

Note: Field Engineer shall check stub's flow elevation prior to construction of sanitary sewer.

Plan Scale 1"=40'
Profile Scale Hor. 1"=40'
Profile Scale Ver. 1"=5'

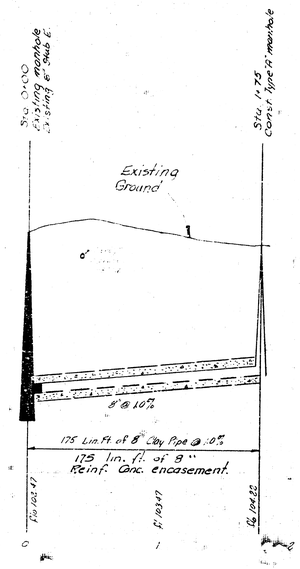

As Built Final Measurements K-28

LAT. 50 S.W. INTERCEPTOR
R. W. LINN CITY ENGINEER
CITY OF WICHITA, KS.
PROJ. NO. DBKL 572033
DATE 7-72