B. M. 141.66 "a" top E-cb Paula @ S. L. University.

B. M. 142.94 N.E. cor. conc. Porch 434 S. Evergreen.

TYLER ROAD

Exist 4" I.L.P. Gas line 44' W. of ℄

Exist. 16" C.I. Water line

To end of 18" R.C.P. Covered up.

18" R.C.P.

A.P. underground conduit N. & S.

A.C. Mat

Conc. Slab

Pump Islana

Joints

Service Station

UNPLATTED

Sta. ~~9166.8~~ Const. Std. M.H. Type "A"

LINE NO. 1

Temp. Elec. Suc

Std. ~~State~~ Const. Std. M.H. Type "A"

Remains of old adv. sign Tele. Pole

Nail set by others

Tele. Pole

Sta. ~~9147.2~~ Const. Std. M.H. Type "A" Install 6" Stub NE

Adv. Sign, Ch. Lk. fnc., G.M. Sign Conc. Base

FLOYD FOURTH AVE.

BAILEY ADDITION

DAULA AVE.

UNIVERSITY

Exist. 8" A.C. Water line

4-Plex Fl. 142.47

4-Plex Fl. 143.85

4-Plex Fl. 144.28

4-Plex Fl. 143.67

146.0 Floor

145.3 Floor

141.9 Floor

Temp. Elec. Suc

Building Under Construction

Buried Tele. Cable

LOT 1 DEVONSHIRE ADDITION

Sta. 2192.0 Const. Std. M.H. Type "A" Sta. 0100.0 Line No. 2

Sta. 0100.0 Exist. M.H.

Sta. 1149.0 Beg. Project

Buried Tele. Cable

Buried Tele. Cable Tele. Pedistal

"CAUTION" Sta. 2185 Buried Telephone Cable.

8' Exist. Pavement

MAPLE ST.

NOTE: Contractor to excavate at Sta. 1149 to verify Flo elev. prior to construction.

Plan Scale 1" = 40'
Profile Scale 1" = 40' Horz.
1" = 5' Vert.


B. M. 143.53 S/d. 34.2' E. and 27.2' S. of ℄ Tyler and Maple.

B. M. 139.31 R.R. Spk. E-face P.P. S.W. cor. Tyler Rd. & University.

B. M. 141.76 "a" Top S-cb University at West end of Rad. 1st curve east of Robin Road.

CAUTION
UNDERGROUND UTILITIES

DONALD E. SCHNEIDER CIVIL ENGINEER 6311 KANSAS REGISTERED PROFESSIONAL ENGINEER

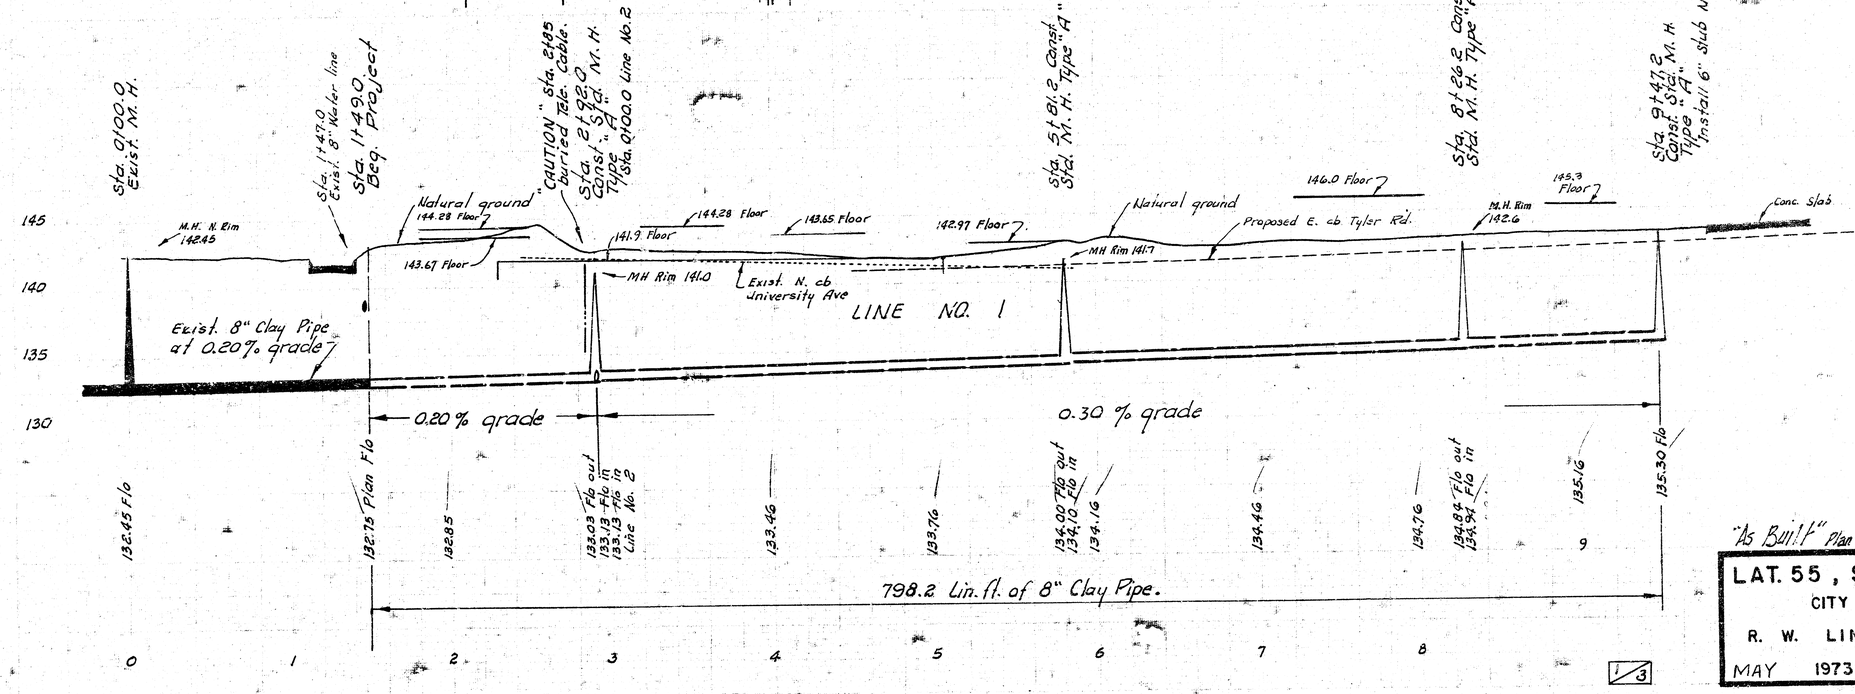

"As Built" Plan from K-108

LAT. 55, S. W. INTERCEPTOR SEWER

CITY OF WICHITA, KANSAS

R. W. LINN — CITY ENGINEER

MAY 1973 PROJECT NO. DEKL572058

1/3

B. M. 141.76 "a" top S-cb University at west end Rad. 1st curve east of Robin Road.

B. M. 143.71 R. R. Spk. SW-face Street lite pole NE cor. Robin Road and Maple.

B. M. 142.94 NE cor. conc. Porch 434 So. Evergreen.

N

Proposed Bldg. Fl. 142.6

Proposed Bldg. Fl. 143.3

Proposed Bldg. Fl. 143.5

Proposed Bldg. Fl. 141.9

Proposed Bldg. Fl. 143.0

LOT 1

DEVONSHIRE ADDITION

LINE NO. 3

Sta. 0100.0 Line No. 2 = Sta. 2192.0 Line No. 1

Sta. ~~1110.0~~ 1119.0 Const. Std. M.H. Type "A" Install 6" Stub N Install 6" Stub W. NW.

Sta. 1125.0 End 8" Clay pipe Plug Pipe

Bar ditch

TURQUOISE LANE

LINE NO. 4

LINE NO. 2

LINE NO. 1

Phone Pedistal Buried Cable.

4-Plex Fl. 143.67

4-Plex Fl. 144.13

4-Plex Fl. 144.23

Sta. ~~0178.8~~ 0178.8 Const. Std. M.H. Type "A" Sta. 0100.0 Line No. 3

Sta. ~~2151.8~~ 2151.8 Const. Std. M.H. Type "A" Sta. 0100.0 Line No. 5

Sta. ~~3158.4~~ 3158.4 Const. Std. M.H. Type "A" Sta. 0100.0 Line No. 4

Sta. ~~5190.0~~ 5190.0 Const. Std. M.H. Type "A"

5 6 7 8 9 10 11 12 13

FLOYD BAILEY FOURTH ADDN. Fl.

EVERGREEN LANE

UNIVERSITY AVE.

Iron Tacked hub Bar ditch

Sta. 0100.0 Line No. 2 = Sta. 2192.0 Line No. 1

Sta. 0178.8 Const. Std. M.H. Type "A" Sta. 0100.0 Line No. 3

Sta. 2151.8 Const. Std. M.H. Type "A" Sta. 0100.0 Line No. 5

Sta. 3158.4 Const. Std. M.H. Type "A" Sta. 0100.0 Line No. 4

Sta. 5190.0 Const. Std. M.H. Type "A"

Exist N. cb University Ave.

Natural ground

Proposed S. cb Turquoise Lane

MH Rim 142.0

MH Rim 141.0

LINE NO. 2

590 Lin. ft. of 8" Clay Pipe @ 0.20 % grade.

Sta. 0100.0 Line No. 3 = Sta. 0178.8 Line No. 2

Sta. 1110.0 Const. Std. M.H. Type "A" Install 6" Stub N Install 6" Stub W. NW

MH. Rim 141.5

LINE NO. 3

110 Lin. ft. of 8" Clay Pipe @ 0.50 % grade

Sta. 0100.0 Line No. 4 = Sta. 3188.4 Line No. 2

Sta. 1125.8 End 8" Clay Pipe. Plug Pipe.

Proposed S. cb. Turquoise Lane

LINE NO. 4

125.2 Lin. ft. of 8" Clay Pipe @ 0.20% grade


2/3

LAT. 55, S. W. INTERCEPTOR SEWER

PROJECT NO. DBKL572058

2/3

1-eng-
1-water

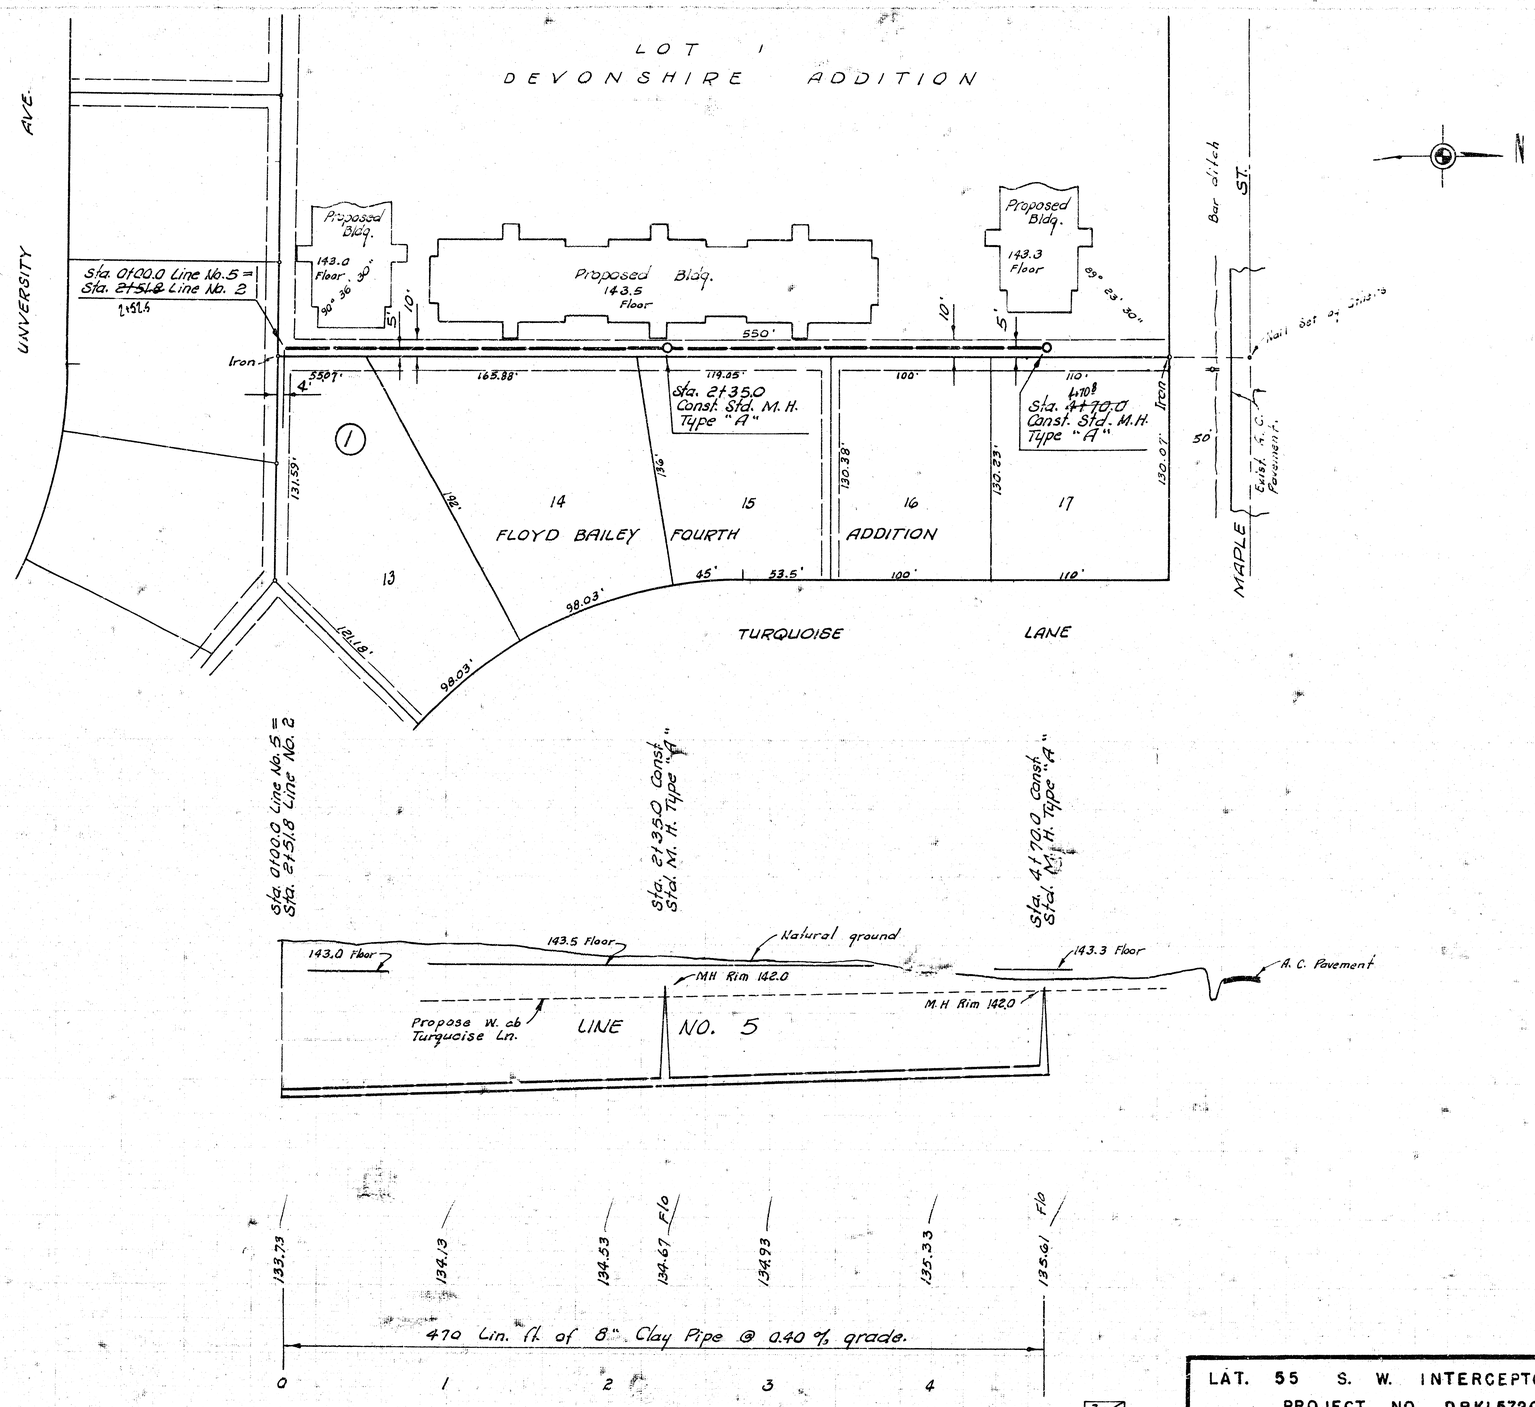

LAT. 55 S. W. INTERCEPTOR SEWER
PROJECT NO. DBKL572058

3/3

14 2 3 (2) 10-Engr. 1-Water