

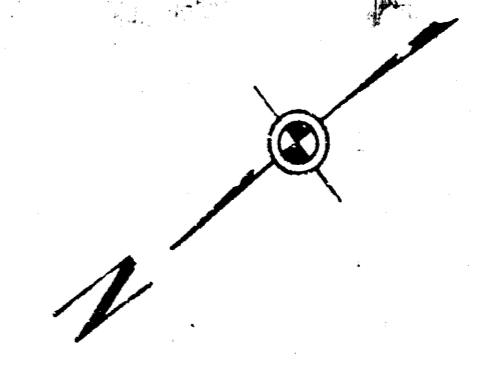


FILE  
DATE

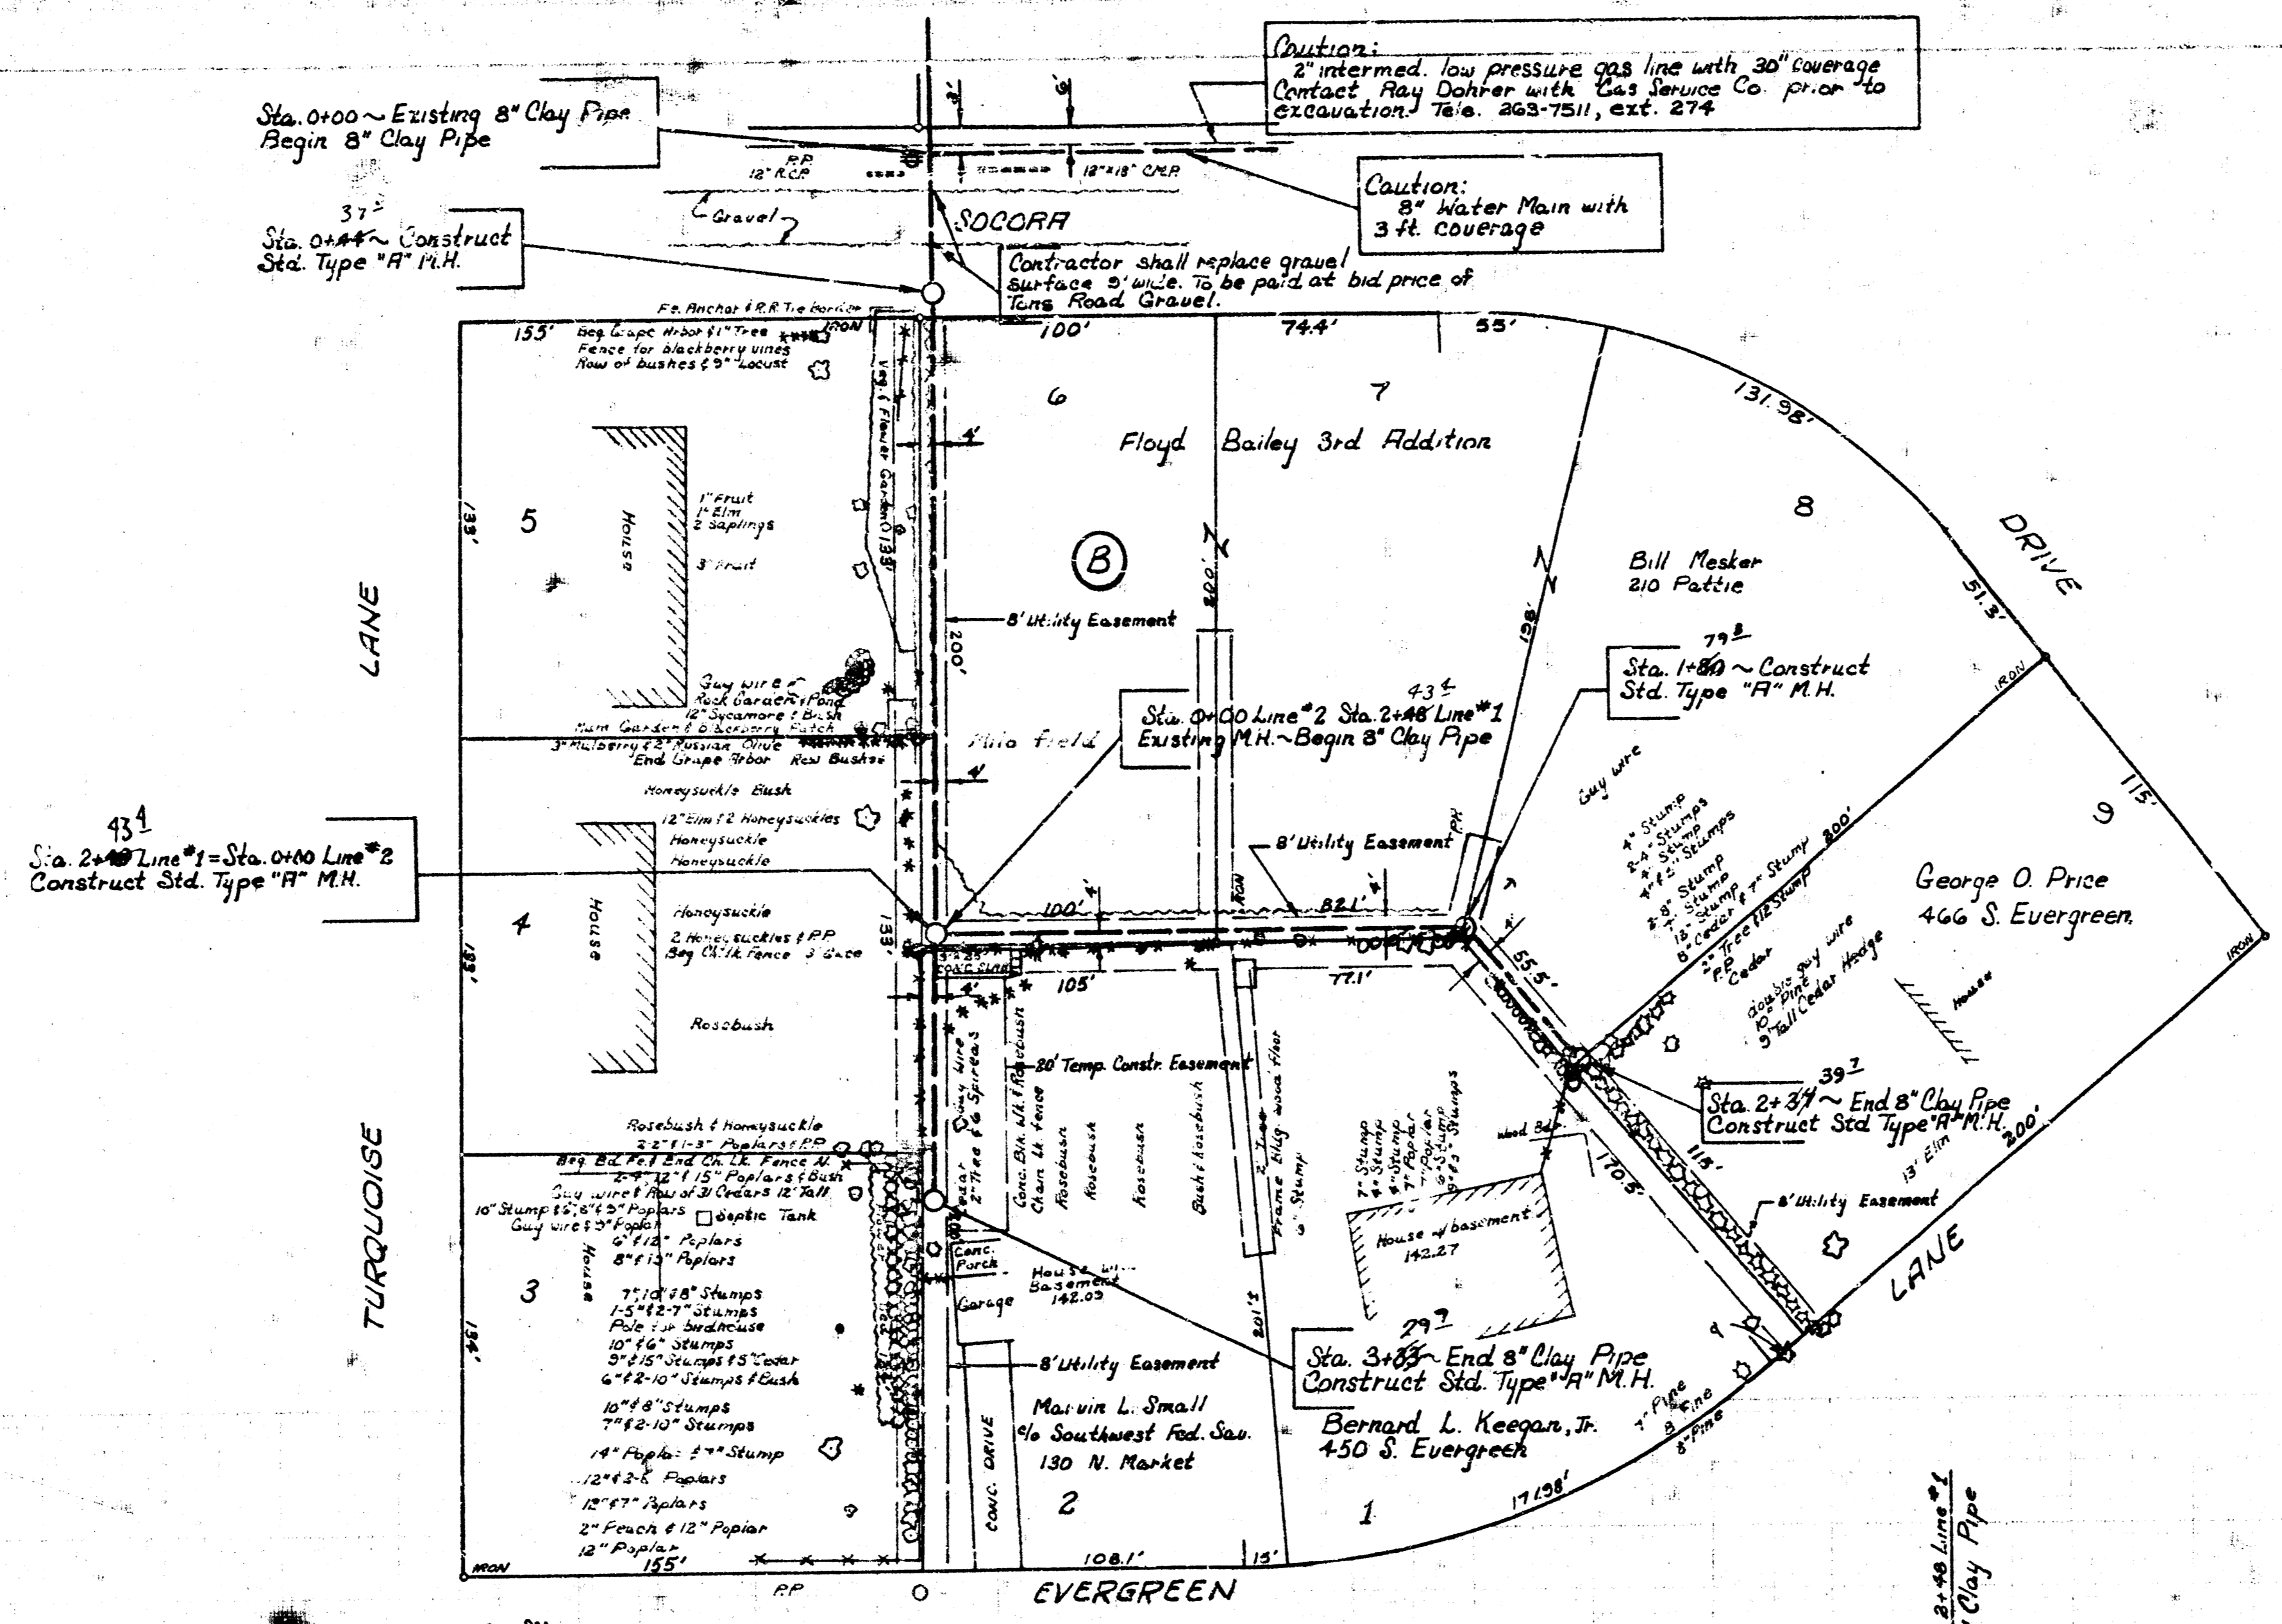

Plan Scale 1" = 40'  
Profile Scale 1" = 4' Vert.

B.M. 142.94 ~ NE. cor. conc. porch 434 So. Evergreen

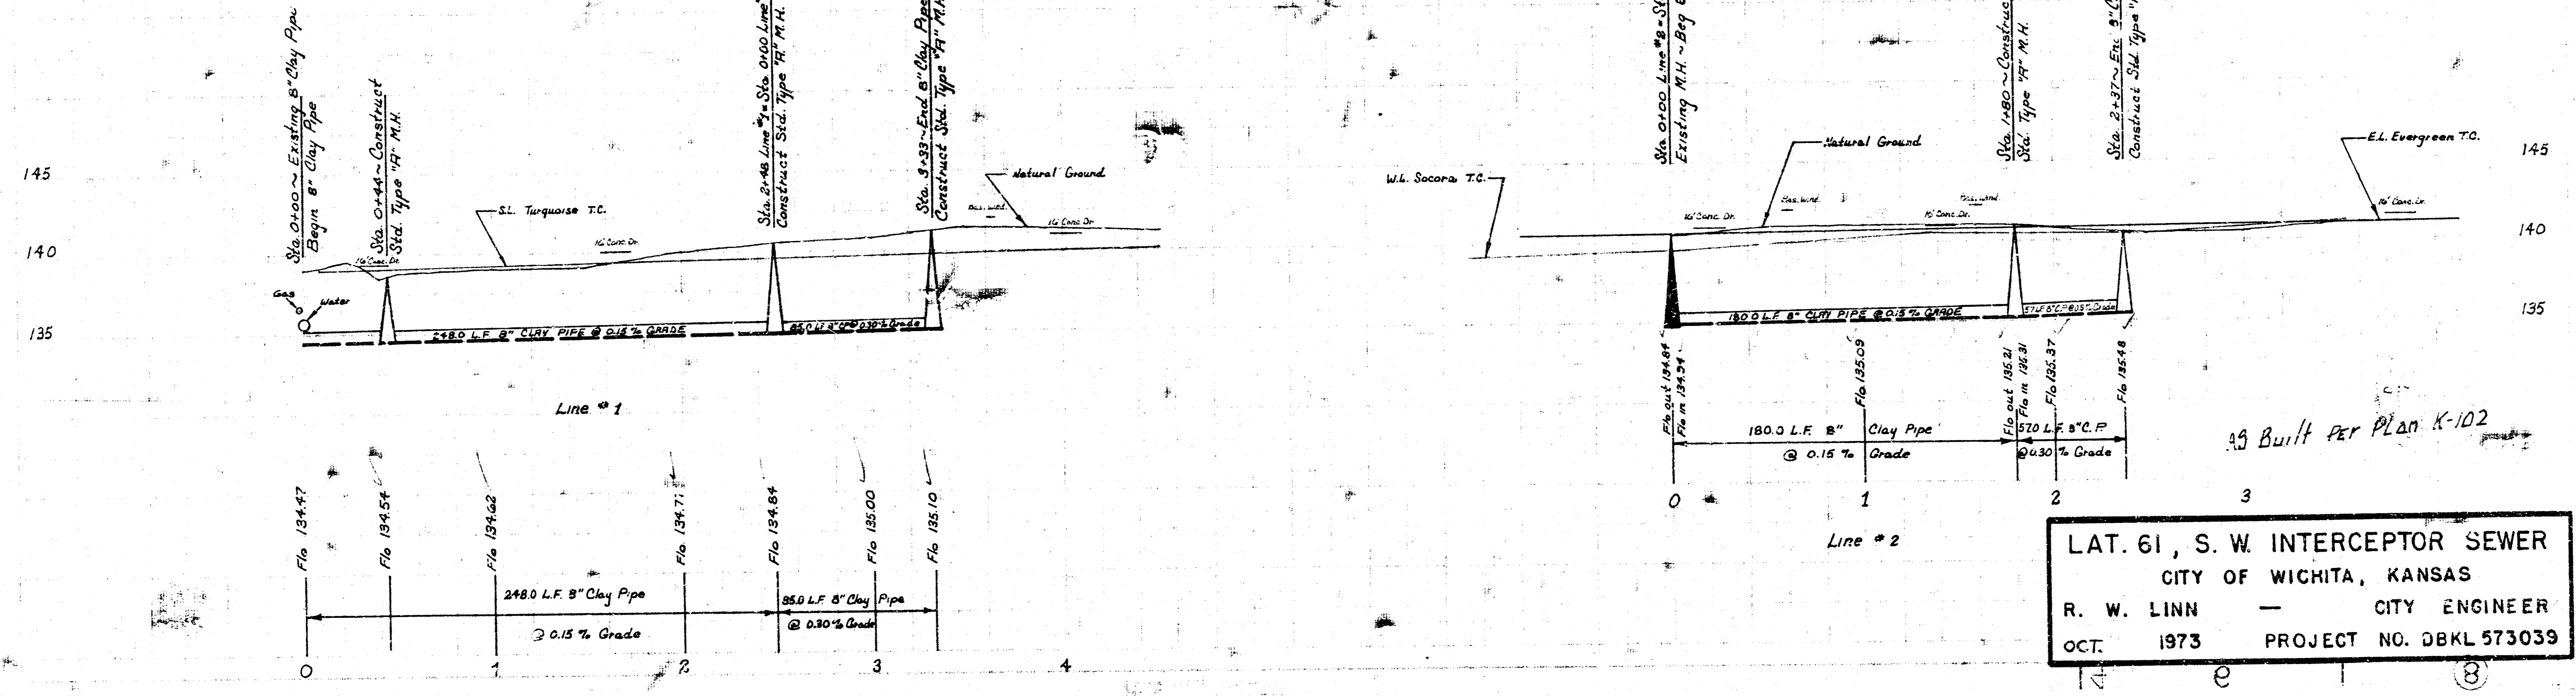

LAT. 61, S. W. INTERCEPTOR SEWER  
CITY OF WICHITA, KANSAS  
R. W. LINN — CITY ENGINEER  
OCT. 1973 PROJECT NO. DBKL 573039

Built per Plan K-102