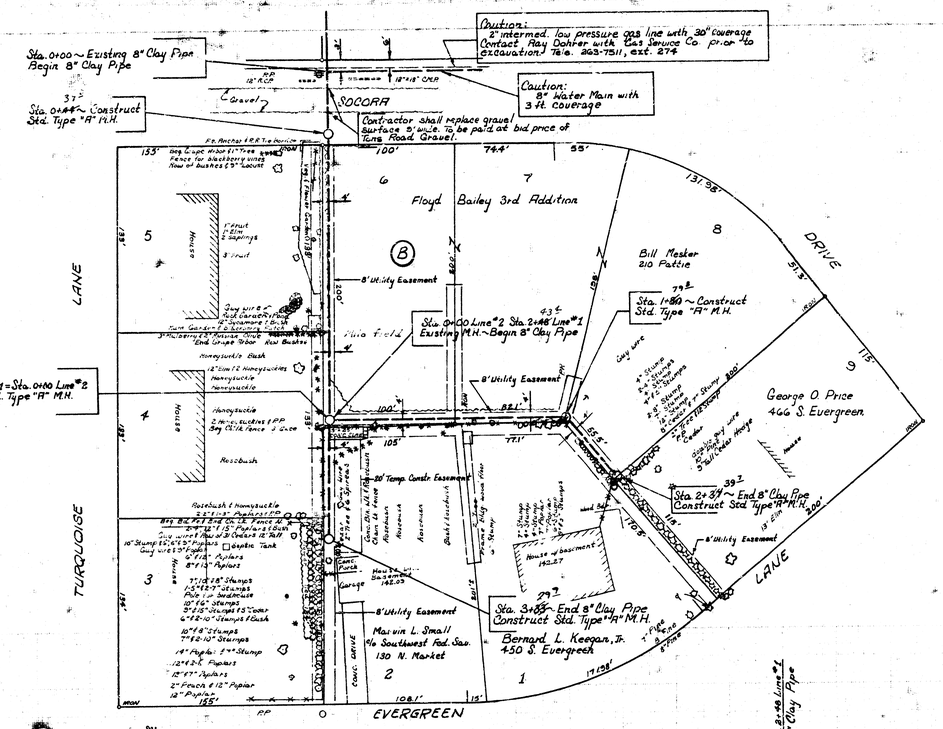

Caution:
2" intermed. low pressure gas line with 30" coverage
Contact Ray Dohrer with Gas Service Co. prior to excavation. Tele. 263-7511, ext. 274
Caution:
8" Water Main with 3 ft. coverage
Sta. 0+00 ~ Existing 8" Clay Pipe
Begin 8" Clay Pipe
Sta. 0+44 ~ Construct Std. Type "A" M.H.
Contractor shall replace gravel surface 5' wide to be paid at bid price of Tons Road Gravel.
SOCORA
Floyd Bailey 3rd Addition
Bill Mesker
210 Pattie
George O. Price
466 S. Evergreen
Sta. 1+80 ~ Construct Std. Type "A" M.H.
Sta. 0+00 Line #2 Sta. 2+48 Line #1 Existing M.H. ~ Begin 8" Clay Pipe
Sta. 2+48 Line #1 = Sta. 0+00 Line #2 Construct Std. Type "A" M.H.
8' Utility Easement
20' Temp. Constr. Easement
Sta. 2+37 ~ End 8" Clay Pipe Construct Std. Type "A" M.H.
Sta. 3+83 ~ End 8" Clay Pipe Construct Std. Type "A" M.H.
Marvin L. Small
c/o Southwest Fed. Sav.
130 N. Market
Bernard L. Keegan, Jr.
450 S. Evergreen
LANE
TURQUOISE
DRIVE
EVERGREEN
Plan Scale 1" = 40'
Profile Scale 1" = 5' Horz.
Vert.
B.M. 1429.4 ~ N.E. cor. conc. porch 434 So. Evergreen
Sta. 0+00 ~ Existing 8" Clay Pipe Begin 8" Clay Pipe
Sta. 0+44 ~ Construct Std. Type "A" M.H.
Sta. 2+48 Line #1 Sta. 0+00 Line #2 Construct Std. Type "A" M.H.
Sta. 3+83 ~ End 8" Clay Pipe Construct Std. Type "A" M.H.
S.L. Turquoise T.C.
Natural Ground
248.0 L.F. 8" CLAY PIPE @ 0.15 % GRADE
850.0 L.F. 8" CLAY PIPE @ 0.30 % GRADE
Line # 1
Flo 134.47
Flo 134.54
Flo 134.62
Flo 134.71
Flo 134.84
Flo 135.00
Flo 135.10
248.0 L.F. 8" Clay Pipe @ 0.15 % Grade
850 L.F. 8" Clay Pipe @ 0.30 % Grade
Sta. 0+00 Line #2 = Sta. 2+48 Line #1 Existing M.H. ~ Beg 8" Clay Pipe
Sta. 1+80 ~ Construct Std. Type "A" M.H.
Sta. 2+37 ~ End 8" Clay Pipe Construct Std. Type "A" M.H.
W.L. Socora T.C.
E.L. Evergreen T.C.
180.0 L.F. 8" CLAY PIPE @ 0.15 % GRADE
570 L.F. 8" C.P. @ 0.30 % Grade
Flo out 134.69'
Flo in 134.74'
Flo 135.09
Flo out 135.21'
Flo in 135.31'
Flo 135.37
Flo 135.48
180.0 L.F. 8" Clay Pipe @ 0.15 % Grade
Line # 2
As Built Per Plan K-102
LAT. 61, S. W. INTERCEPTOR SEWER
CITY OF WICHITA, KANSAS
R. W. LINN — CITY ENGINEER
OCT. 1973 PROJECT NO. 08KL 573039