
B. M. 148.10 City std. @ Ridge Rd. & 13th St.

B. M. 159.71 N.E. cor. conc. porch No. #1525 N. Holland.

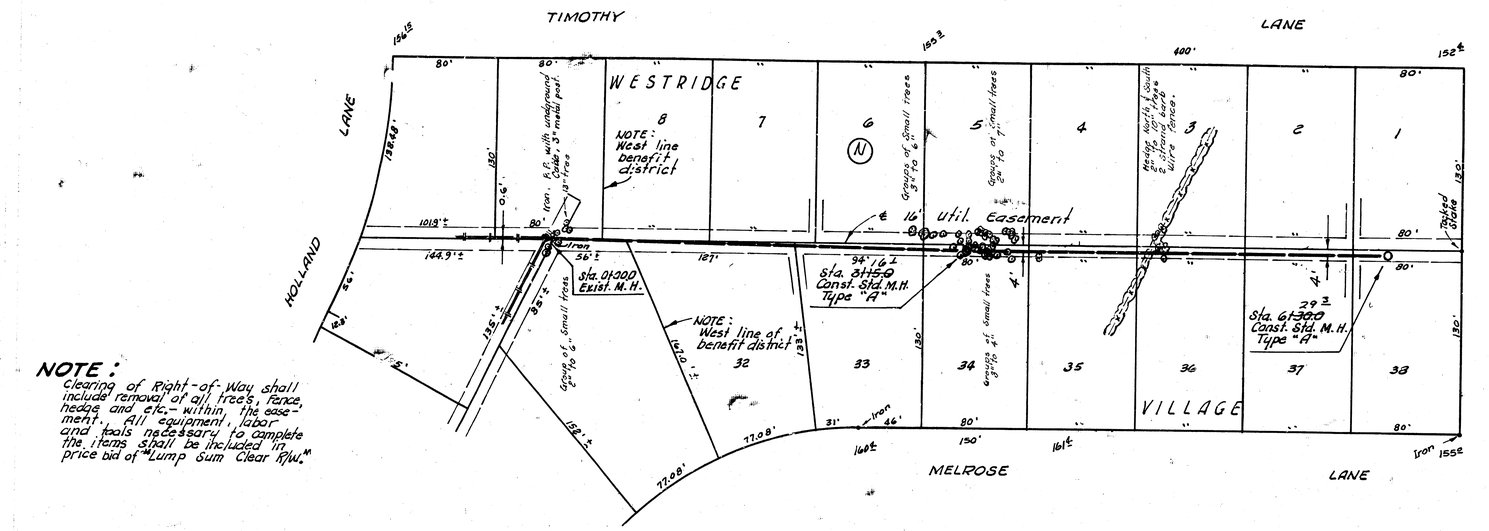


**NOTE:**
Clearing of Right-of-Way shall include removal of all trees, fence, hedge and etc.- within the easement. All equipment, labor and tools necessary to complete the items shall be included in price bid of "Lump Sum Clear R/W."

Plan Scale 1"=40'
Profile Scale 1"=40' Horz.
1"=5' Vert.

As Built Final Mros. K-102

DONALD E. SUNDGREN LICENSED 6311 KANSAS PROFESSIONAL ENGINEER

LAT. 64, S. W. INTERCEPTOR SEWER
CITY OF WICHITA, KANSAS
R. W. LINN — CITY ENGINEER
DEC. 1973 PROJECT NO. DBKL 573075