


B. M. 148.10 City Std. @ Ridge Rd. & 13th St.
 B. M. 159.71 N.E. cor. conc. porch No. # 1525 N. Holland.



217

NOTE:

Clearing of Right-of-Way shall include removal of all trees, fence, hedges and etc. within the easement. All equipment, labor and tools necessary to complete the items shall be included in price bid of "Lump Sum Clear R/W."

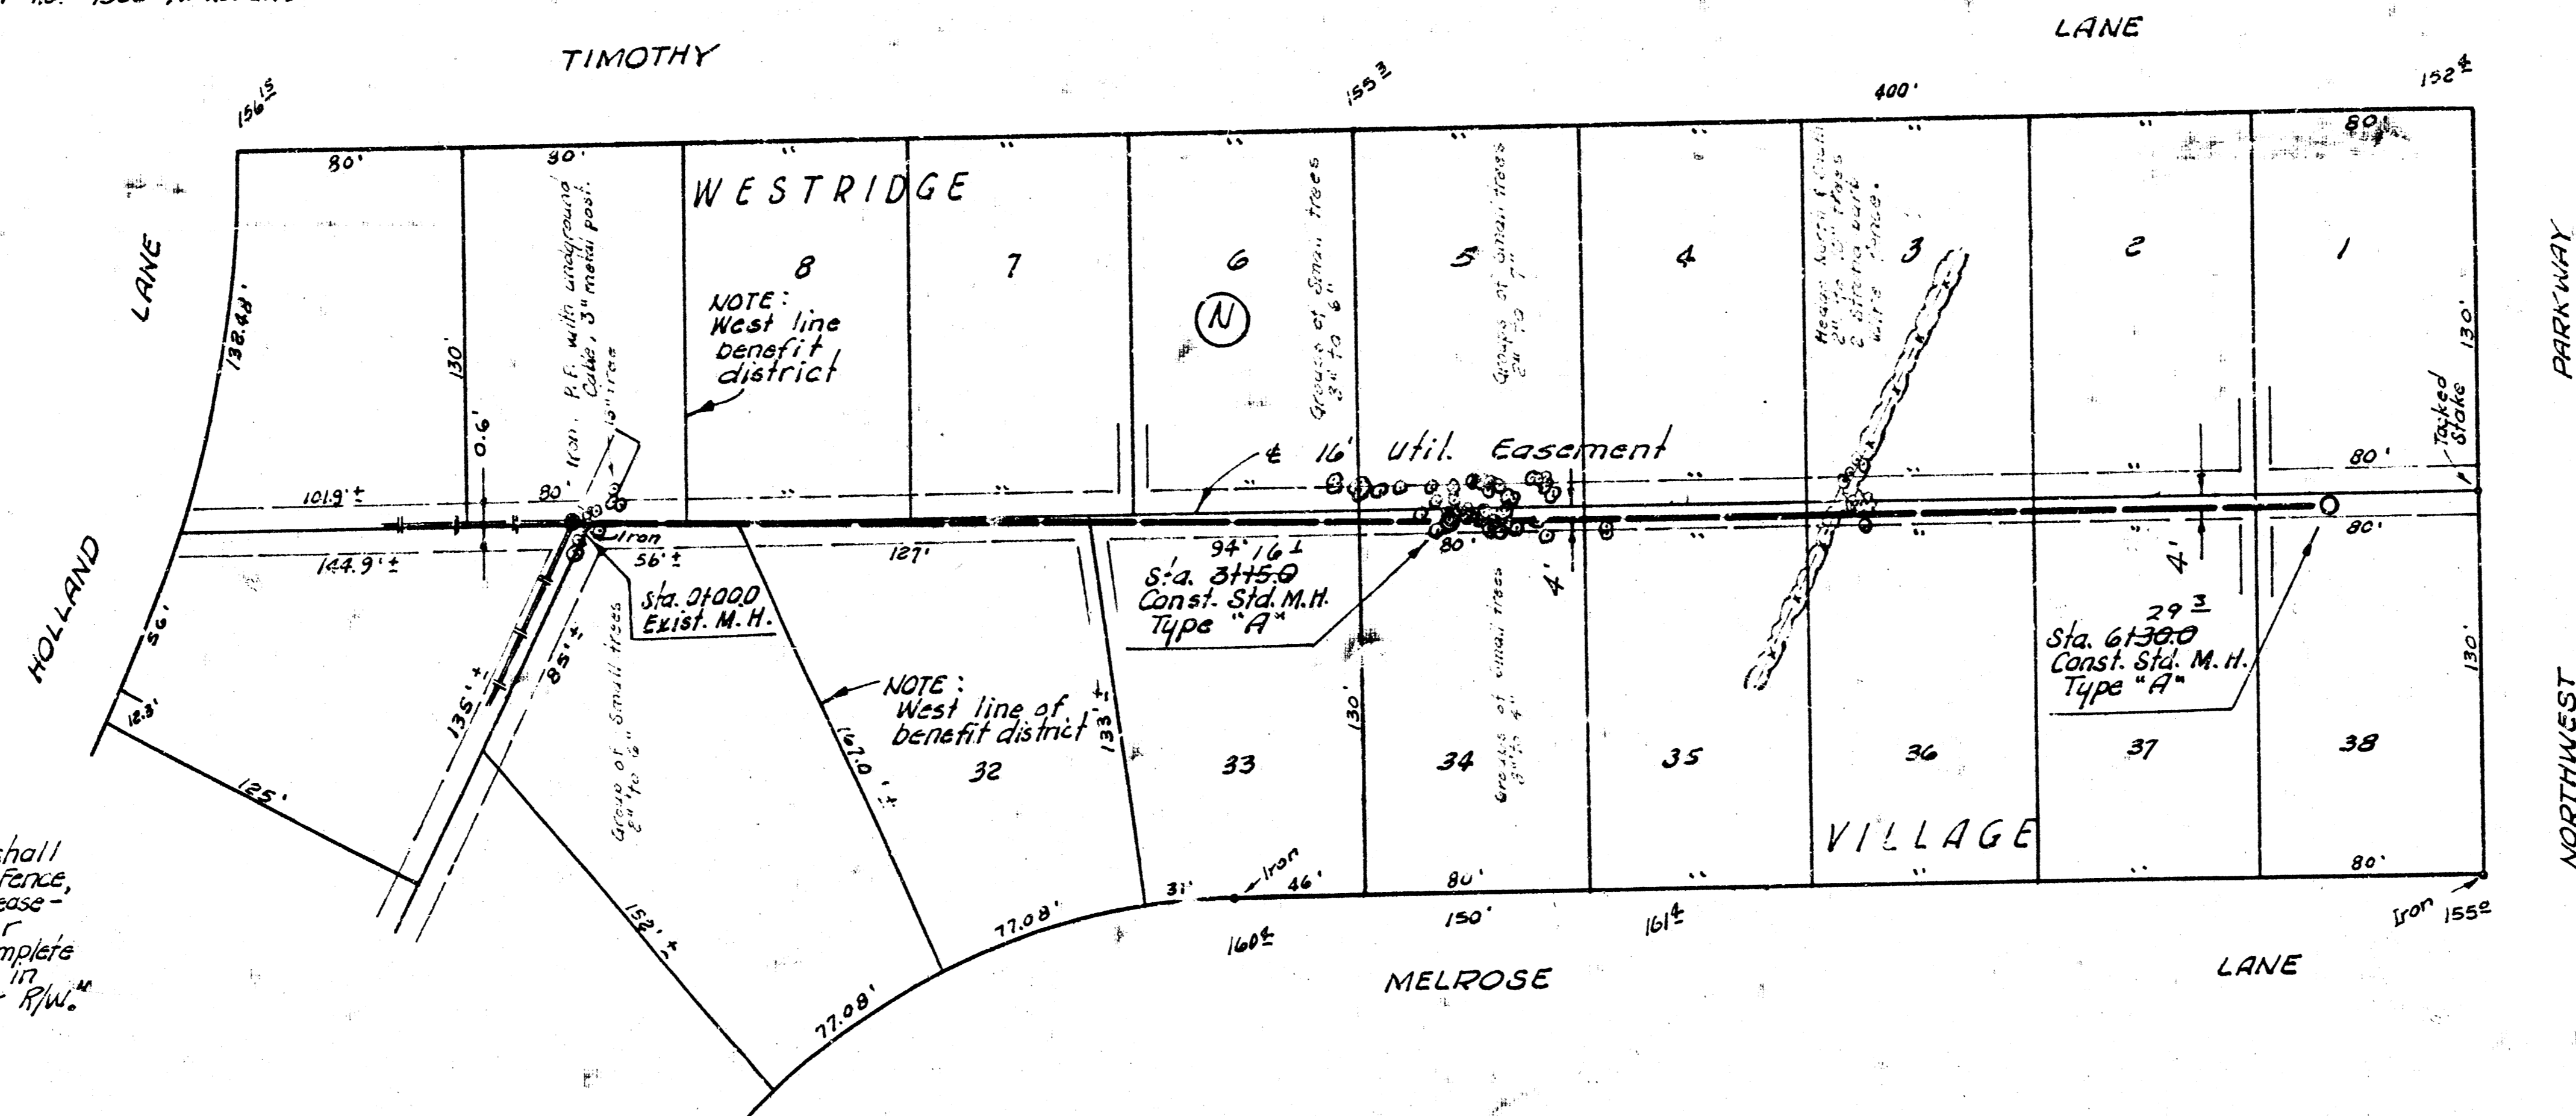

Plan Scale 1" = 40'
 Profile Scale 1" = 4' Horiz.
 1" = 5' Vert.

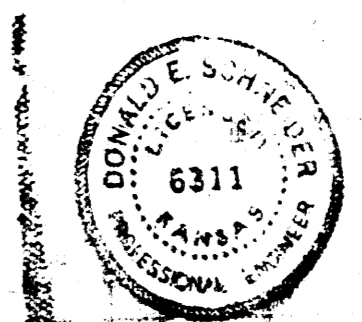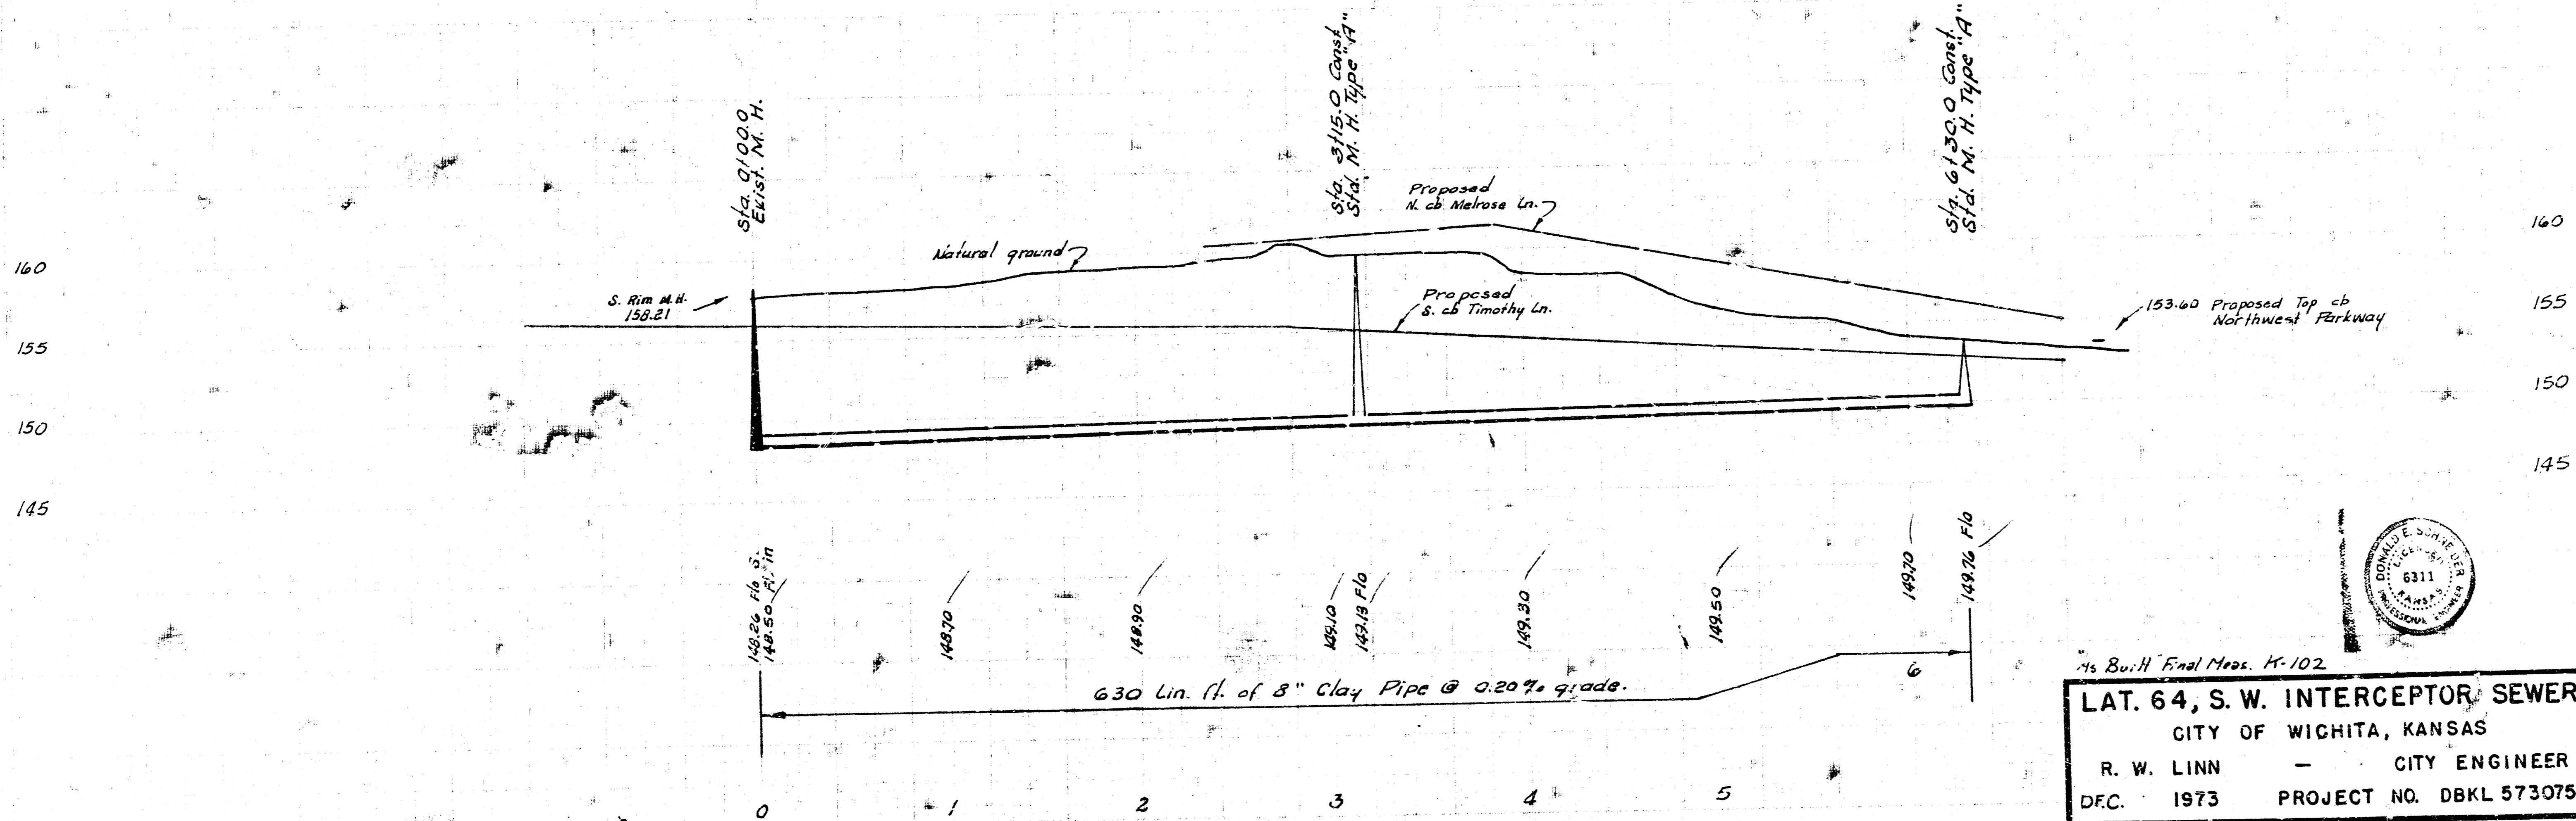

As Bu. H. Final Meas. K-102.
LAT. 64, S. W. INTERCEPTOR SEWER
 CITY OF WICHITA, KANSAS
 R. W. LINN - CITY ENGINEER
 DEC. 1973 PROJECT NO. DBKL 573075