
B. M. 148.10 City Std. @ Ridge Rd. & 13th St.

B. M. 159.71 N.E. cor. conc. porch No. # 1525 N. Holland.

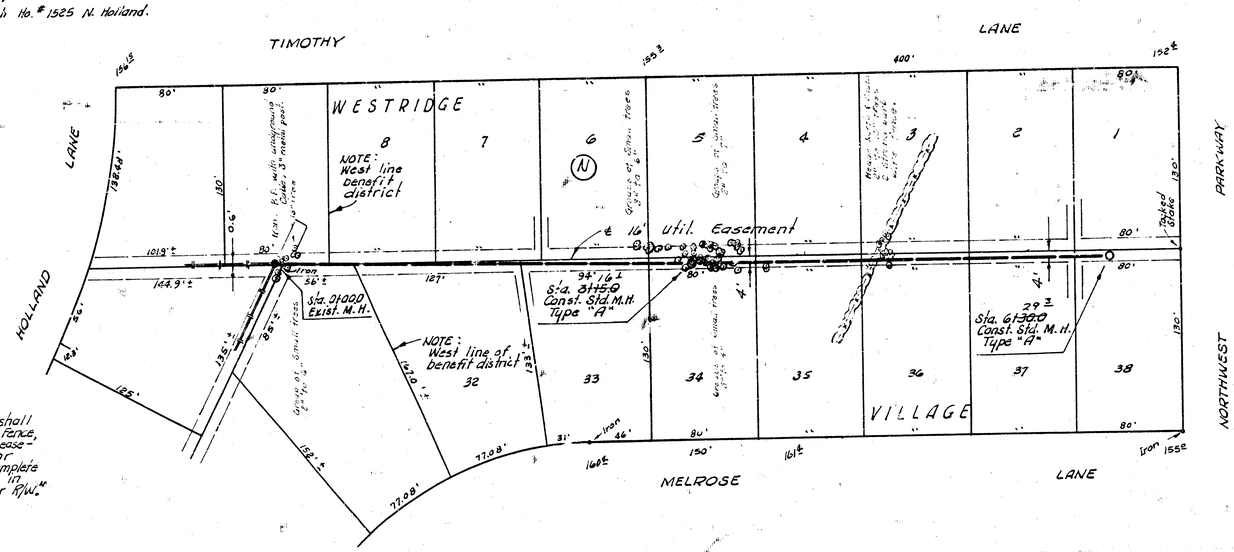

Plan Scale 1" = 40' Horz.
Profile Scale 1" = 5' Vert.

NOTE:
Clearing of Right-of-Way shall include removal of all trees, fence, hedge and etc.- within the easement. All equipment, labor and tools necessary to complete the items shall be included in price bid of "Lump Sum Clear R/W."

As Built Final Meas. K-102

LAT. 64, S. W. INTERCEPTOR SEWER
CITY OF WICHITA, KANSAS
R. W. LINN — CITY ENGINEER
D.F.C. 1973 PROJECT NO. DBKL 573075