
B. M. 148.102 City Std. on S.W. cor. Ridge Rd. & 13th St.

B. M. 149.837 ½" Bolt N. Side P. Pole on S.W. cor. Dunsworth & 13th St.

B. M. 154.627 R.R. Spike E. Side, Bell pole 125' N. of N. Line Nantucket and 125' W of W. Line of Morgantown.

B. M. 159.71 NE. cor. conc. porch No. #1525 N. Holland.

NOTE:
Clearing of Right-of-Way shall include removal of all trees, fence, hedge and etc. - within the easement. All equipment, labor and tools necessary to complete the items shall be included in price bid of "Lump Sum Clearing R/W."

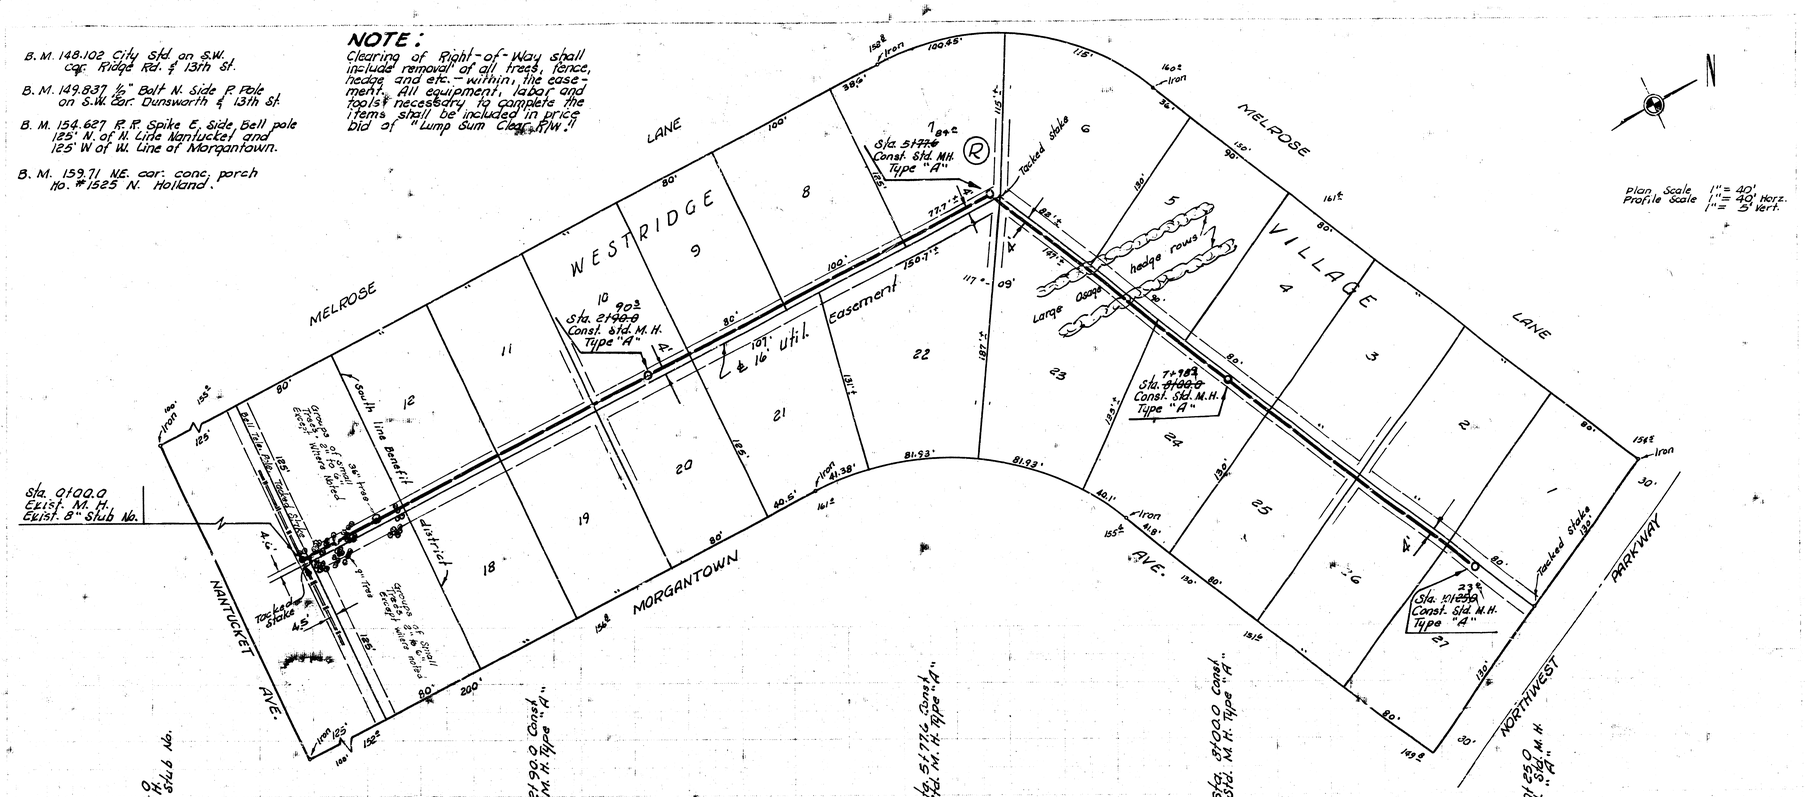

Plan Scale 1" = 40'
Profile Scale 1" = 40' Horz.
1" = 5' Vert.

RAYMOND E. SCHAEFER 6311 REGISTERED LAND SURVEYOR KANSAS

LAT. 65, S.W. INTERCEPTOR SEWER
CITY OF WICHITA, KANSAS
R. W. LINN — CITY ENGINEER
DEC. 1973 PROJECT NO. DBKL573076

FILMED FROM THE BEST AVAILABLE COPY