


14-3-1-10
10 M. H. M.
10-10-74
Pg 2

69
A. R. W.
U. R. W.


B. M. 108.43 City Std. Hoover & 31st. St. So.
44' E. & 32' N. & both.

Plan Scale 1" = 40'
Profile Scale 1" = 40' Horz.
1" = 5' Vert.

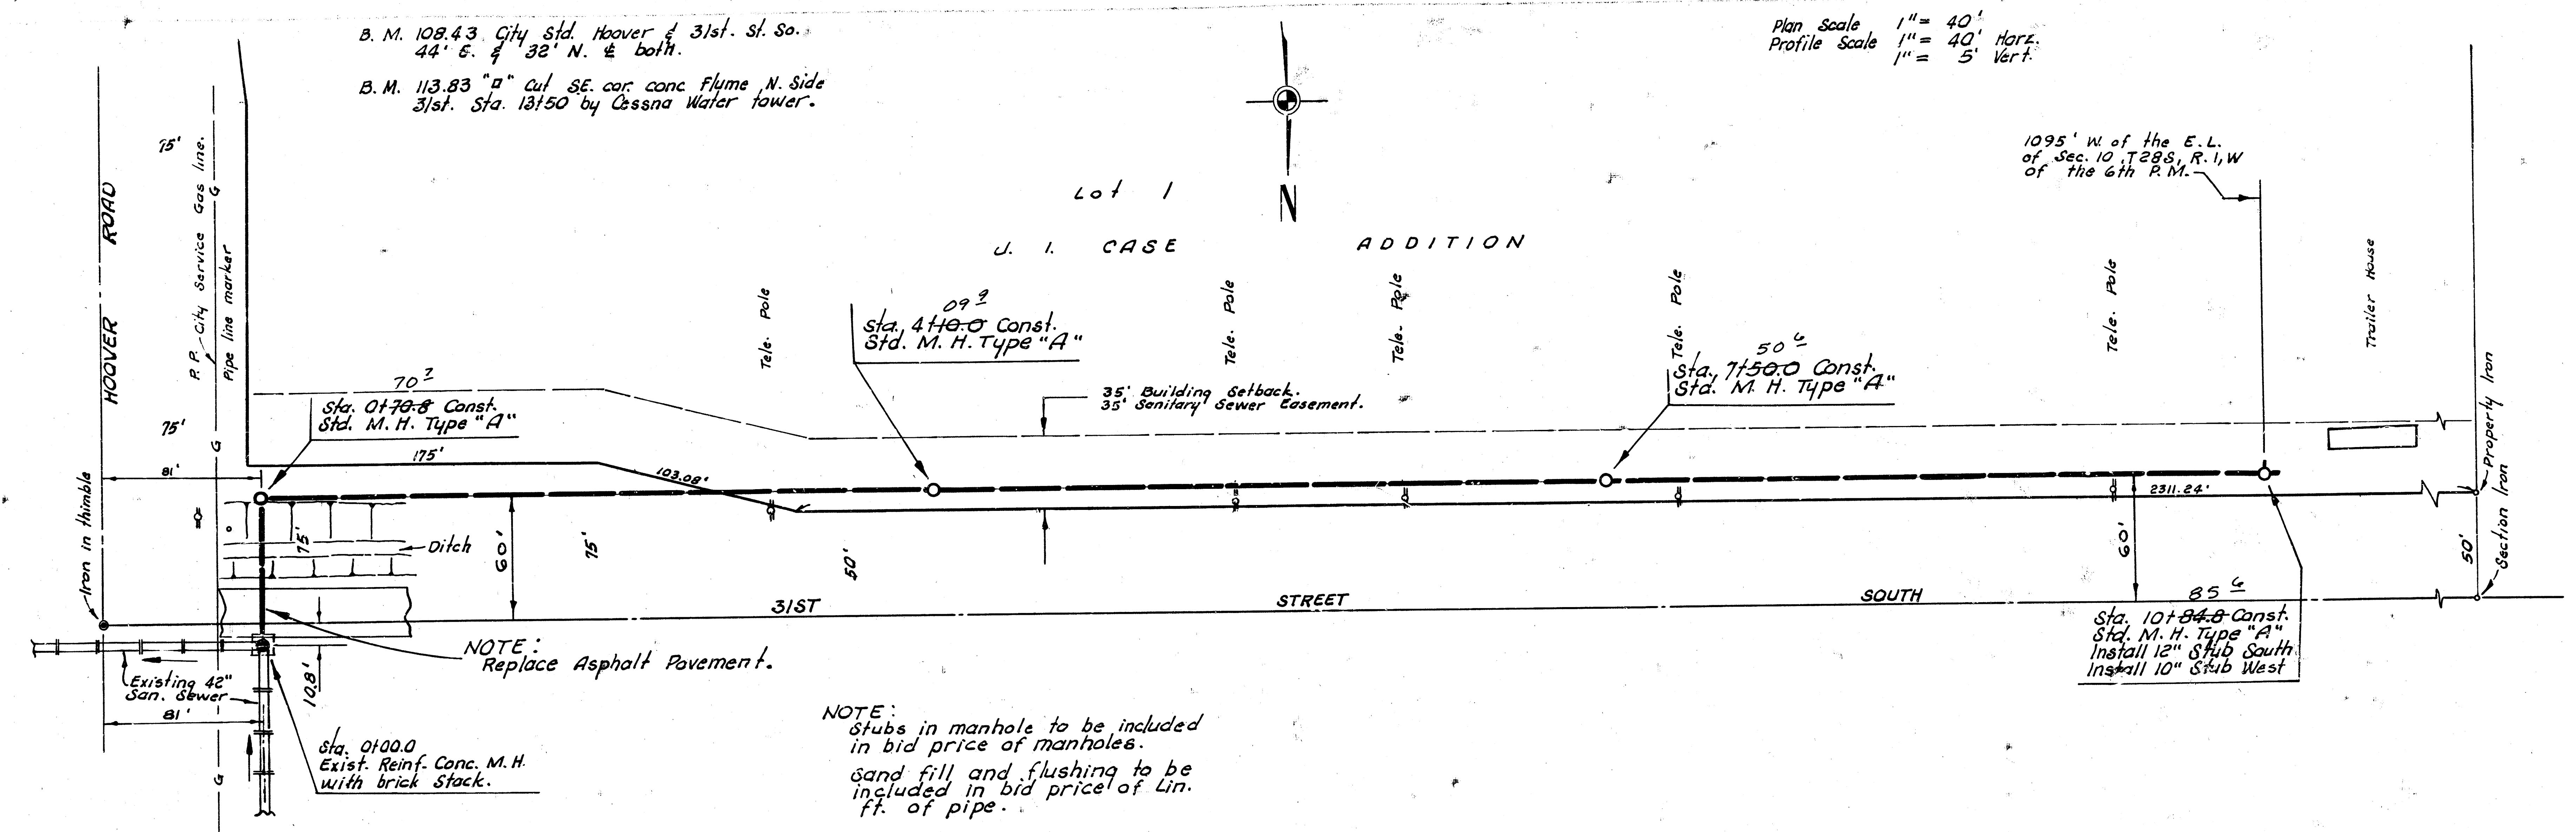


NOTE:
Replace Asphalt Pavement.

NOTE:
Stubs in manhole to be included
in bid price of manholes.
Sand fill and flushing to be
included in bid price of lin.
ft. of pipe.

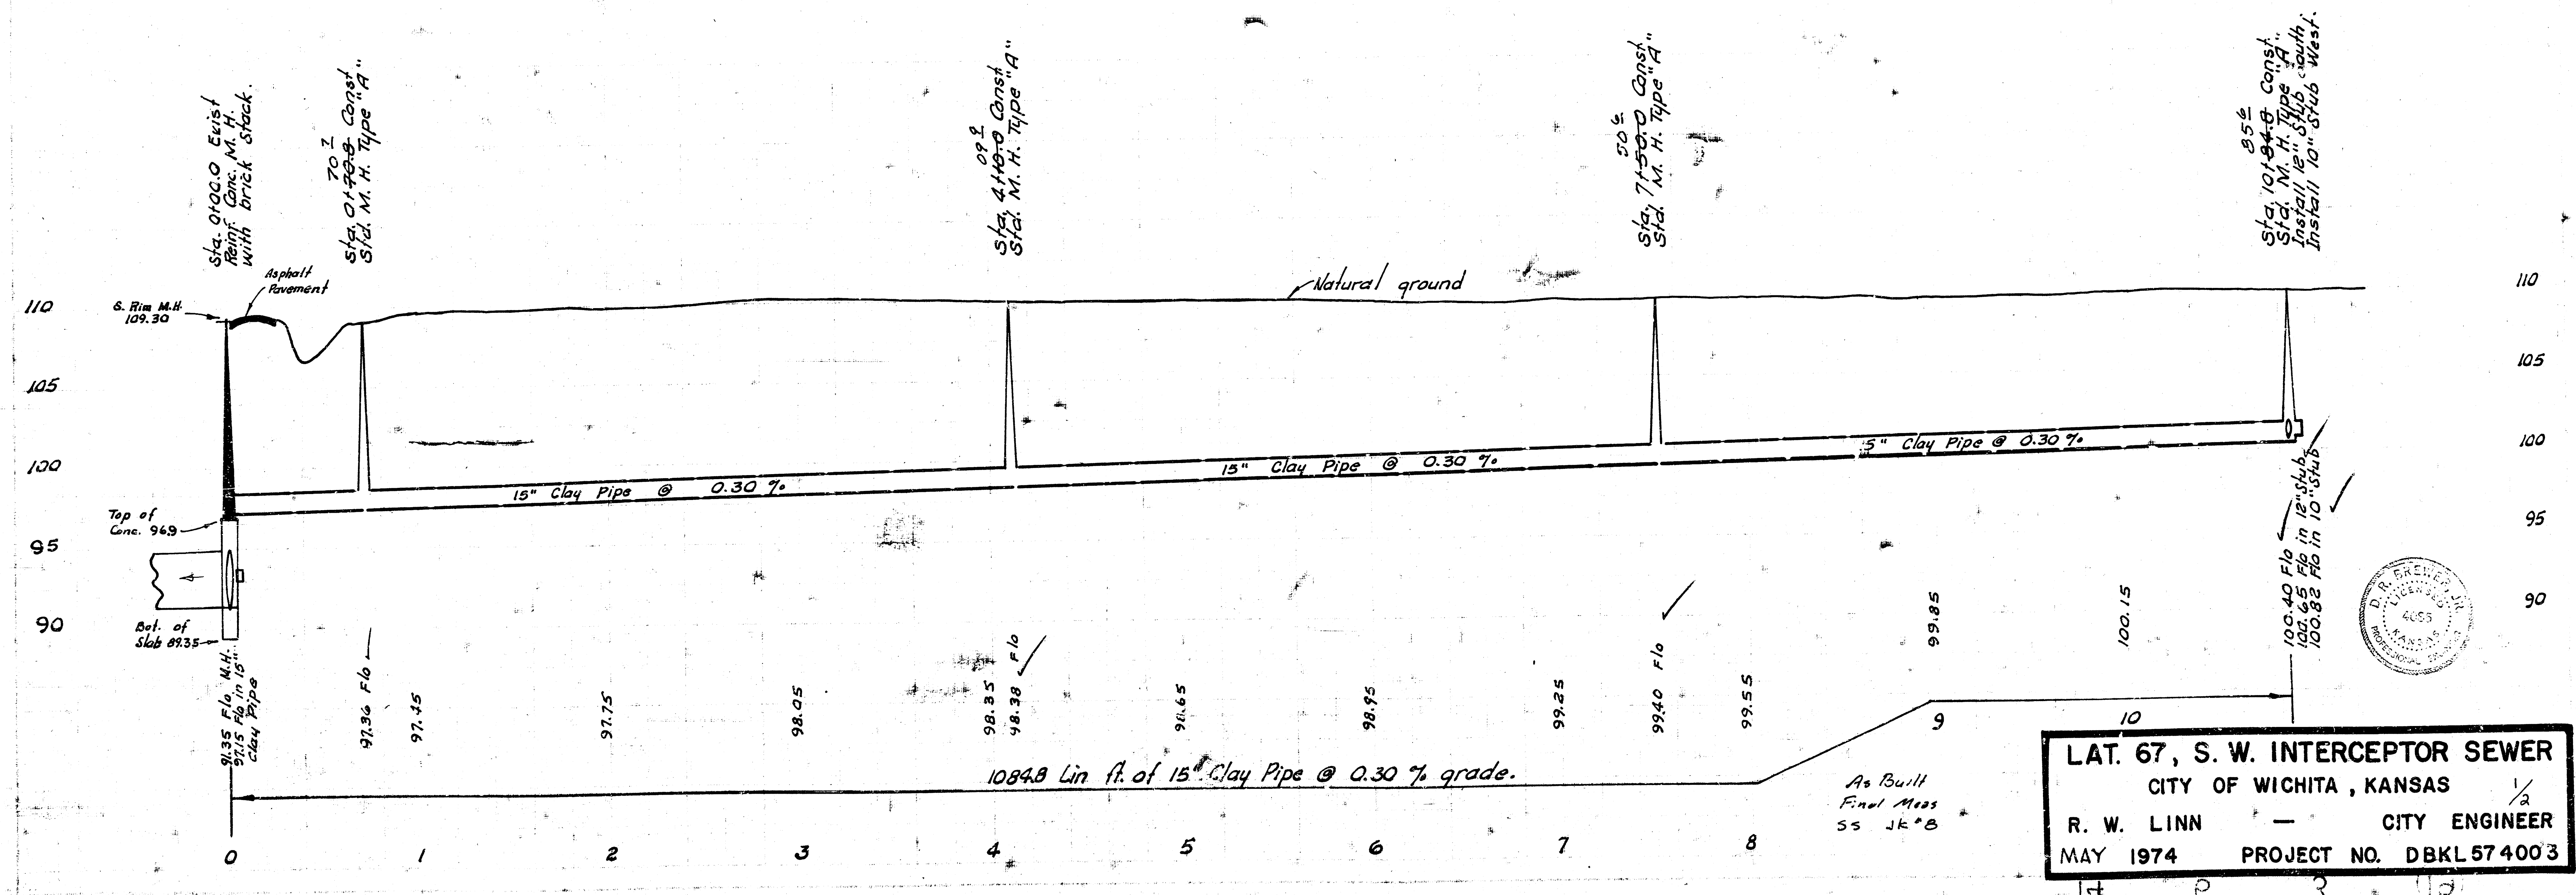

LAT. 67, S. W. INTERCEPTOR SEWER
CITY OF WICHITA, KANSAS
R. W. LINN — CITY ENGINEER
MAY 1974 PROJECT NO. DBKL 574003

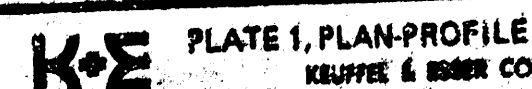

LAT. 67, S. W. INTERCEPTOR SEWER
CITY OF WICHITA, KANSAS
R. W. LINN — CITY ENGINEER
MAY 1974 PROJECT NO. DBKL 57 4003