
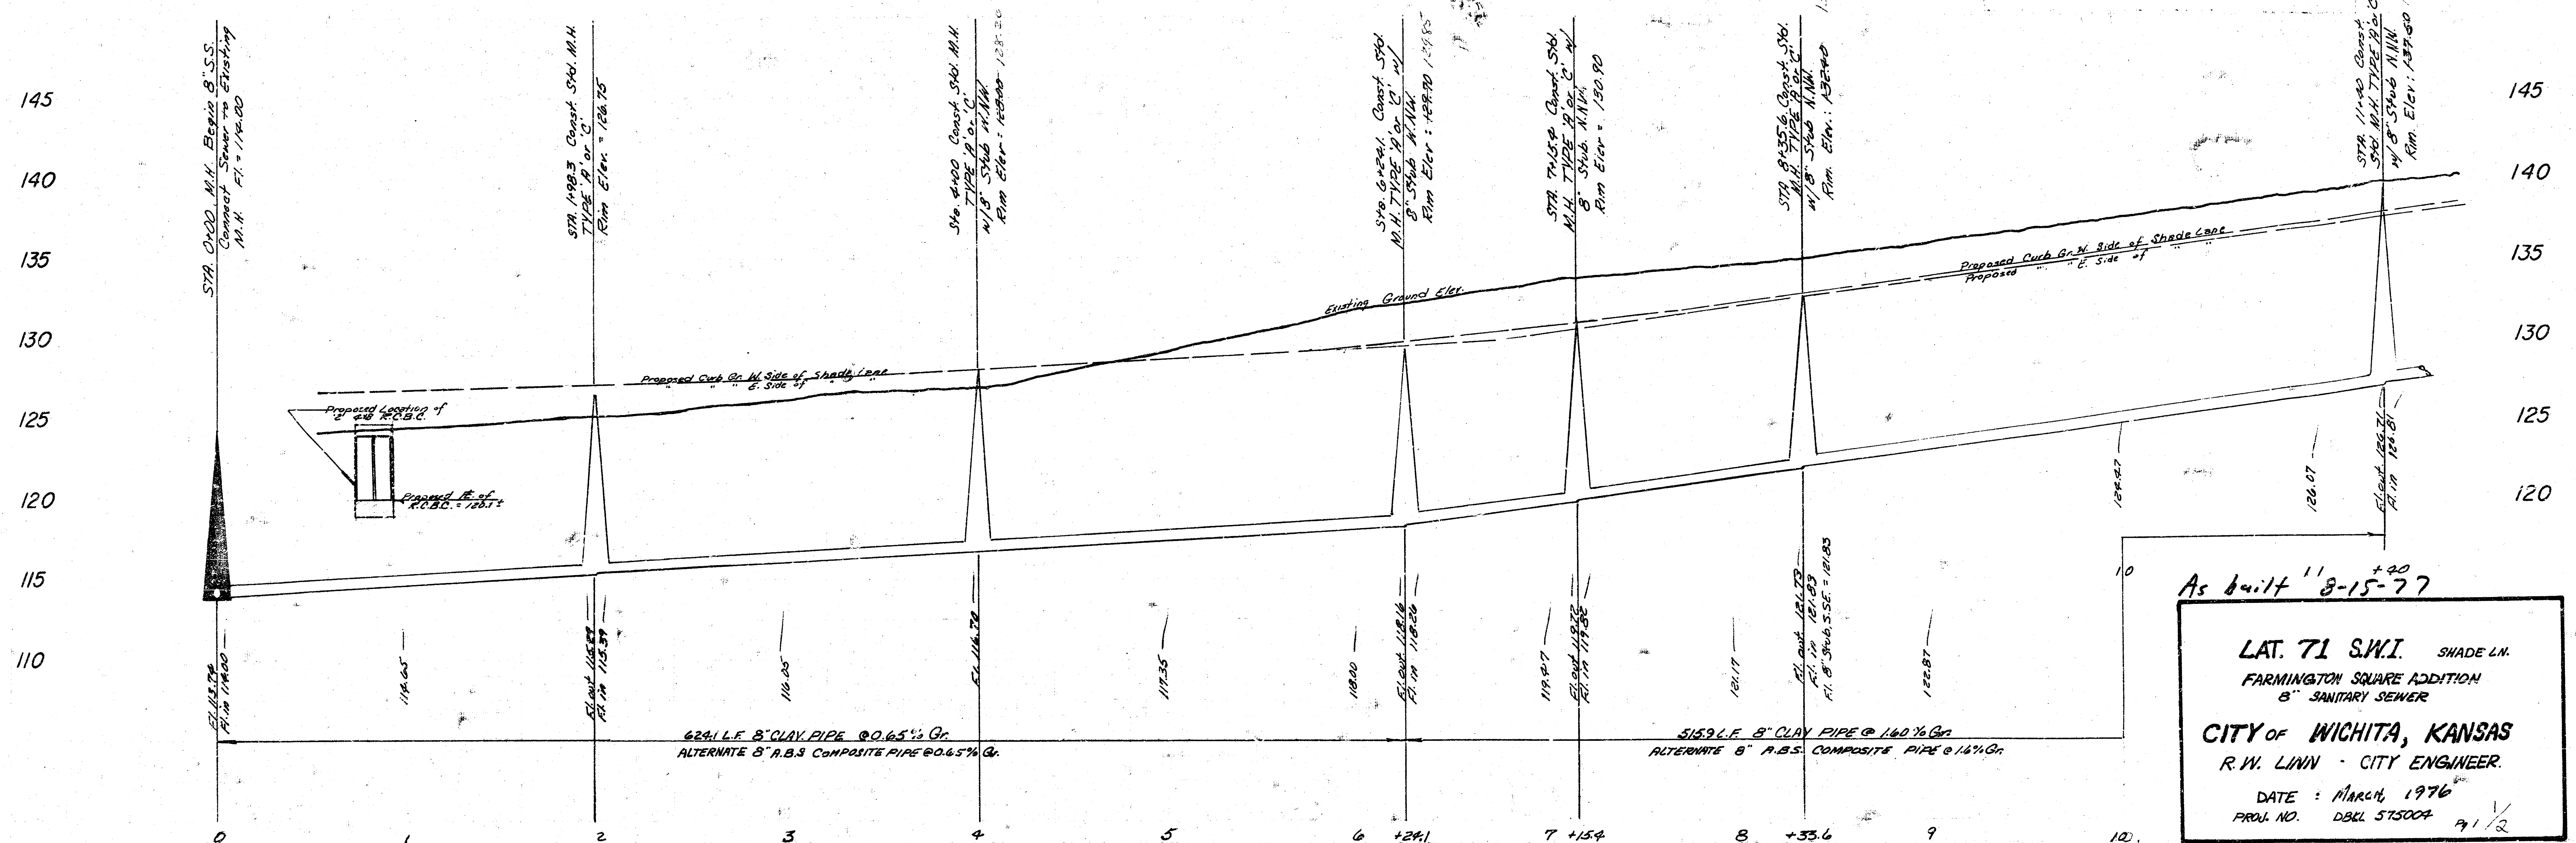
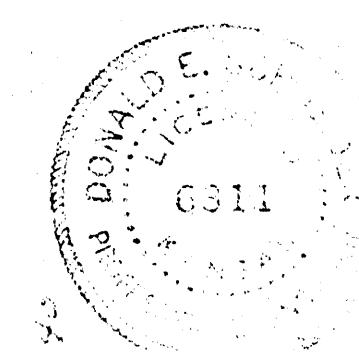



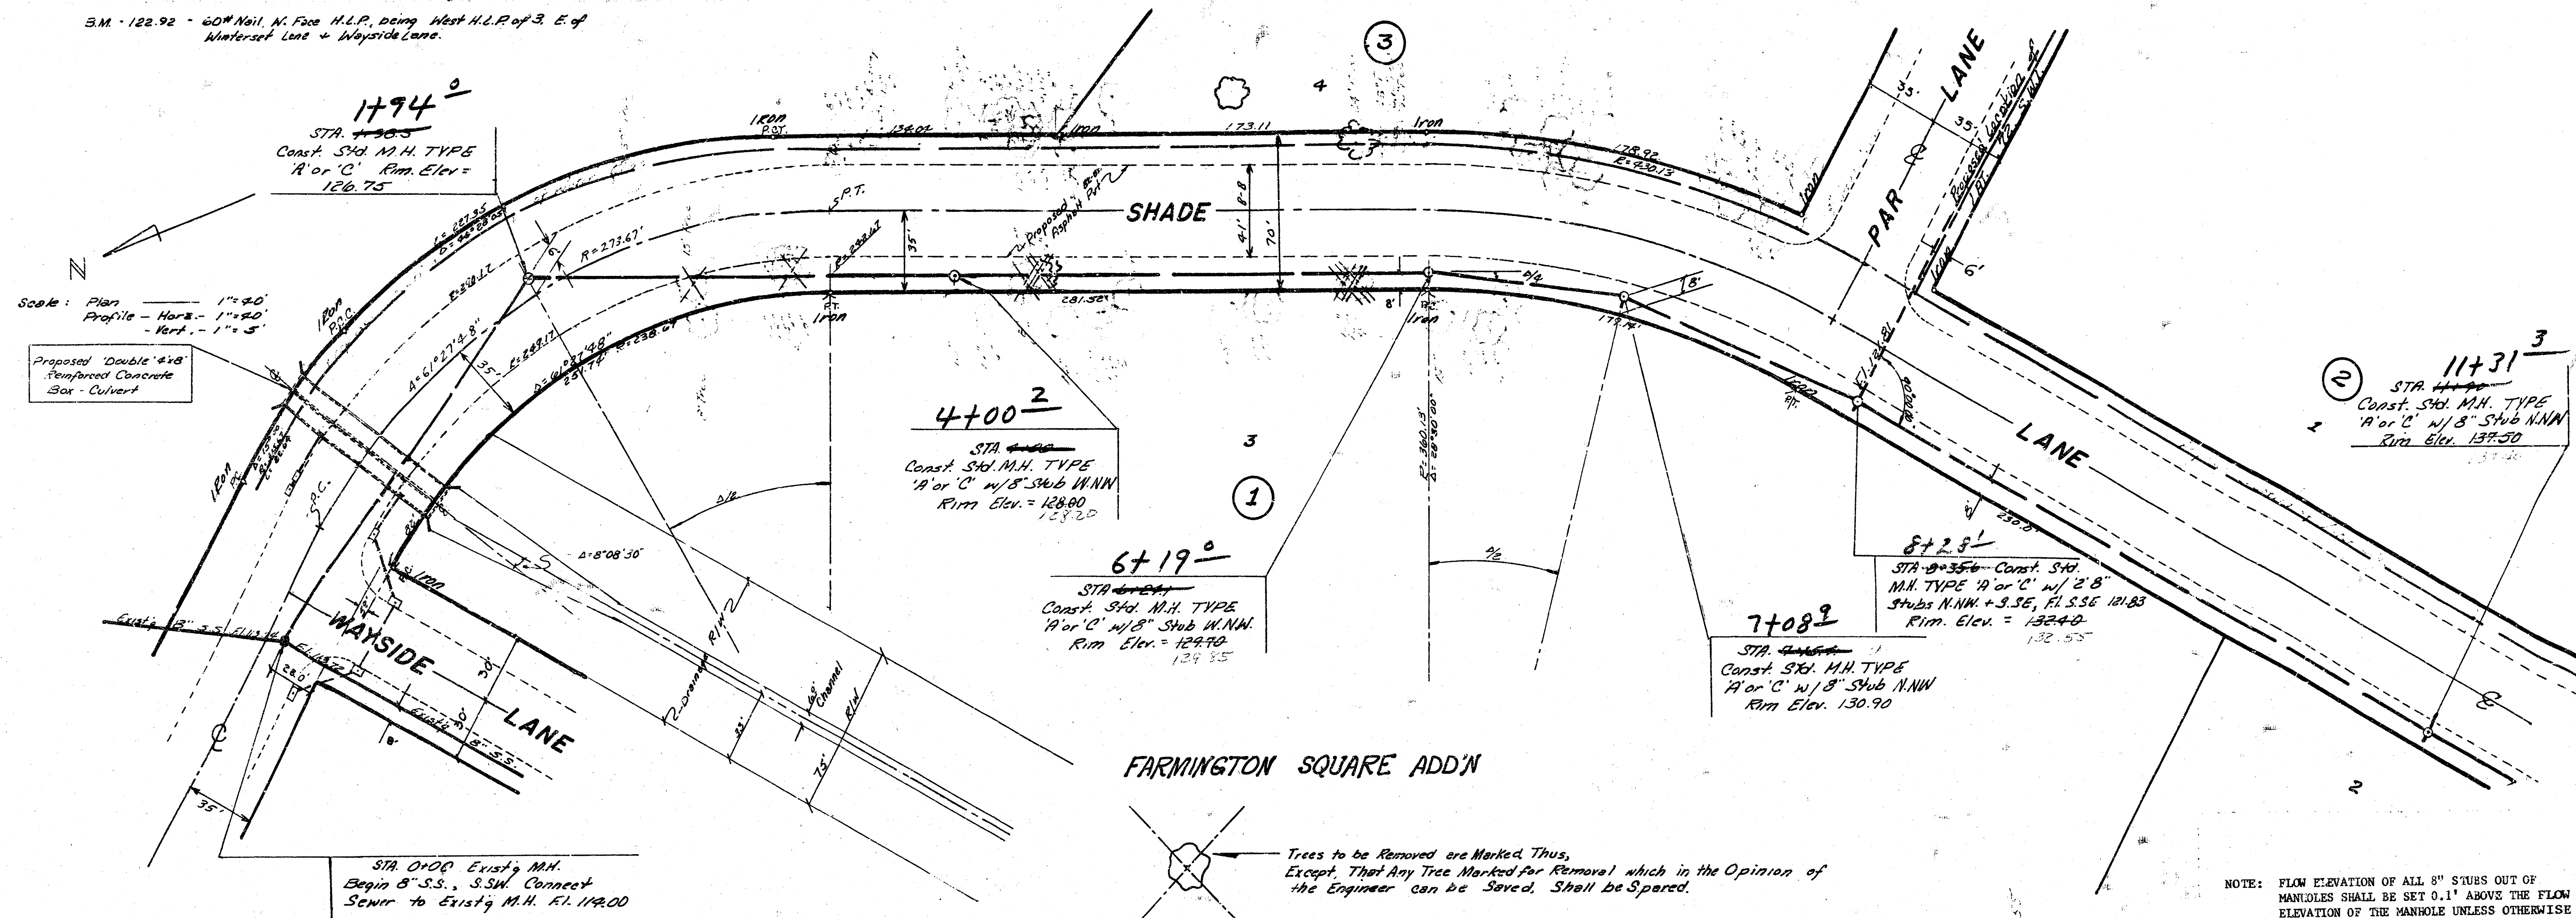

B.M. 144.96 - City Std. NW Corner of Ridge Rd. & 2nd St.
39.5' N. & 48.0' W.

SCALE:
PLAN: 1" = 40'
PROFILE: Vert. 1" = 5'
Horiz. 1" = 40'

11+31³
M.H. STA. 11+31³
see Sheet No. 1 for
Spec.

14+50¹
STA. 14+50¹
Const. Std. M.H.
TYPE 'A' or 'C' w/ 8" Stub
NNW. Rim Elev. = 142.55

17+84⁸
STA. 17+84⁸ and LAT 71
Const. Std. M.H. TYPE
'B' or 'C' w/ 2-8" Stubs S.E. & W.S.W.
Rim Elev. = 147.50







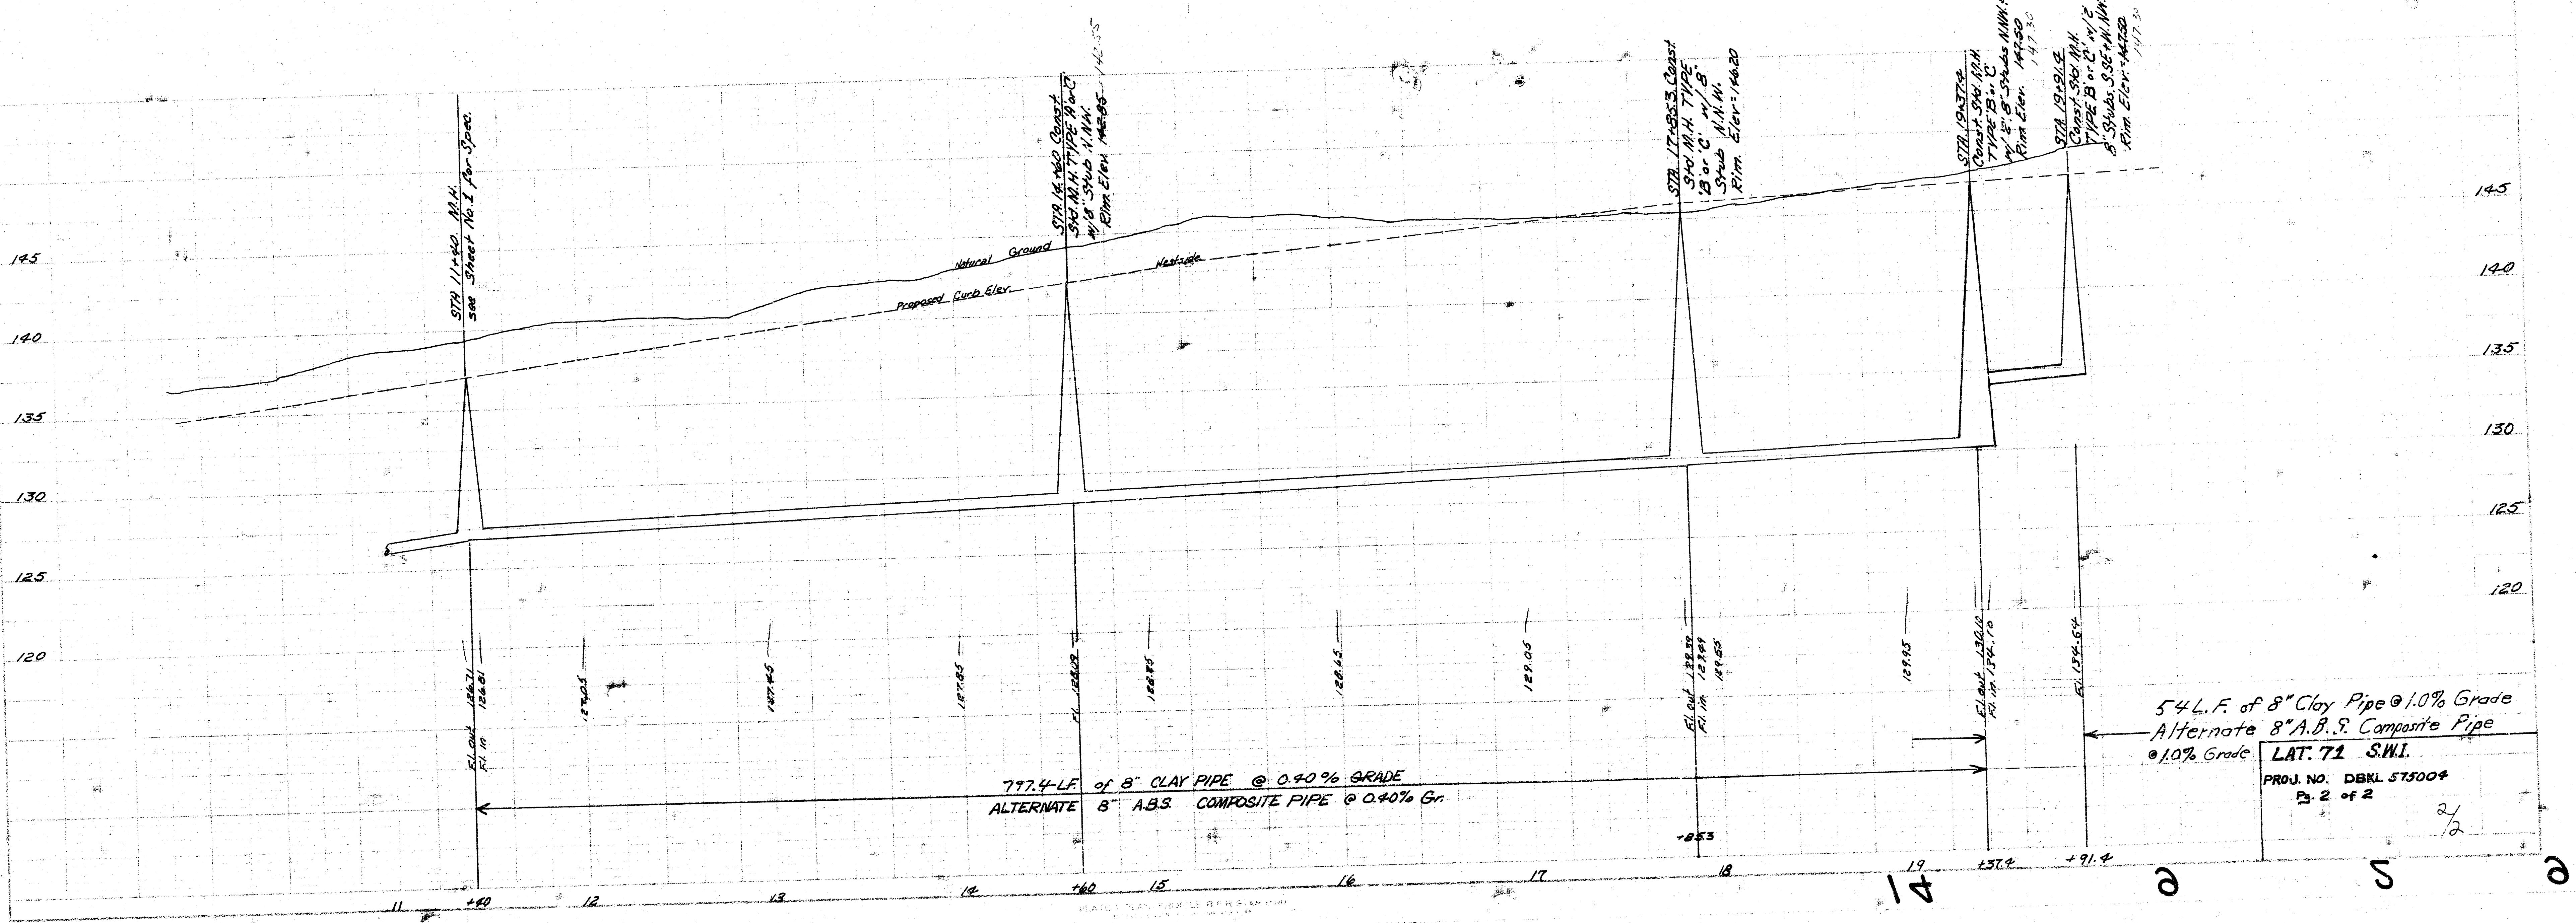

ALTERNATE 8" A.B.S. COMPOSITE PIPE @ 0.40% G.

54 L.F. of 8" Clay Pipe @ 1.0% Grade
Alternate 8" A.B.S. Composite Pipe
@ 1.0% Grade

LAT. 71 S.W.L.
PROJ. NO. DEKL 575004
Pg. 2 of 2