
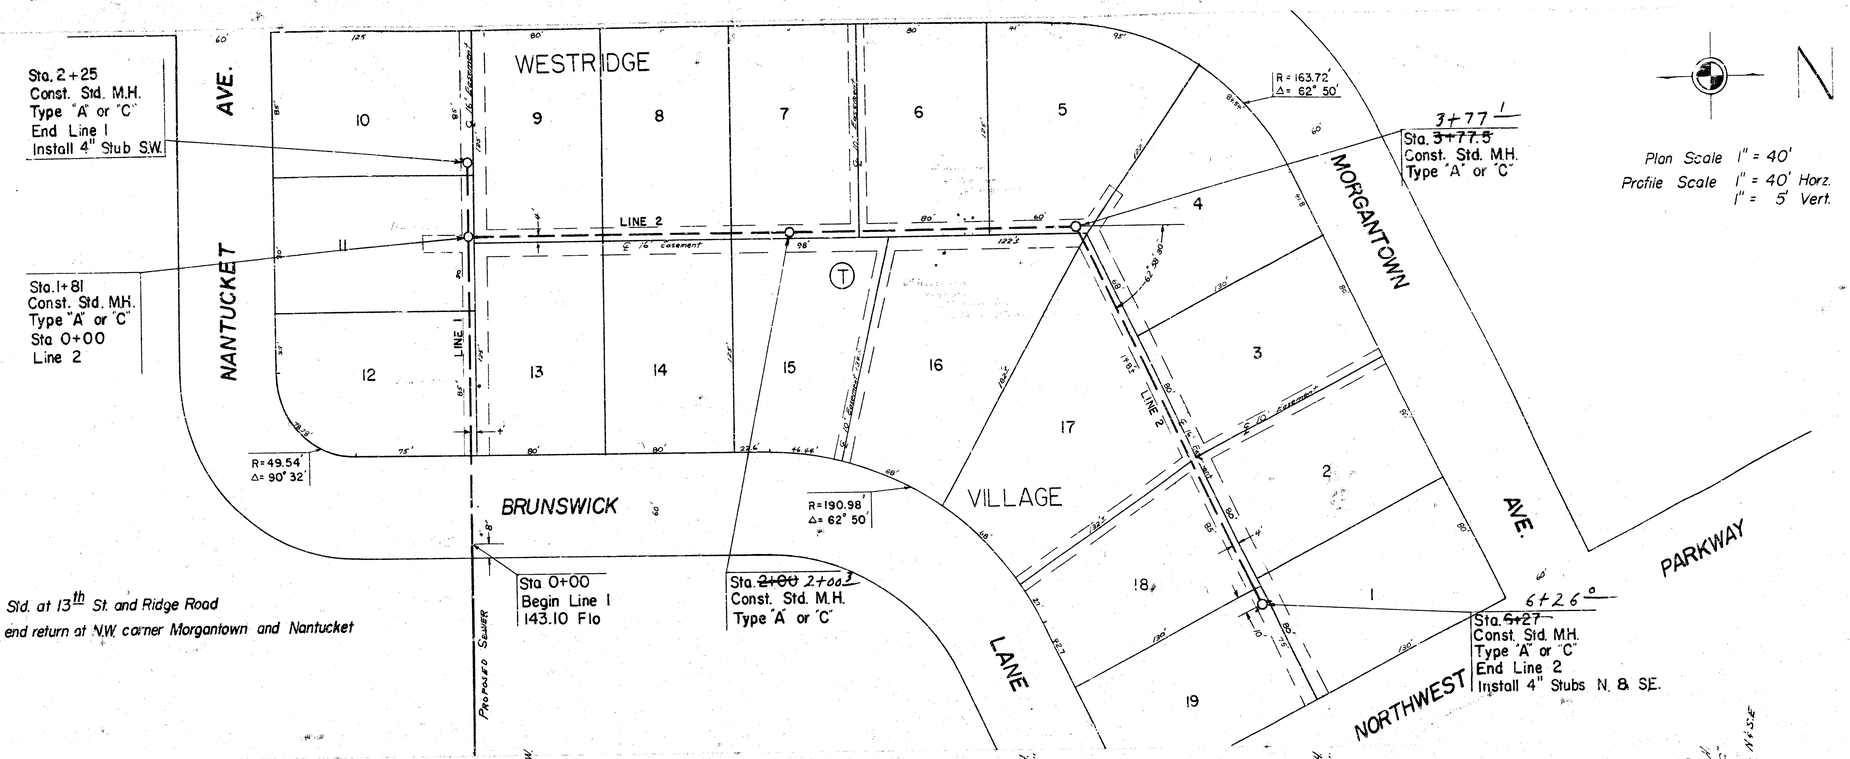


BM = 148.10 Wichita City Std. at 13th St. and Ridge Road

BM = 150.27 "+" at West end return at N.W. corner Morgantown and Nantucket

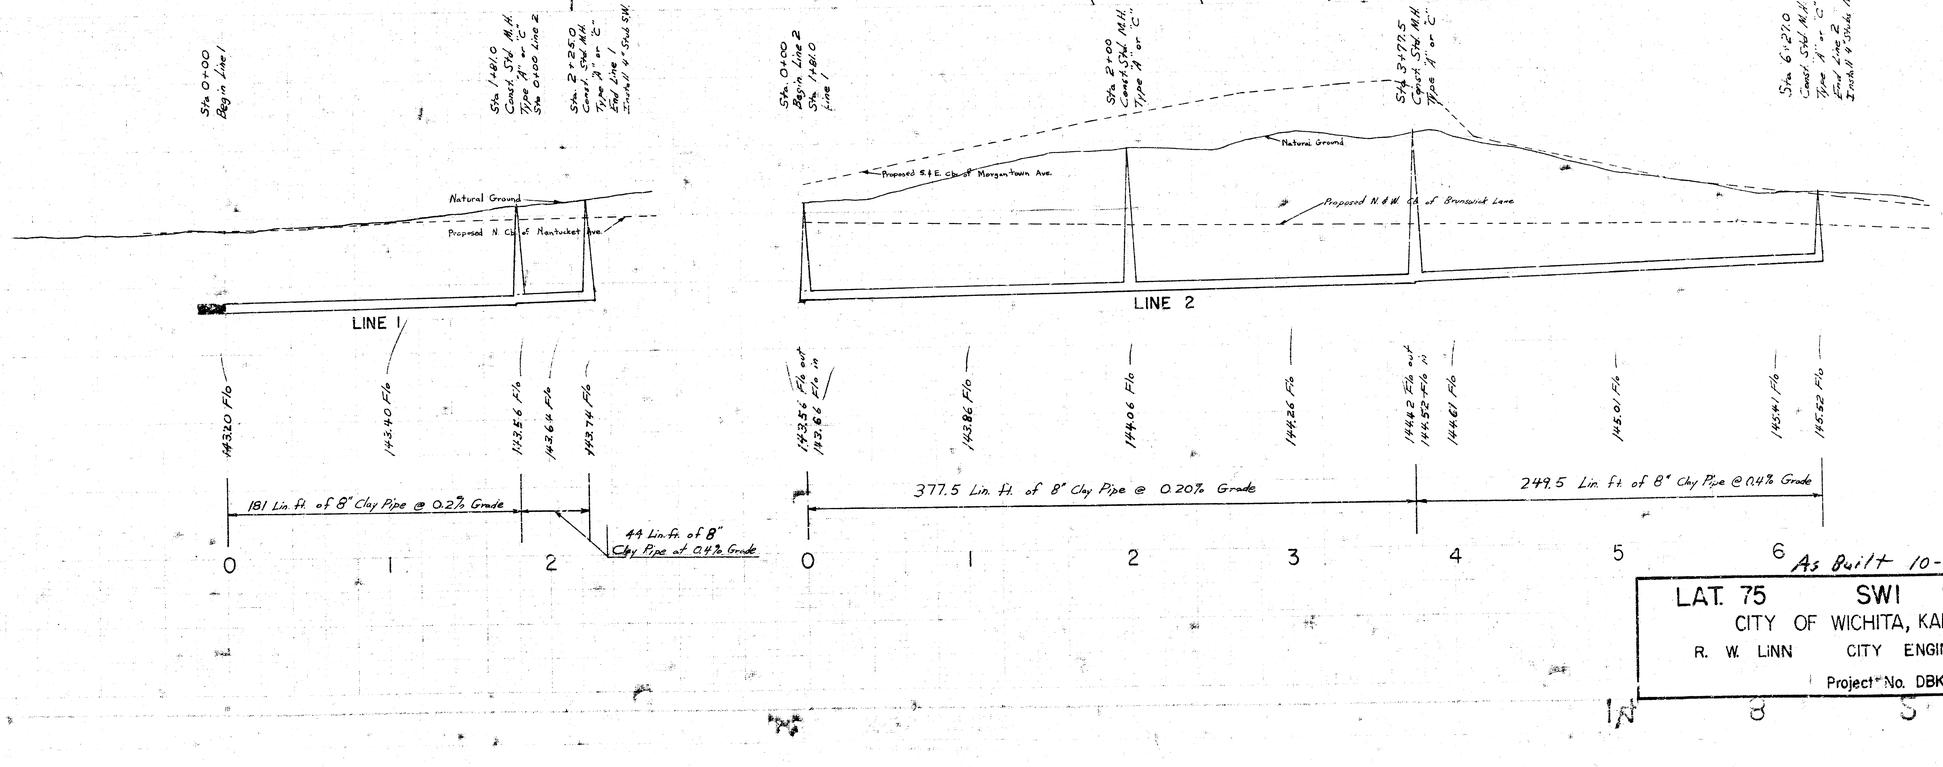

As Built 10-15-75

LAT. 75 SWI SEWER
CITY OF WICHITA, KANSAS
R. W. LINN CITY ENGINEER
Project No. DBKL575041