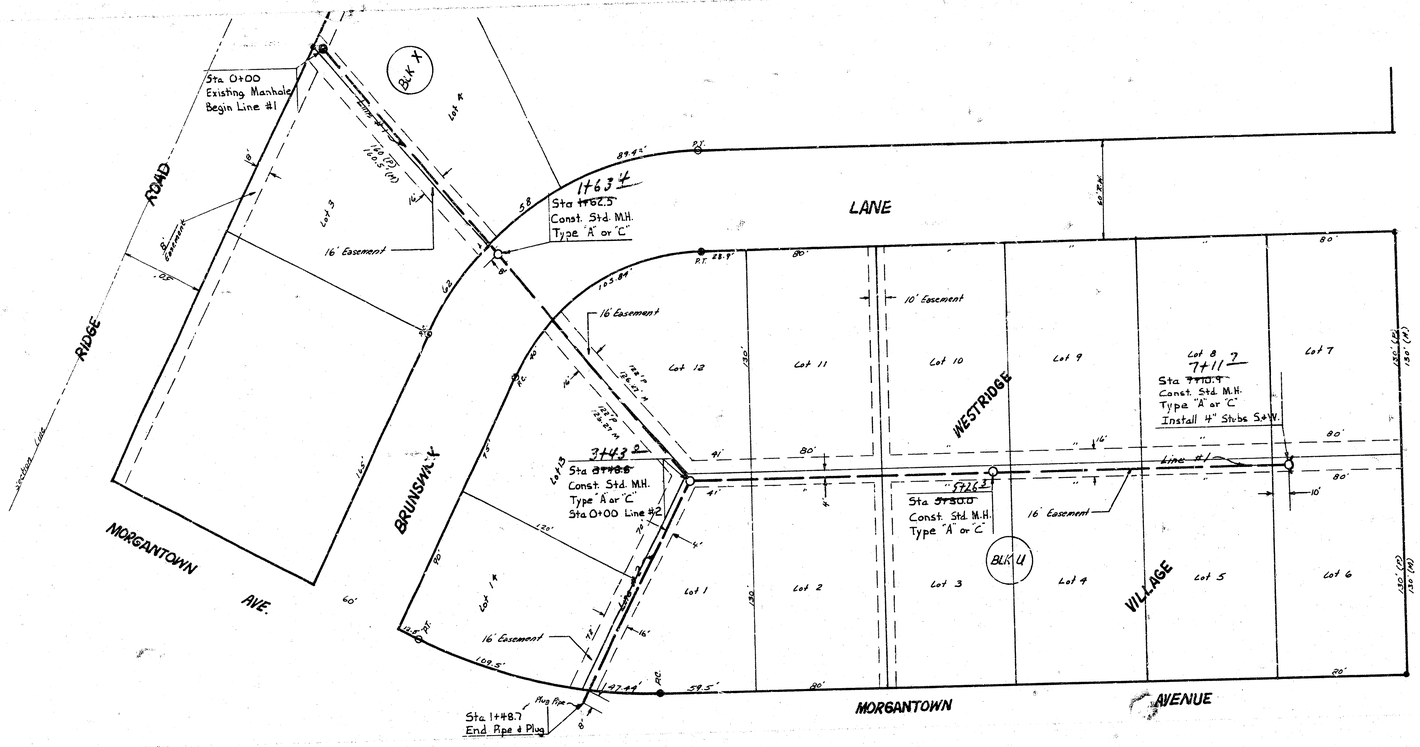



B.M. - 156.19 - CITY B.M. DISC, 4.23' E. + 4.9' N. of 1/4 SEC. CORNER at 13TH. STREET & WOODCHUCK.


B.M. - 150.27 - 'X' at Westend of RETURN, N.W. CORNER of MORGANTOWN and NANTUCKET

B.M. - 137.55 - PK SPIKE in E.S. of P.P. 1.0' N. of ℄ of 13TH ST and 48' W. of ℄ of RIDGE ROAD

B.M. - 149.83 - 'X' on TOP of CURB at WESTEND of RADIUS, N.W. CORNER of 'NORTHWEST PARKWAY' and MORGANTOWN AVE.

SCALE : PLAN : 1" = 40'
PROFILE : HORIZONAL : 1" = 40'
VERTICAL : 1" = 5'

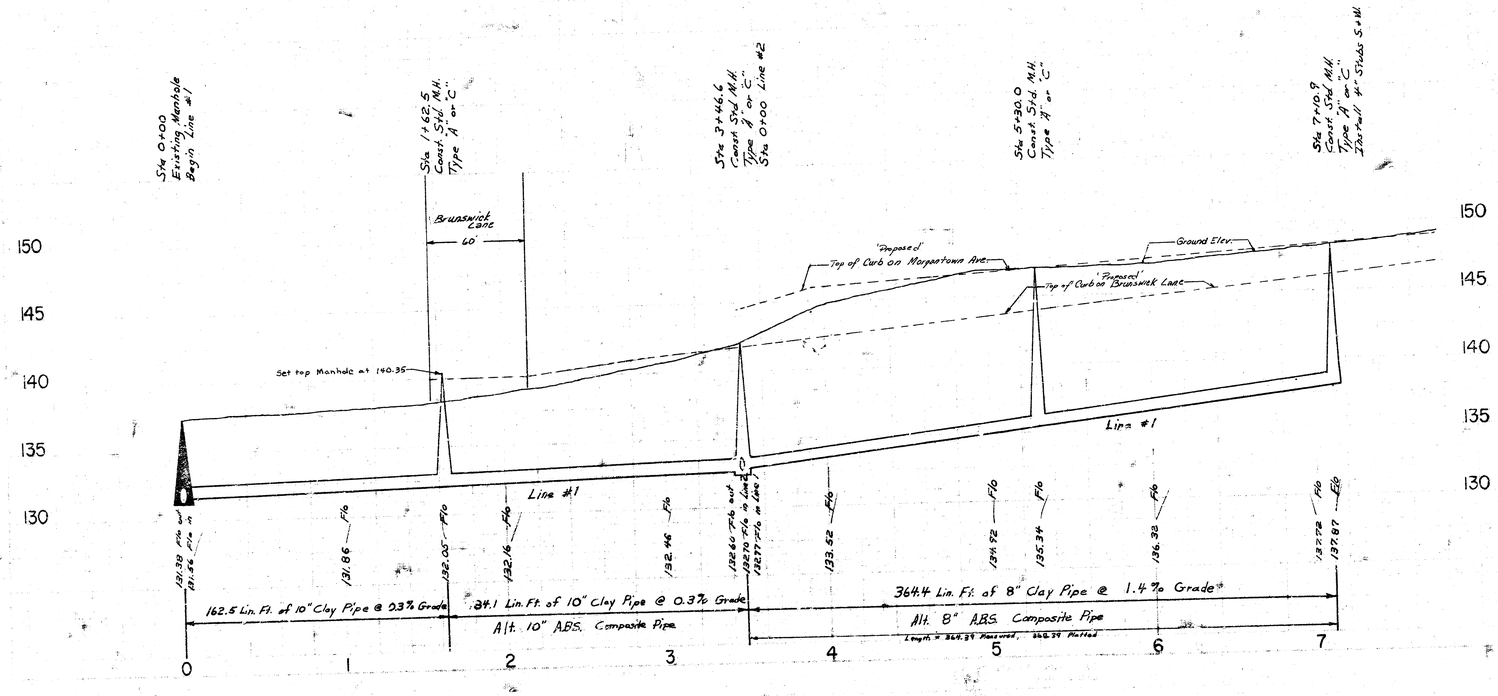

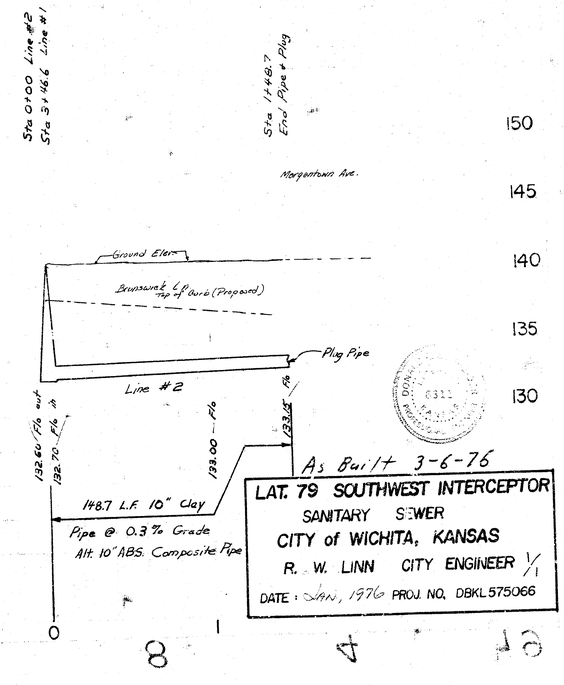

As Built 3-6-76

LAT. 79 SOUTHWEST INTERCEPTOR
SANITARY SEWER
CITY of WICHITA, KANSAS
R. W. LINN CITY ENGINEER
DATE : JAN., 1976 PROJ. NO. DBKL 575066

14 8 4 12