

BM. 137.54 R.R. spike N.E. corner power pole approx. 285' S. of S.L. Morgantown on W. Side Ridge Rd.

BM. 142.81 Ridge Rd. and 17th St. North: City of Wichita Bench mark disc 42' North and 38.5' East of 1/4 sec. corner.

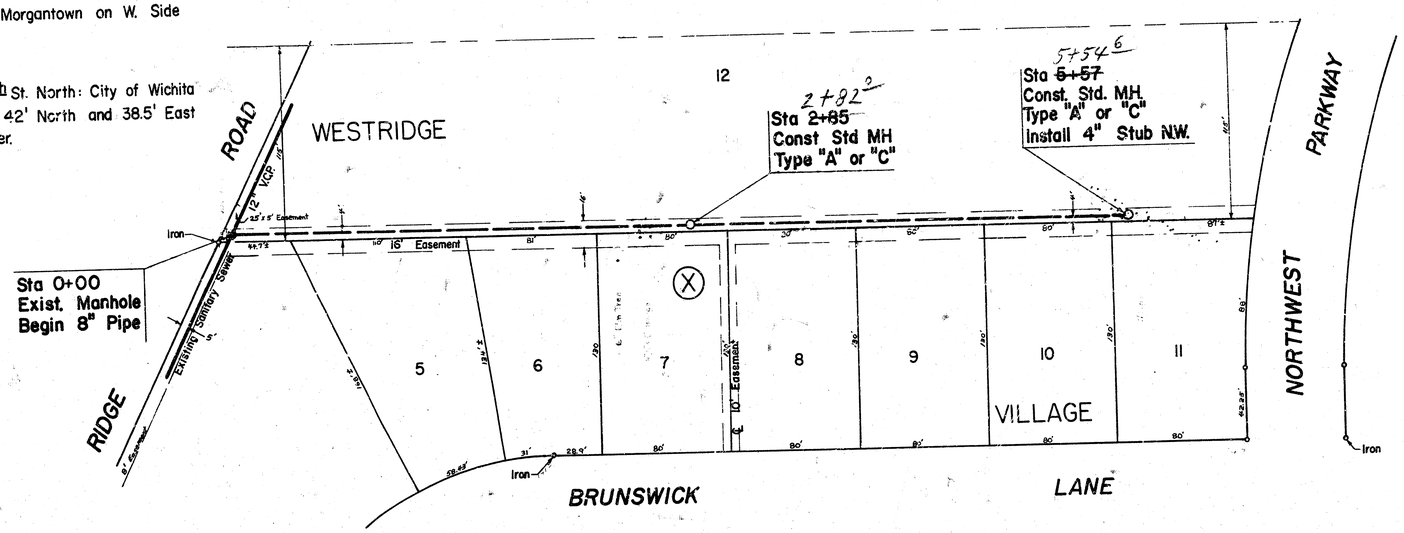

Plan Scale 1" = 40'
Profile Scale 1" = 40' Horz.
1" = 5' Vert.

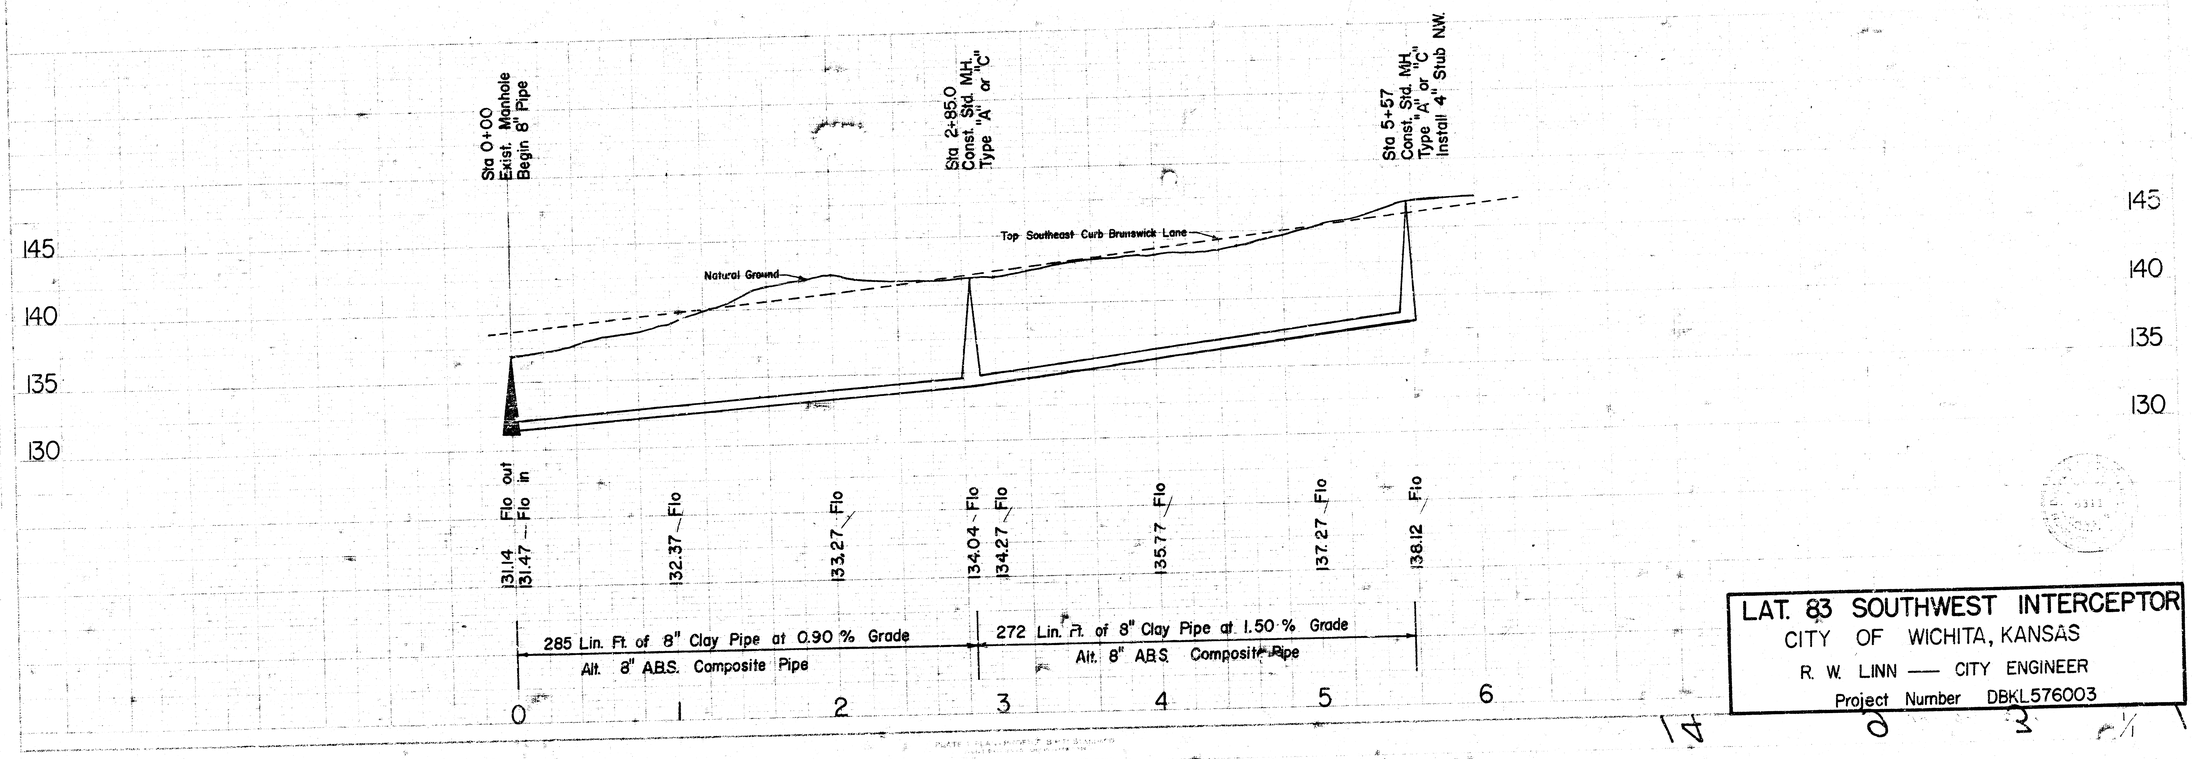

LAT. 83 SOUTHWEST INTERCEPTOR
CITY OF WICHITA, KANSAS
R. W. LINN — CITY ENGINEER
Project Number DBKL576003