
B.M. 157.04 R.R. Spike N. face Power Pole approx. 200' S. and 100' W. of NW. corner Nantucket and Park.


B.M. 156.63 R.R. Spike N. face Power Pole approx. 90' W. and 20' S. of NW. corner 13th and Parkdale.


Plan Scale: 1"=40'
Profile Scale: 1"=40' Horz.
1"= 5' Vert.

NOTE: PIPE BETWEEN STATION 0 + 00 AND STATION 1 + 71 ON THIS PROJECT SHALL BE SAME TYPE OF PIPE AS THAT WHICH IS TO BE INSTALLED BY CONTRACTOR FOR CONSTRUCTING LATERAL 111, SOUTHWEST INTERCEPTOR.

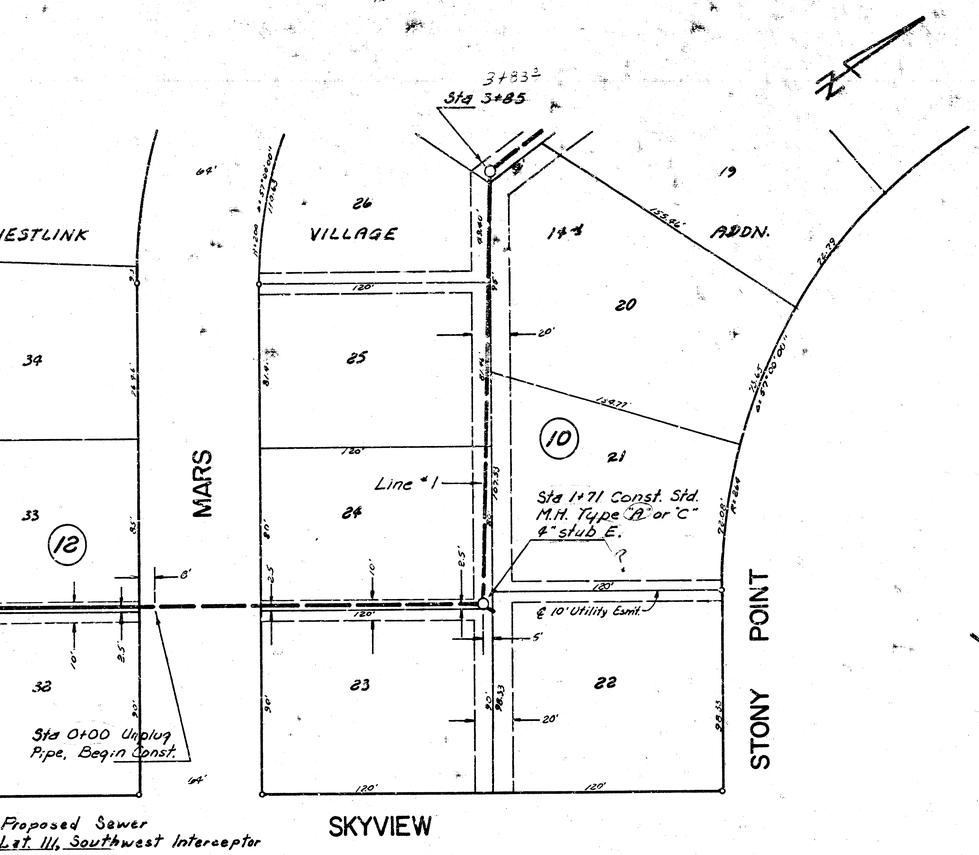

Proposed Sewer
Lat 111, Southwest Interceptor

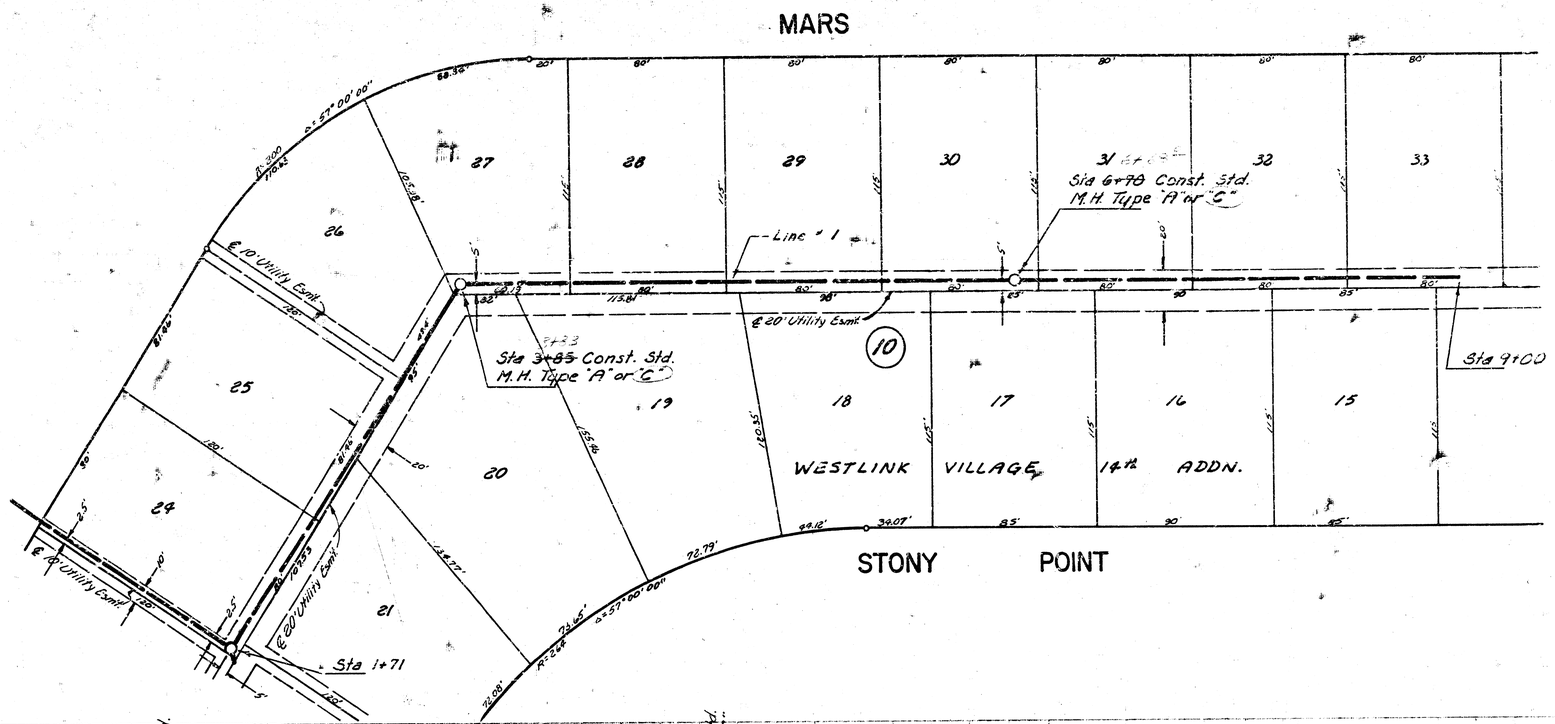

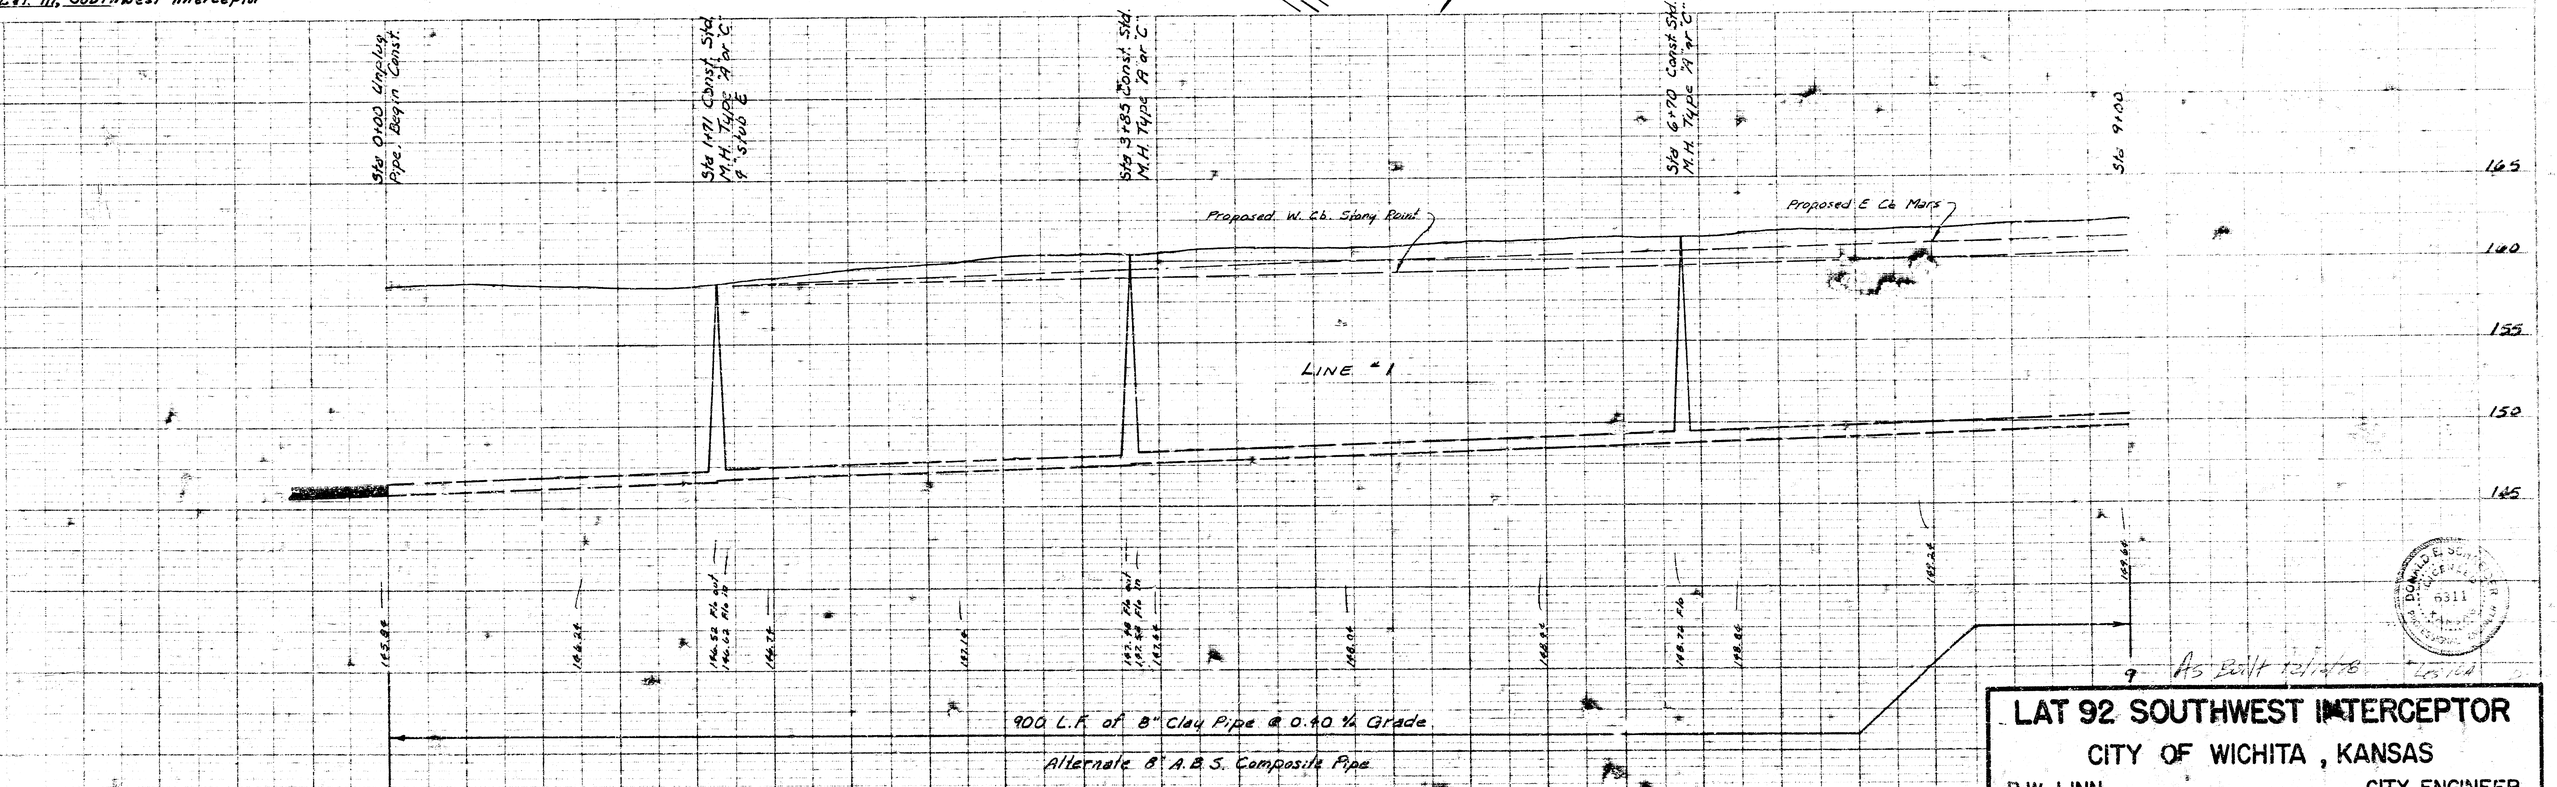

As Built 10/14/76

LAT 92 SOUTHWEST INTERCEPTOR

CITY OF WICHITA, KANSAS

R.W. LINN — CITY ENGINEER

PROJECT NUMBER: 468-76-245-80352-000-000-001

Plan Scale: 1" = 40'
Profile Scale: 1" = 4'

