Plan Scale: 1" = 40'
Profile Scale: 1" = 40' Horiz.
1" = 5' Vert.

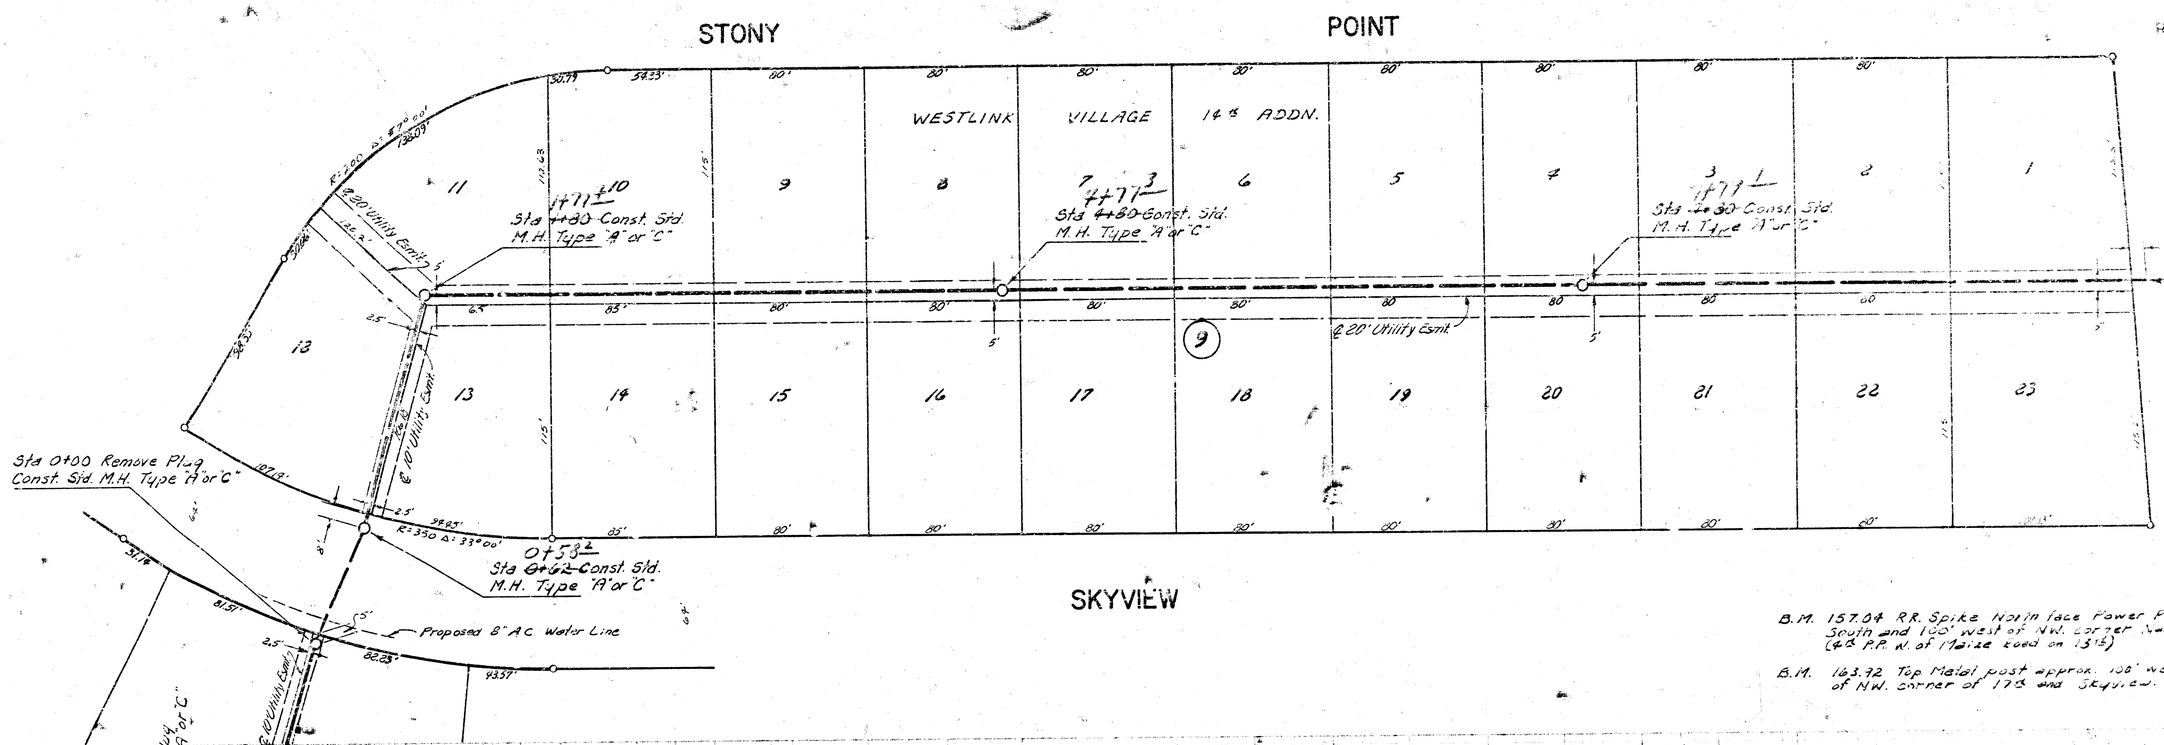

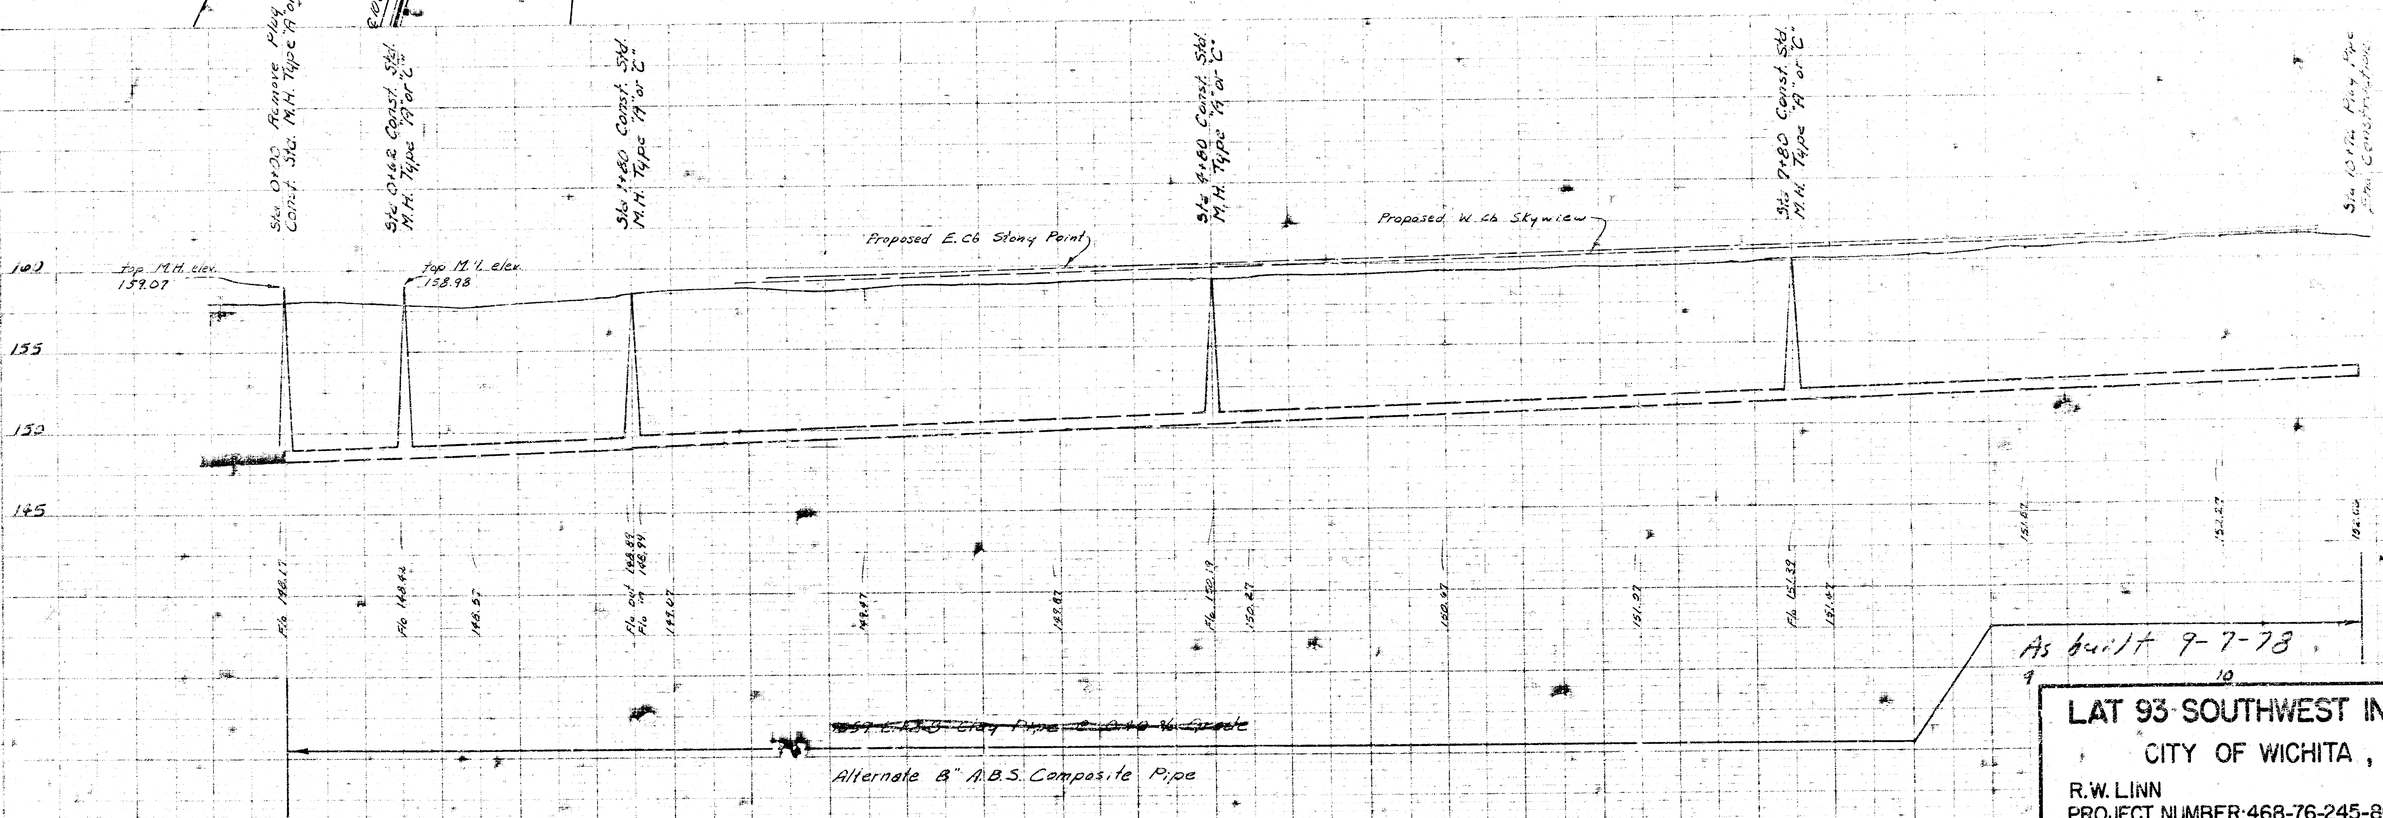

LAT 93 SOUTHWEST INTERCEPTOR
CITY OF WICHITA, KANSAS
R.W. LINN CITY ENGINEER
PROJECT NUMBER: 468-76-245-80353-000-000-001