

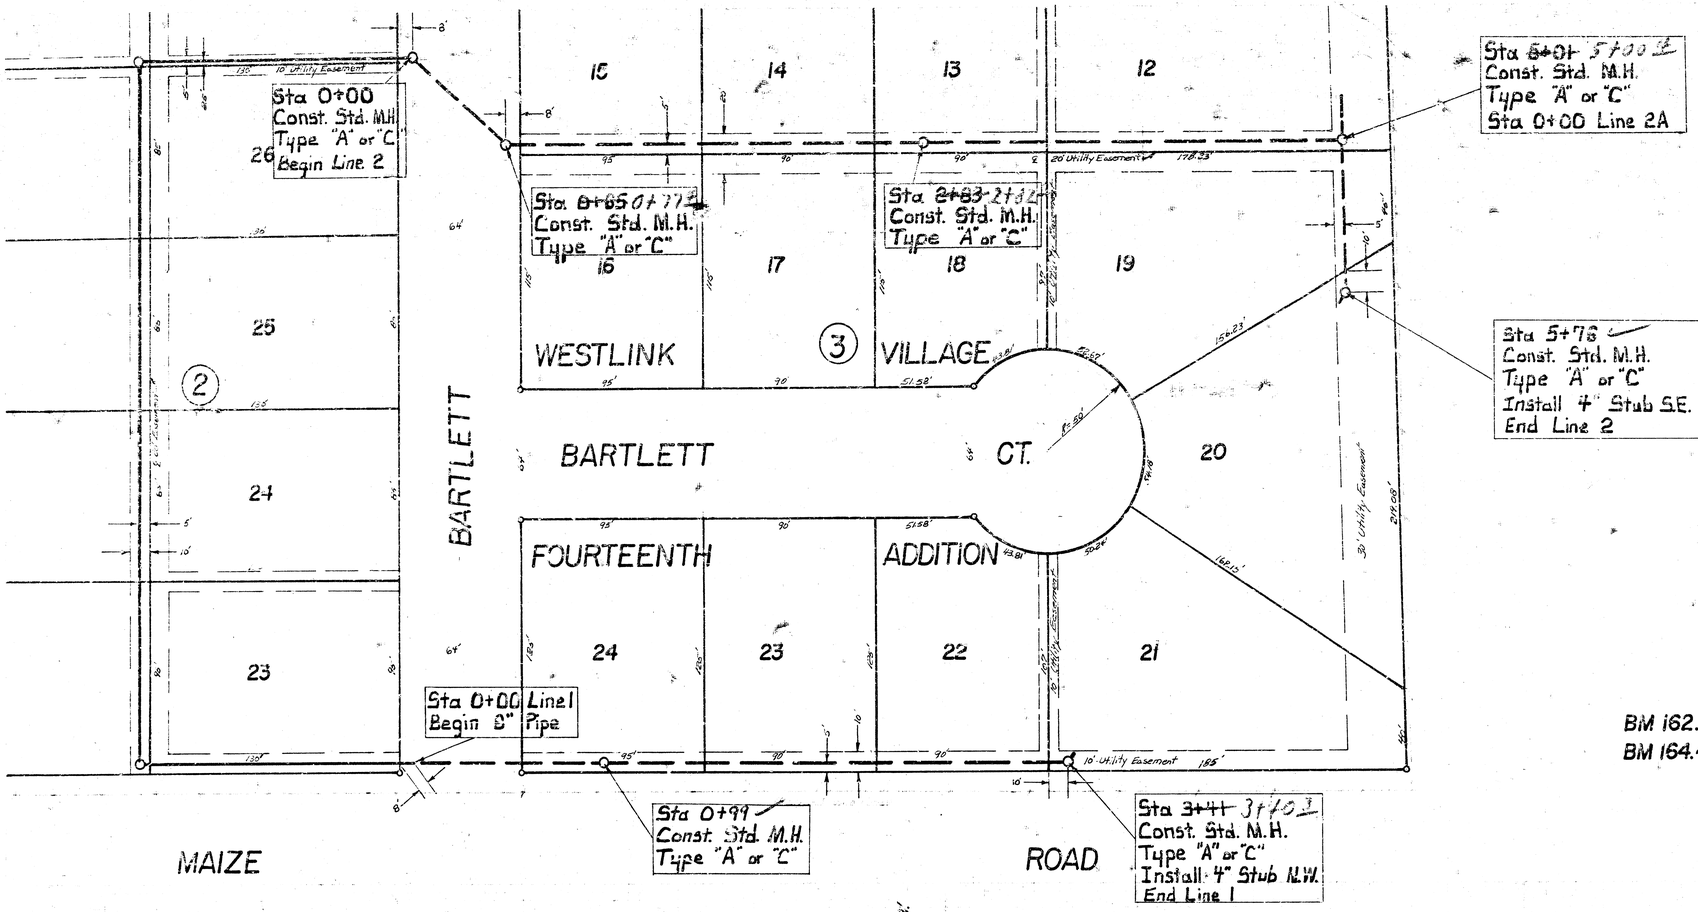


Plan Scale 1" = 40'
Profile Scale 1" = 40'
1" = 5'

NOTE: PIPE FROM STATION 0 + 00.00 TO 0 + 27.00 ON LINE NO. 1 AND FROM STATION 0 + 00.00 TO 0 + 15.00 ON LINE NO. 3 SHALL BE SAME TYPE OF PIPE AS PIPE SOUTH OF STATION 0 + 00 WHICH IS TO BE INSTALLED BY THE CONTRACTOR FOR LATERAL 108, SOUTHWEST INTERCEPTOR.

BM 162.11 R.R. Spike W. fc. P.P. N.W. cor. Maize Rd. & Bartlett
BM 164.49 R.R. Spike W. fc. P.P. S.W. cor. 17th & Maize Rd.

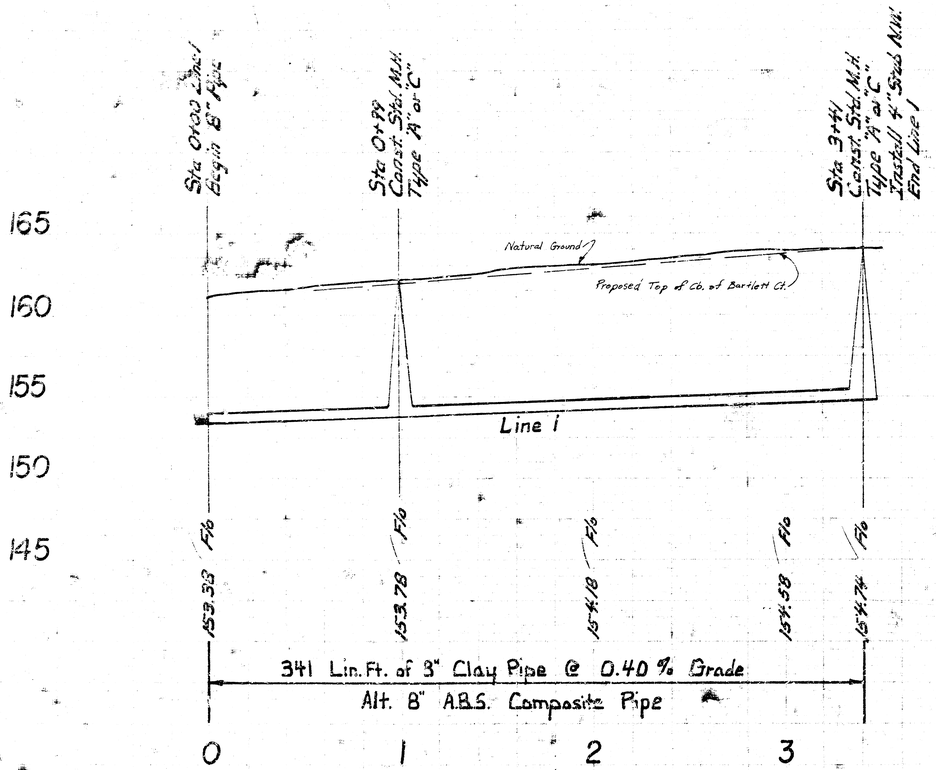

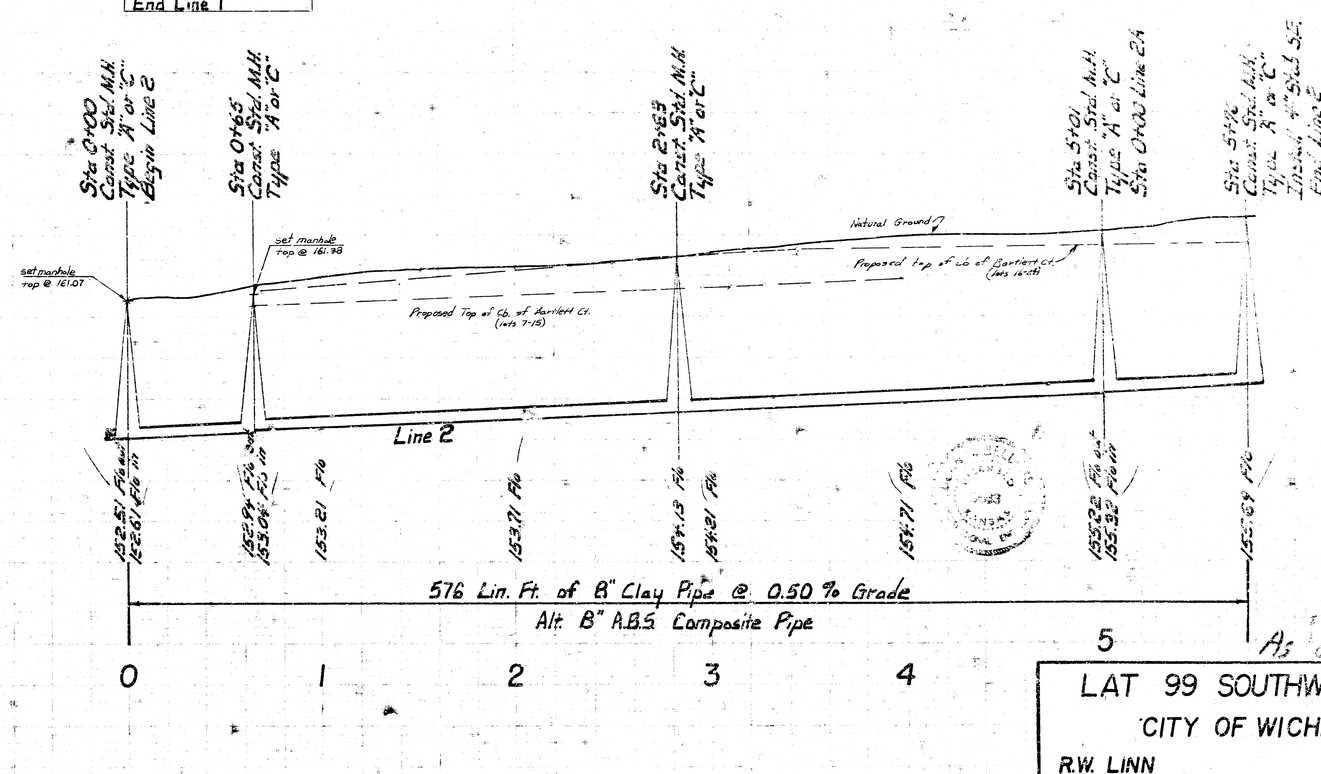

As Built 2-22-

LAT 99 SOUTHWEST INTERCEPT
CITY OF WICHITA, KANSAS
R.W. LINN — CITY ENGI
DATE: — PROJECT NUMBER DRKI 5770

Plan Scale 1"= 40'
Profile Scale 1"= 40'
1"= 5'

Sta 0+00 Line 3
Begin 8" Pipe

Sta 0+69
Const. Std. M.H.
Type "A" or "C"

Sta 2+43
Const. Std. M.H.
Type "A" or "C"

Sta 4+78
Const. Std. M.H.
Type "A" or "C"

Sta 0+69
Const. Std. M.H.
Type "A" or "C"
Install 4" Stub SW.
End Line 2A

Sta 0+00 Line 2A
Sta 5+01 Line 2

Sta 7+86
Const. Std. M.H.
Type "A" or "C"
Install 4" Stub SW.
End Line 3

WESTLINK
VILLAGE
BARTLETT
CT.
FOURTEENTH
ADDITION
17TH

Line 3
Line 2
Line 2A

10' Utility Easement
30' Utility Easement

Sta 0+00 Line 2A
Sta 5+01 Line 2
Sta 0+69
Const. Std. M.H.
Type "A" or "C"
Install 4" Stub SW.
End Line 2A

69 Lin. Ft. of 8" Clay Pipe @ 4% Grade
Alt. 8" A.B.S. Composite Pipe

Sta 0+00 Line 3
Begin 8" Pipe
Sta 0+48
Const. Std. M.H.
Type "A" or "C"
Sta 2+43
Const. Std. M.H.
Type "A" or "C"
Sta 4+78
Const. Std. M.H.
Type "A" or "C"
Sta 7+86
Const. Std. M.H.
Type "A" or "C"
Install 4" Stub SW.
End Line 3

Natural Ground
set top manhole @ 160.13
Proposed Top of Cb of Bartlett Ct.
Proposed Top of Cb at Lark

48 Lin. Ft. of 8" Clay Pipe @ 0.40 % Grade
Alt. 8" A.B.S. Composite Pipe

738 Lin. Ft. of 8" A.B.S. Composite Pipe @ 0.25% Grade

165
160
155
150
145

LAT 99 SOUTHWEST INTERCEPT