

BM 157.04 R.R. spike N. fc. P.P. approx. 200' S. & 100' W. of N.W. cor. Nantucket & Lark (4th P.P. W. Maize Rd.)

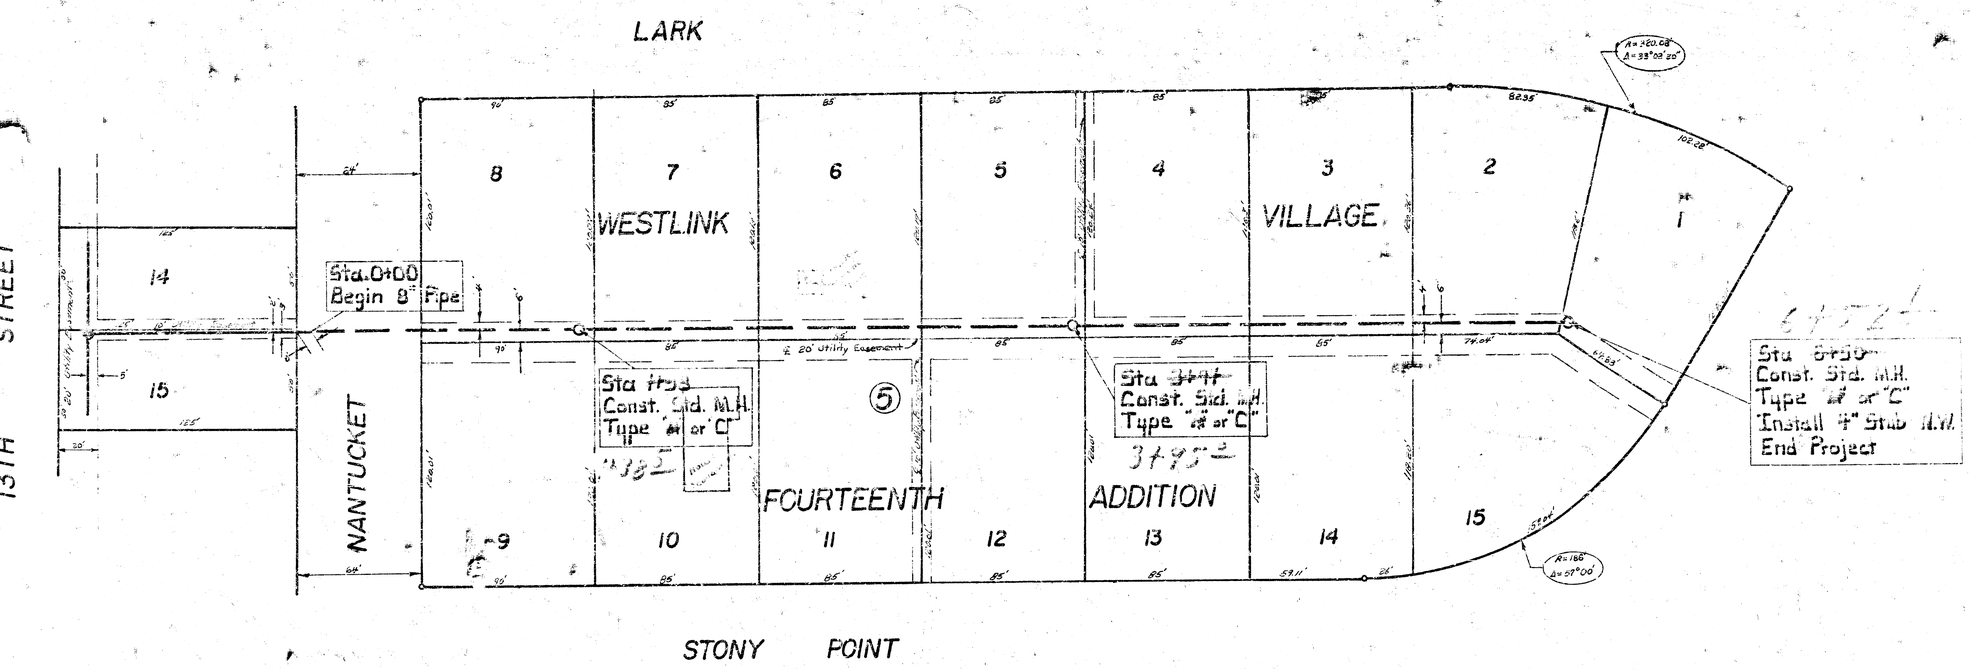

Plan Scale 1"= 40'
Profile Scale 1"= 40' Horz.
1"= 5' Vert.

NOTE: PIPE BETWEEN STATION 0 + 00 AND 1 + 38 SHALL BE SAME TYPE OF PIPE AS PIPE SOUTH OF STATION 0 + 00 WHICH IS TO BE INSTALLED BY THE CONTRACTOR FOR LATERAL 103, SOUTHWEST INTERCEPTOR.

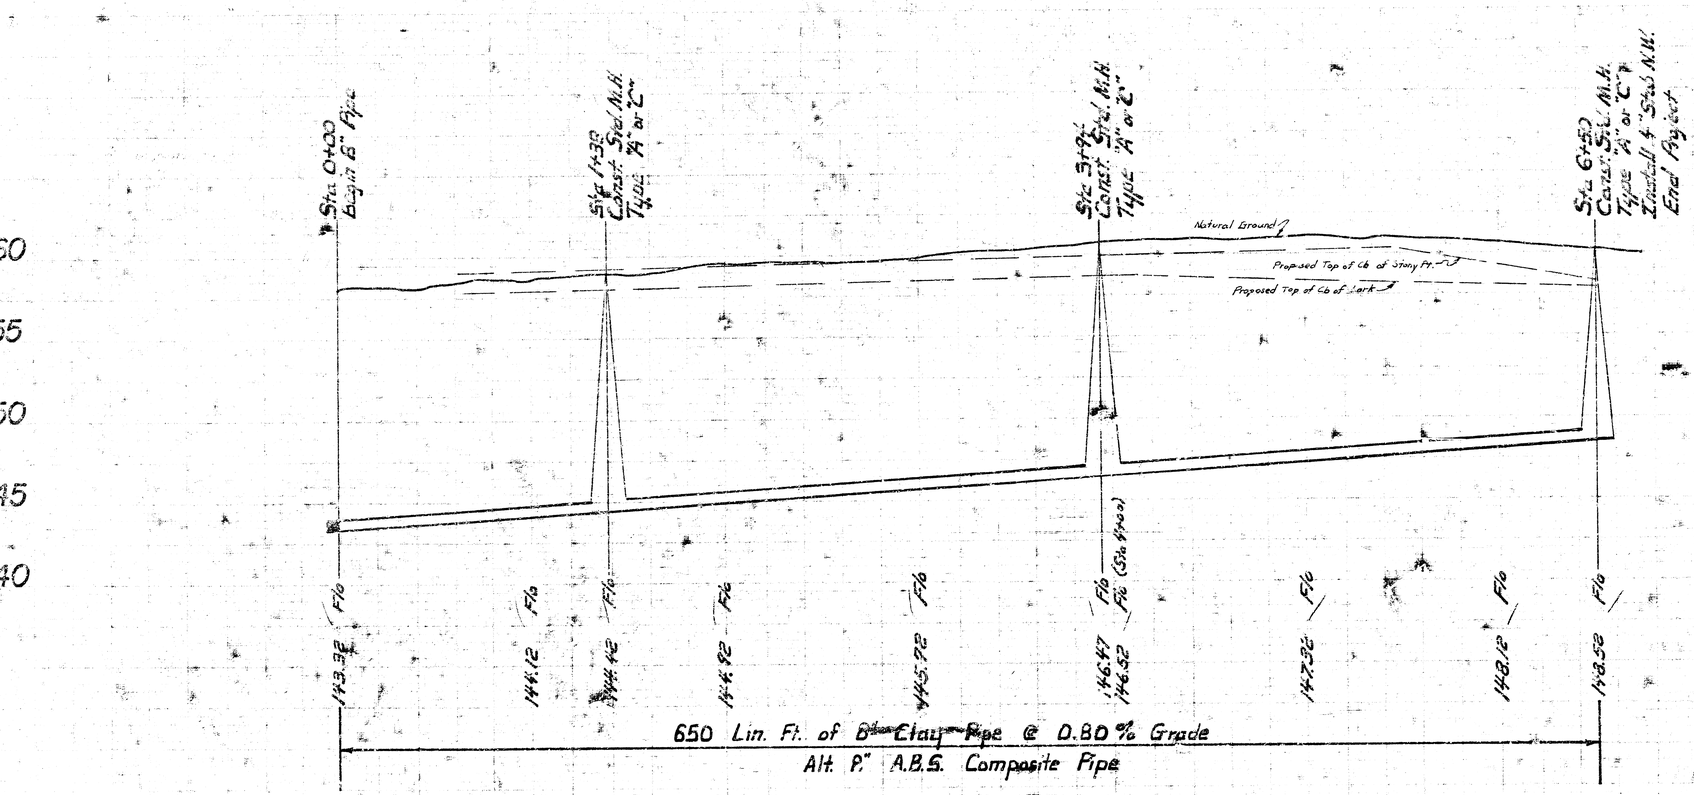

As built 4-24-78

LAT 103 SOUTHWEST INTERCEPTOR
CITY OF WICHITA, KANSAS
R.W. LINN CITY ENGINEER
DATE: PROJECT NUMBER DBKL577040