

BM 157.04 R.R. Spike N. fc. P.P. approx. 200' S. & 100' W. of N.W. cor. Nantucket & Lark
(4th P.P. W. Maize Rd on 13th)

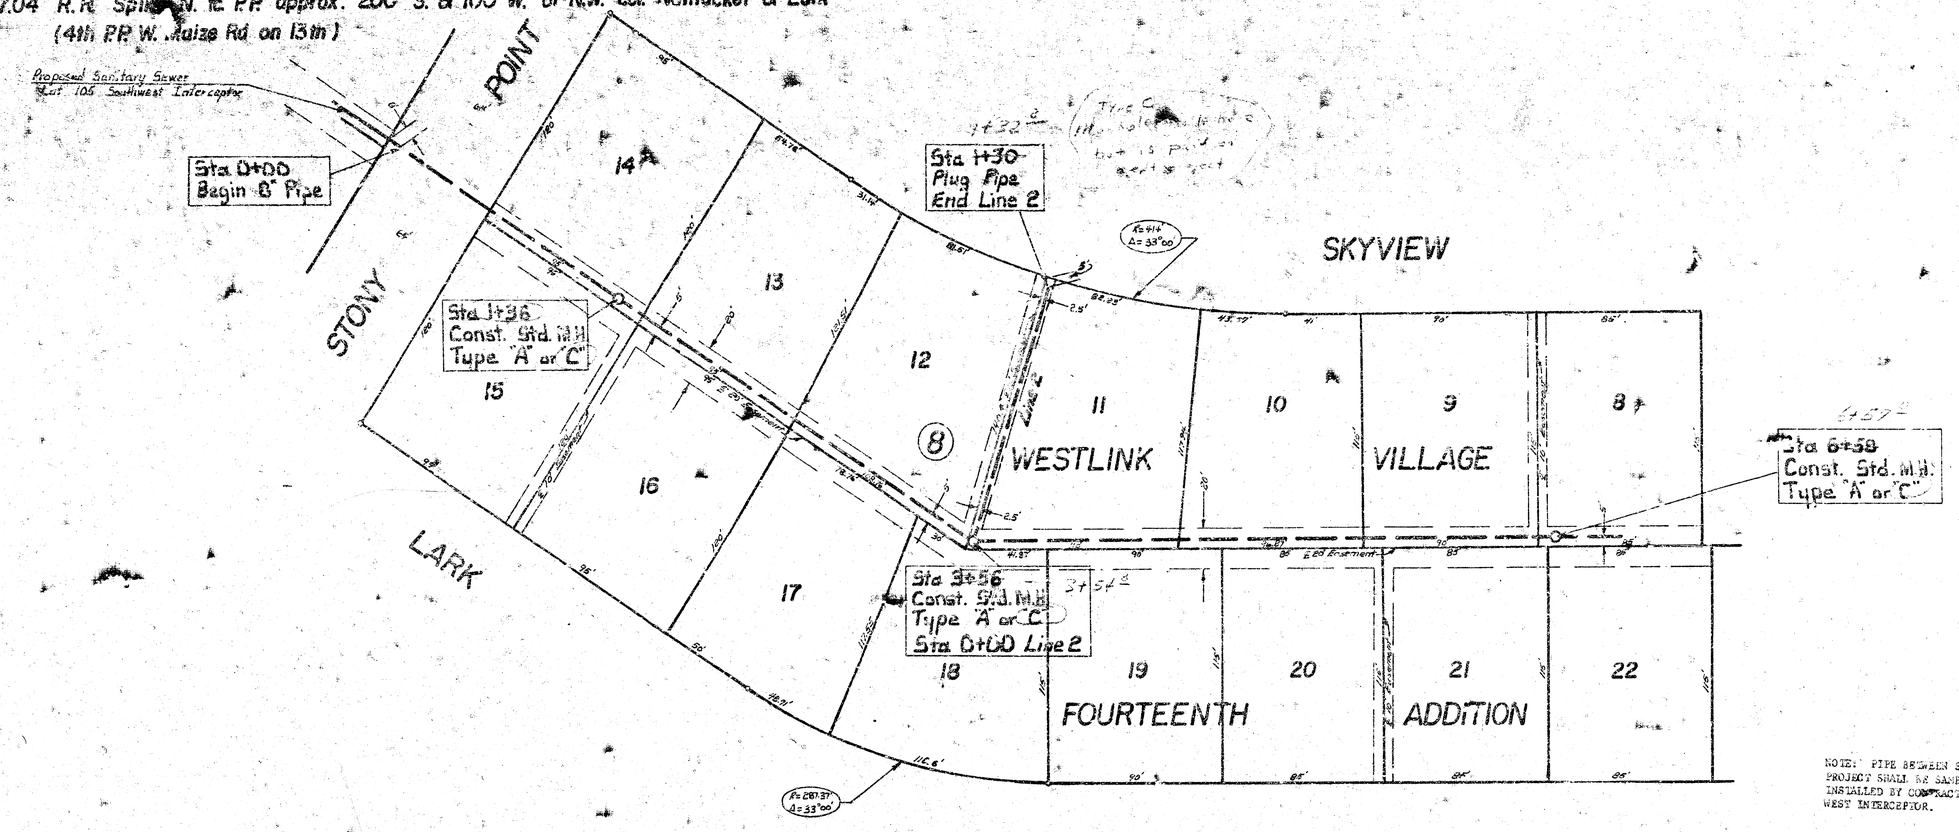

Plan Scale 1"= 40'
Profile Scale 1"= 40'
1"= 5'

NOTE: PIPE BETWEEN STATION 0 + 00 AND STATION 1 + 36 ON THIS PROJECT SHALL BE SAME TYPE OF PIPE AS THAT WHICH IS TO BE INSTALLED BY CONTRACTOR FOR CONSTRUCTING LATERAL 105, SOUTHWEST INTERCEPTOR.

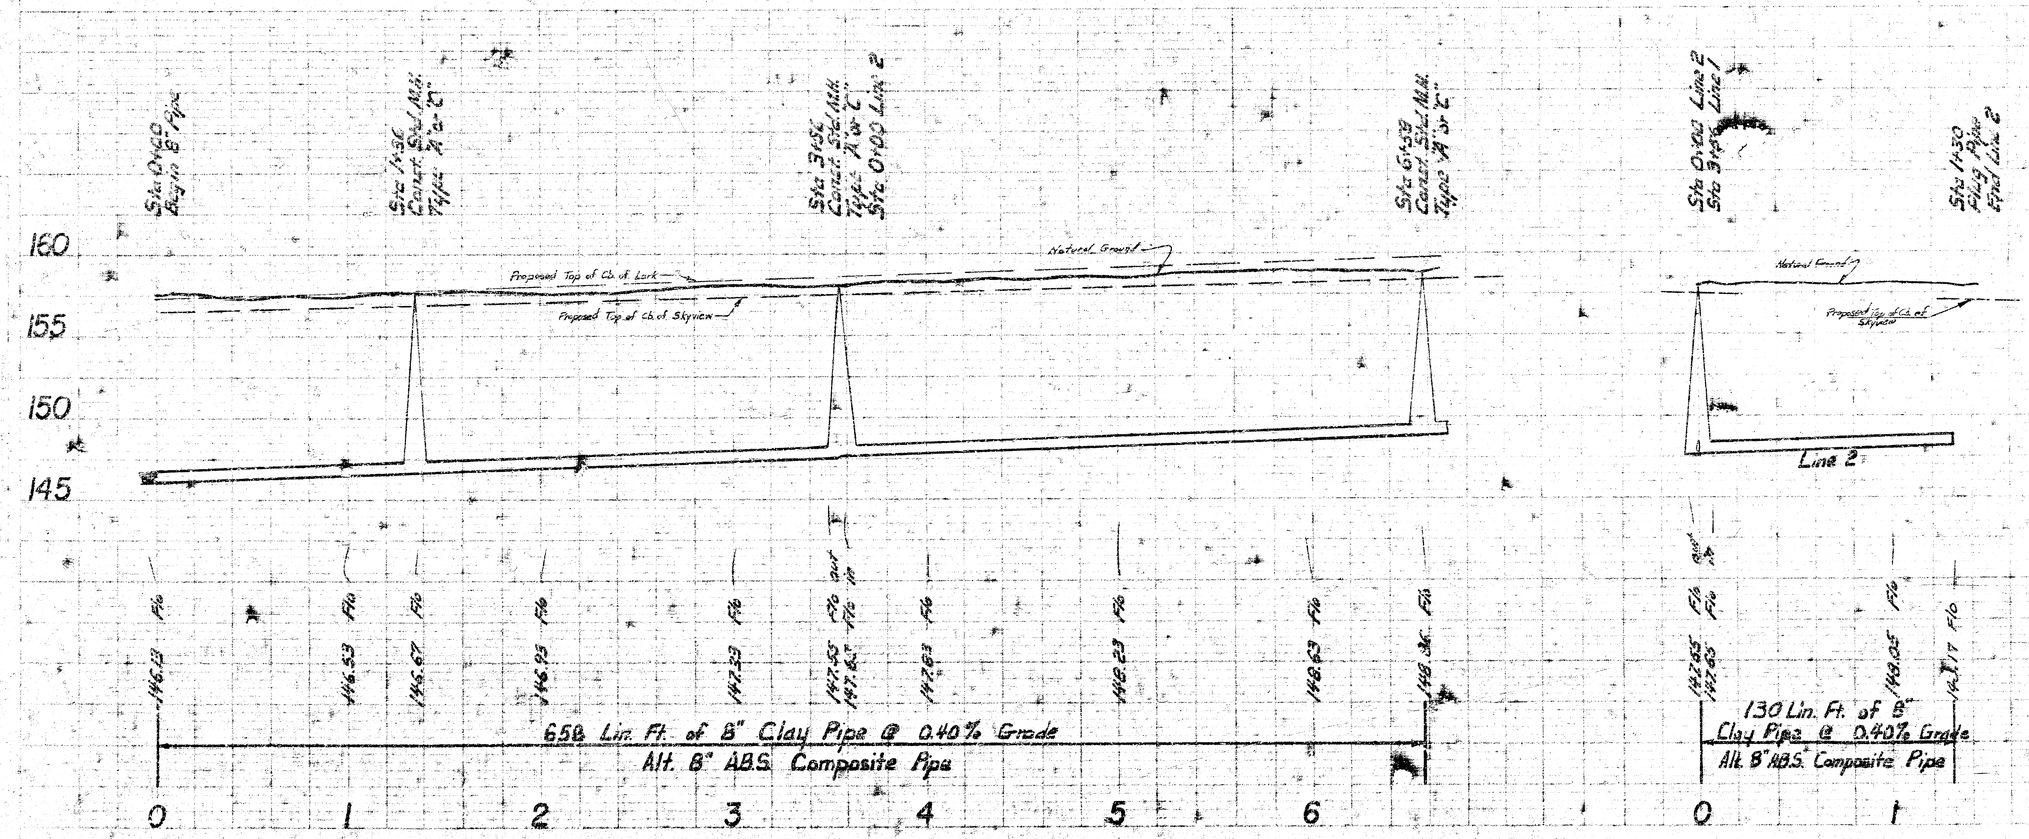

LAT. 106 SOUTHWEST INTERCEP
CITY OF WICHITA, KANSAS
R.W. LINN CITY ENG
PROJ. NO. 468-76-245-80375-000-0
DATE

SKYVIEW

WESTLINK

VILLAGE

8 7 6 5 4 3 2 1

ST. NORTH 17TH

Sta 6+58

Sta 9+63
Const. Std. M.H.
Type "A" or "C"

8

Sta 12+68
Const. Std. M.H.
Type "A" or "C"
Install 4" Stubs N.E.+N.W.
End Line 1

22 23 24 25 26 27 28 29

FOURTEENTH ADDITION

LARK

R=86'
Δ=90°08'20"

N

Plan Scale 1"=40'
Profile Scale 1"=40'
1"=5'

Sta 6+58

Sta 9+63
Const. Std. M.H.
Type "A" or "C"

Sta 12+68
Const. Std. M.H.
Type "A" or "C"
Install 4" Stubs N.E.+N.W.
End Line 1

160
155
150
145

Proposed Top of Ch. of Lark

Proposed Top of Ch. of Skyview

Natural Ground

142.86 F/G | 145.03 F/G | 148.43 F/G | 149.83 F/G | 150.03 F/G | 150.23 F/G | 150.63 F/G | 151.03 F/G | 151.30 F/G

610 Lin. Ft. of 8" Clay Pipe @ 0.40% Grade
Alt. 8" A.B.S. Composite Pipe

6 7 8 9 10 11 12

LAT 106 SOUTHWEST INTERCE

PROJ. NO. 468-76-245-80375-000-0

Jim L. Armor
State Planner
Page 179
Page 177

JLA#29