


Scale: Plan 1" = 40'
 Profile 1" = 40' Horiz.
 1" = 5' Vert.

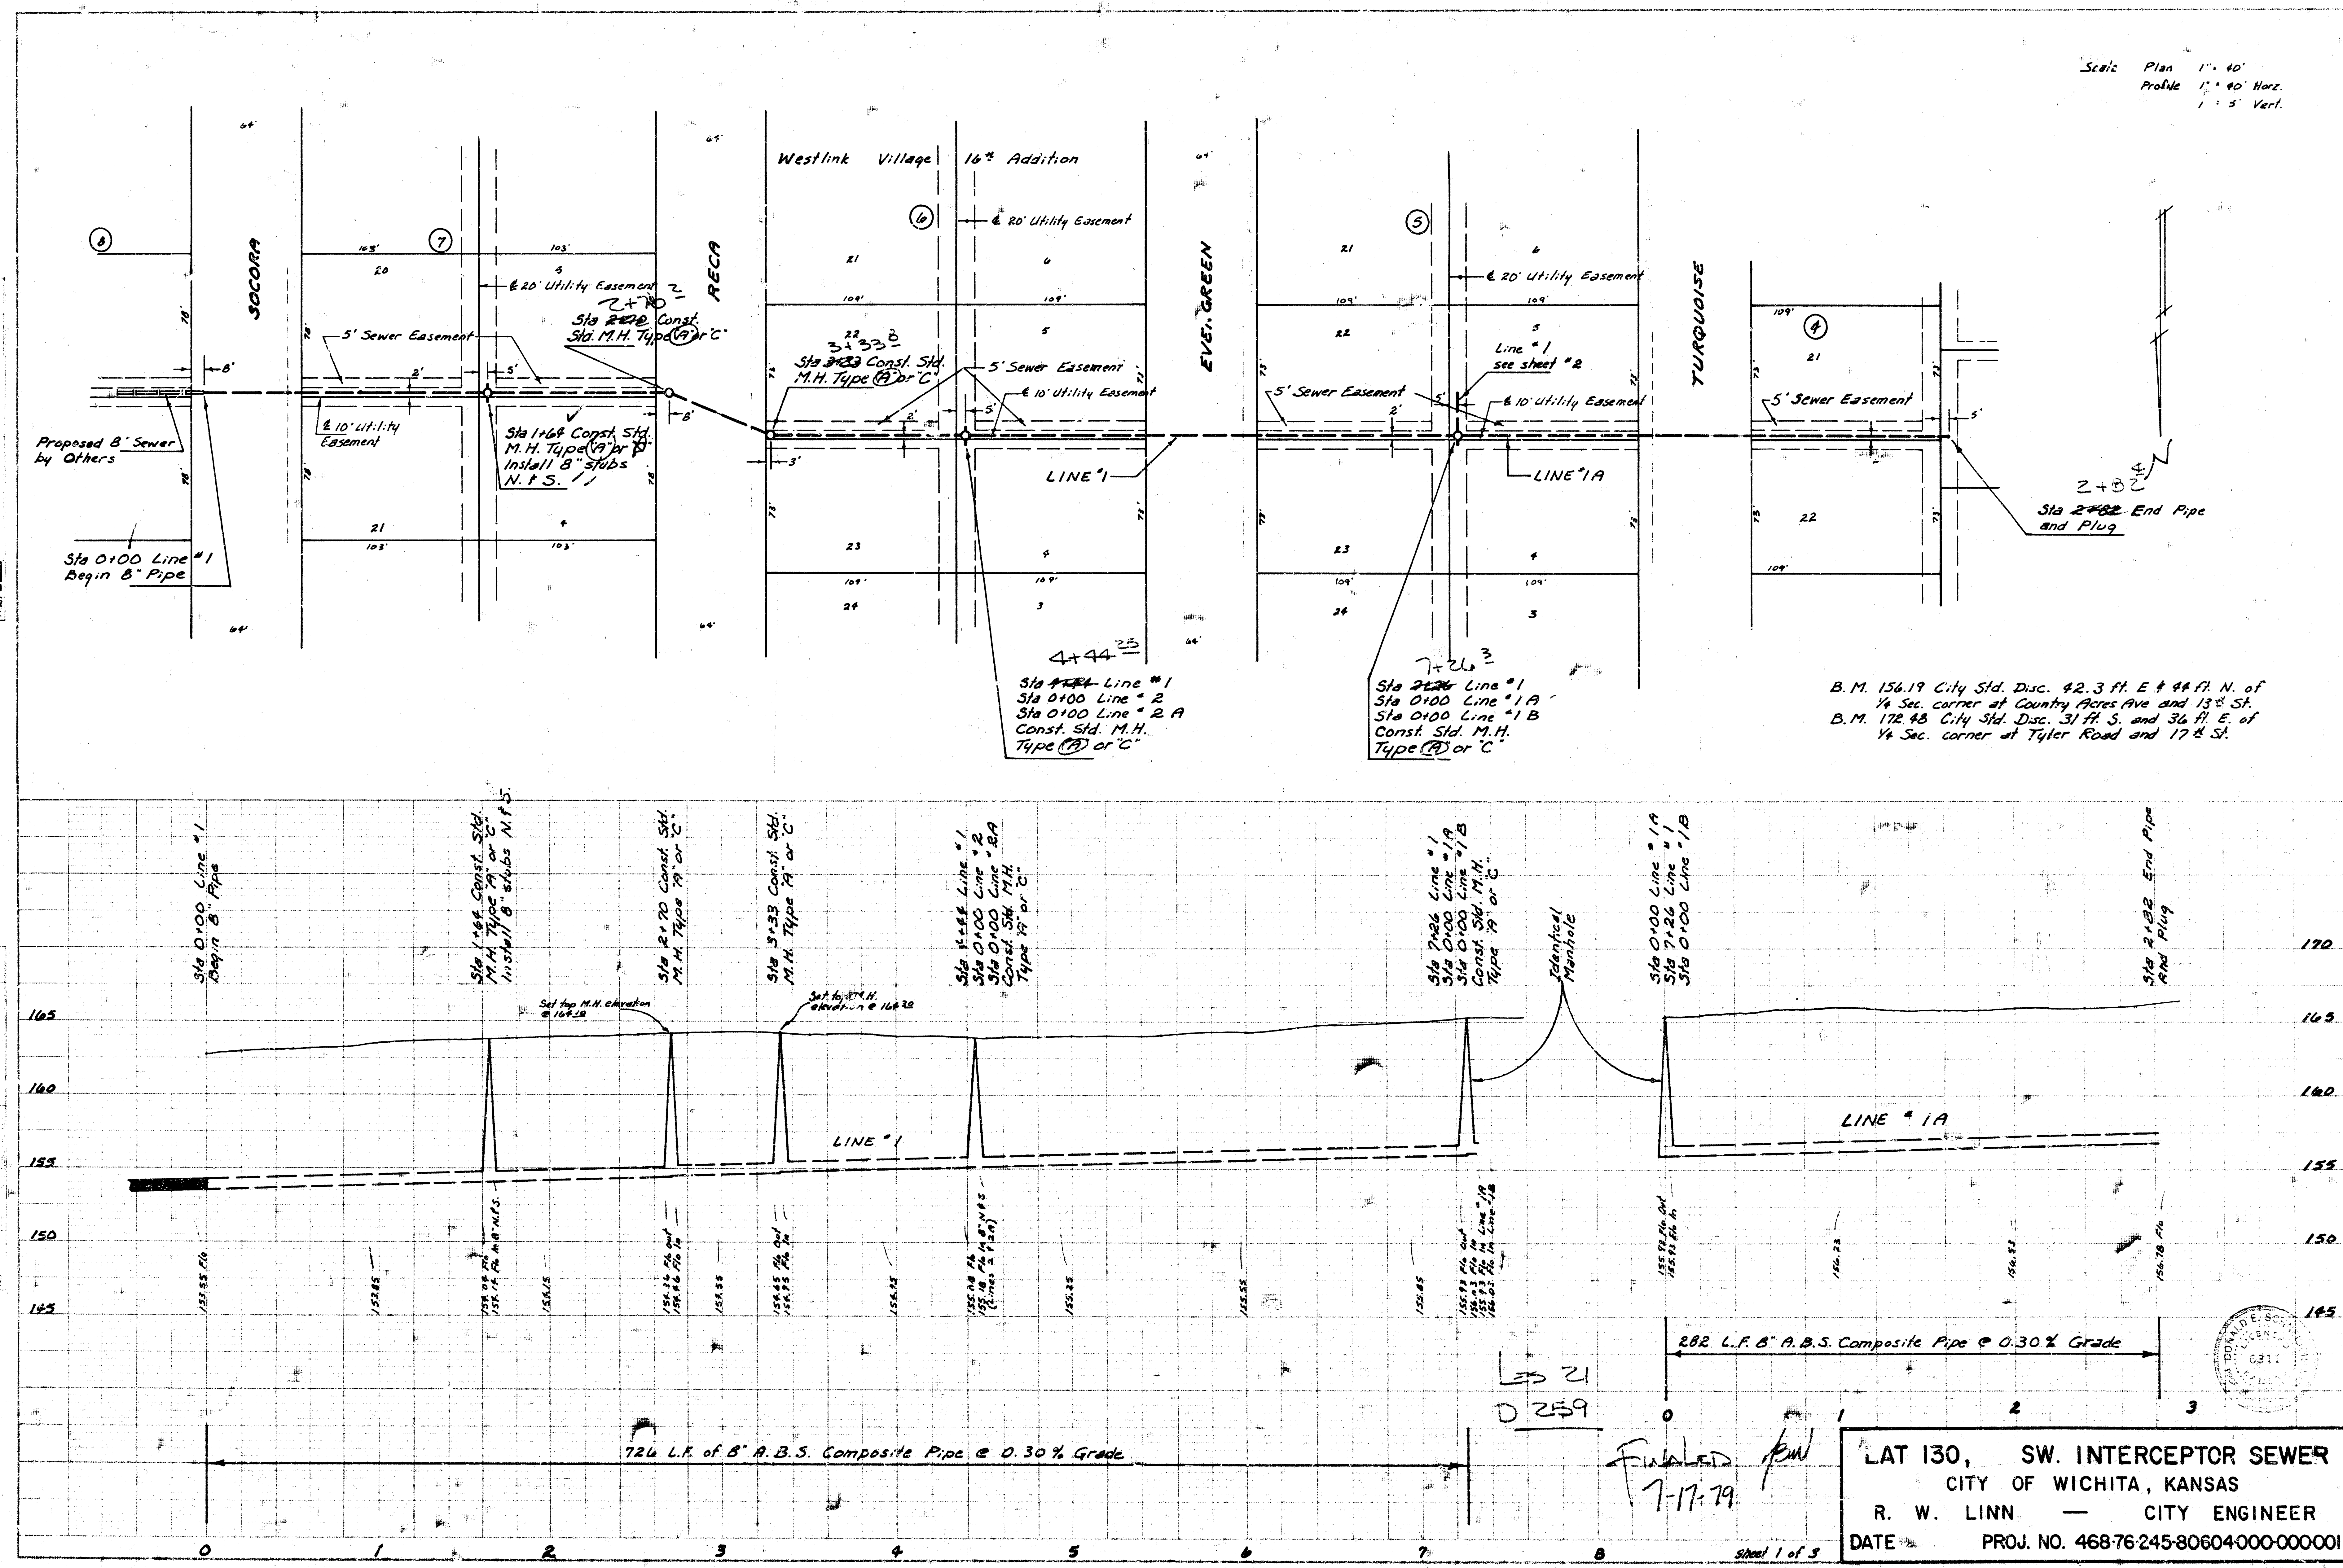



B.M. 156.19 City Std. Disc. 42.3 ft. E & 44 ft. N. of
 1/4 Sec. corner at Country Acres Ave and 15th St.
 B.M. 172.48 City Std. Disc. 31 ft. S. and 36 ft. E. of
 1/4 Sec. corner at Tyler Road and 17th St.

LAT 130, SW. INTERCEPTOR SEWER
 CITY OF WICHITA, KANSAS
 R. W. LINN — CITY ENGINEER
 DATE 7-17-79 PROJ. NO. 468-76-245-80604-000-000001

Scale Plan 1" = 40'
 Profile 1" = 40' Horiz.
 1" = 5' Vert.



EVERGREEN

TURQUOISE



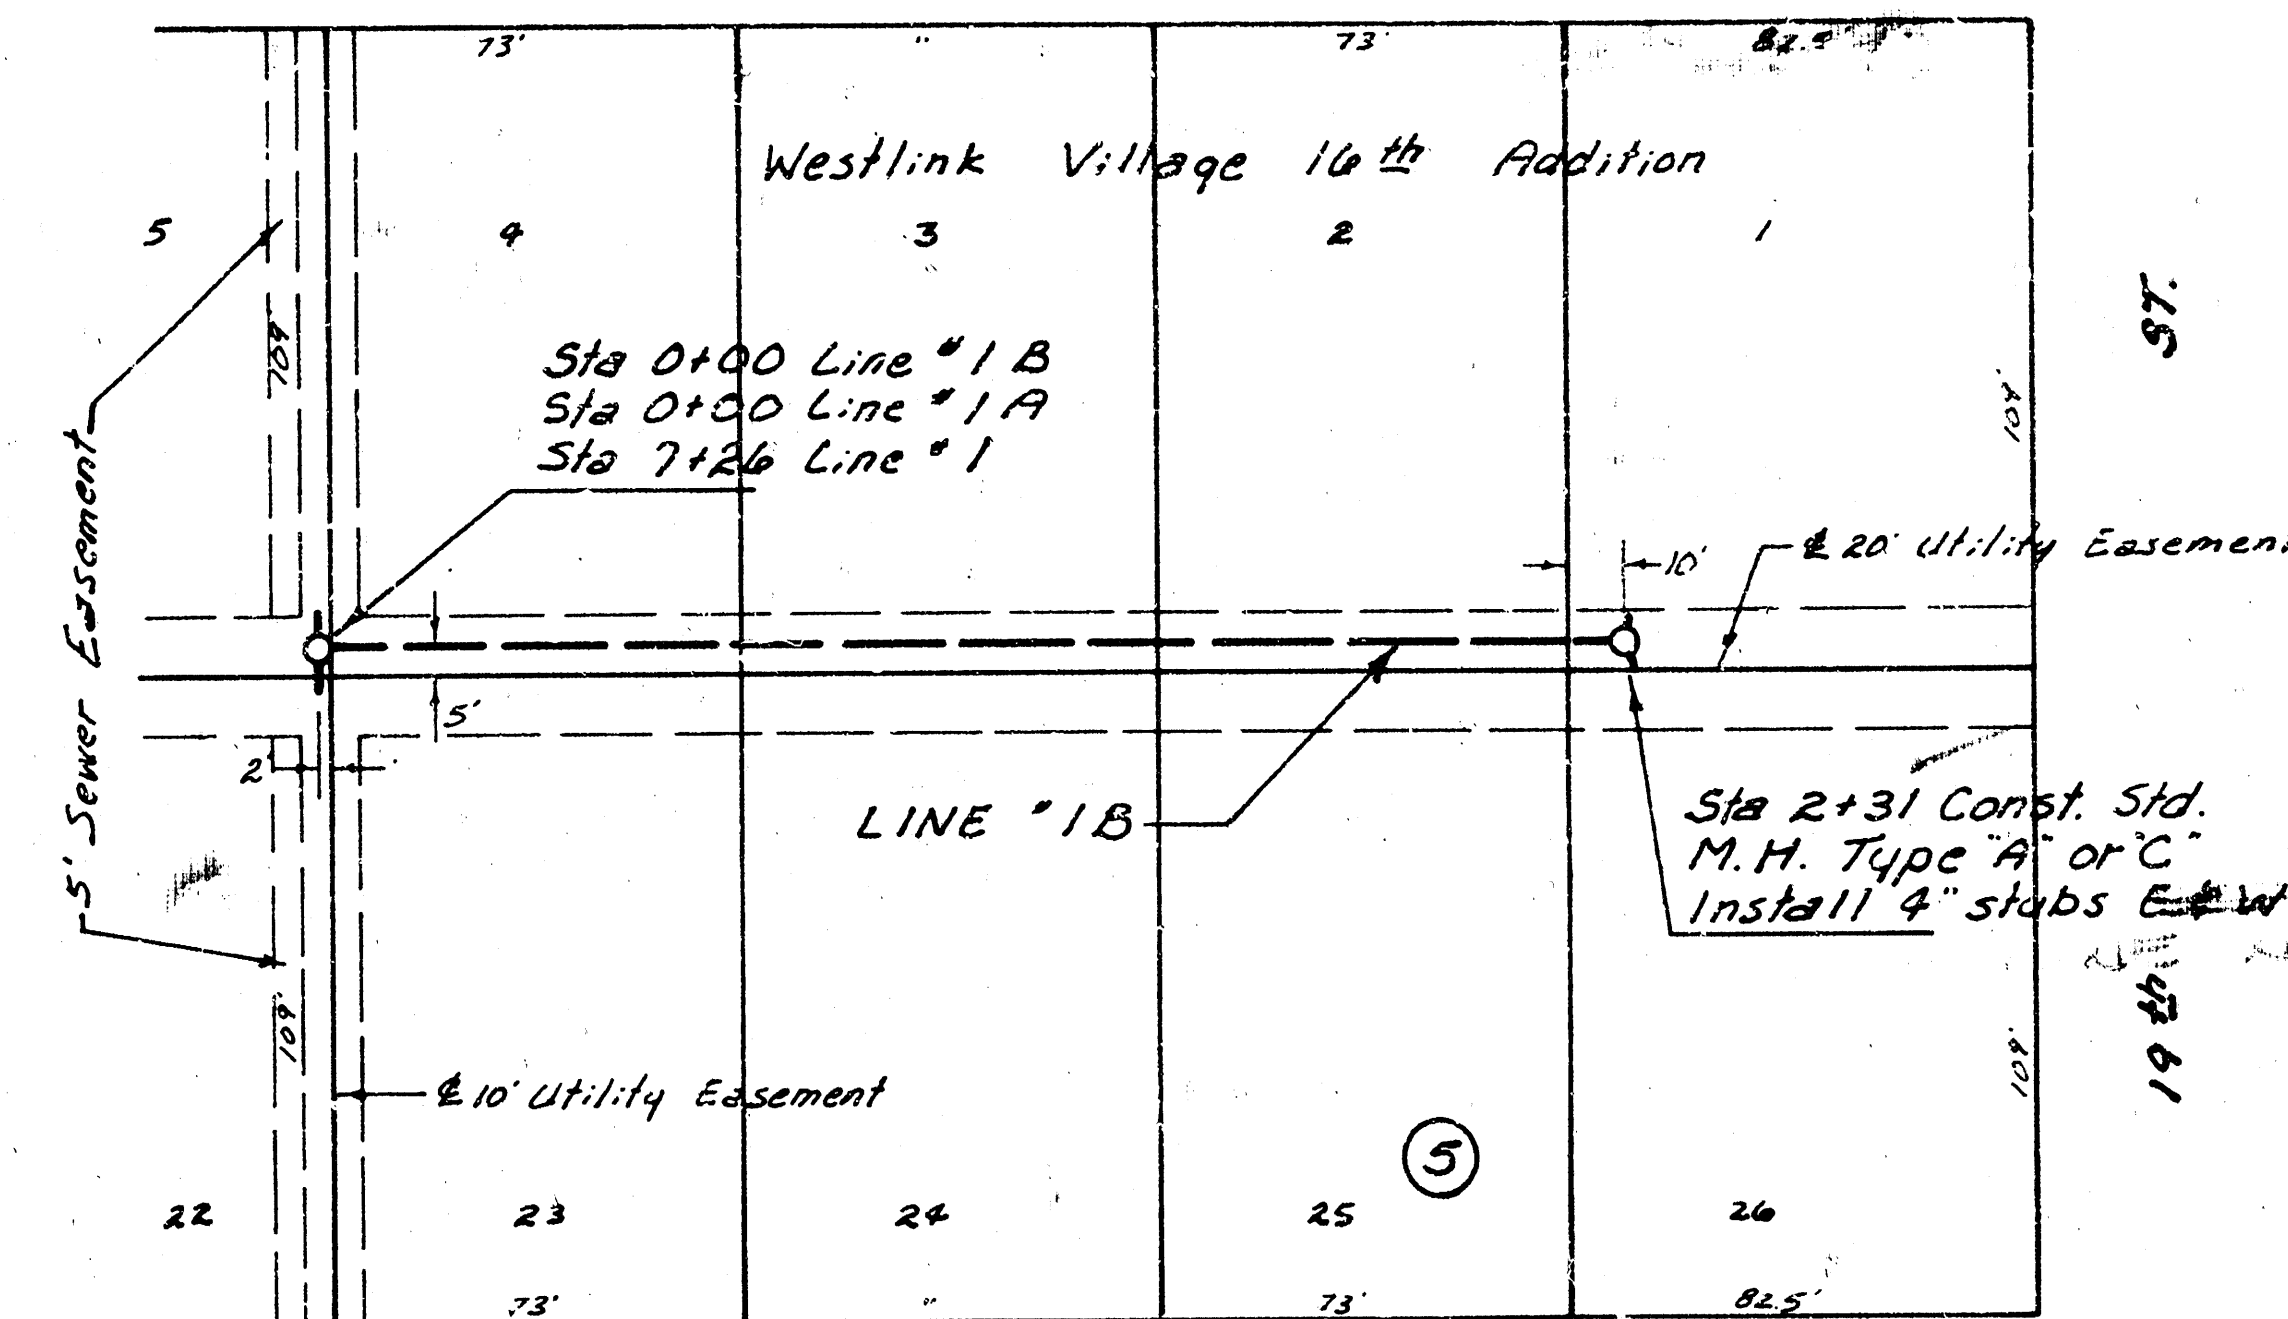
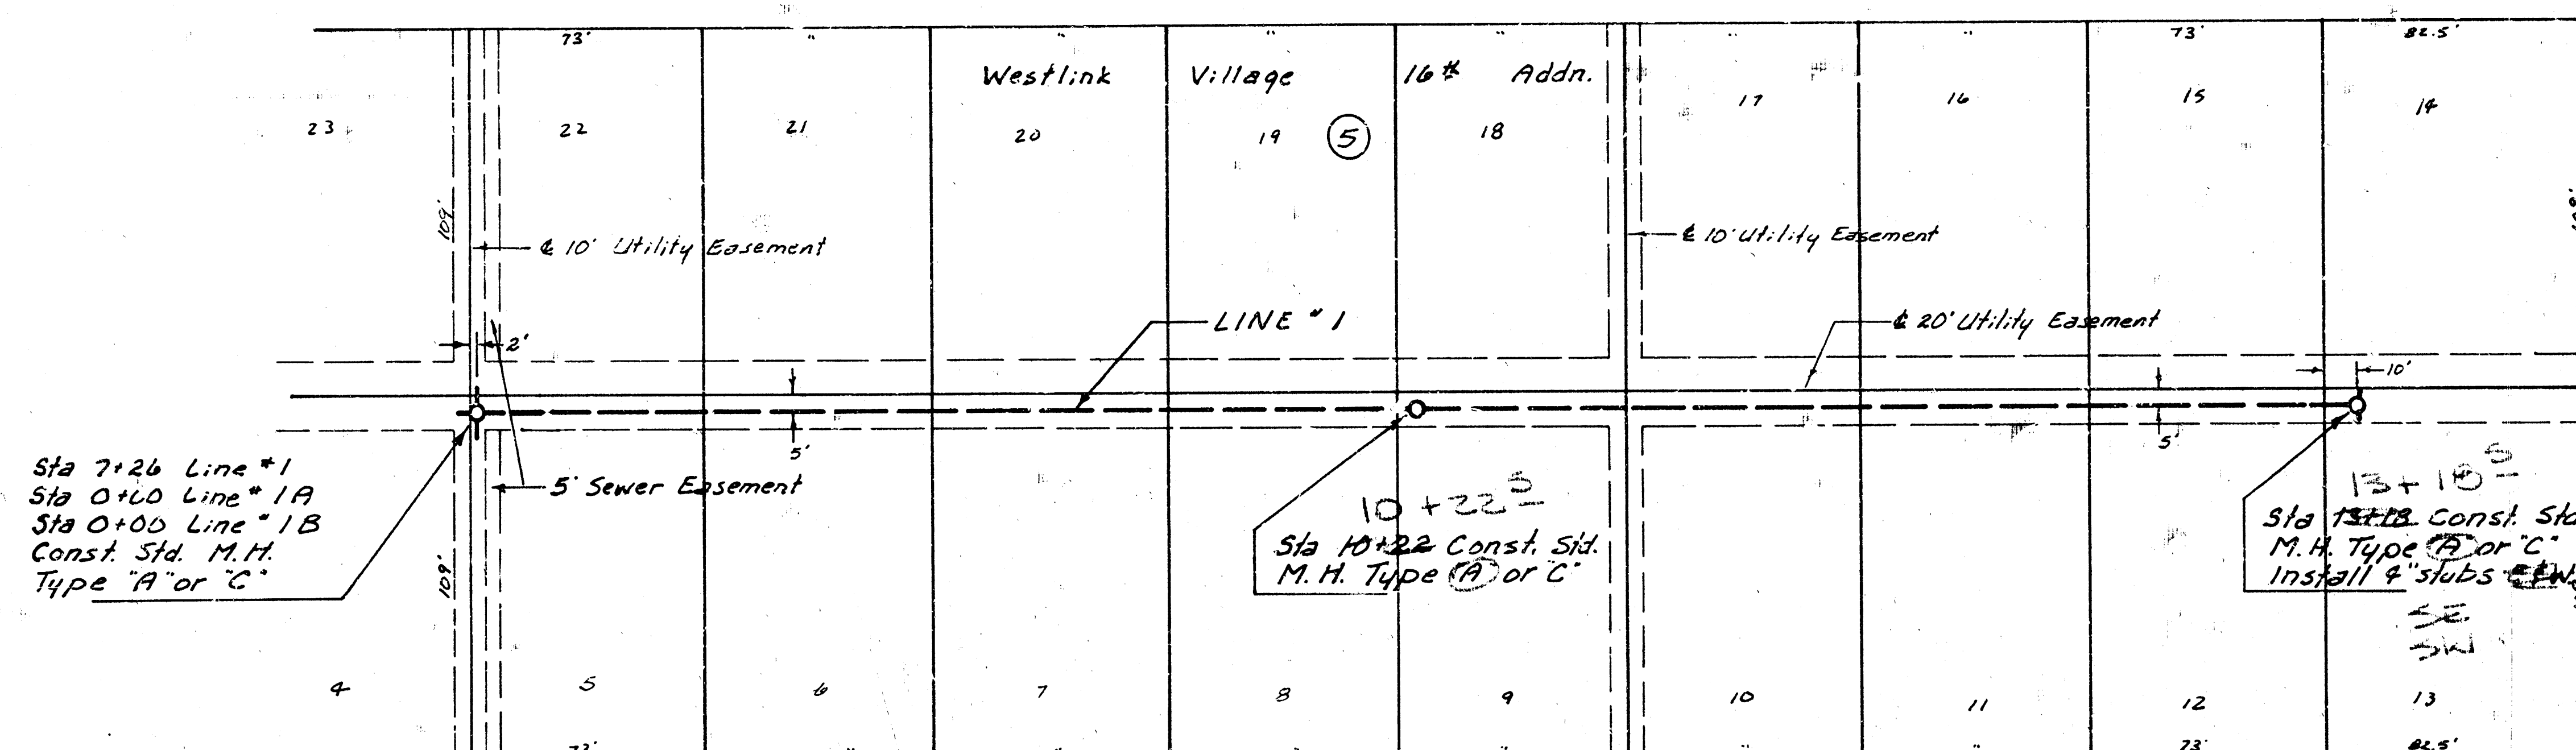


TURQUOISE

EVERGREEN

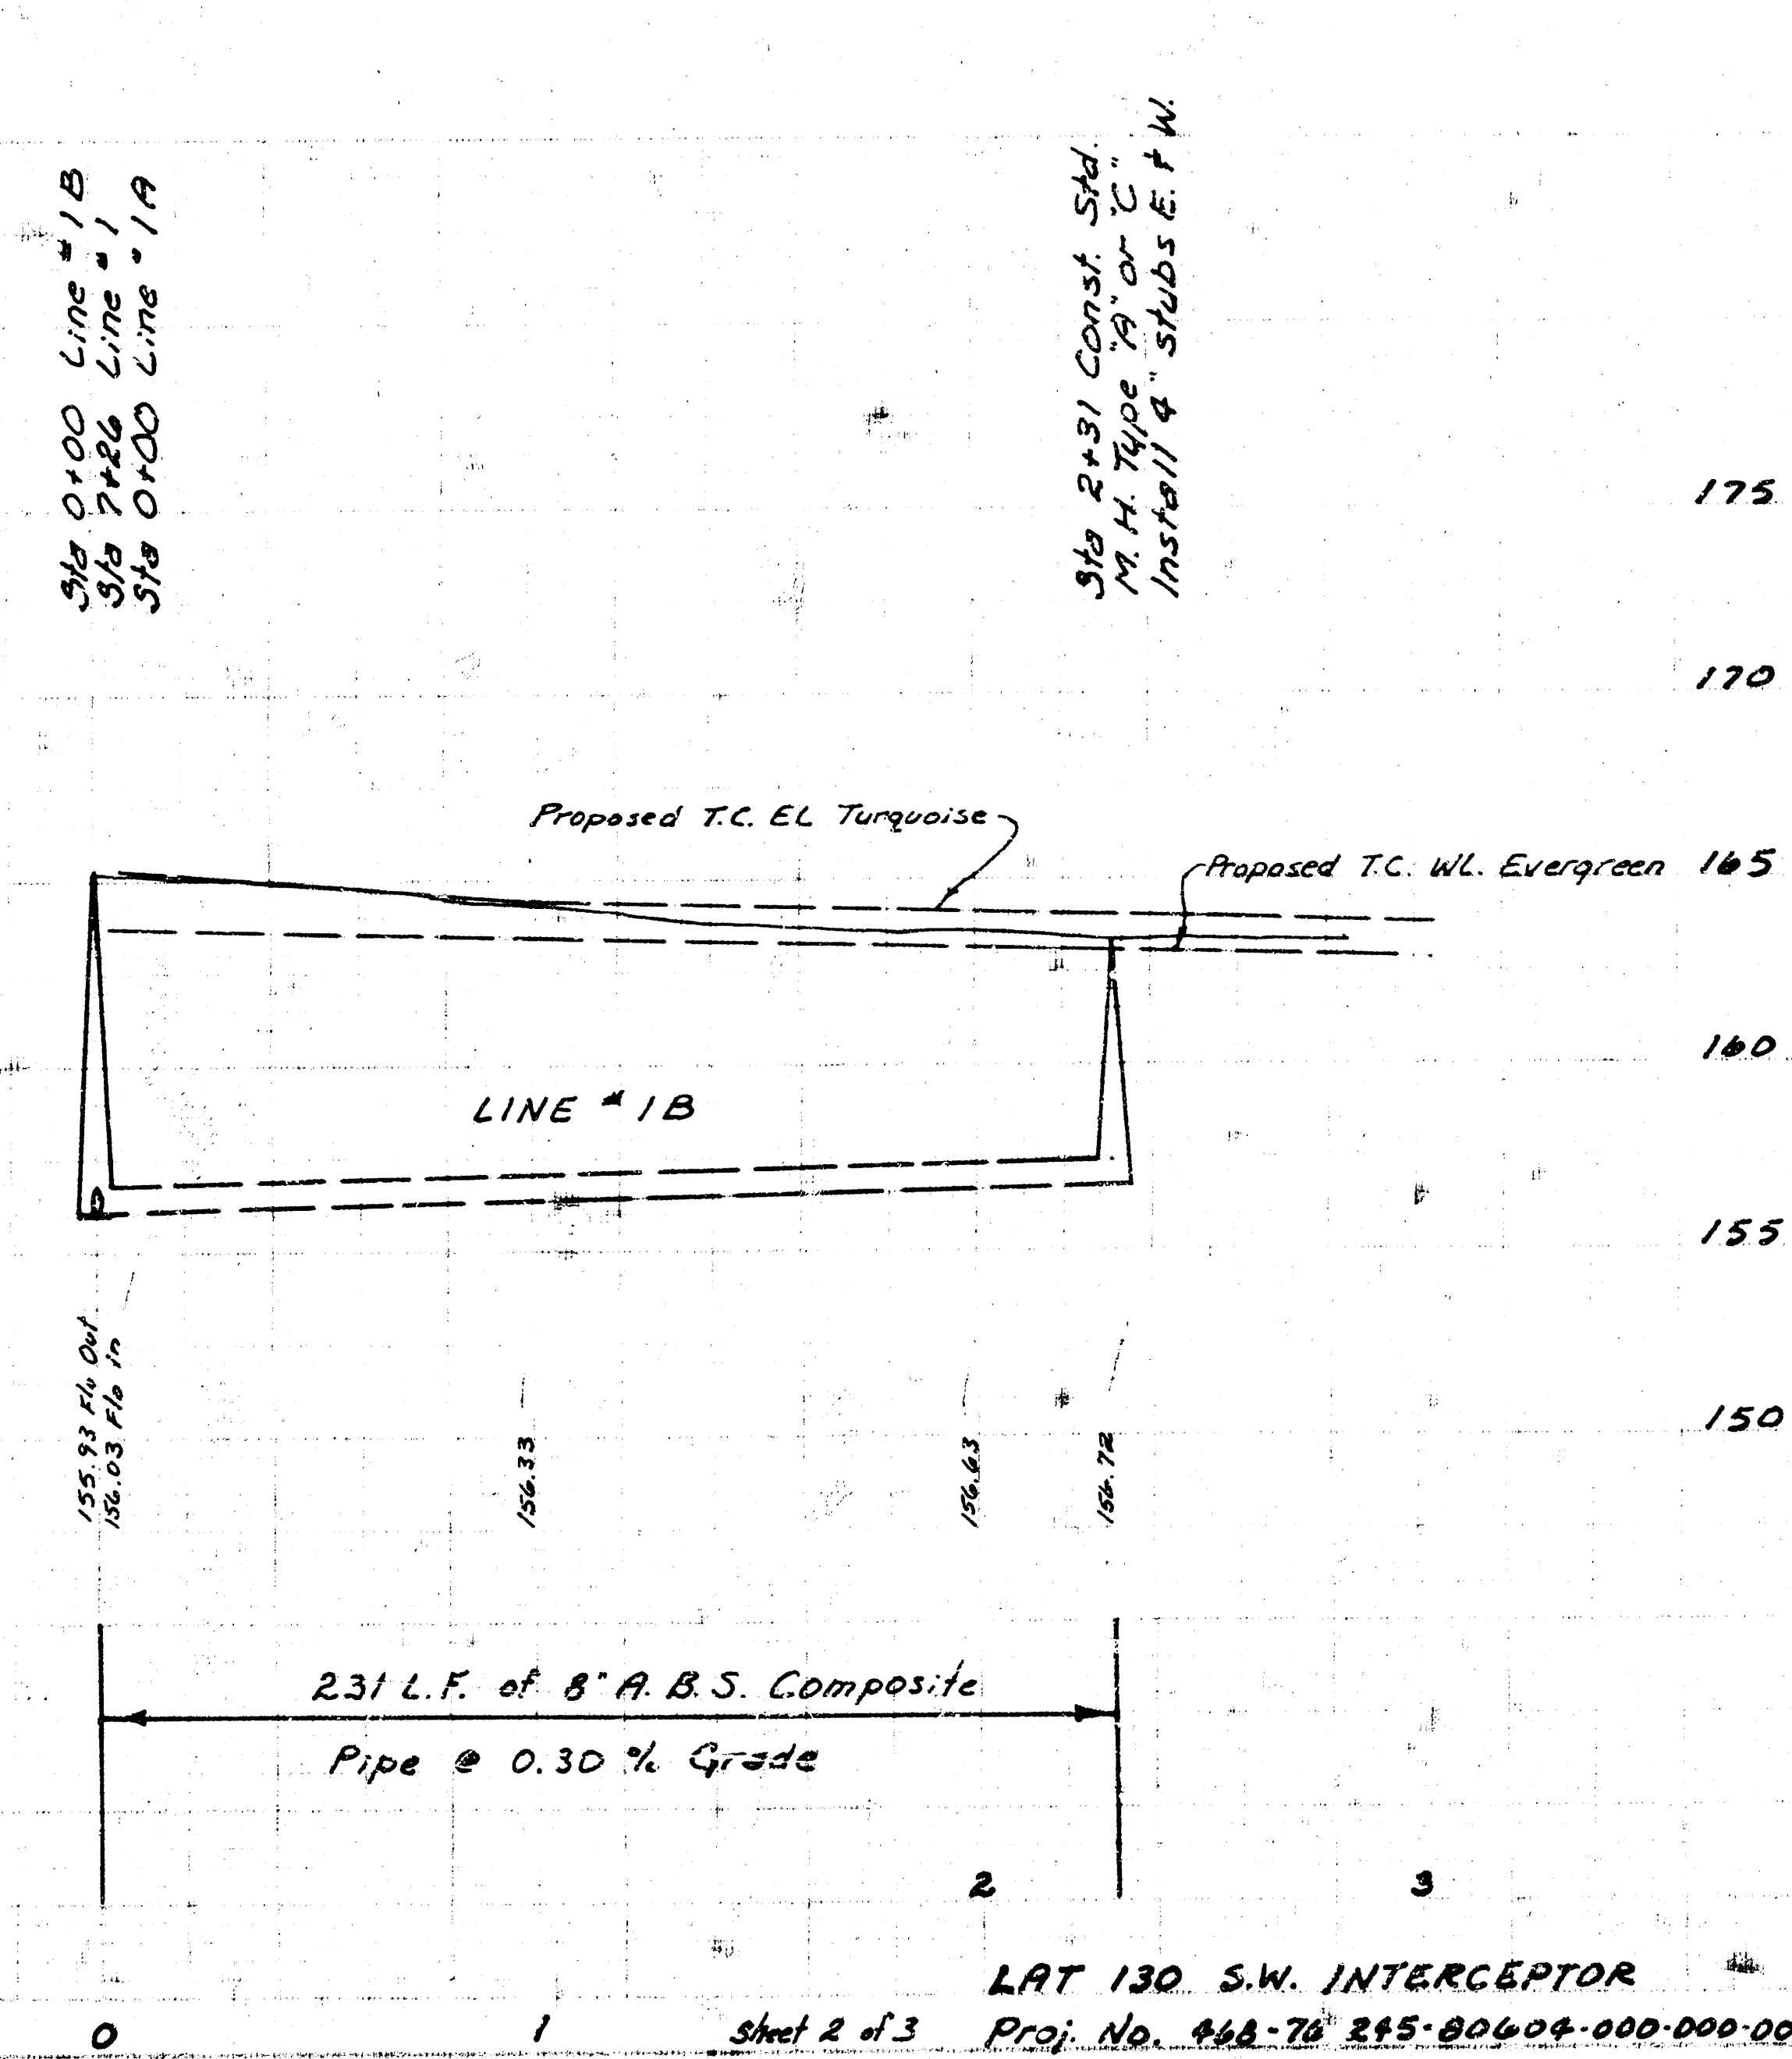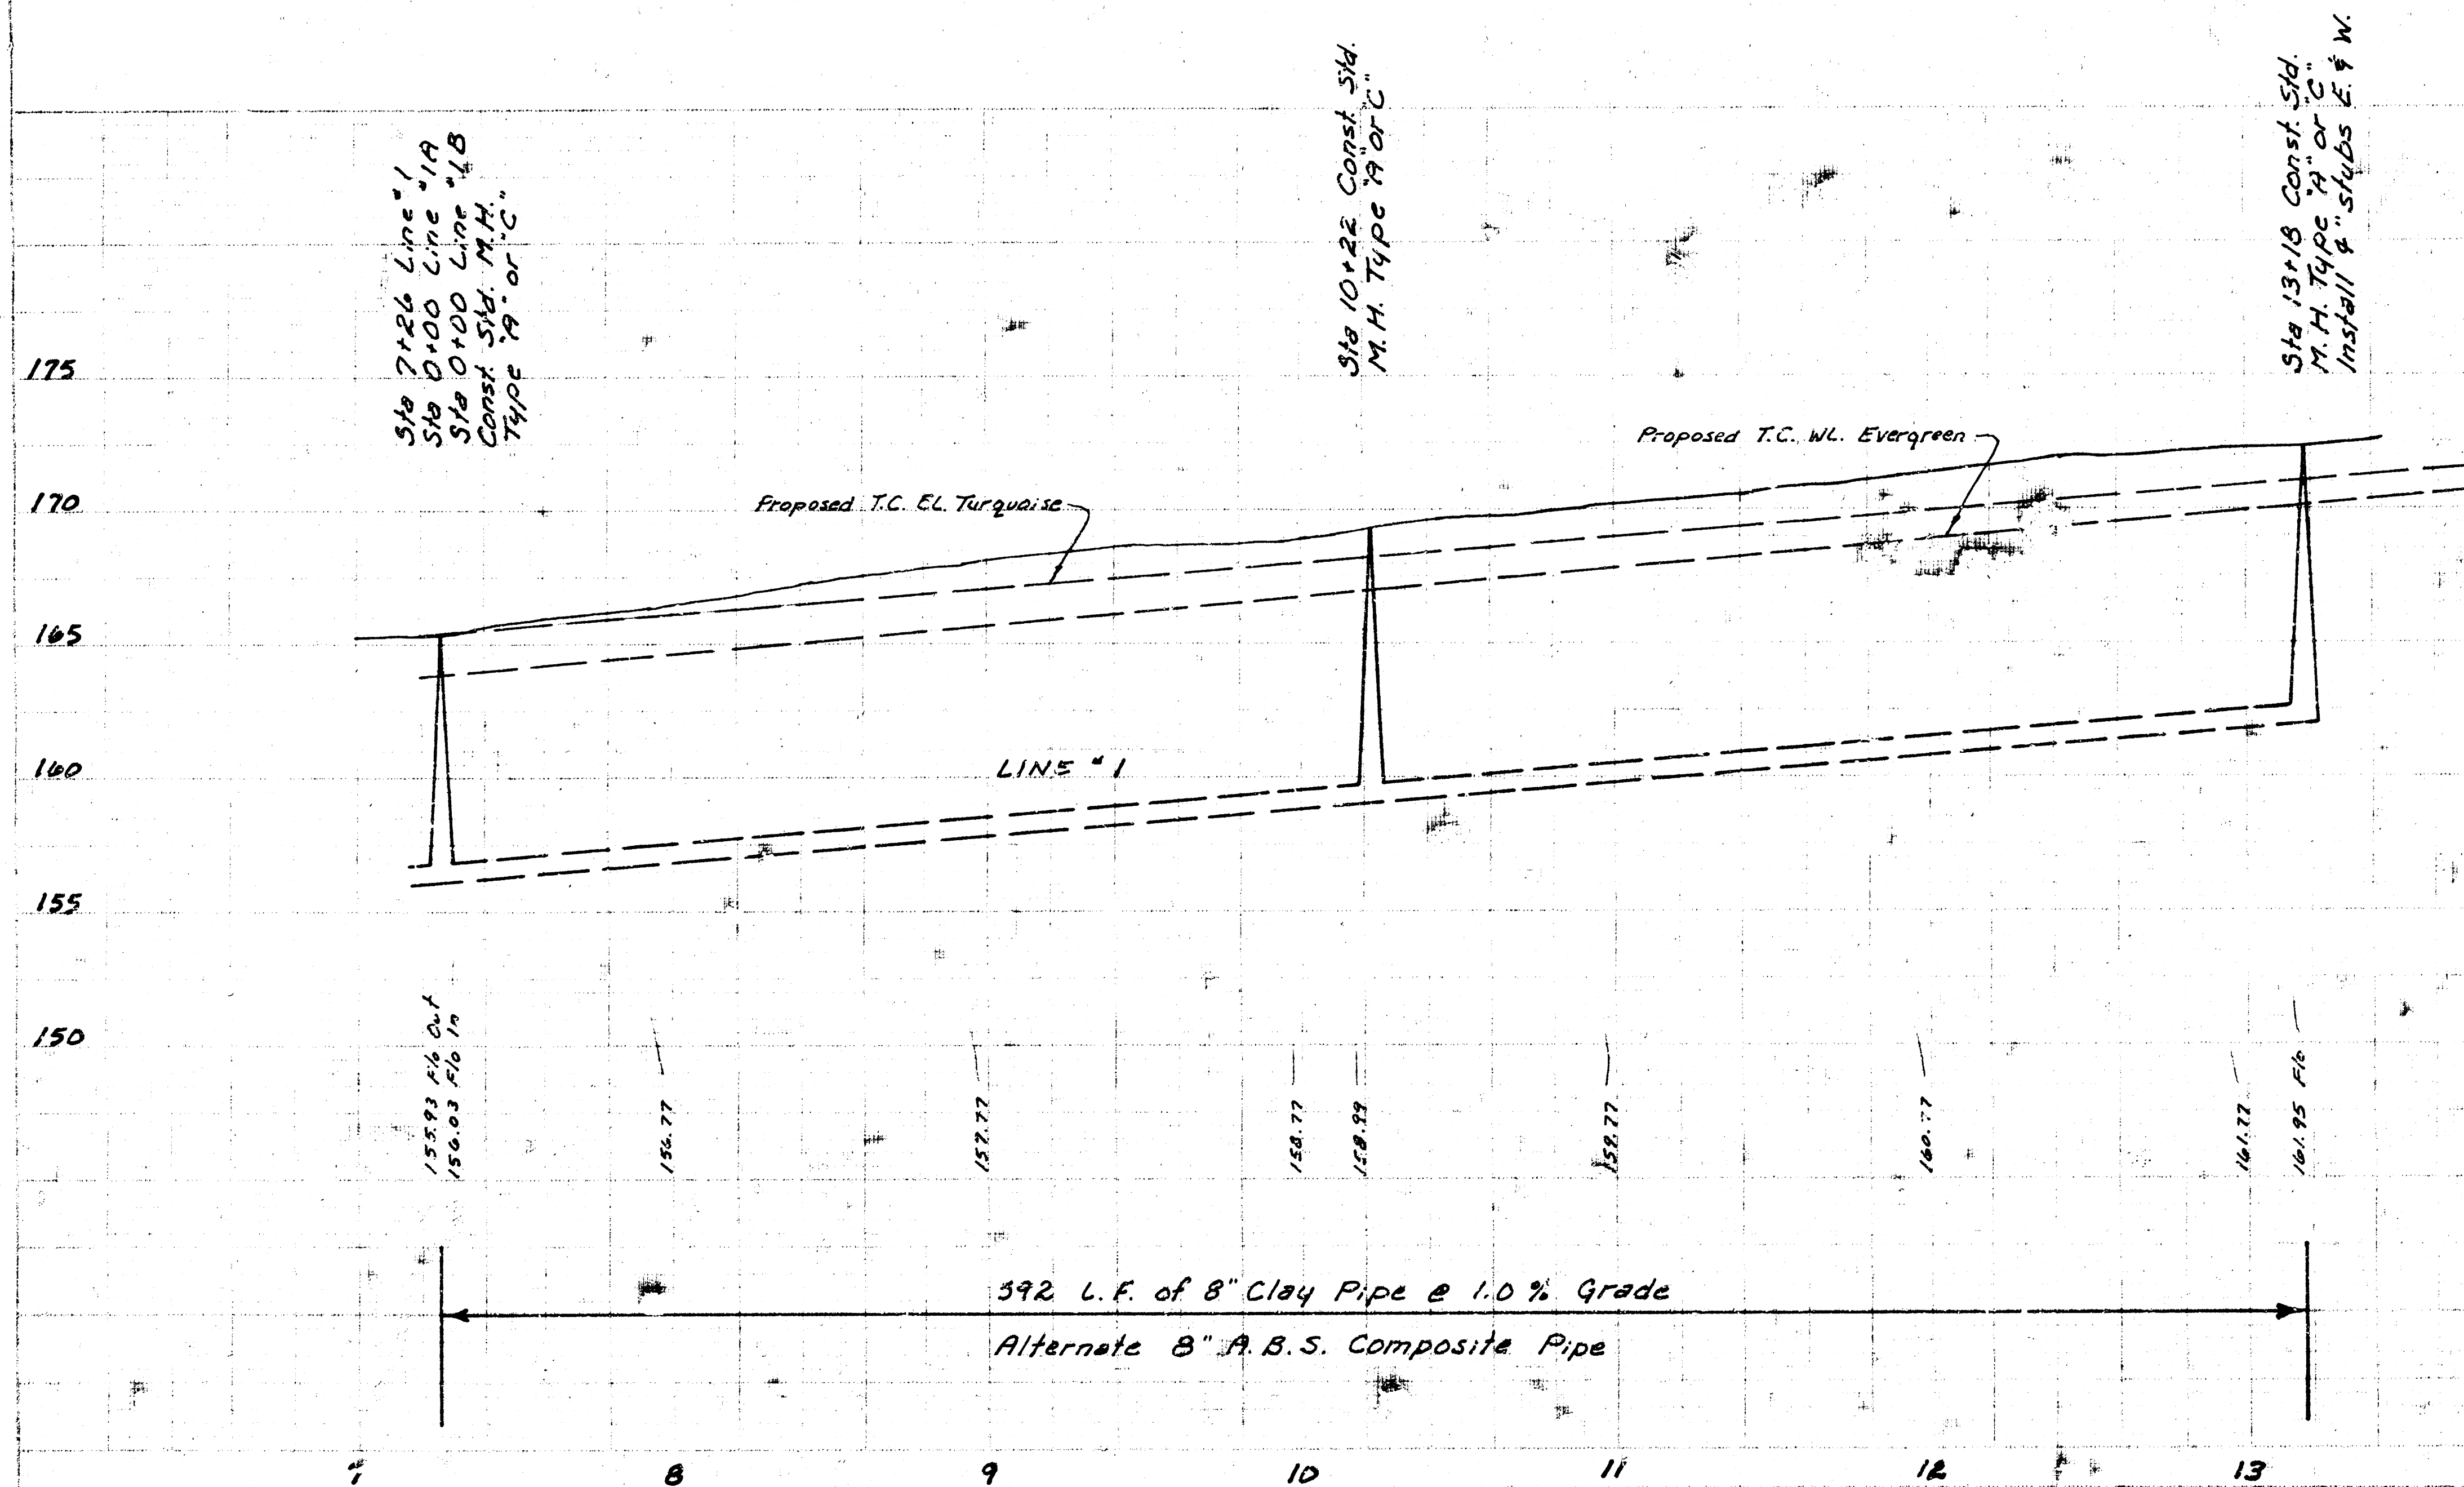

LAT 130 S.W. INTERCEPTOR

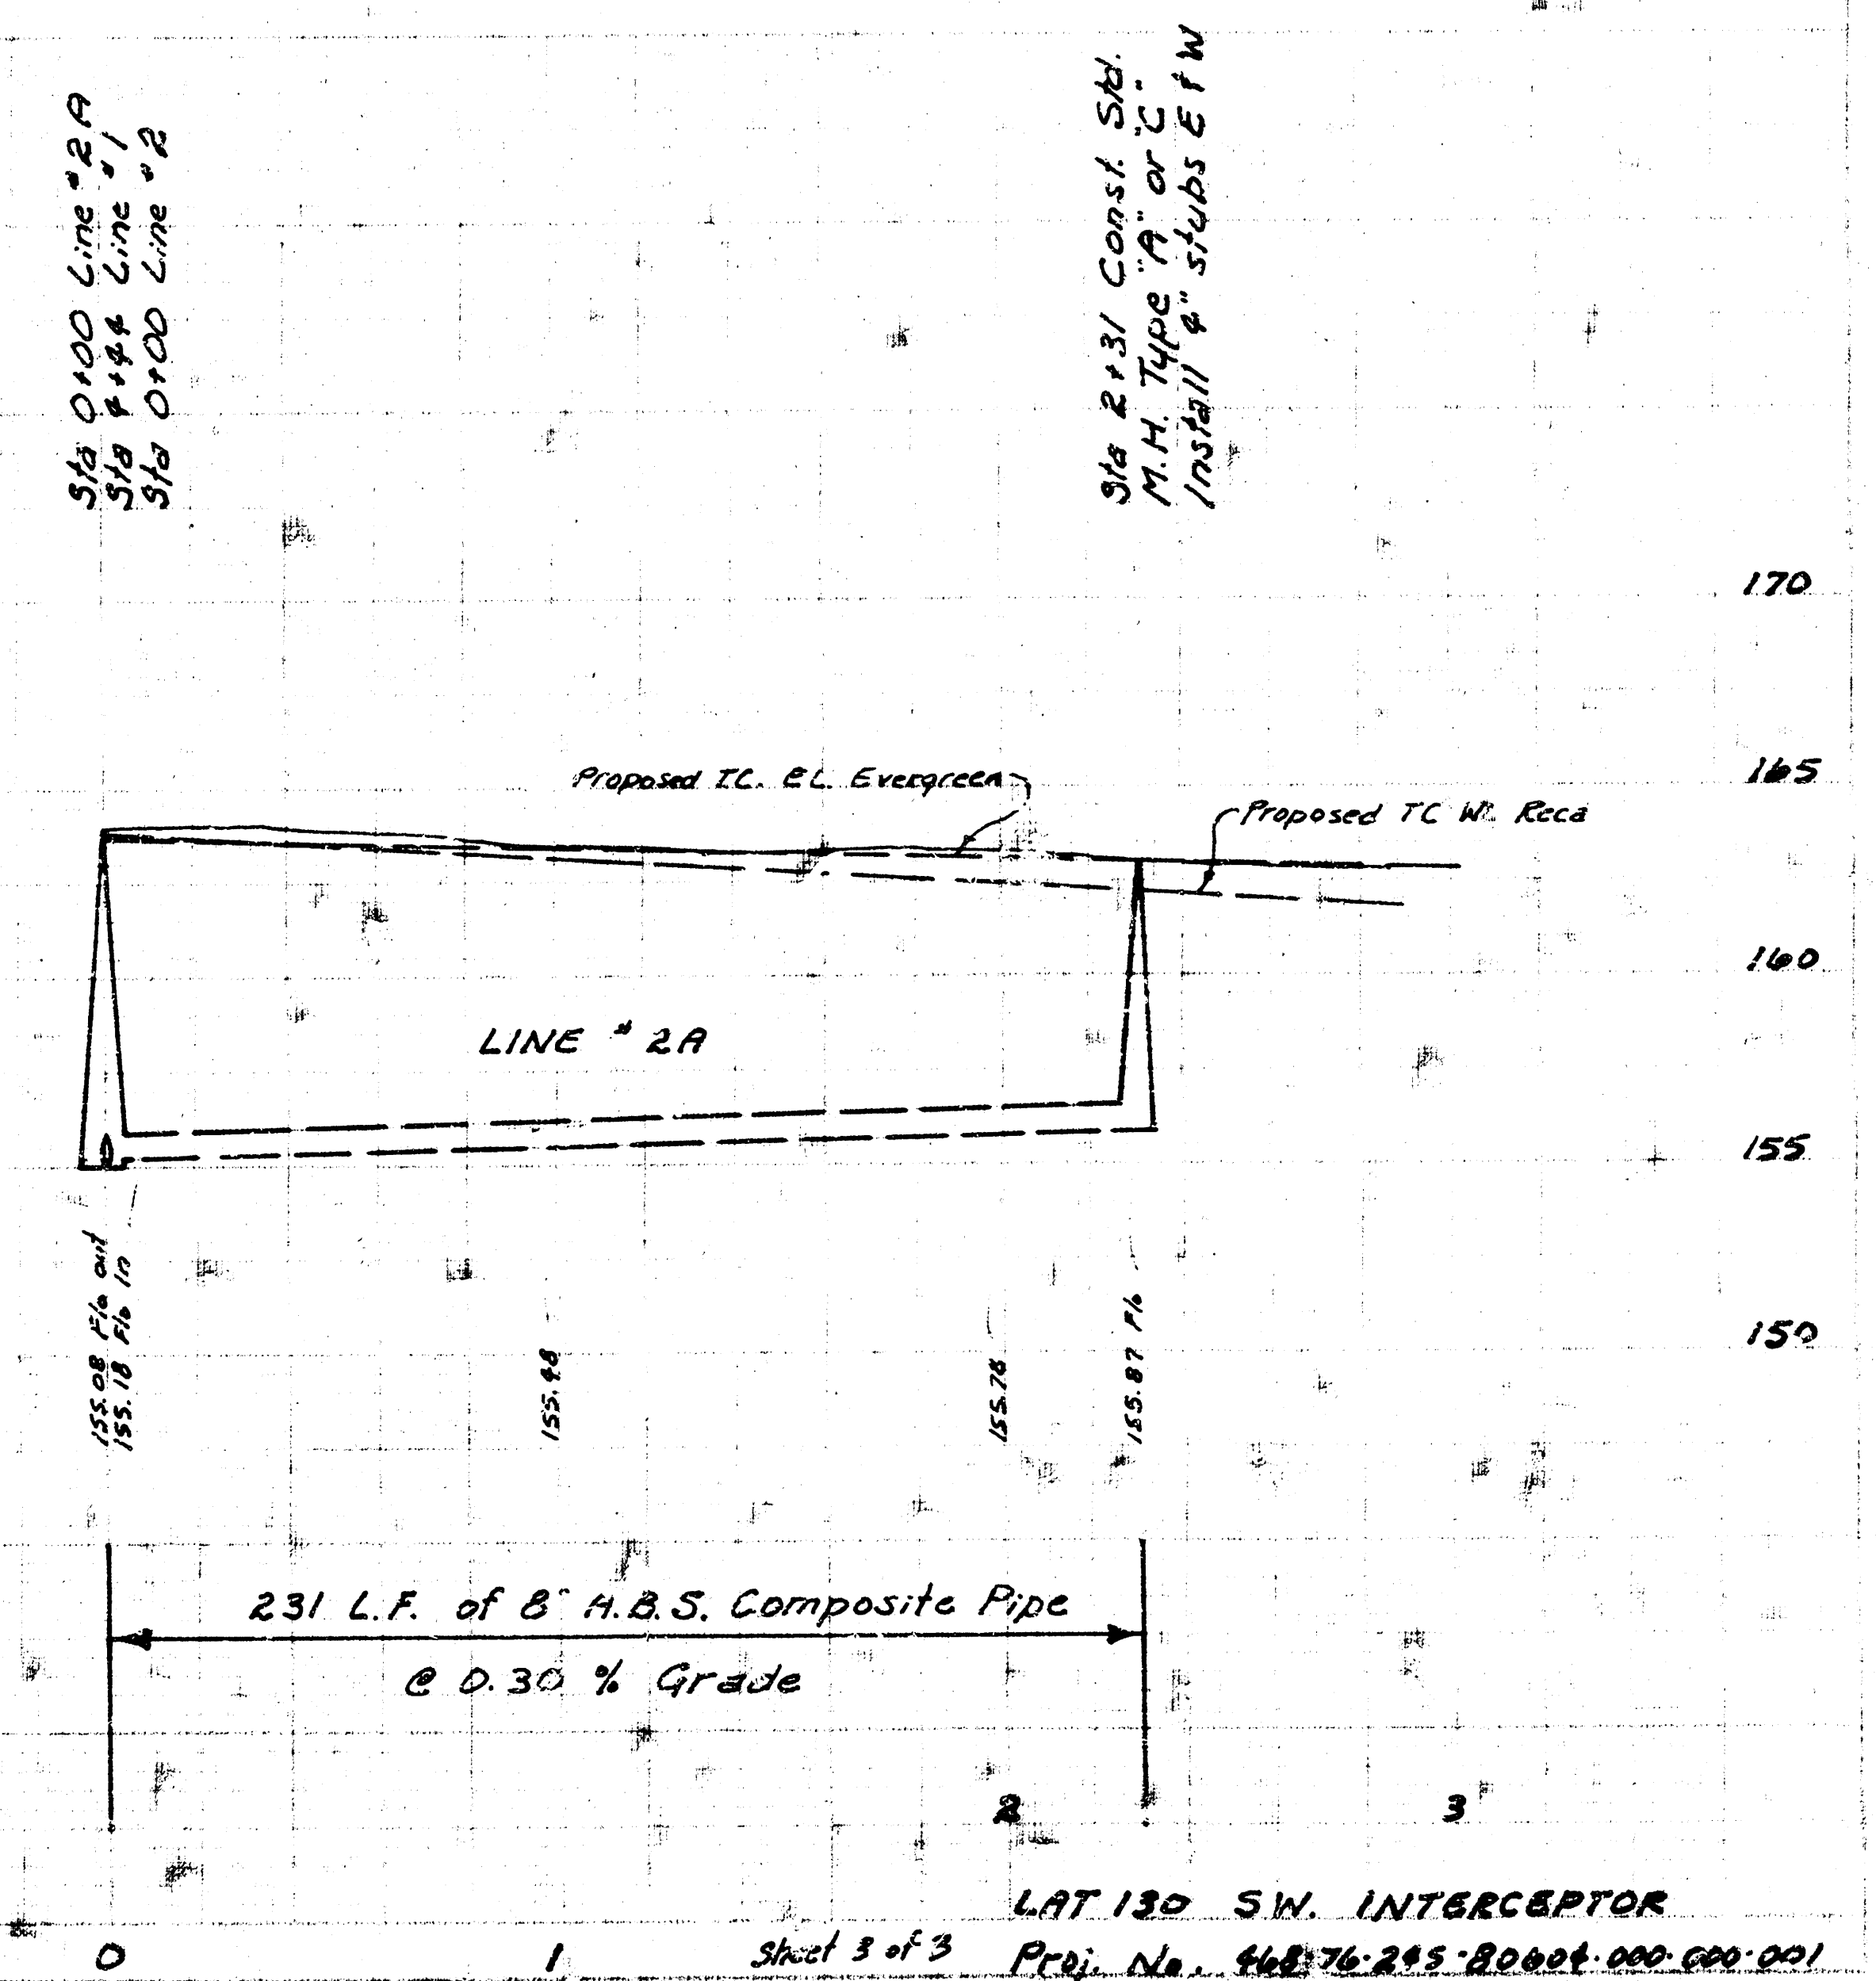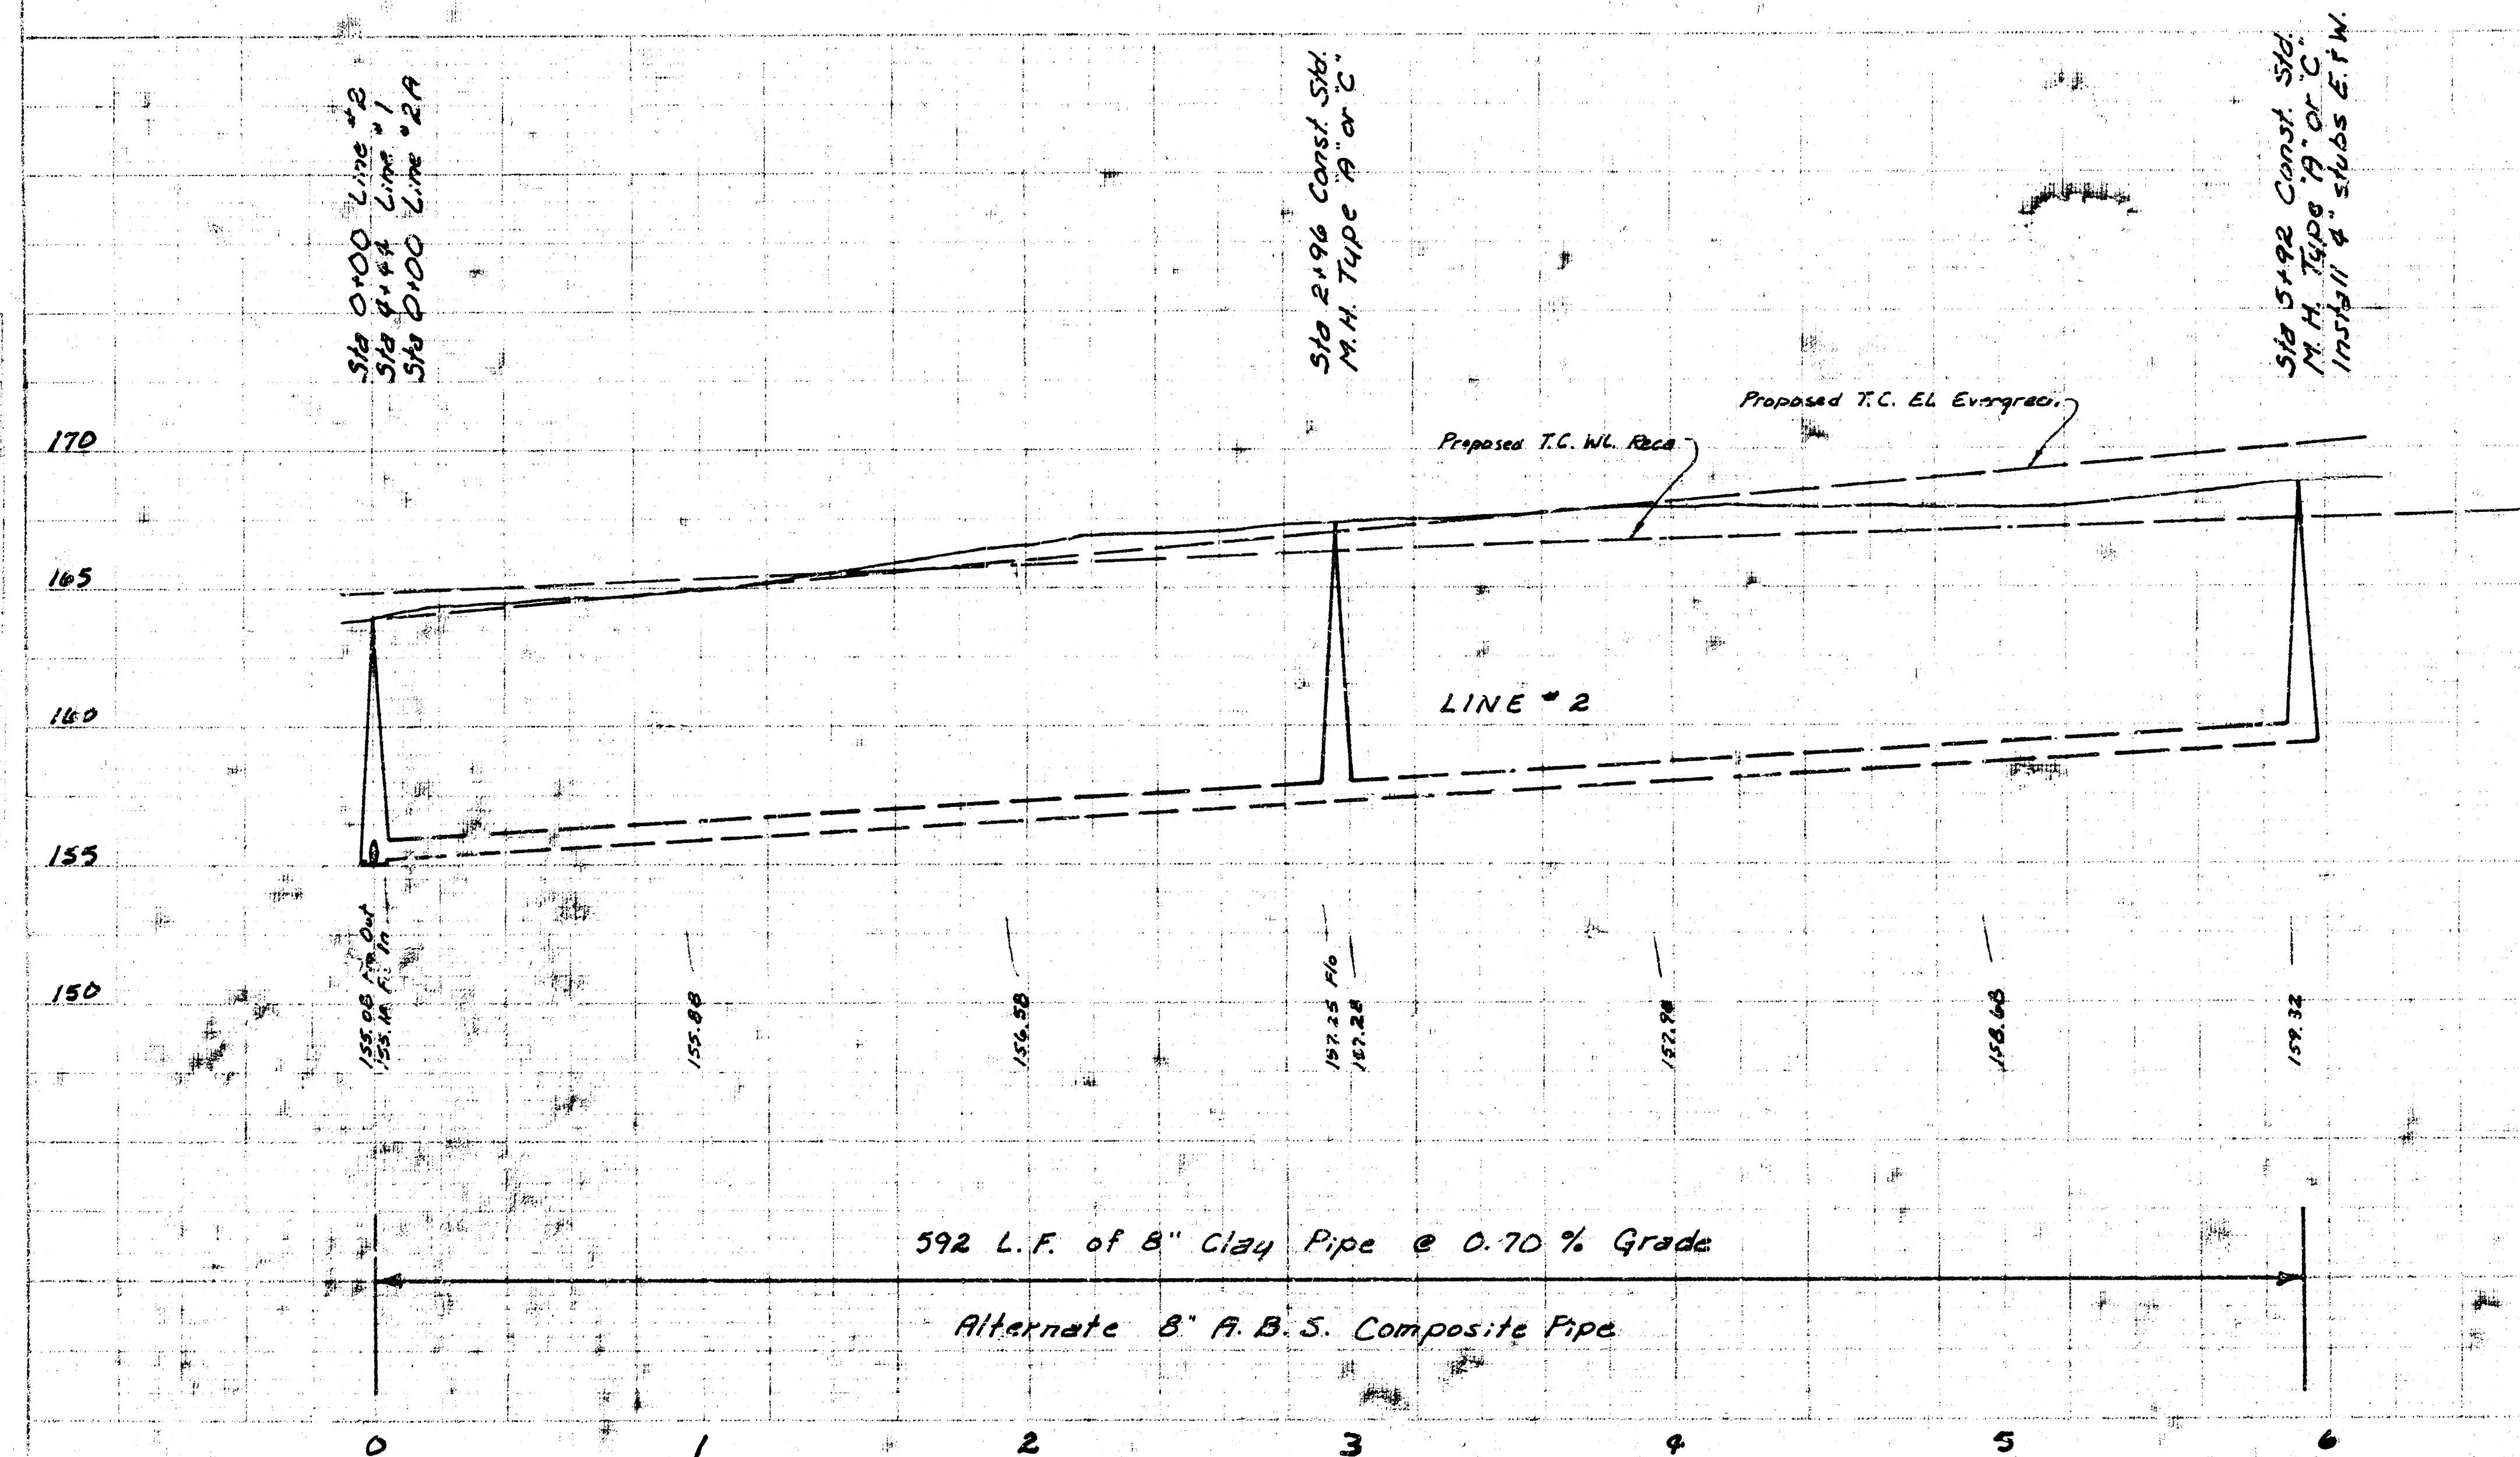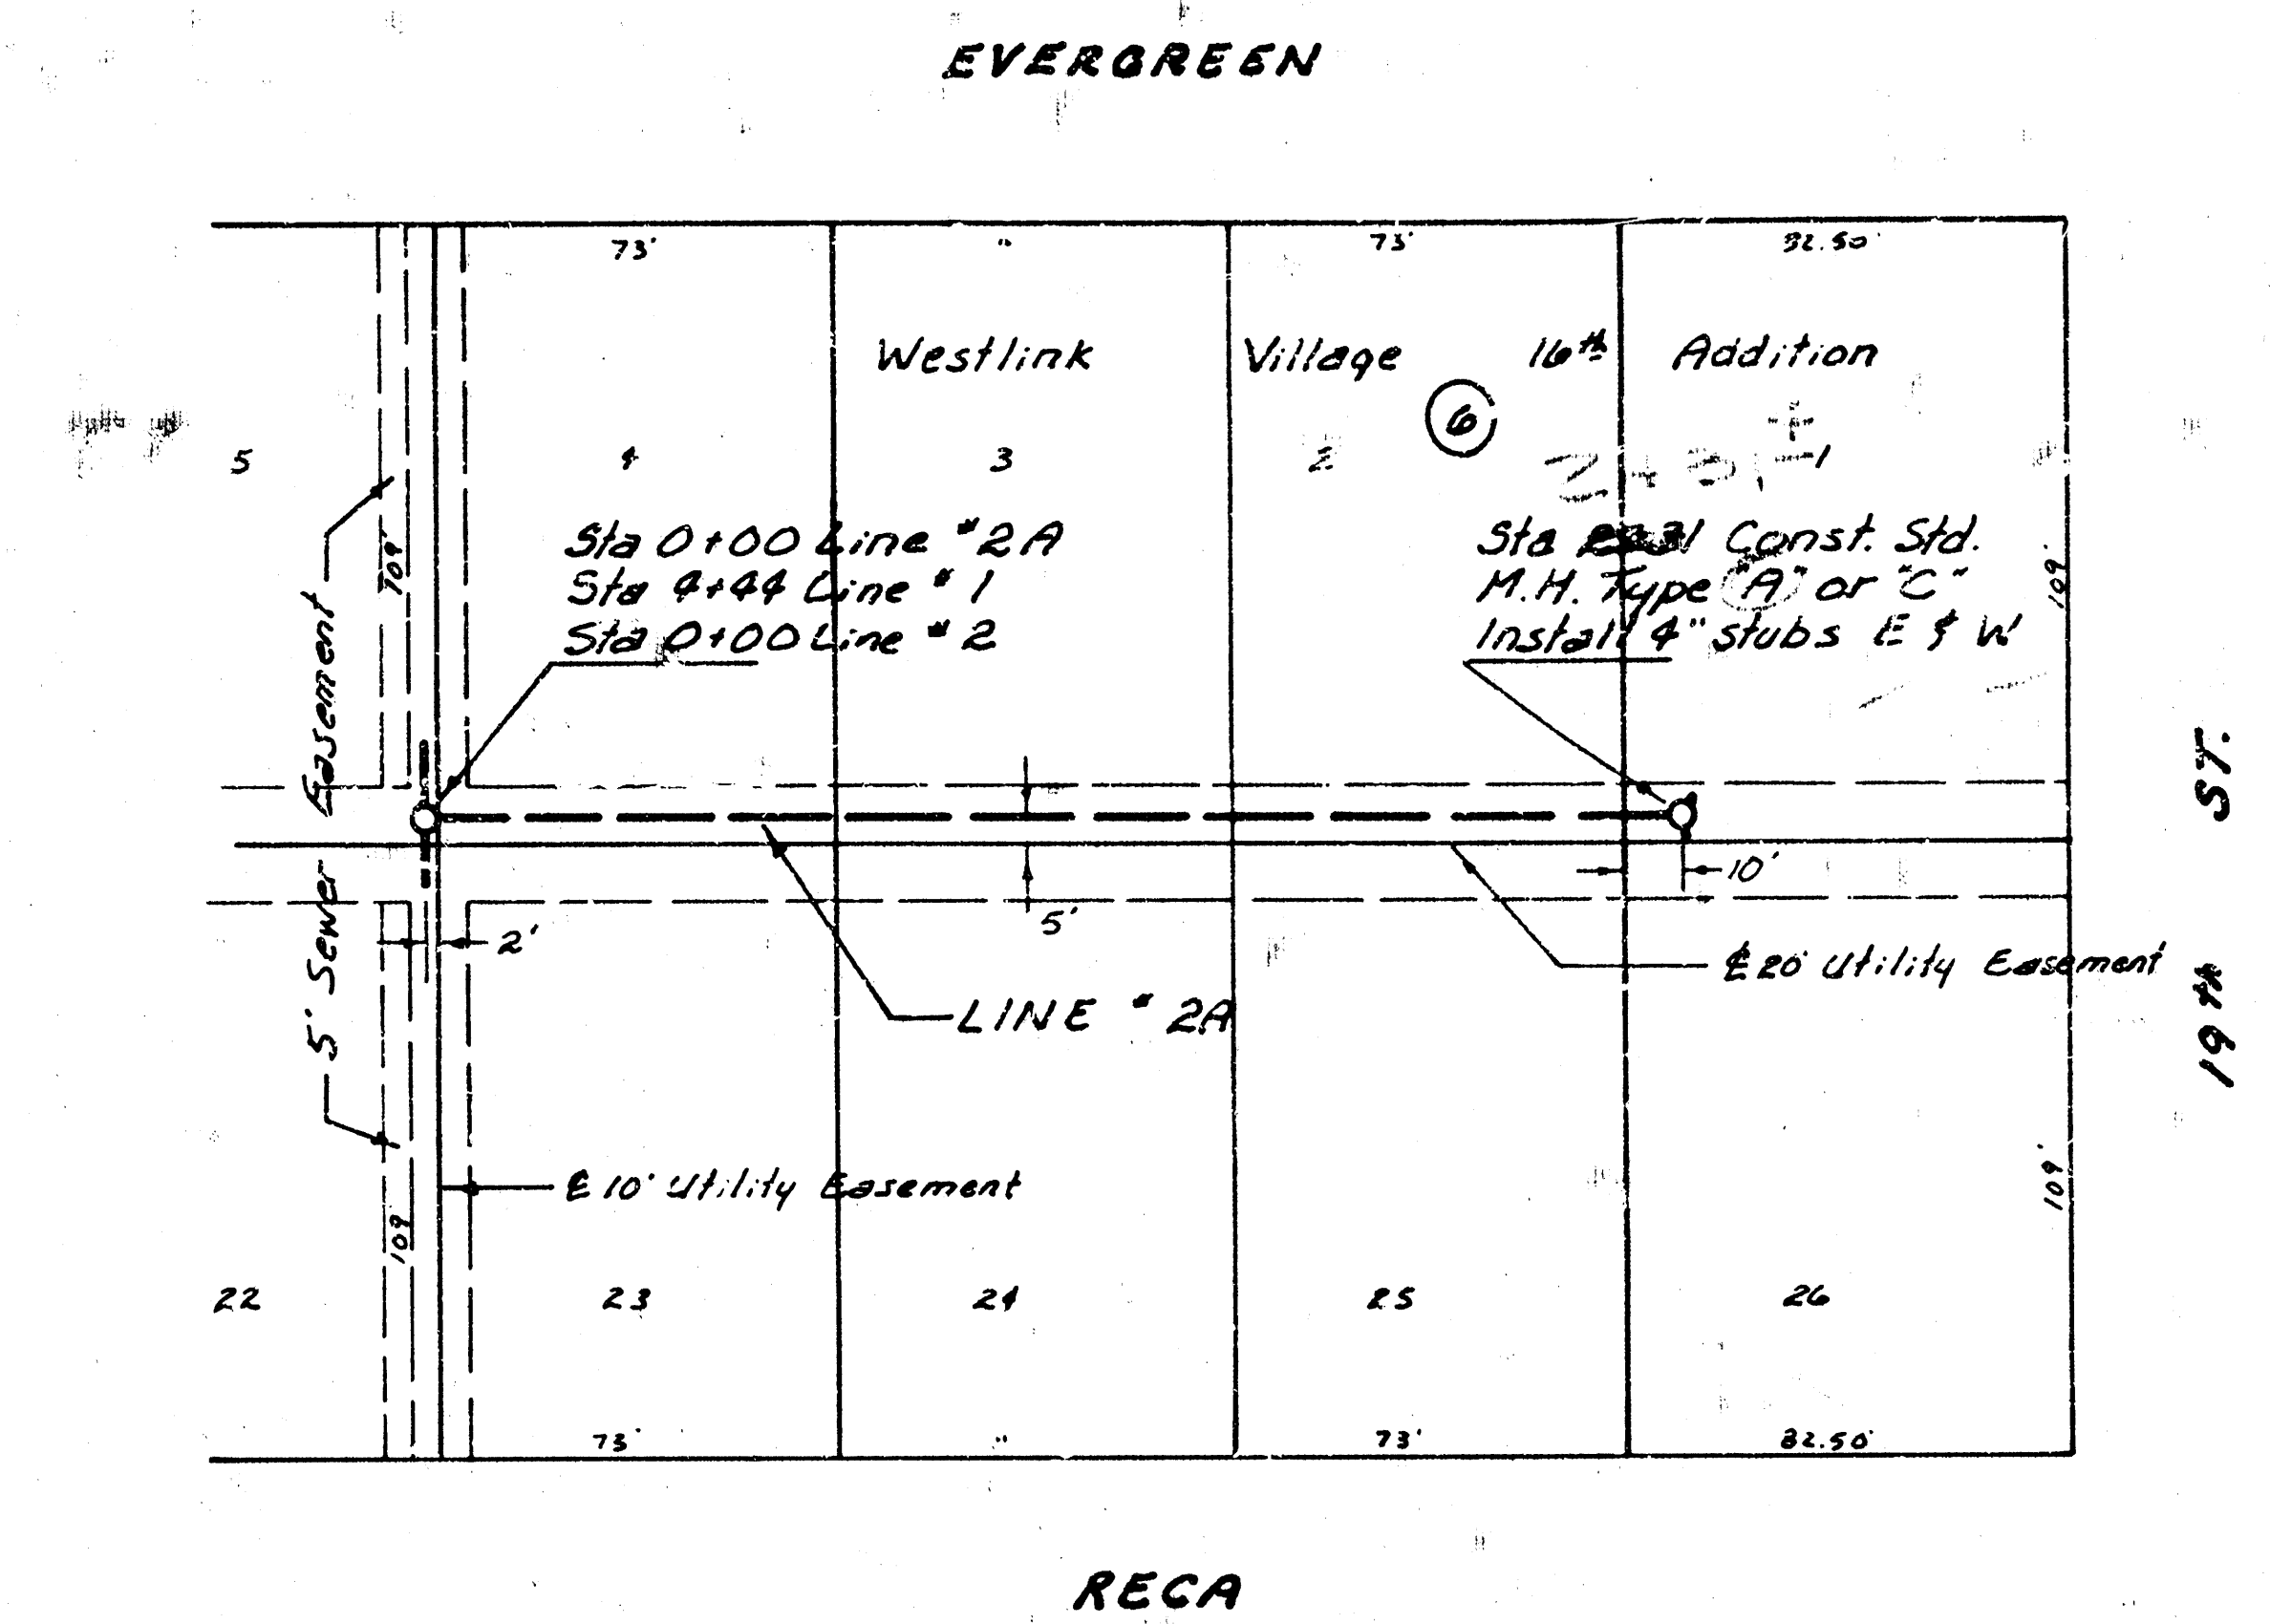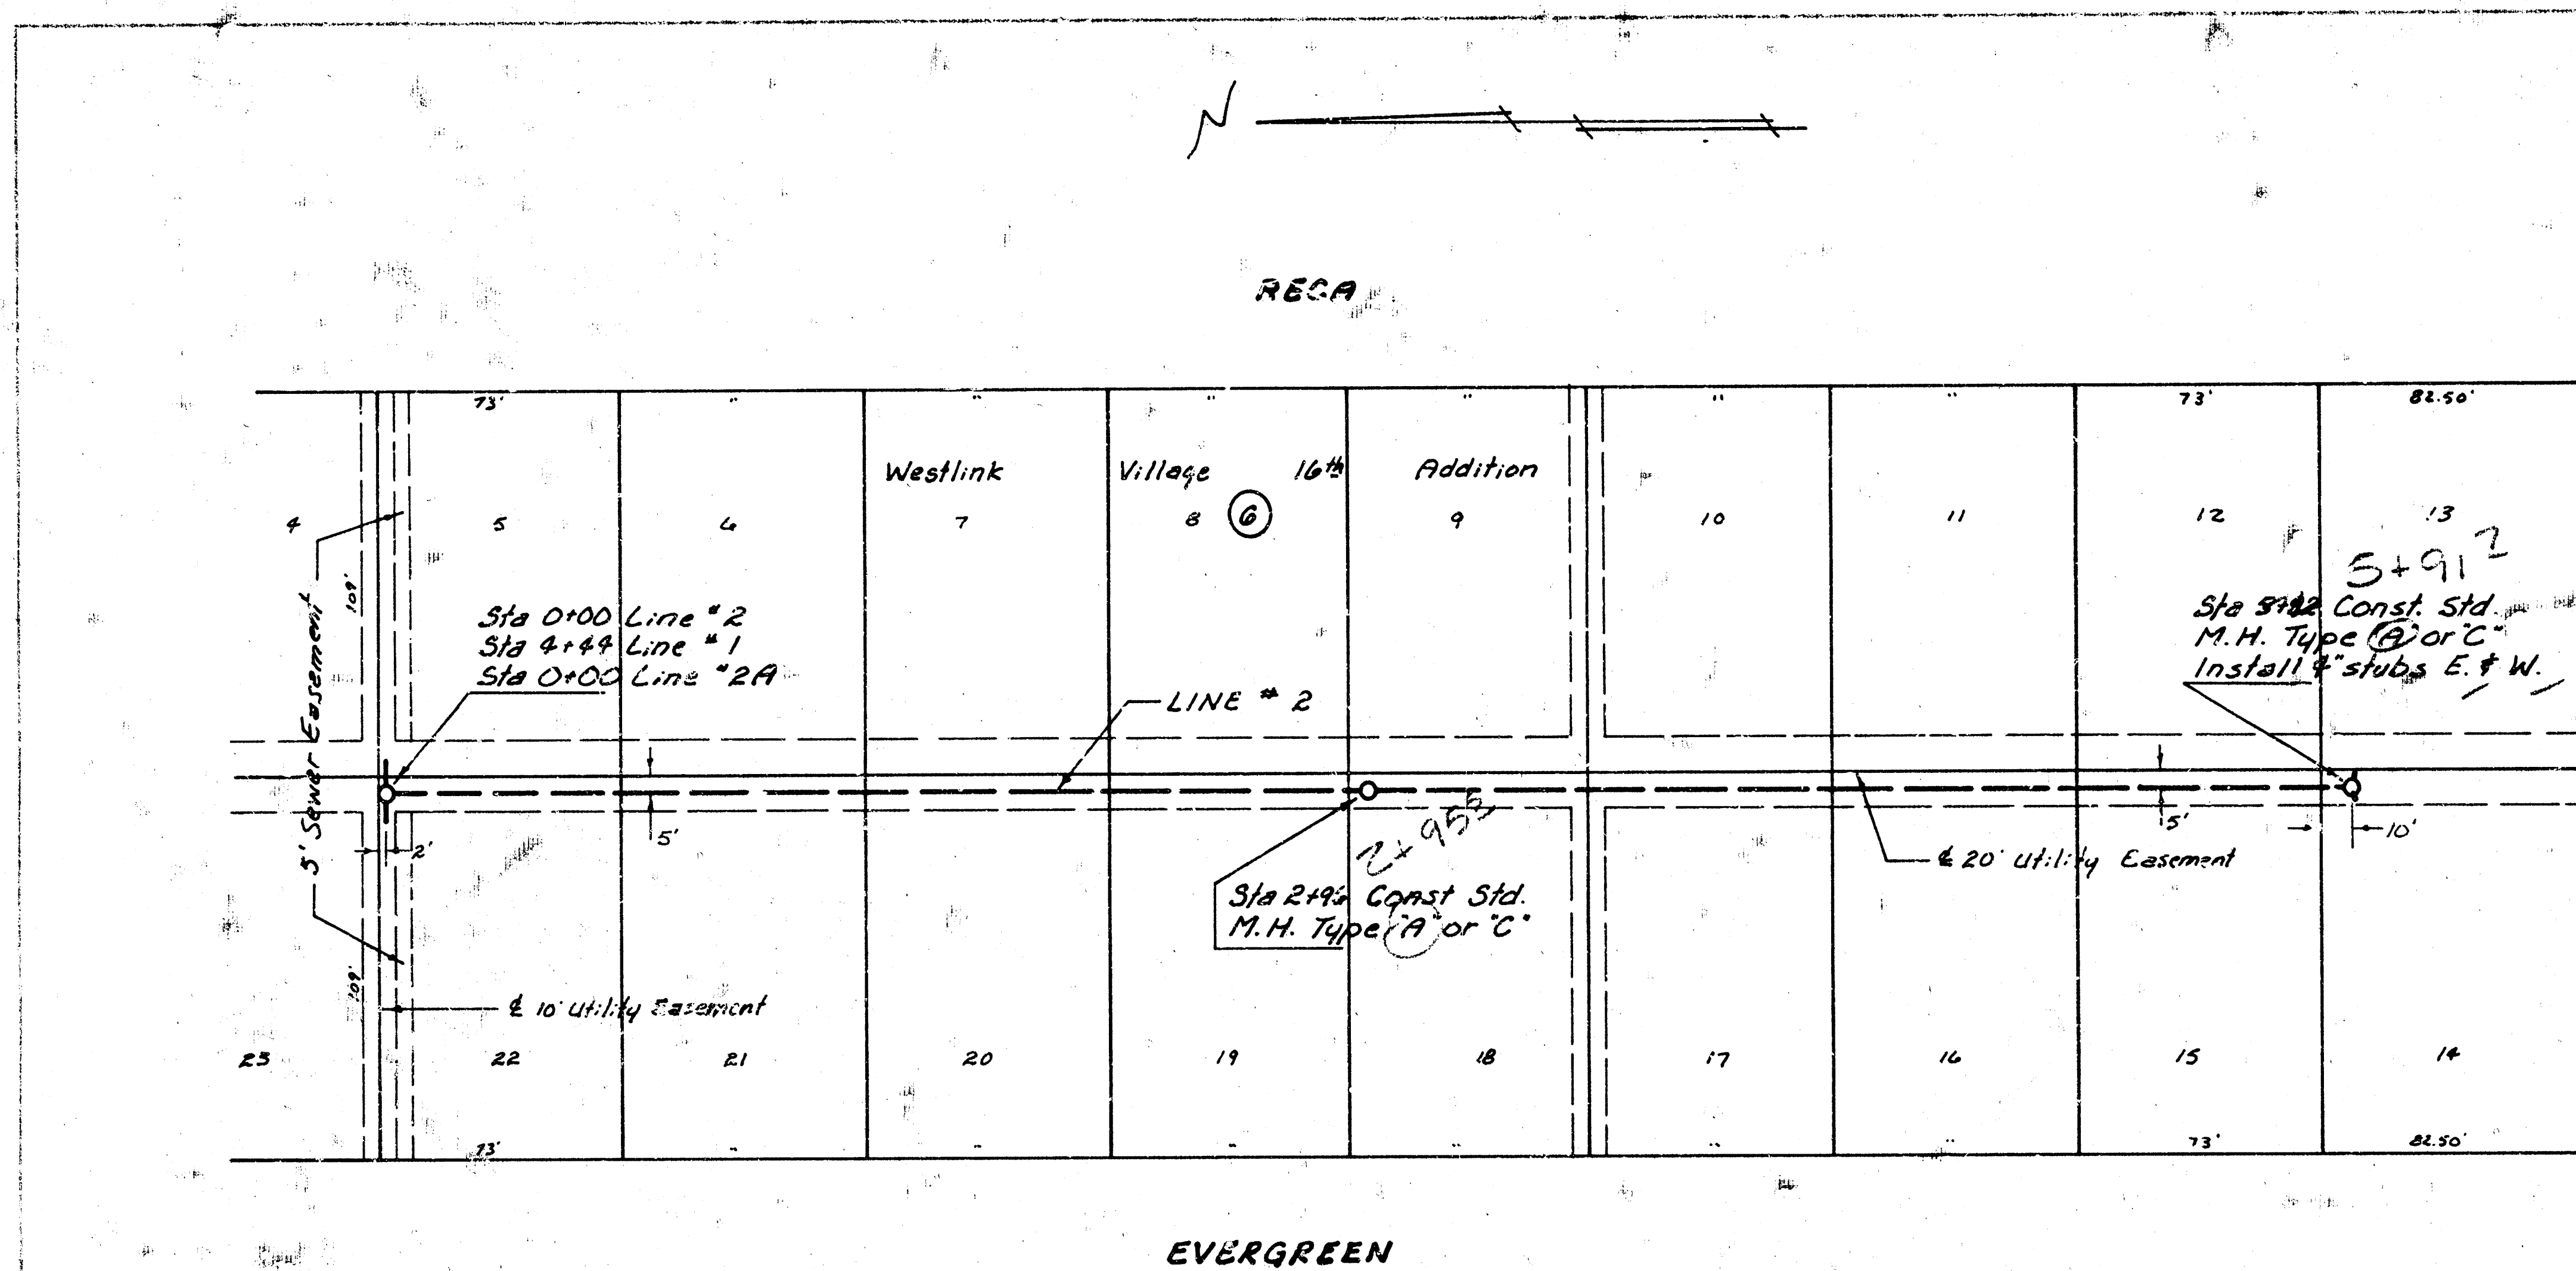

LAT 130 SW. INTERCEPTOR

Sheet 3 of 3 Proj. No. 44276-203-2000-000-001