
N


Scale Plan 1" = 40'
Profile 1" = 40' Horz.
1" = 5' Vert.

TURQUOISE

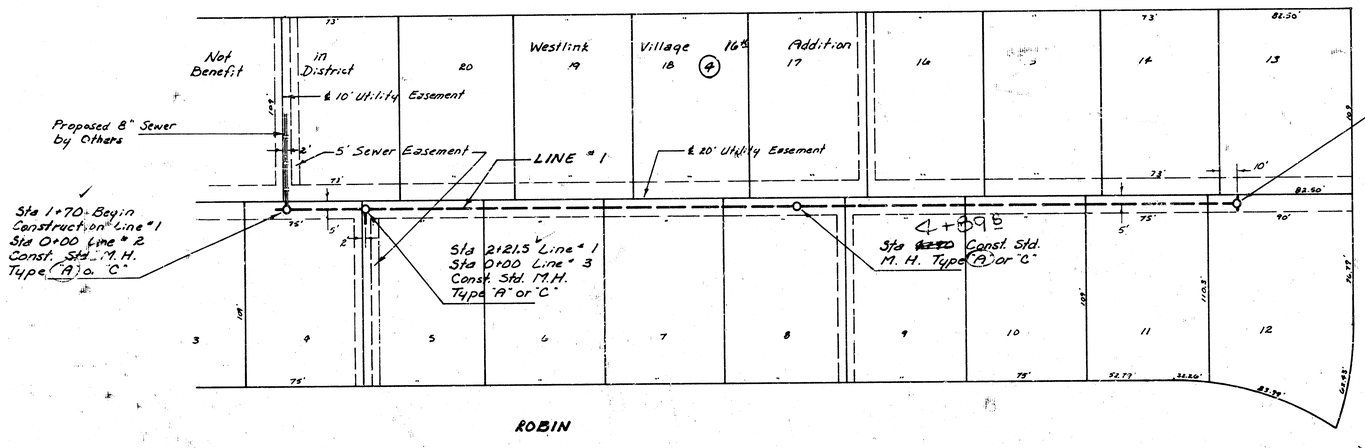

B.M. 156.19 City Std. Disc. 42.3 ft. E & 44 ft. N. of ¼ Sec. corner at Country Acres Ave and 13th St.
B.M. 172.92 City Std. Disc. 31 ft. S. and 36 ft. E. of ¼ Sec. corner at Tyler Road and 17th St.


PROFILE

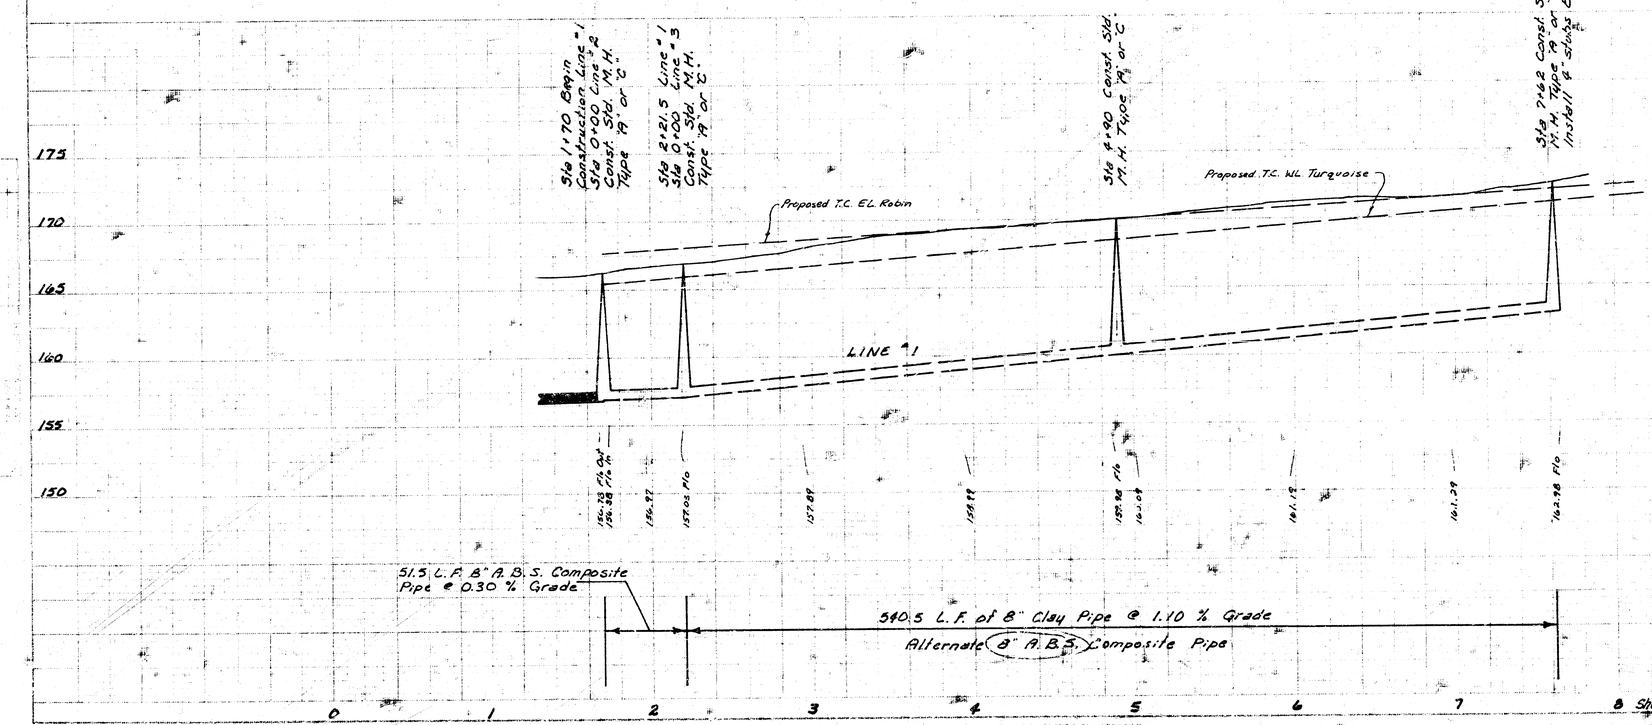


As Built
D 259
Les 21

LAT 131, SW. INTERCEPTOR SEWER
CITY OF WICHITA, KANSAS
R. W. LINN — CITY ENGINEER
DATE PROJ. NO. 468-76-245-80603-000-000-001

Sheet 1 of 2

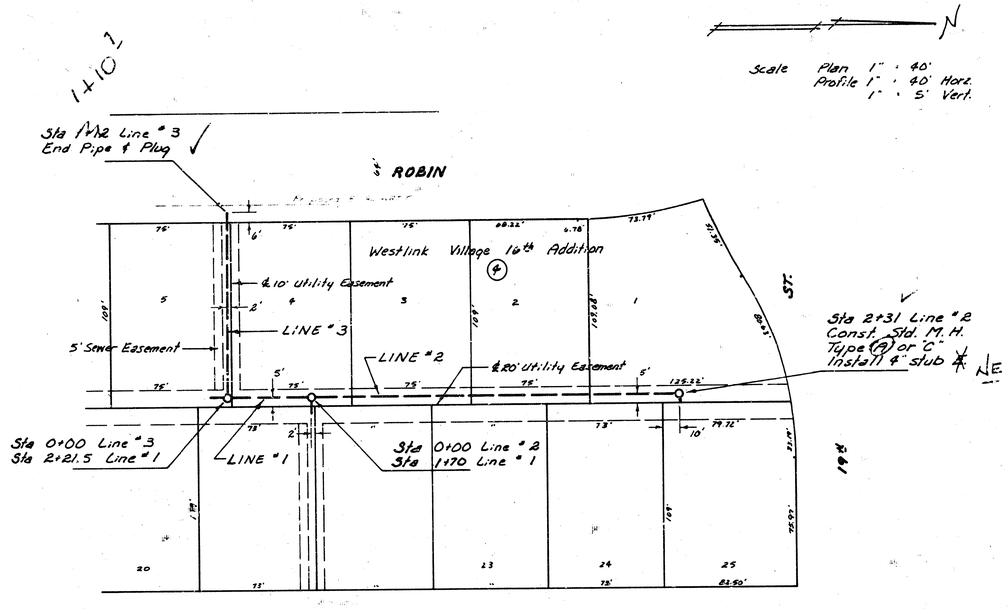

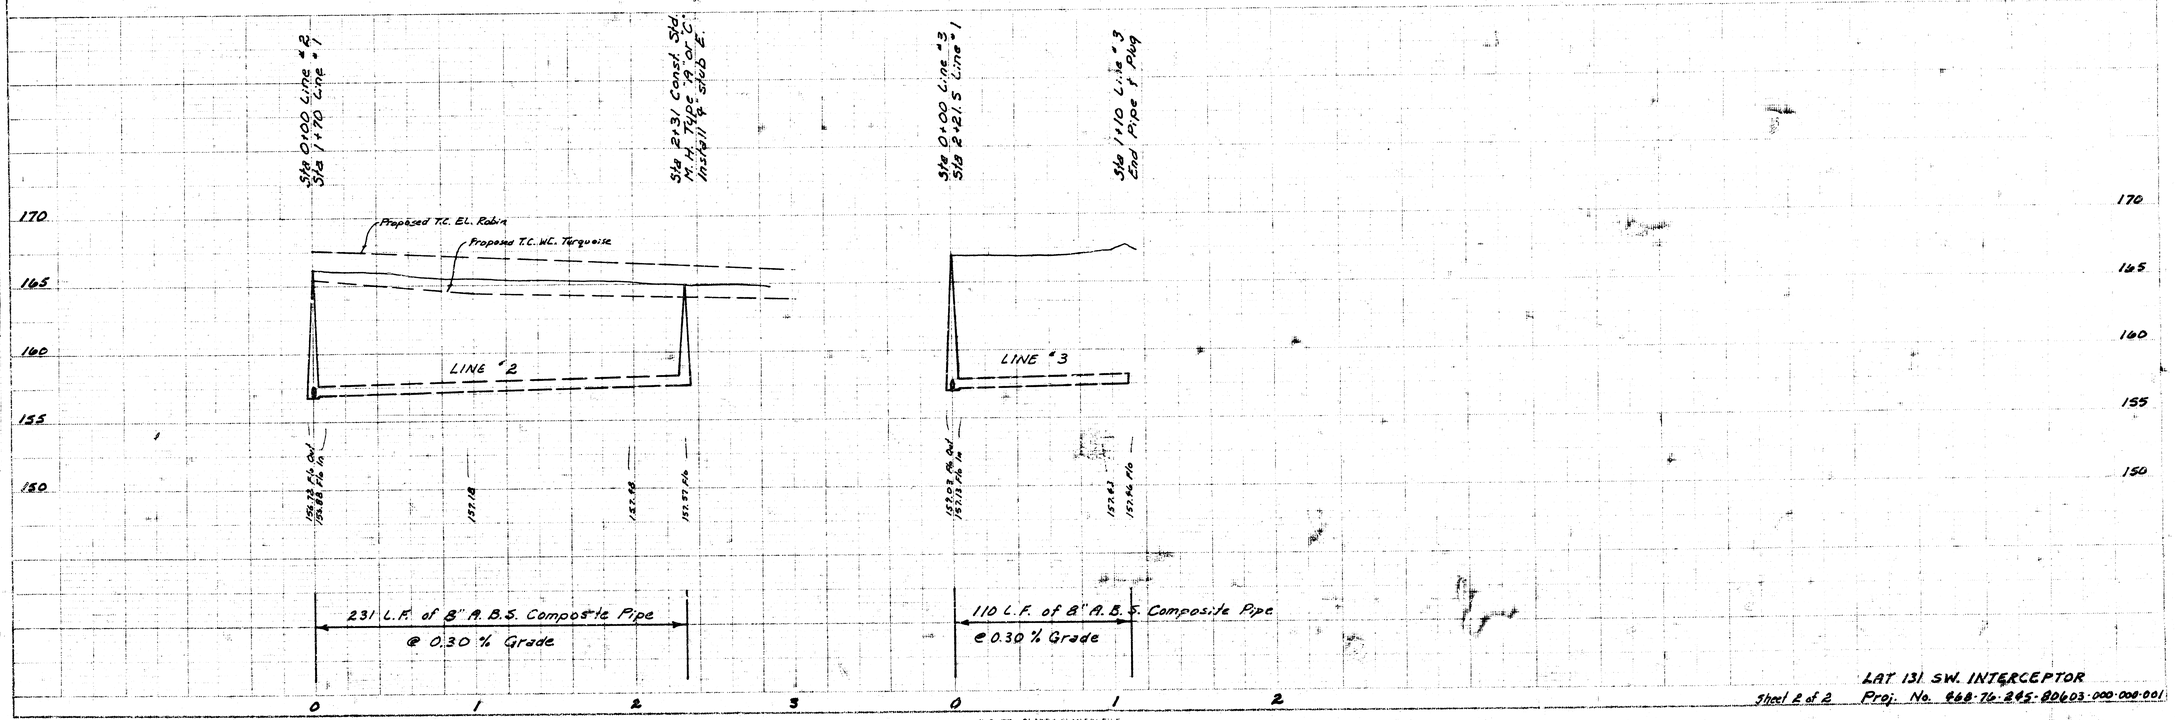

PLAN

PROFILE

PLATE 1, PLAN-PROFILE
KOEPPEL & GERR CO.

LAT 131 SW. INTERCEPTOR

14-8-5-1e