· WESTLINK VILLAGE 16TH ADD'N ·

SOCORA

RECA

17TH ST.

Not in Benifit District (Lots 20 & 21)

Not in Benifit District (Lots 1 & 5)

Sta 0+00 Line 1, Begin 8" Pipe at 8" Stub S., of Existing M.H.

Existing M.H.

Line 1

Line 2

Sta 2+80 Line 1 Const. Std. M.H. Type ~~A~~ C

Sta 5+57 Line 1 Const. Std. MH, Type ~~A~~ C; Install 4" Stubs; SW, SE

Existing 8" A.B.S. Comp. Pipe @ 0.30 % Grade

10' UT. EASEM'T

5' SEWER EASEM'T

20' UTILITY EASEM'T

5'

2'

8'

64'

78'

80'

90'

103'

N0° 00'E

4 5 6 7 8 9 10 11 12

13 14 15 16 17 18 19 20 21

7

CAUTION
UNDERGROUND UTILITIES
Please check with K.G.& E. or Southwestern Bell Telephone Co. for Location

N

Scale: 1" = 40' Plan
Horz. 1" = 40' Profile
Vert. 1" = 5'

⊙ — Irons —

B.M. : 172.479 — City Std. Disc, 31' S. & 36' E. of 1/4 Sec. Corner ; TYLER RD. & 17TH ST. N.

Sta 0+00 Line 1, Begin 8" Pipe at 8" Stub S., of Existing M.H.

Sta 2+80 Line 1, Const. Std. M.H.; Type A or C

Sta 5+57 Line 1, Const. Std. M.H.; Type A or C; Install 4" Stubs; SW, SE.

E. Top of Curb - RECA

Existing Ground

Proposed W. Top of Curb - SOCORA

163.59 S.Rim

Line 1

165 160 155 150 145

Existing M.H. Flo. 154.10
8" Stub Line 1 Flo In 154.13
8" Stub Line 2 Flo In 154.18

154.53 154.93 Flo 155.25 155.33 155.73 156.13

Flo Out 156.36 —
4" Stubs; Flo 156.69 —

280 Lin. Ft. of 8" A.B.S. Composite Pipe @ 0.40% Grade

277 Lin. Ft. of 8" A.B.S. Composite Pipe @ 0.40% Grade
Alternate Pipe - 8" P.V.C. or 8" V.C.P.

0 1 2 3 4 5

As Built
5/81
SSL

DONALD E. SCHNEIDER
LICENSED
6311
KANSAS
PROFESSIONAL ENGINEER

LATERAL 132, S.W.I.
CITY of WICHITA, KANSAS

R.W. BRUGGEMAN : DIRECTOR OF ENGINEERING / CITY ENGINEER—


Proj. No. 468-76-245-80602-000-000-001


DATE:


Line 1


1/2

WESTLINK VILLAGE 16TH ADD'N

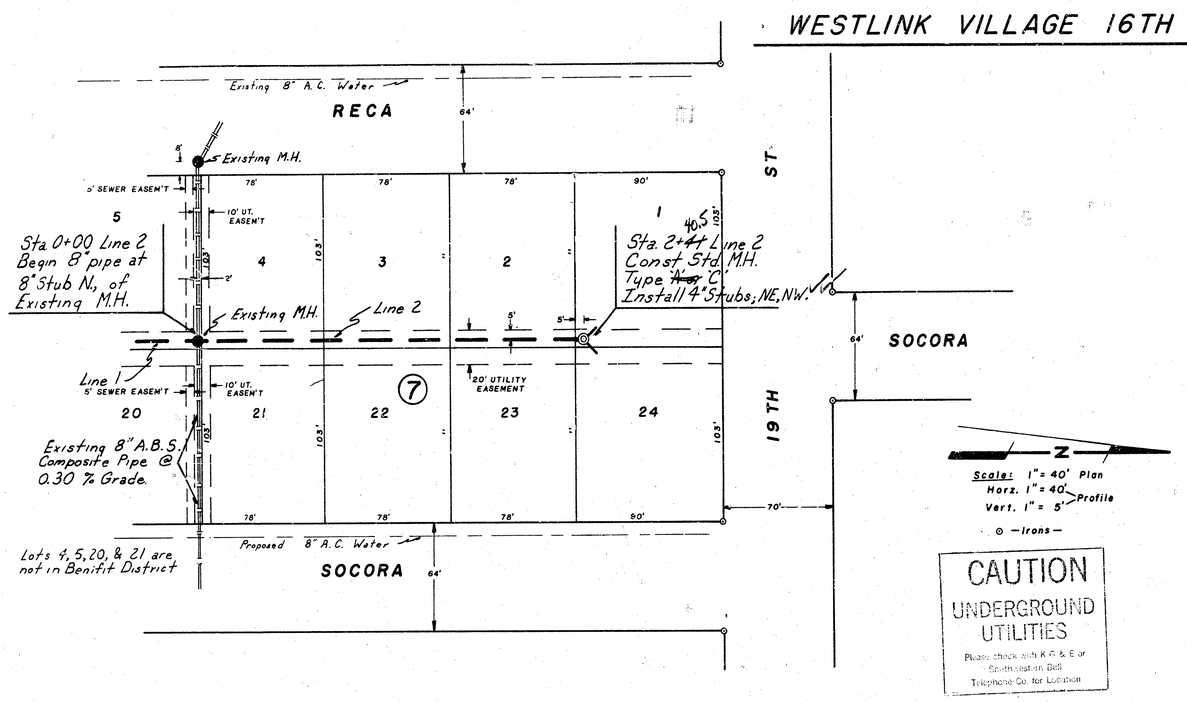

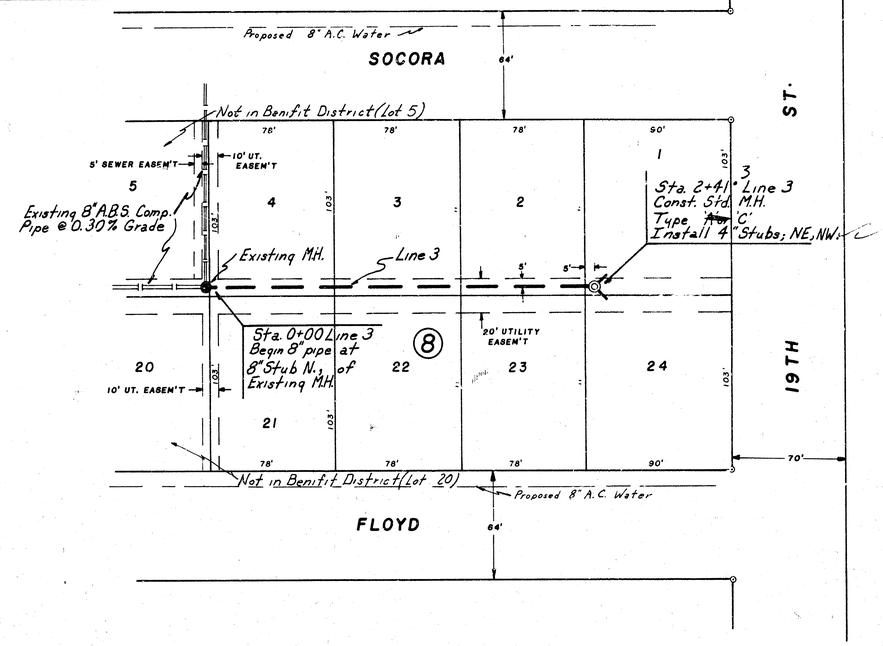

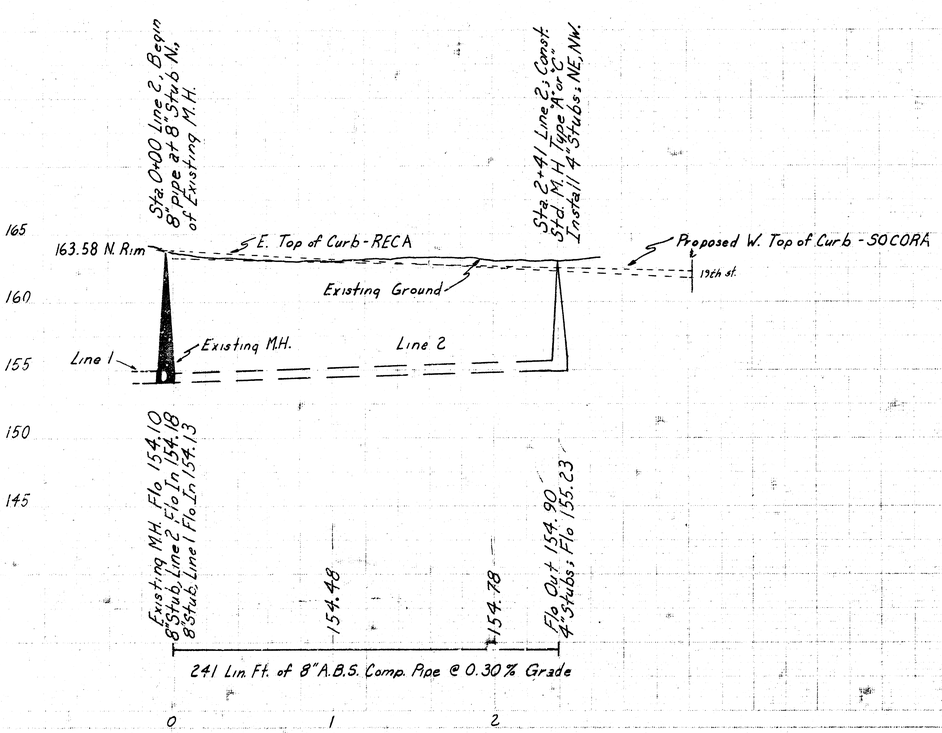

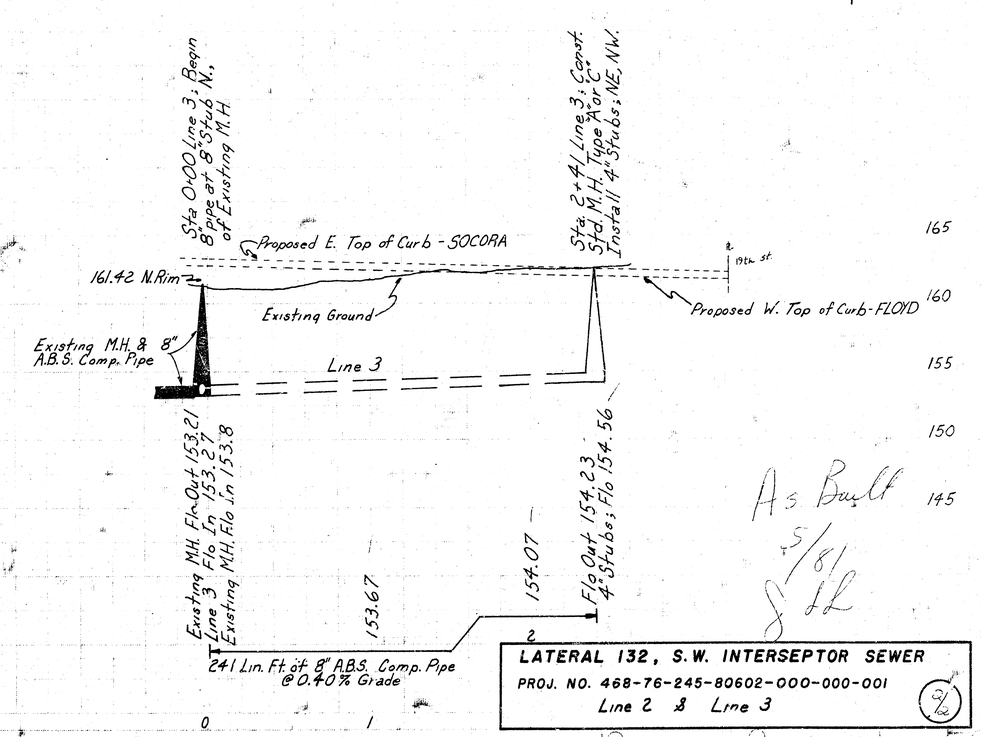

As Built
5/81
SL

LATERAL 132, S.W. INTERSEPTOR SEWER
PROJ. NO. 468-76-245-80602-000-000-001
Line 2 & Line 3
2/2