


Scale. Plan 1" = 40'
Profile 1" = 40' Horz
1" = 5' Vert.


B.M. 167.93 City Std. 48'E & 43'N. ℄'s Tyler & 13th St.
B.M. 171.43 R.R. Spike E. Face P.P. SW. Corner Tyler Rd & 19th St.
B.M. 172.43 City Std. 31'S. & 36'E. of ¼ Sec. corner Tyler & 17th St.
B.M. 173.22 "B" Top of Cb. in front of Conc. Wk. to Bell Tel. switch Box at NW corner of 17th & Robin.

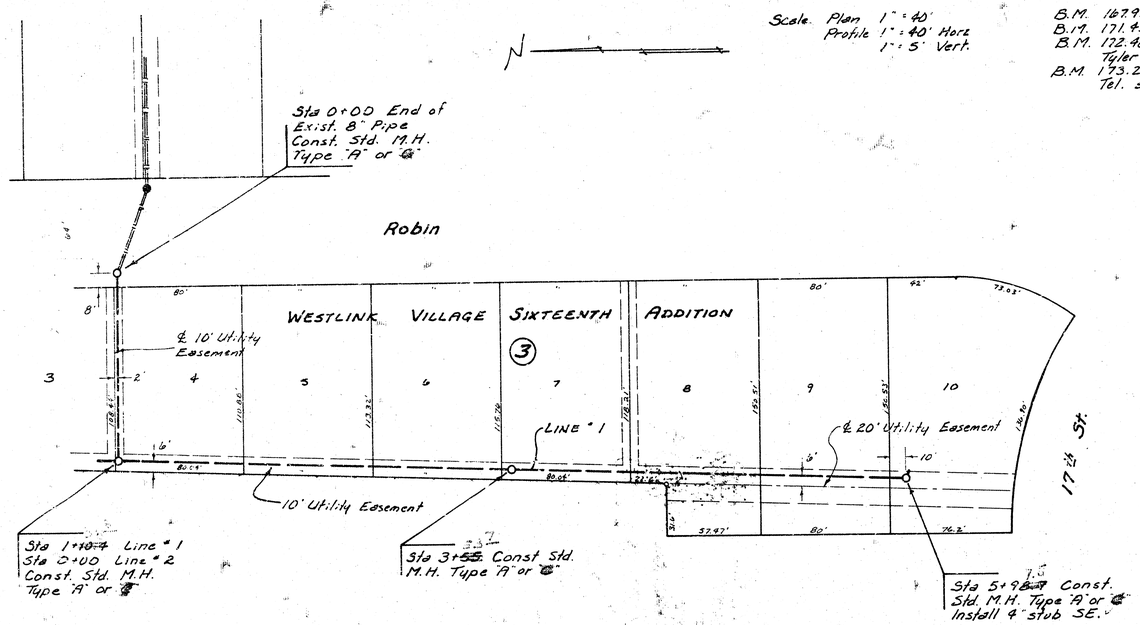

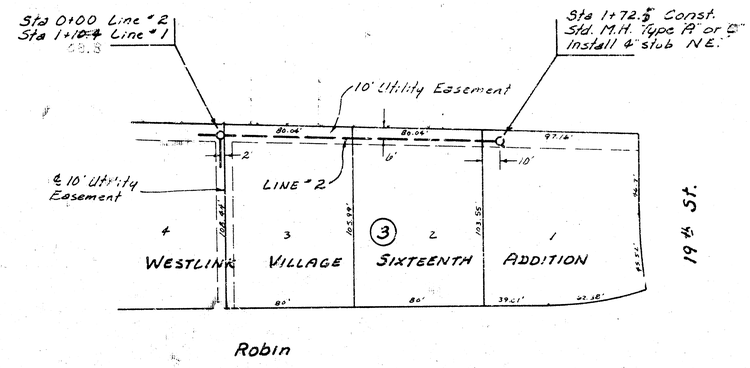

NOTE: TOPS OF MANHOLES SHALL BE SET TO MATCH PROPOSED FINISHED GRADE AS DETERMINED BY THE DEVELOPER UNLESS SHOWN OTHERWISE BY PLANS.

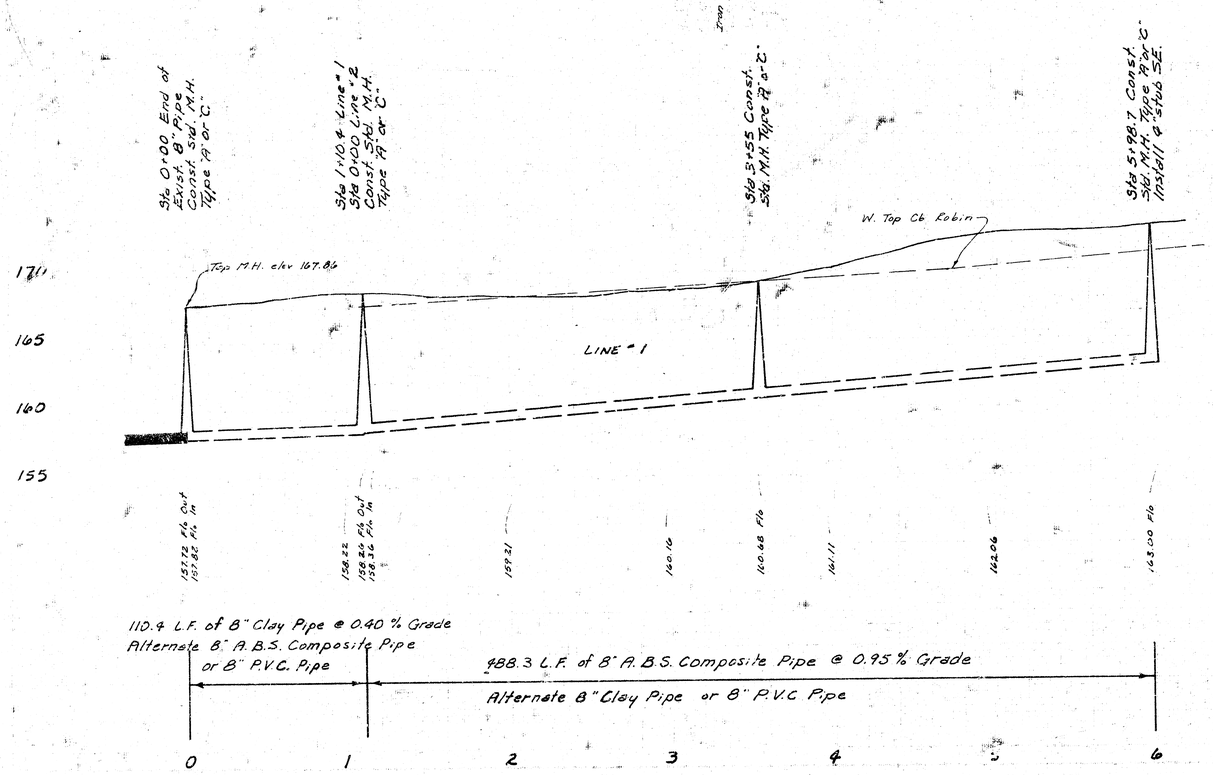

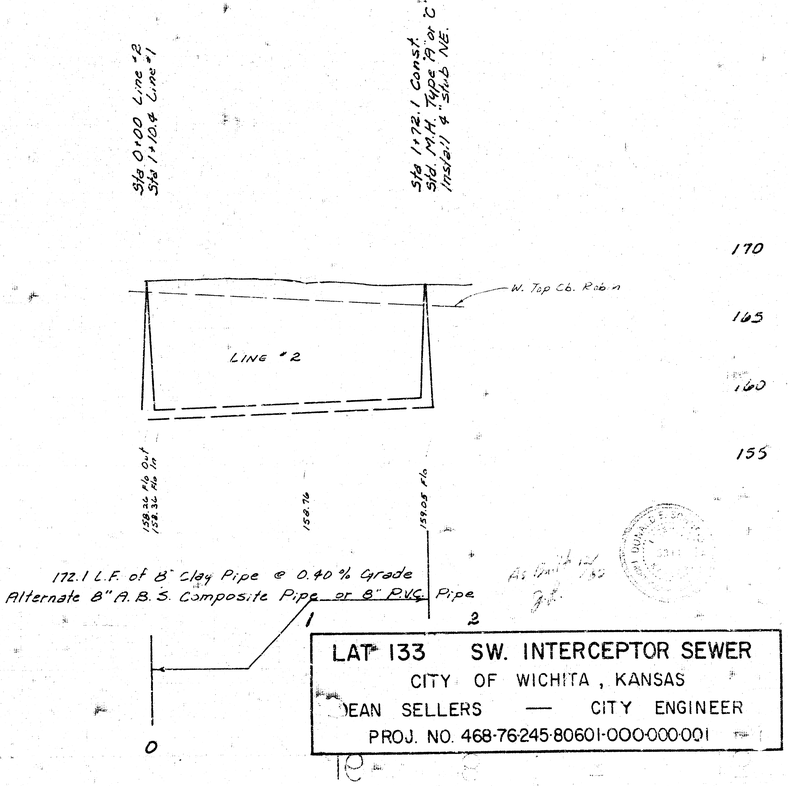

LAT 133 SW. INTERCEPTOR SEWER
CITY OF WICHITA, KANSAS
DEAN SELLERS — CITY ENGINEER
PROJ. NO. 468-76245-80601-000-000-001

FILMED FROM THE BEST