


LATERAL 142 SANITARY SEWER 22

PROJECT NO.

468-76-245-81315-000-000-001

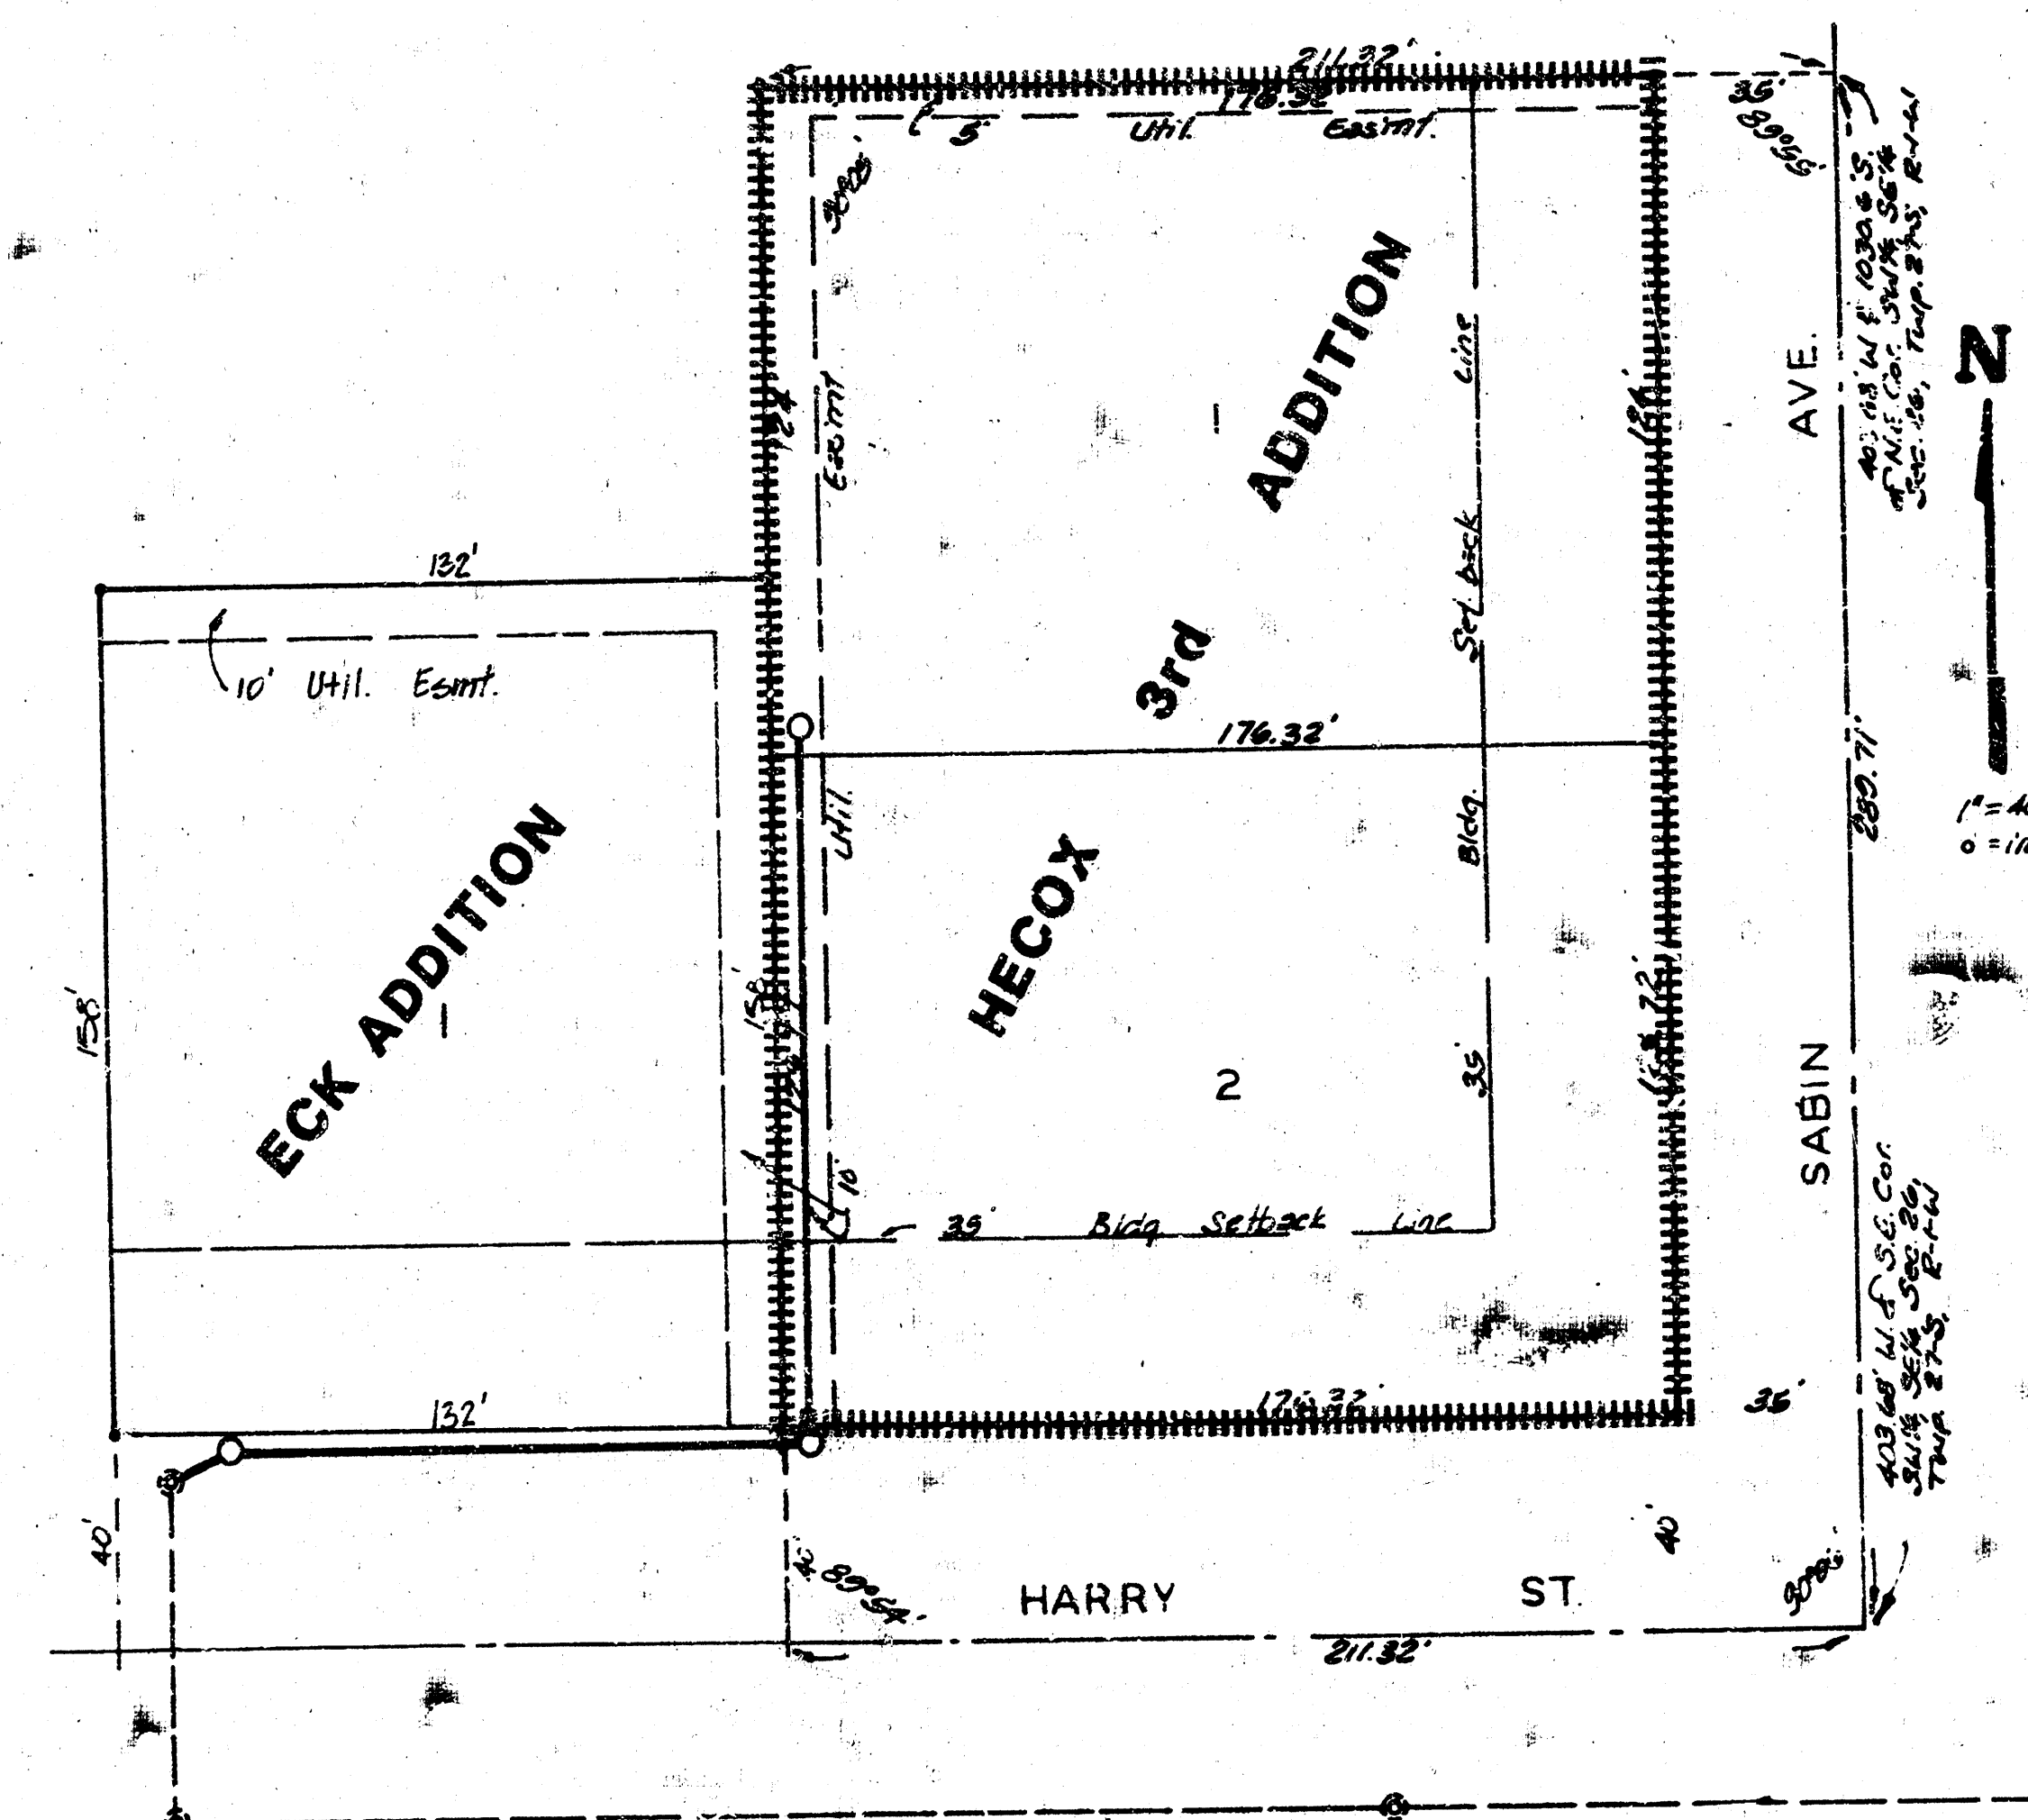


BENEFIT DISTRICT

GENERAL NOTES

1. The contractor shall be responsible for preserving property irons. The contractor shall be required to re-establish any property irons which are damaged or destroyed by his construction operations. Such irons shall be re-established by a licensed land surveyor or a licensed professional engineer in accordance with state laws.
2. The contractor shall contact the utility companies prior to any excavation to arrange for field location of underground lines.
3. The contractor shall contact Eck and Eck Machine Co. prior to any work, to coordinate closing of driveway at 4530 W. Harry.



CITY OF WICHITA, KANSAS
MICHAEL E. LINDEBAK CITY ENGINEER

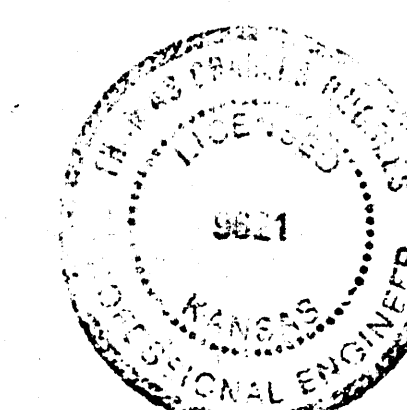


BAUGHMAN COMPANY, P.A.
 SURVEYING & ENGINEERING
 316/262-7271 • 330 LAURA • WICHITA, KANSAS 67211

FILMED FROM THE BEST
 AVAILABLE COPY

BENCH MARK: R.R. spike in North
side power pole, South side Harry
75' East of East line Sabin.
Elev = 113.68 City Datum

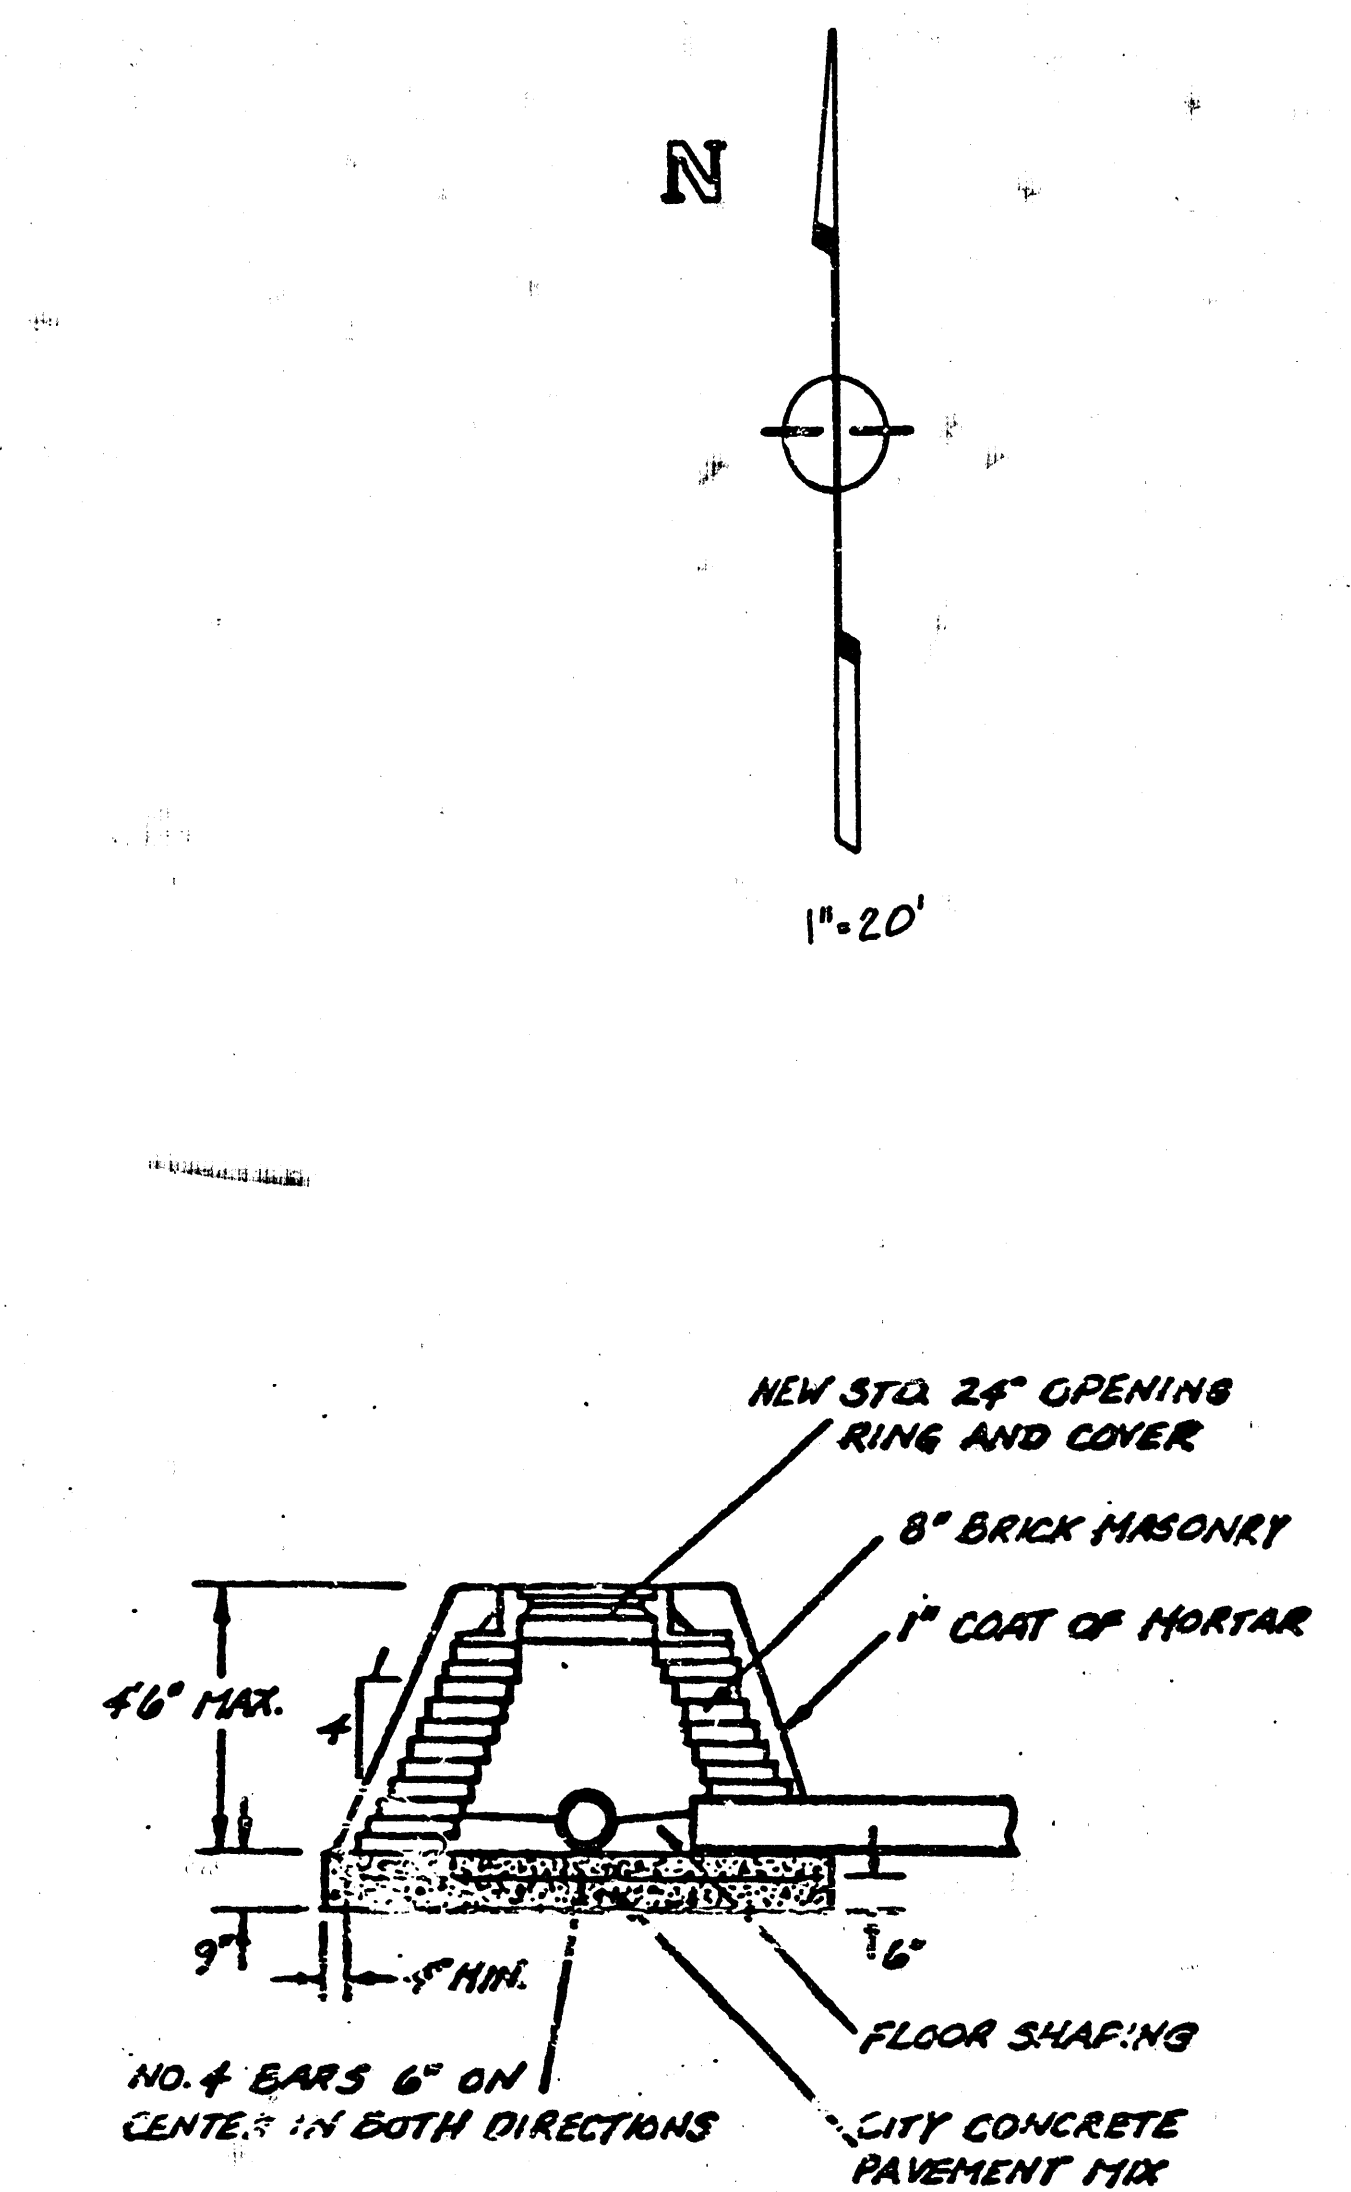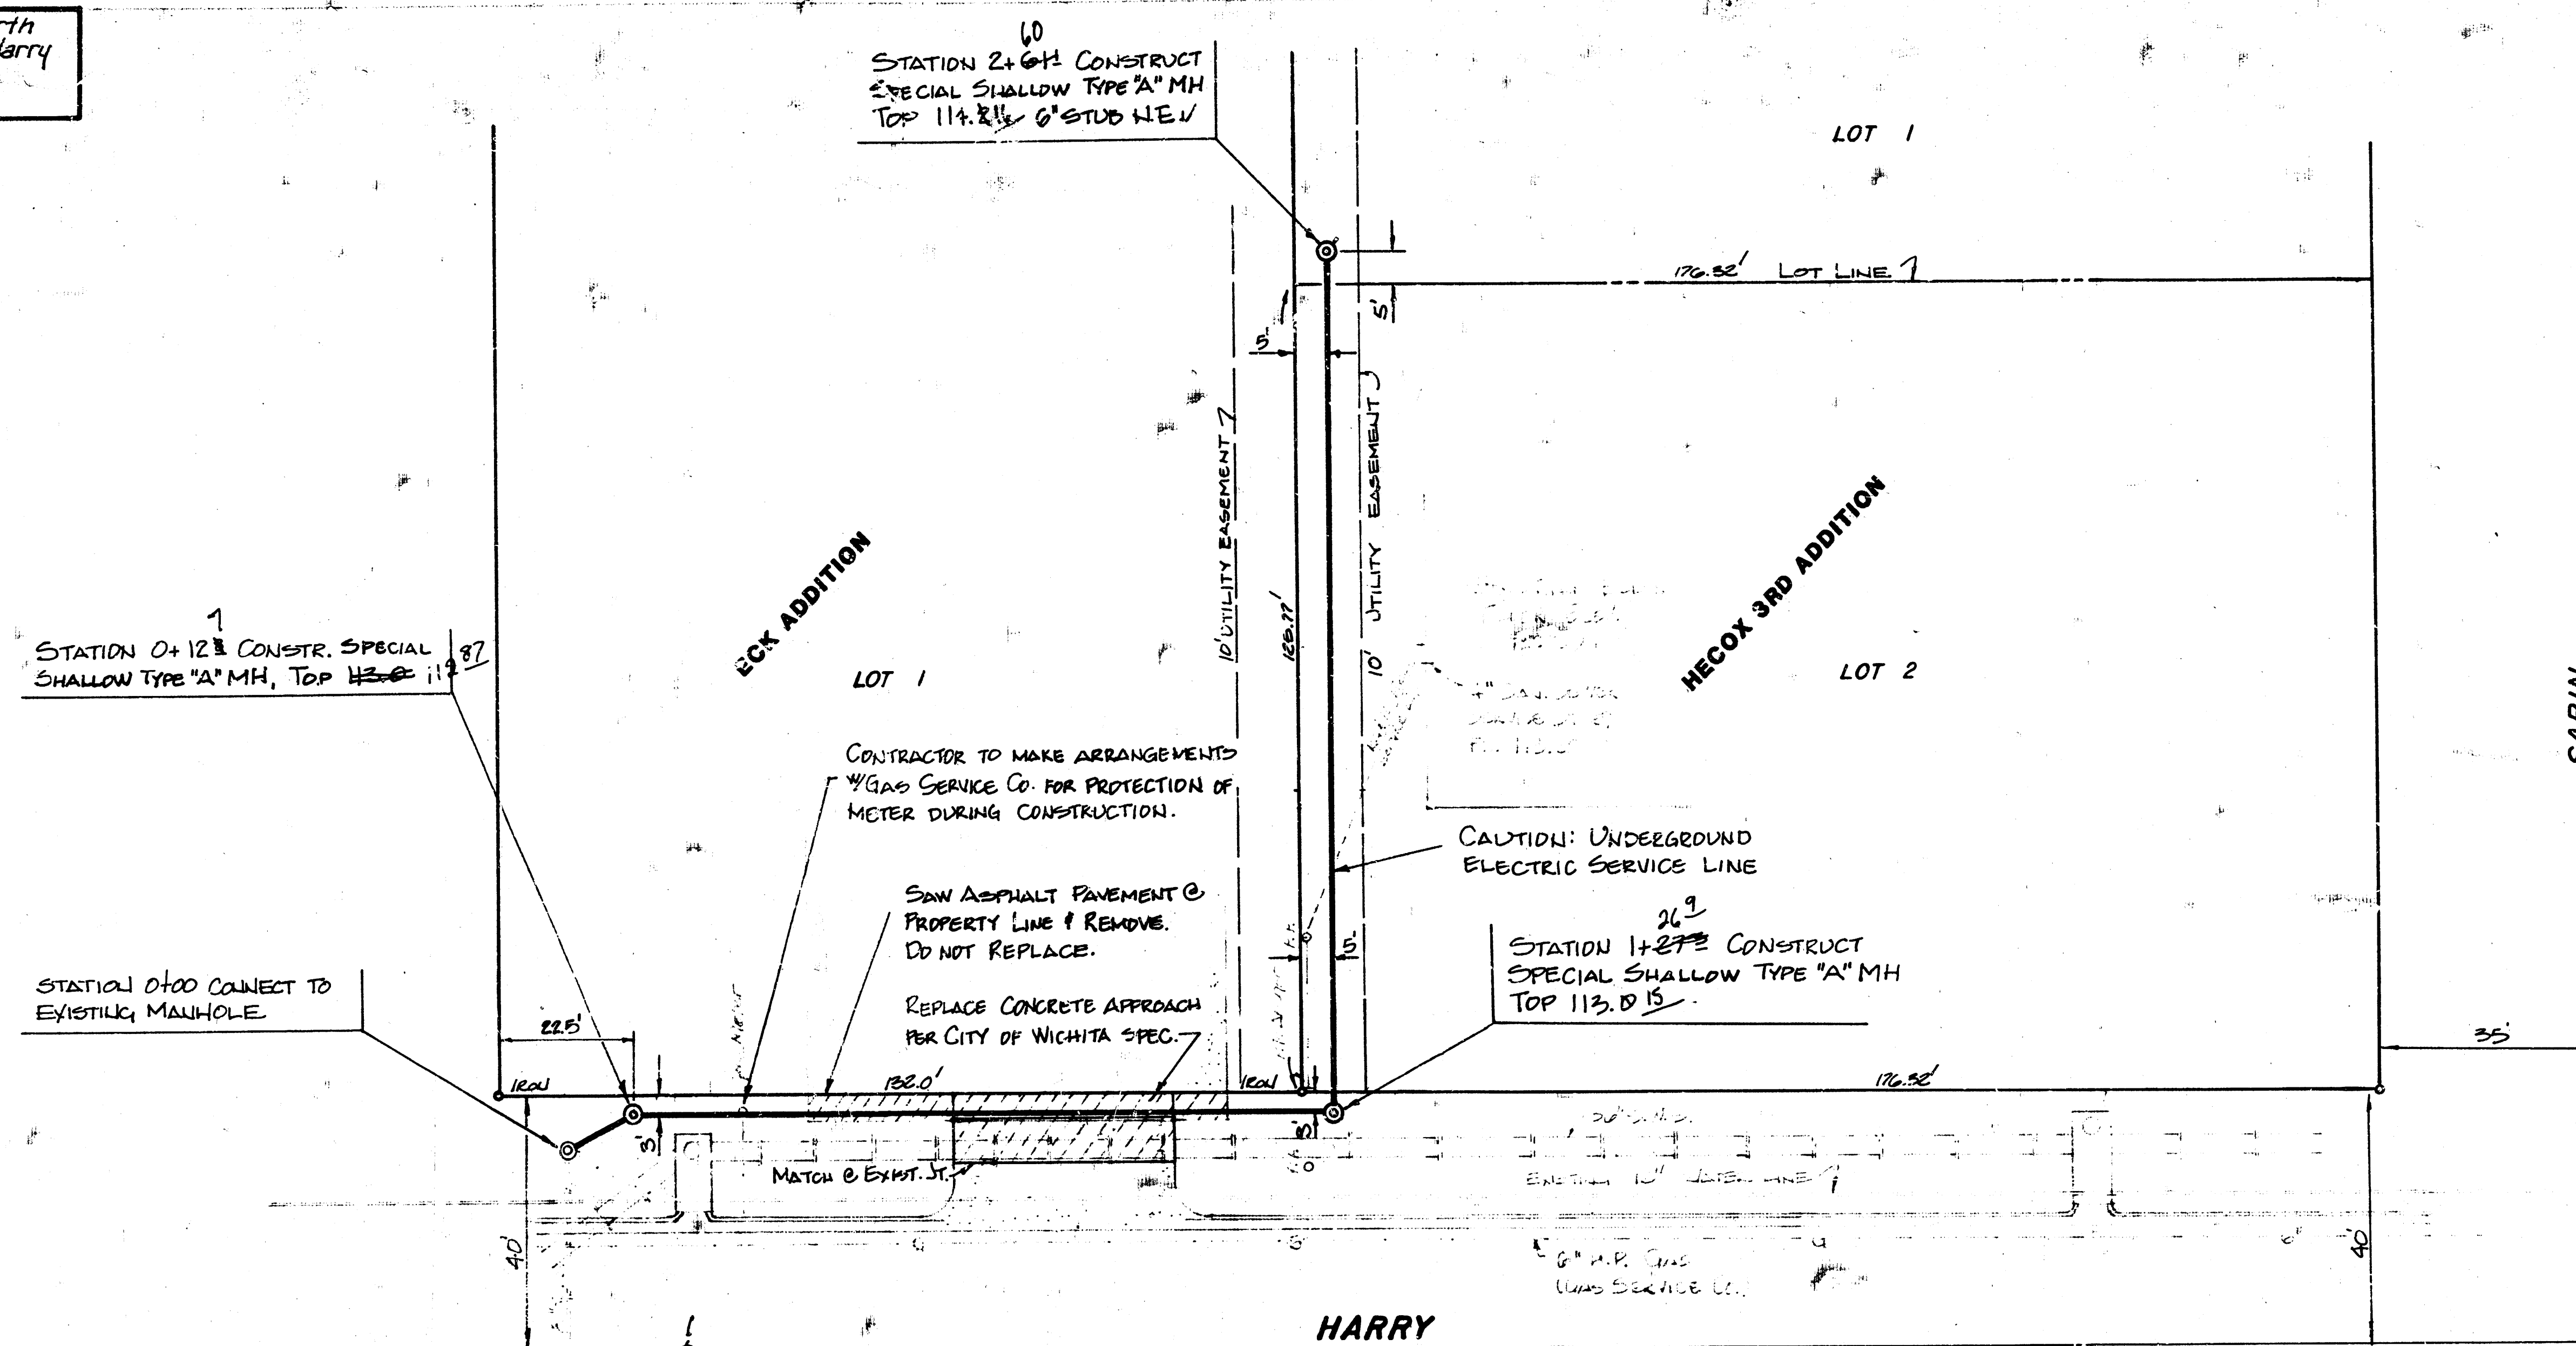

SPECIAL SHALLOW TYPE "A" MANHOLE

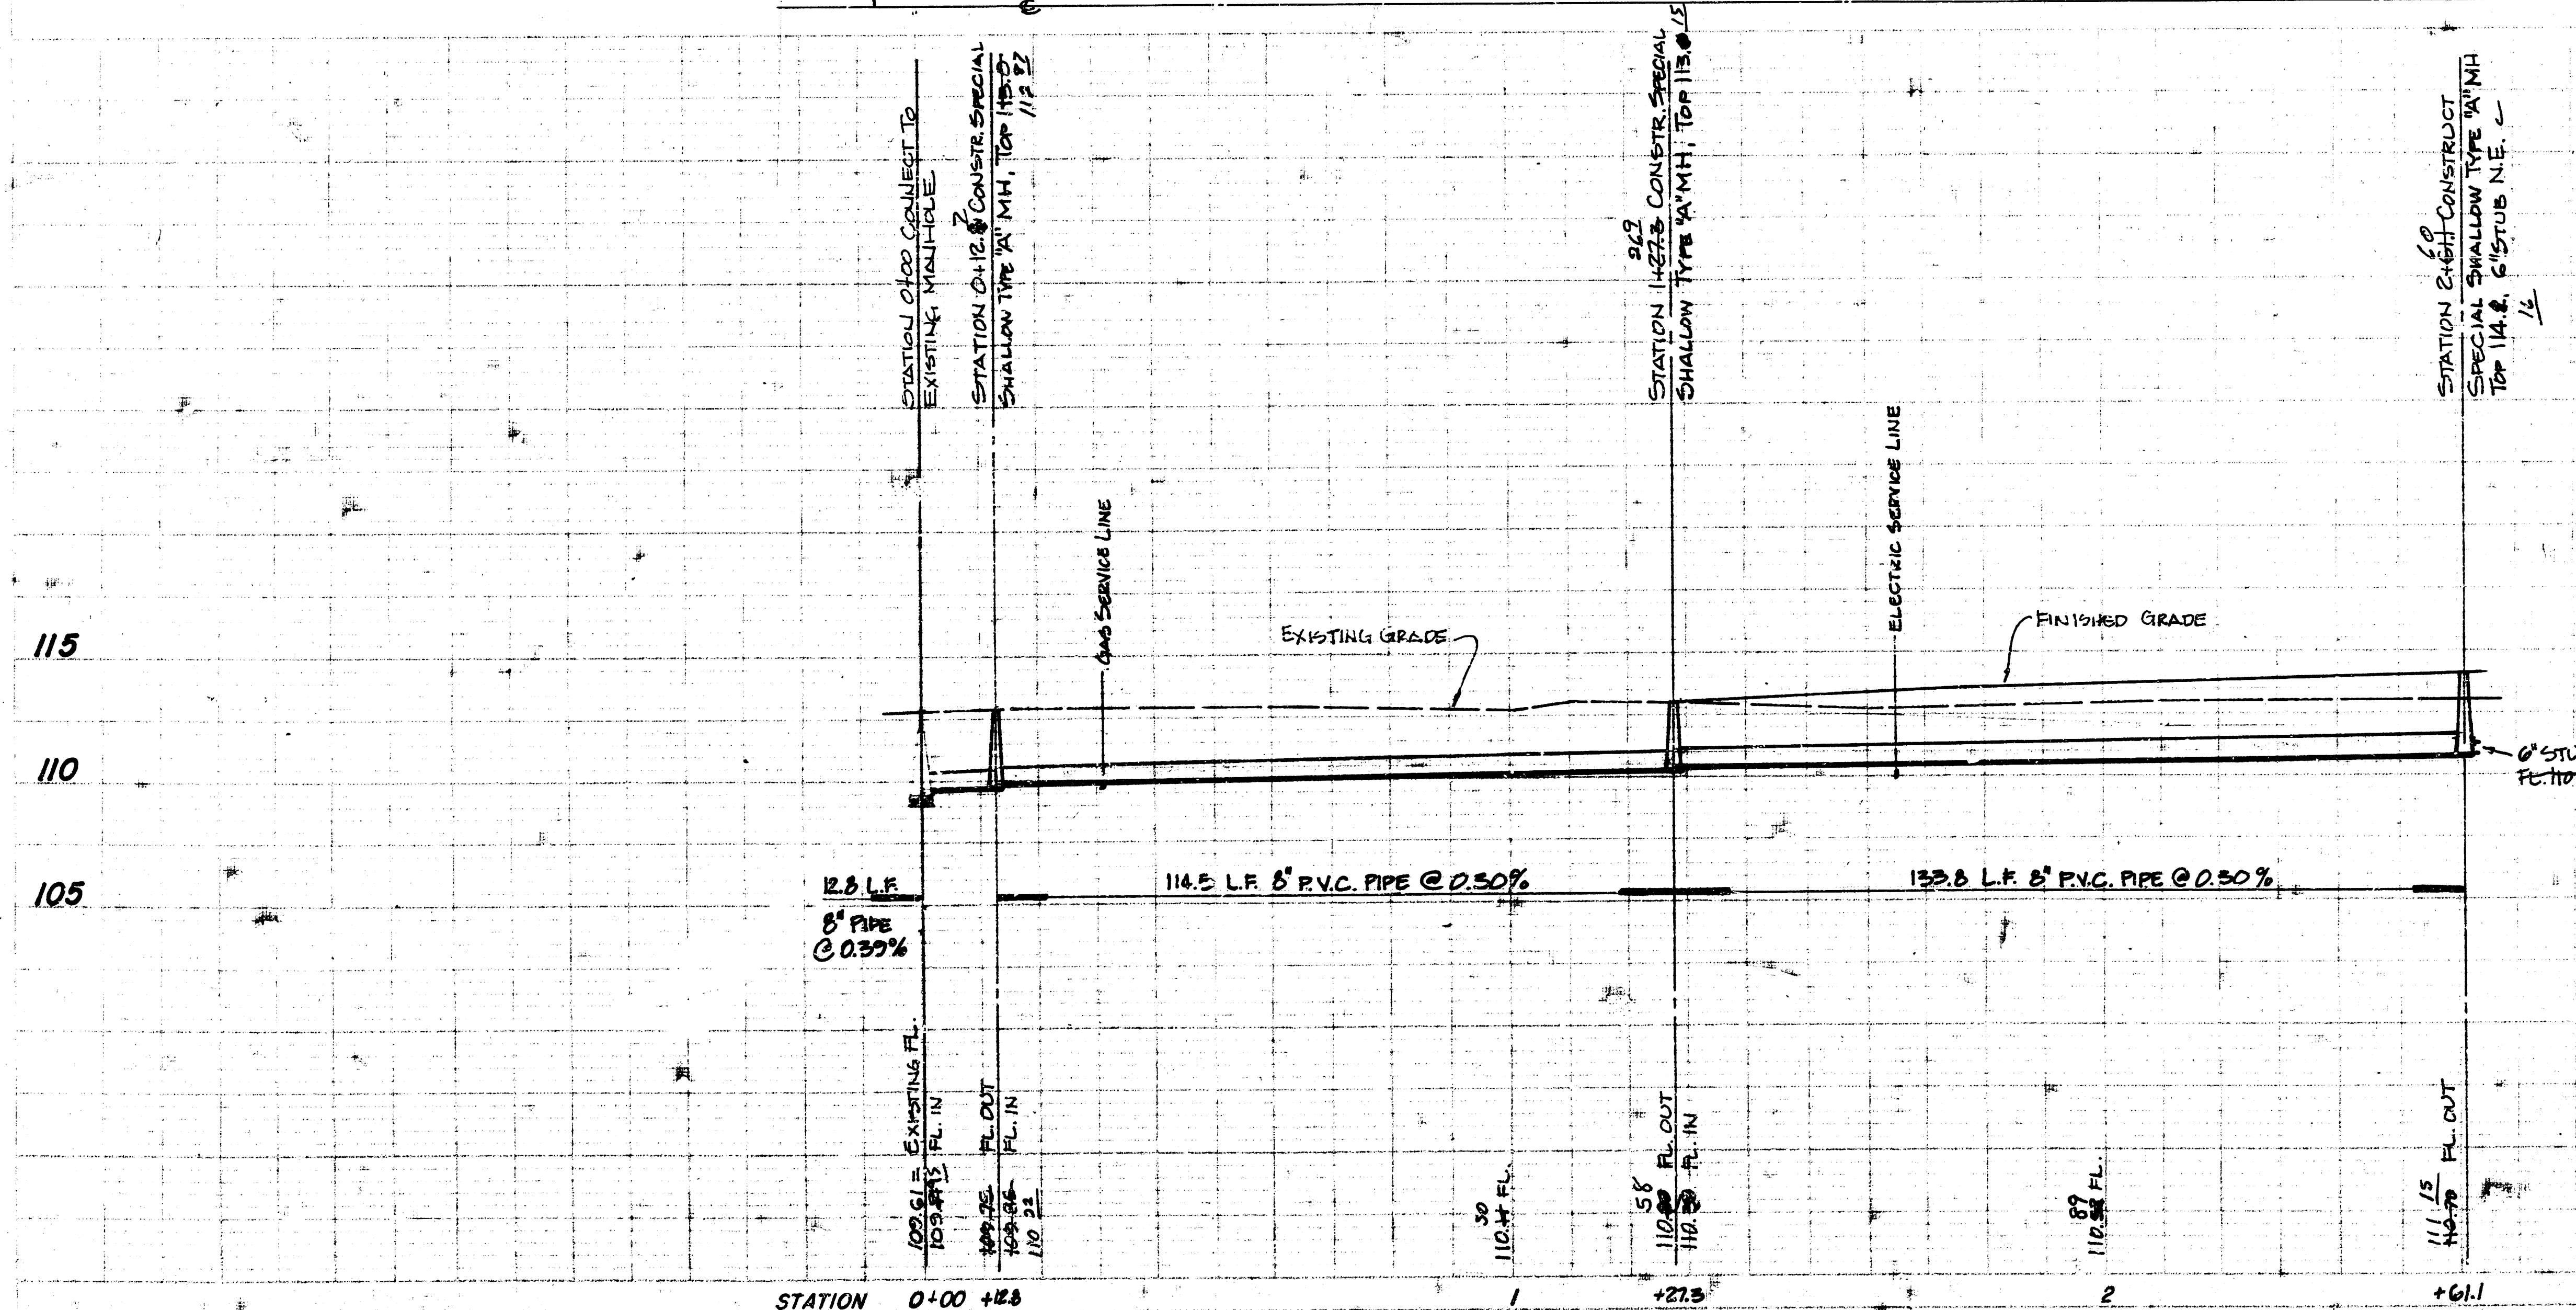

PROFILE SCALE
1" = 20' HORIZ.
1" = 5' VERT.

A5 Builth
J. L. L.
8-8-5

LATERAL 142 S.S. 22

CITY OF WICHITA, KANSAS

PROJECT NO.
468-76-245-81315-000-000-001

BAUGHMAN COMPANY, P.A.
SURVEYING & ENGINEERING
316-262-7271 • 330 LAURA • WICHITA KANSAS 67211

FILMED FROM THE BEST