
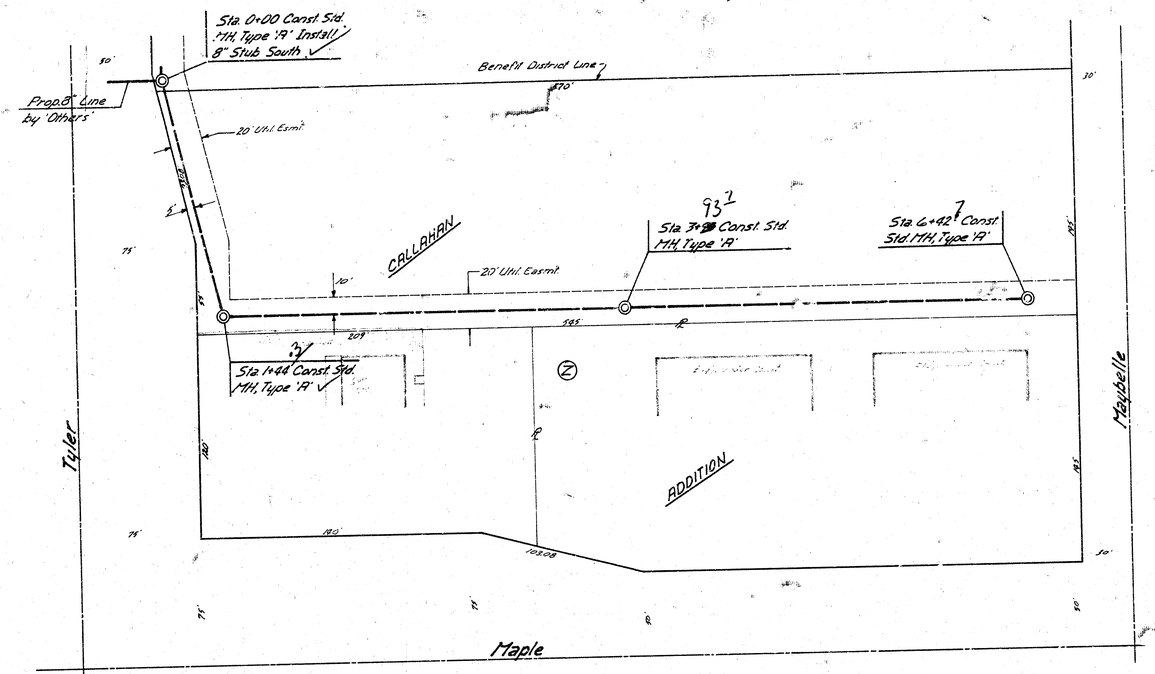


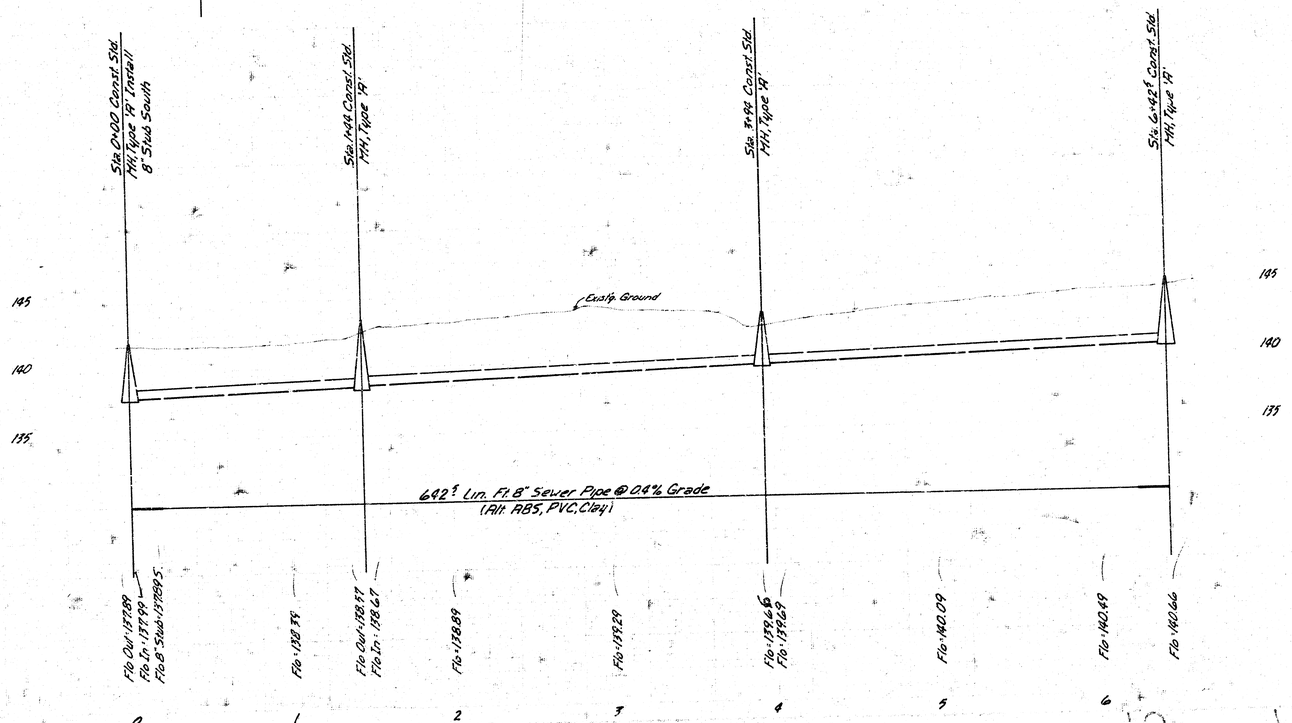

Field Engineer to Set Top of Manholes to Finish Grade as Determined by the Developer.

B.M. 143.41 City Std. 34.2' E. & 27.2' S. of ℄'s Maple & Tyler Rd.

SCALE
Plan 1"=40'
Profile Hort 1"=40'
Vert 1"=5'

As Built
7-27-81
JH

CHRIS J. BILLINGSLEY
LICENSED
8078
KANSAS

Lat. 145, SW Interceptor Sewer
468-76-245-80861-000-000-001
City of Wichita, Kansas
Dept. of Public Works - Eng. Div.
Dean S. Sellers - Acting City Engineer

FILMED FROM THE BEST AVAILABLE COPY