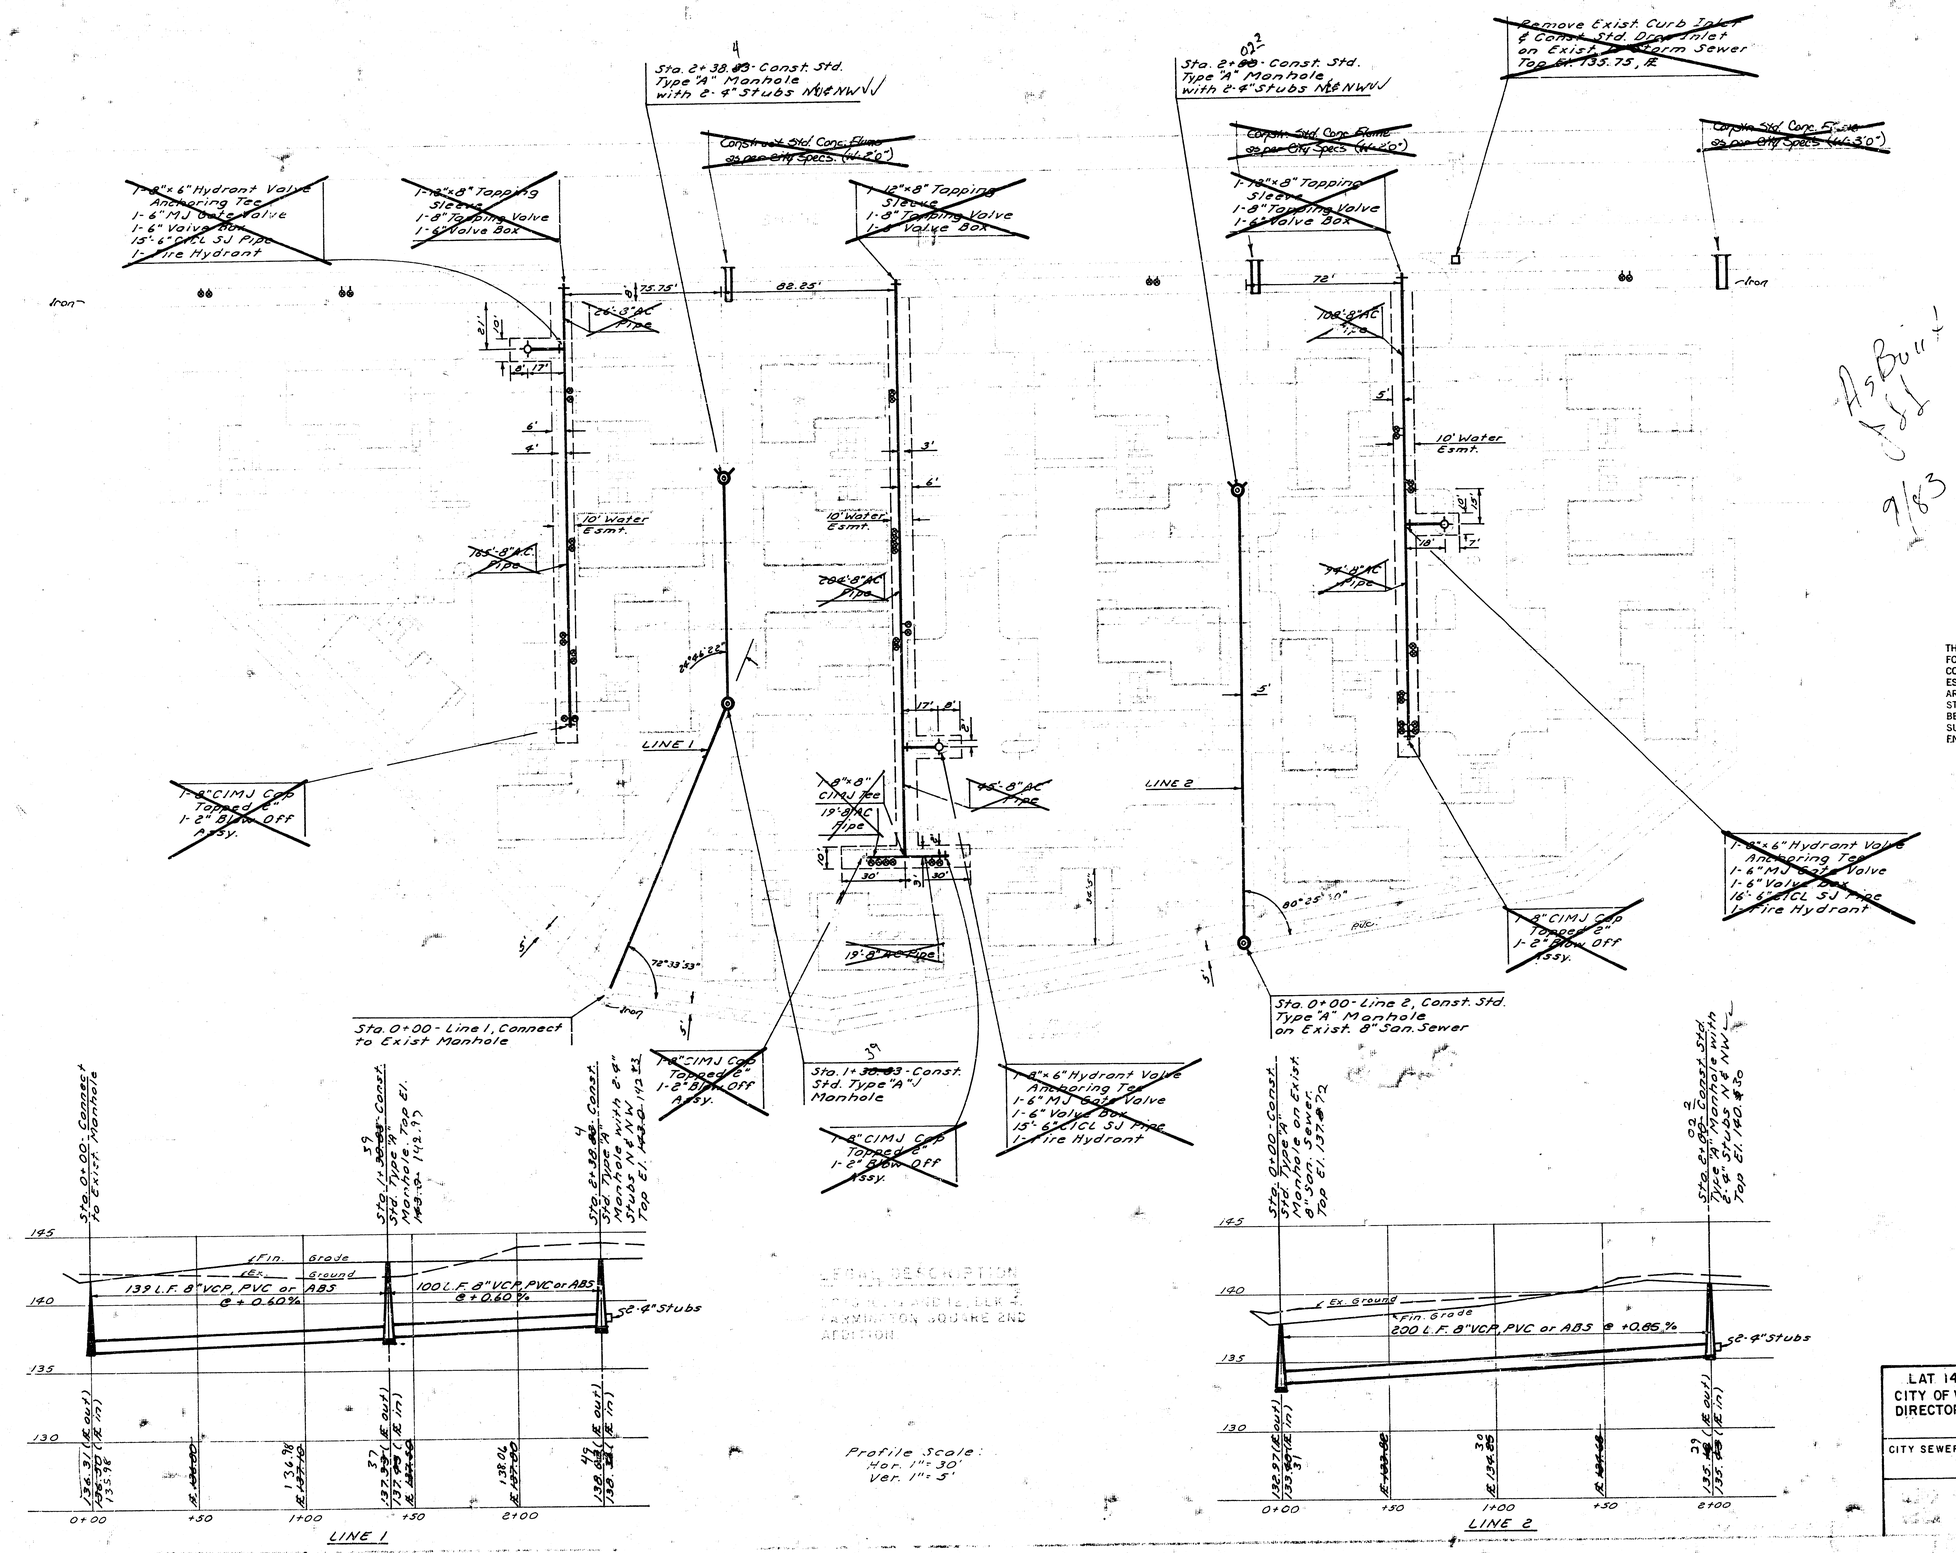

As Built
9/83

B.M. "+" Cut in Bolt Top of Fire Hyd. cor. Shade & Par. Elev. 135.04

THE CONTRACTOR SHALL BE RESPONSIBLE FOR PRESERVING PROPERTY IRONS. THE CONTRACTOR SHALL BE REQUIRED TO RE-ESTABLISH ANY PROPERTY IRONS WHICH ARE DAMAGED OR DESTROYED BY HIS CONSTRUCTION OPERATIONS. SUCH IRONS SHALL BE RE-ESTABLISHED BY A LICENSED LAND SURVEYOR OR A LICENSED PROFESSIONAL ENGINEER IN ACCORDANCE WITH STATE LAWS.

LEGAL DESCRIPTION
[illegible] AND 12, BLK 4, FARMINGTON SQUARE 2ND ADDITION

N. BRENT WOOTEN LICENSED 3470 KANSAS PROFESSIONAL ENGINEER

LAT 149, SOUTHWEST INTERCEPTOR
CITY OF WICHITA, DEPART. OF ENGINEERING
DIRECTOR OF ENGINEERING / CITY ENGINEER
R. W. BRUGGEMAN

CITY SEWER PROJ. NO. 468-76-245-81261-000-000-001

1/1