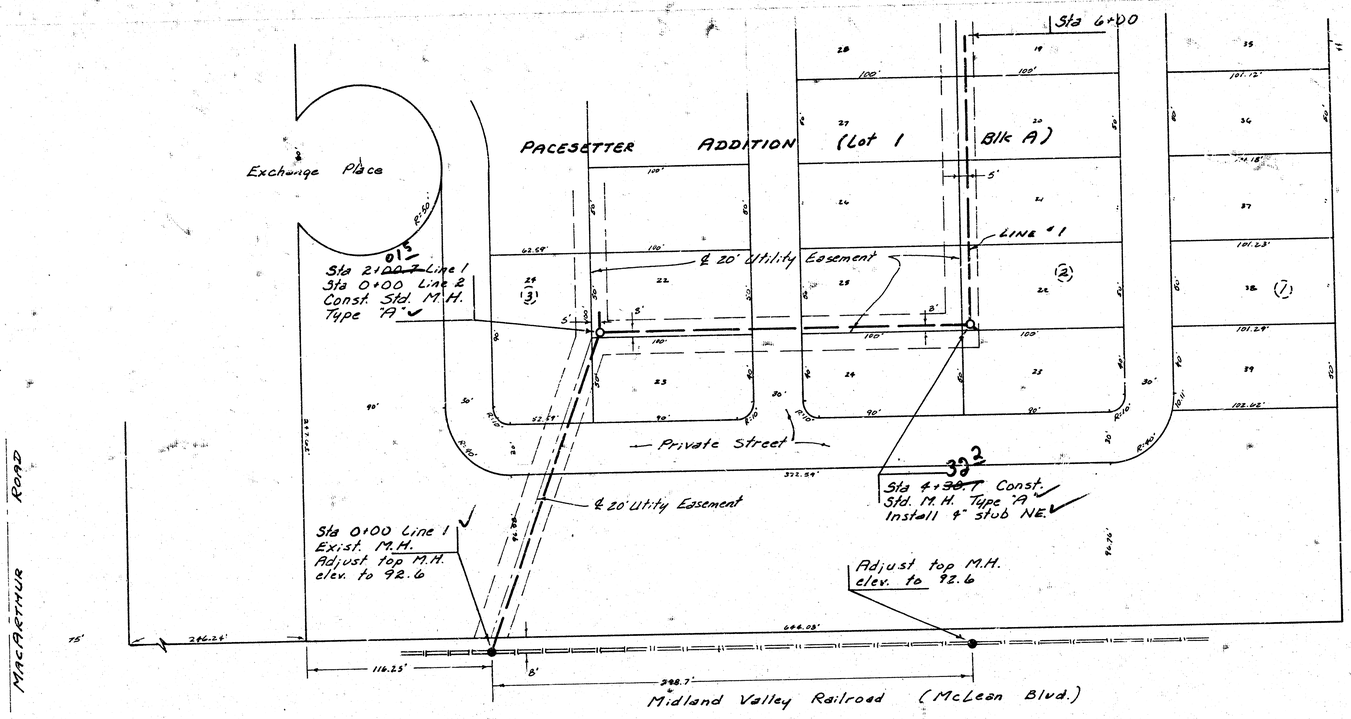

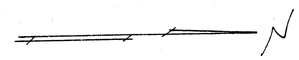

Scale Plan 1" = 40'
Profile 1" = 40' Horz.
1" = 5' Vert.

B.M. 91.28 Step Bench M.S. P.P. S.S. MacArthur Road and W.S. Mid. Valley Railroad.

B.M. 90.370 City Bench Mark disc. 86 ft. N. and 28.5 ft. W of Section corner at Seneca and MacArthur Rd.

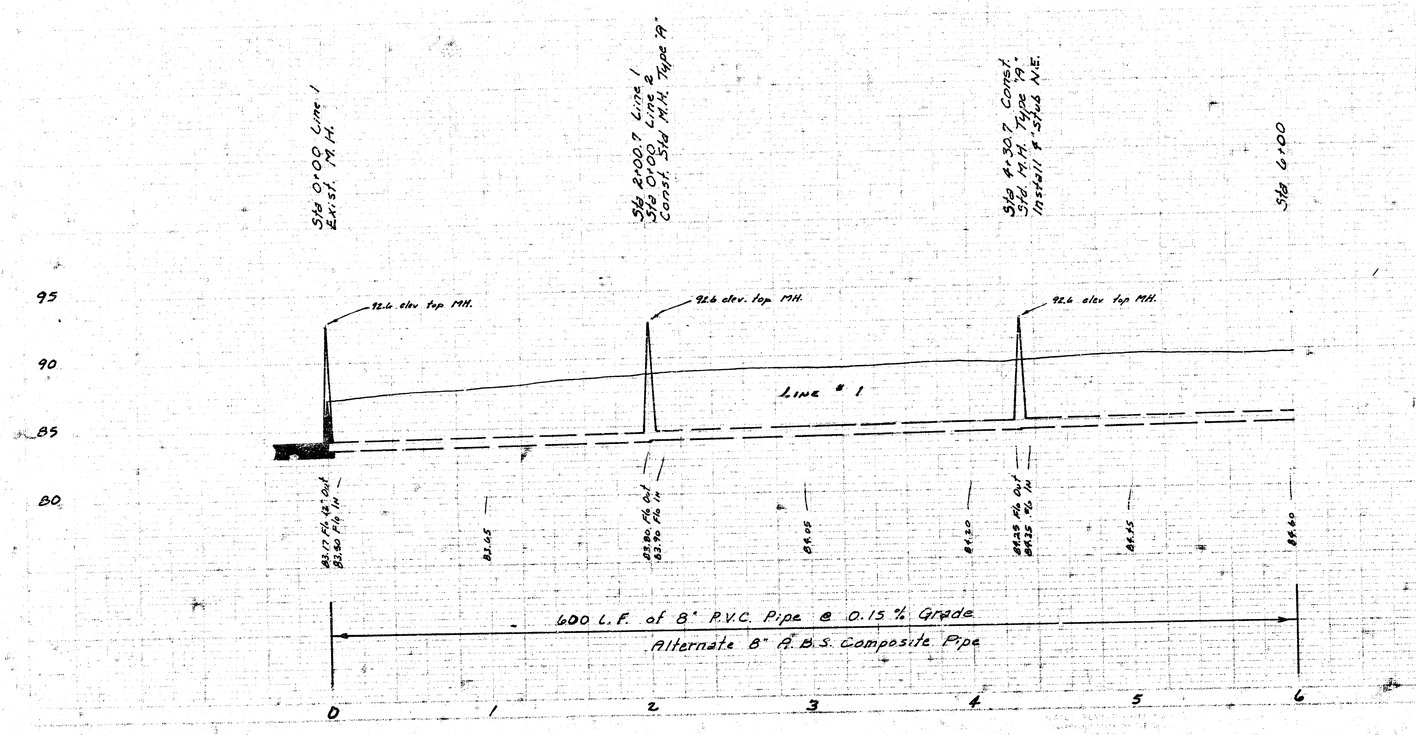

As Built
8-8
10/81

DONALD E. SCHMIDT
REGISTERED
6311
KANSAS
PROFESSIONAL ENGINEER

1/4

LAT 160, SW. INTERCEPTOR
CITY OF WICHITA
R.W. BRUGGEMAN
DIRECTOR OF ENGINEERING CITY ENGINEER
PROJ. NO. 468-76-245-81041-000-000-001

K4

Scale Plan 1" = 40'
Profile 1" = 40' Horz.
1" = 5' Vert.

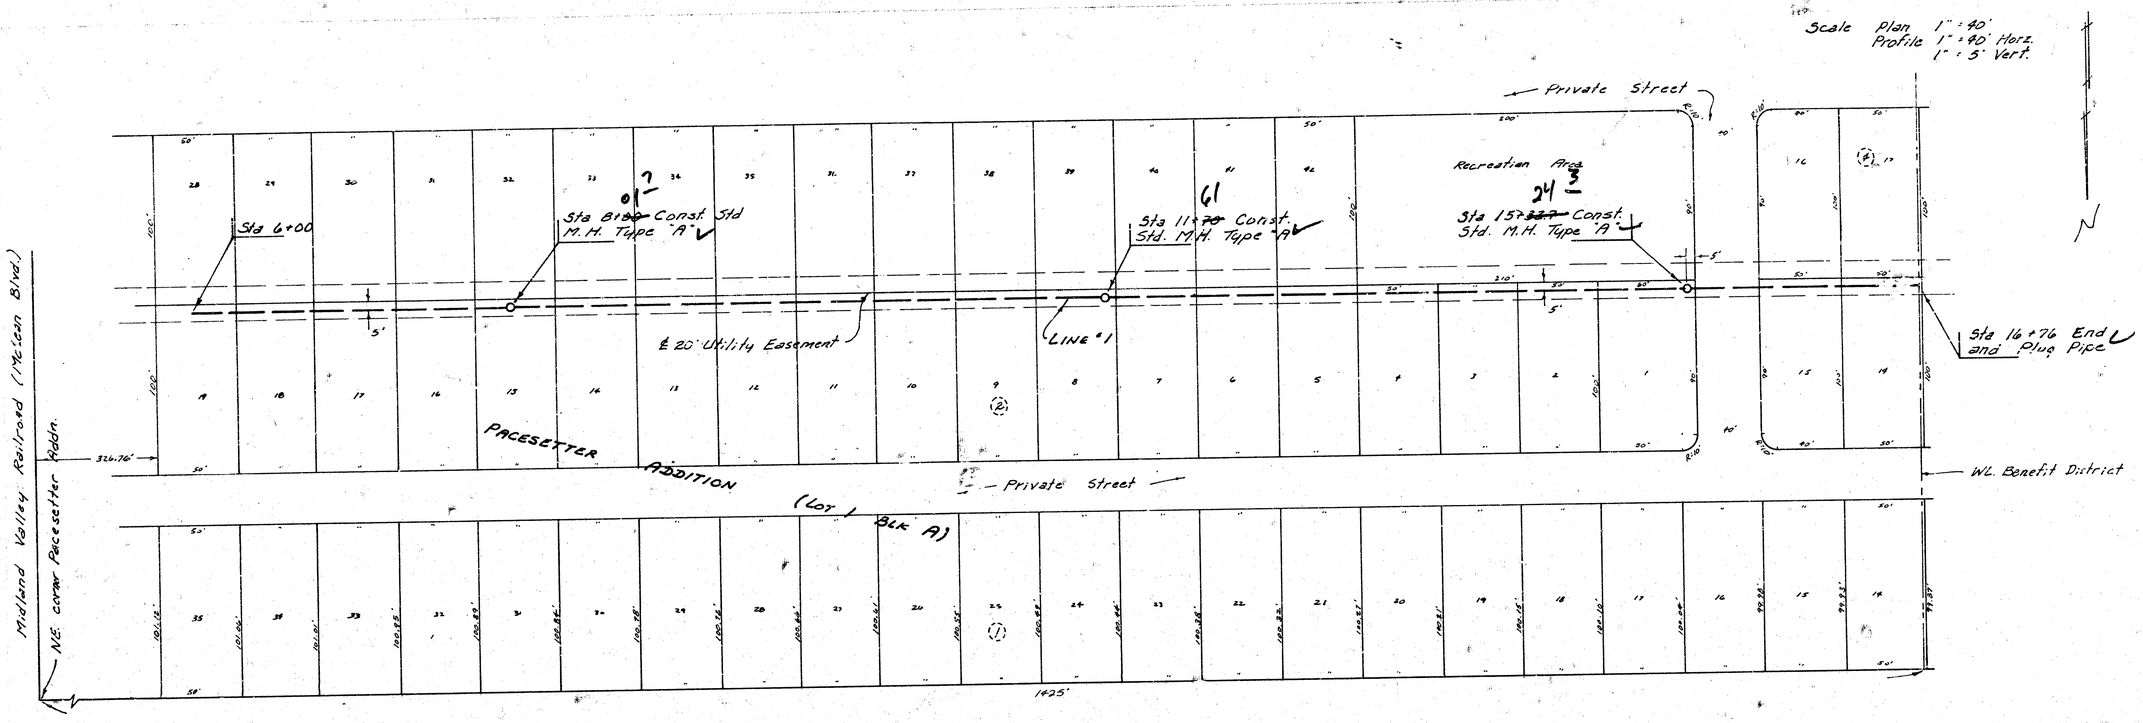

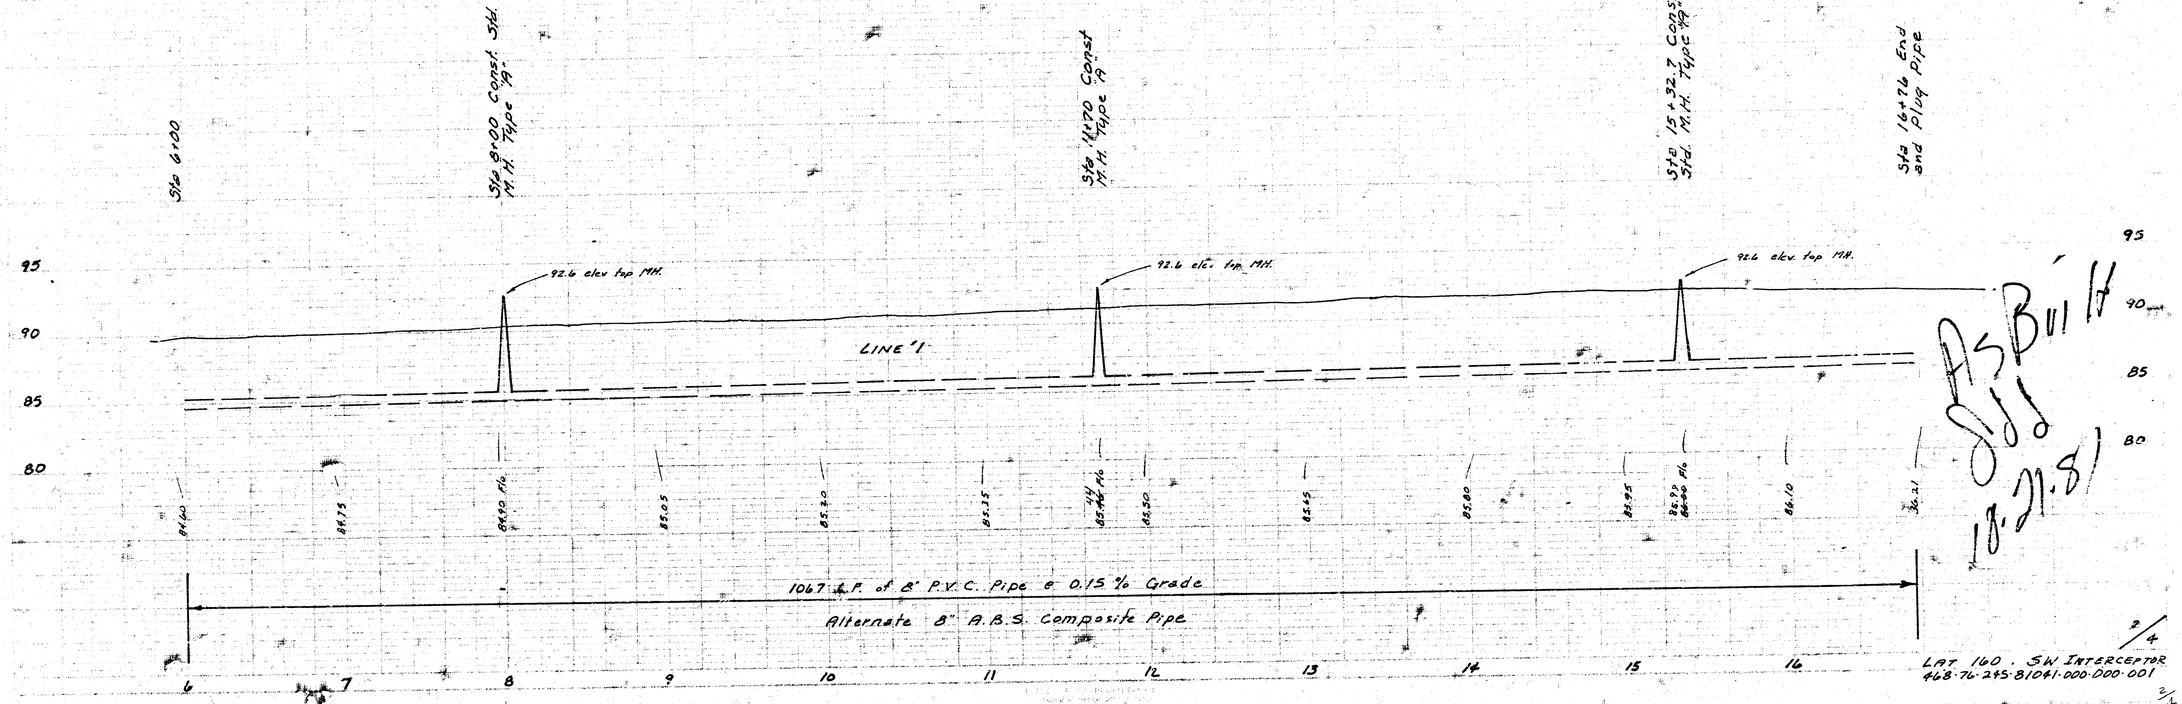

As Built
8-30
10-21-81

2/4

LAT 160 . SW INTERCEPTOR
468-76-245-81041-000-000-001

2/4

Scale Plan 1" = 40'
Profile 1" = 40' Horz.
1" = 5' Vert.

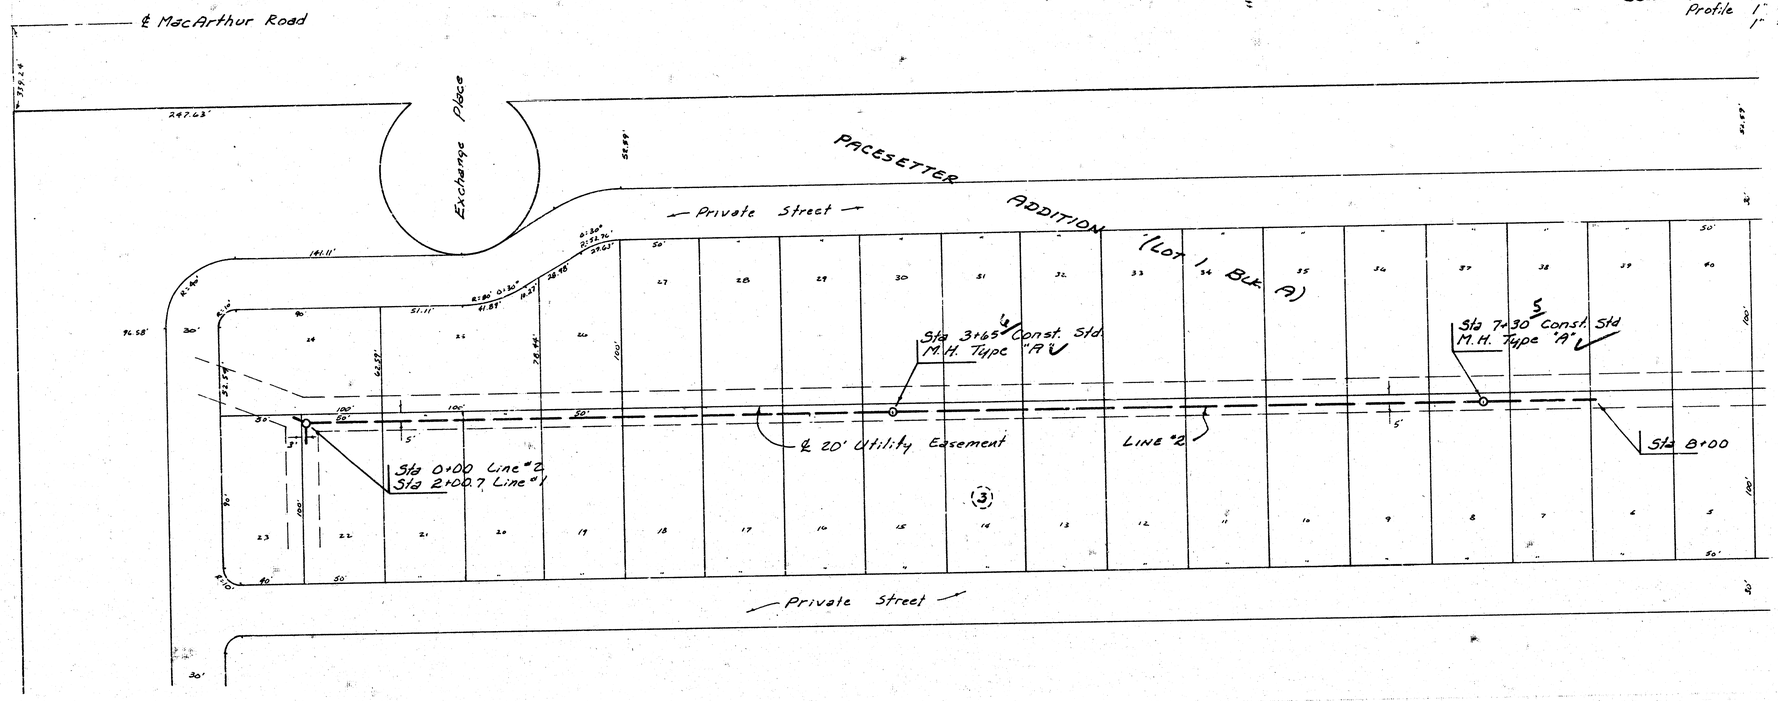

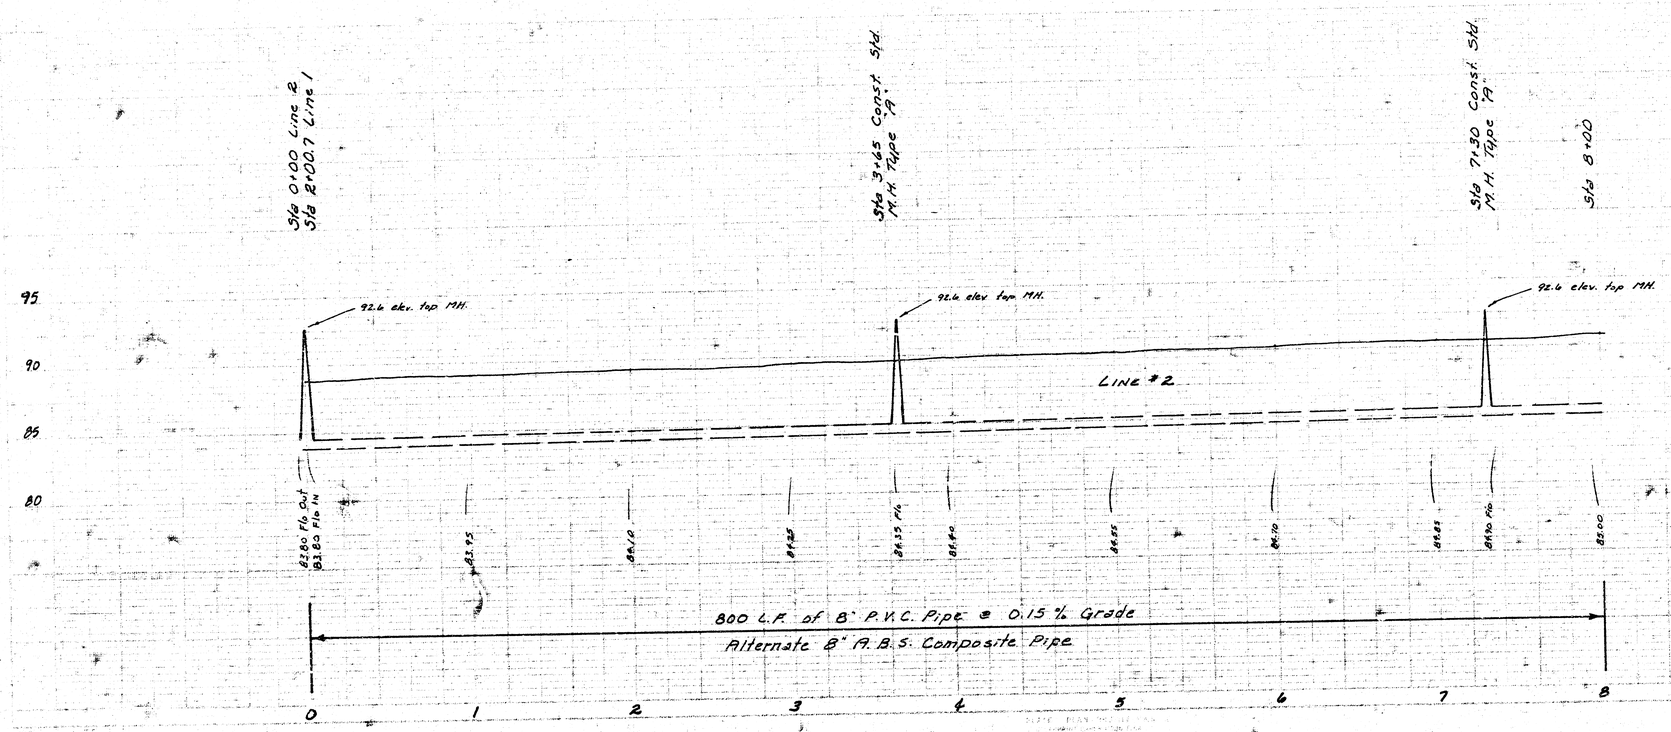

As Built
Jdb
8.21.81

3/4

LAT 160. SW INTERCEPTOR
468-76-245-81041-000-000-001

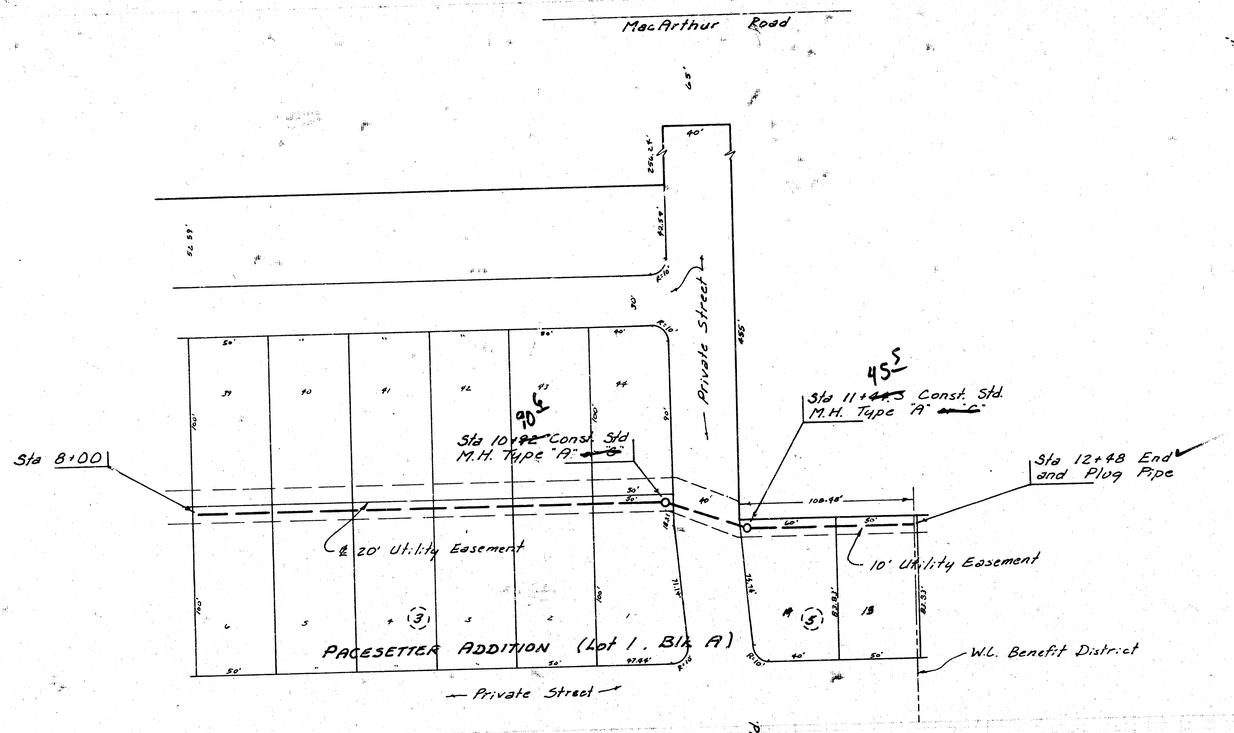

Scale Plan 1" = 40'
Profile 1" = 40' Horz.
1" = 5' Vert.

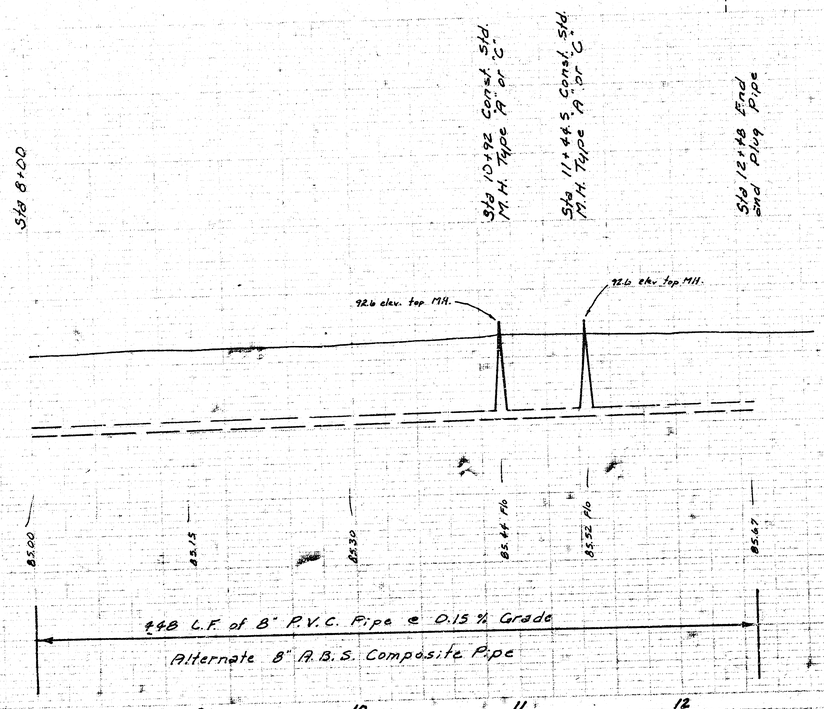

As Built
10-21-81

95
90
85
80

4/4

LAT 160, SW INTERCEPTOR
468-76-245-81041-000-0000001

17 5 5 18 4/4