B.M. 122.92 60P. NAIL IN W. FC. P.P. (W. POLE OF 3) E. OF WINTERSET AT WAYSIDE.
B.M. 126.93 R.R. SPK. IN FC. P.P., S. SIDE CENTRAL ACROSS FROM THE TOOL SHED, 6730 W. CENTRAL.

THE CONTRACTOR SHALL BE RESPONSIBLE FOR PRESERVING PROPERTY CORNERS. THE CONTRACTOR SHALL BE REQUIRED TO RE-ESTABLISH ANY PROPERTY CORNERS WHICH ARE DAMAGED OR DESTROYED BY HIS CONSTRUCTION OPERATIONS. SUCH CORNERS SHALL BE RE-ESTABLISHED BY A LICENSED LAND SURVEYOR OR A LICENSED PROFESSIONAL ENGINEER IN ACCORDANCE WITH STATE LAWS.

SCALE
PLAN 1" = 40'
PROFILE 1" = 40' HORZ.
1" = 5' VERT.

NOT IN BENEFIT DISTRICT

℄ 20' Utility Easement

10' Sewer Easement

N.L. BENEFIT DISTRICT

Sta 0+00 Exist. MH.

10' Utility Easement

2ND ADDN TO QUEEN'S LAKE

Sta 1+87.5 Line 1
Sta 0+00 Line 2
Const. Std. MH. Type "C"

Sta 4+00.2 Const. Std. MH. Type "C"

SILVER SPRINGS ADDN.

Res. "A" Utility Easement

Sta 6+13.8 Const. Std. MH. Type "C"
Install 6" stubs NE & SE

LINE 1

℄ 20' Utility Easement

BOTTENBERG 2nd ADDN.

CENTRAL AVE.

RIDGE ROAD

CENTRAL AVE

BOTTENBERG 2nd ADDN.

2ND ADDN. TO QUEEN'S LAKE

UNPLATTED

D-357-UP

Sta 4+60.5 Const. Std. MH. Type "C"
Install 6" stub W.

Sta 0+00 Line 2
Sta 1+87.5 Line 1

Sta 0+20 Const. Std. MH. Type "C"
Install 6" stub SE.

℄ 20' Utility Easement

LINE 2

N.L. BENEFIT DISTRICT

Sta 3+70.2 Const. Std. MH. Type "C"

As Built
J.L.L.
8/82

Existing Concrete Encasement

Sta 0+00 Exist. MH.

Sta 1+87.5 Line 1
Sta 0+00 Line 2
Const. Std. MH. Type "C"

Sta 4+00.2 Const. Std. MH. Type "C"

Sta 6+13.8 Const. Std. MH. Type "C"
Install 6" stubs NE & SE

128.3 TOP MH. ELEV.
127.2 TOP MH. ELEV.
126.99 TOP MH. ELEV

Sewer raised approx 2'
LINE 1

612.2 Lin. Ft. of 8" P.V.C. Pipe @ 0.40 % Grade
Alternate 8" A.B.S. Composite Pipe or 8" Clay Pipe

Sta 0+00 Line 2
Sta 1+86.8 Line 1

Sta 0+20 Const. Std. MH. Type "C"
Install 6" stub SE.

Sta 3+70.2 Const. Std. MH. Type "C"

Sta 4+60.5 Const. Std. MH. Type "C"
Install 6" stub W.

128.01 TOP MH. ELEV.
128.2 TOP MH. ELEV.
127.5 TOP MH. ELEV

Sewer raise approx. 2'
LINE 2


460 Lin. Ft. of 8" P.V.C. Pipe @ 0.40 % Grade
Alternate 8" A.B.S. Composite Pipe or 8" Clay Pipe

DONALD R. SCHAFER
6311
KANSAS
REGISTERED PROFESSIONAL ENGINEER

LAT 172, SW. INTERCEPTOR SEWER


CITY OF WICHITA, KANSAS
R. W. BRUGGEMAN
DIRECTOR OF ENGINEERING / CITY ENGINEER
PROJ. NO. 468-78-245-81132-000-000-001

1/2

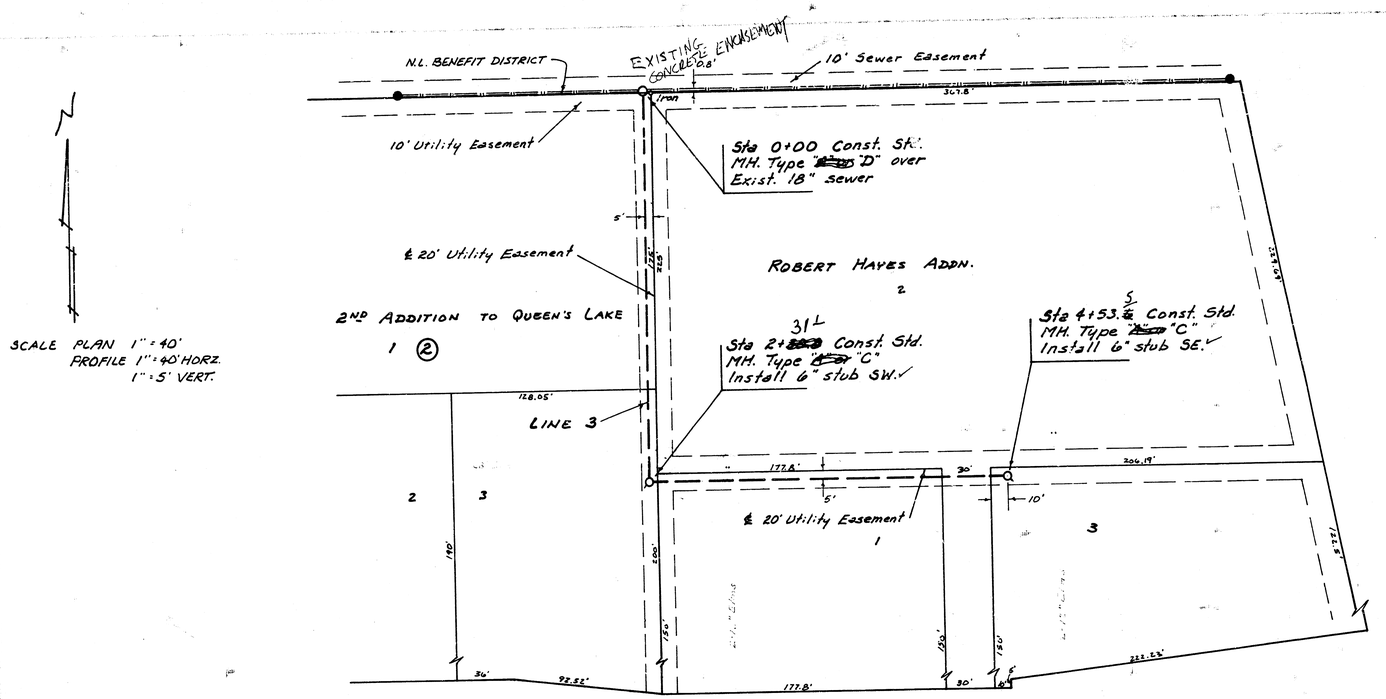

SCALE PLAN 1" = 40'
PROFILE 1" = 40' HORZ.
1" = 5' VERT.

As Built
J.L.L.
8-82

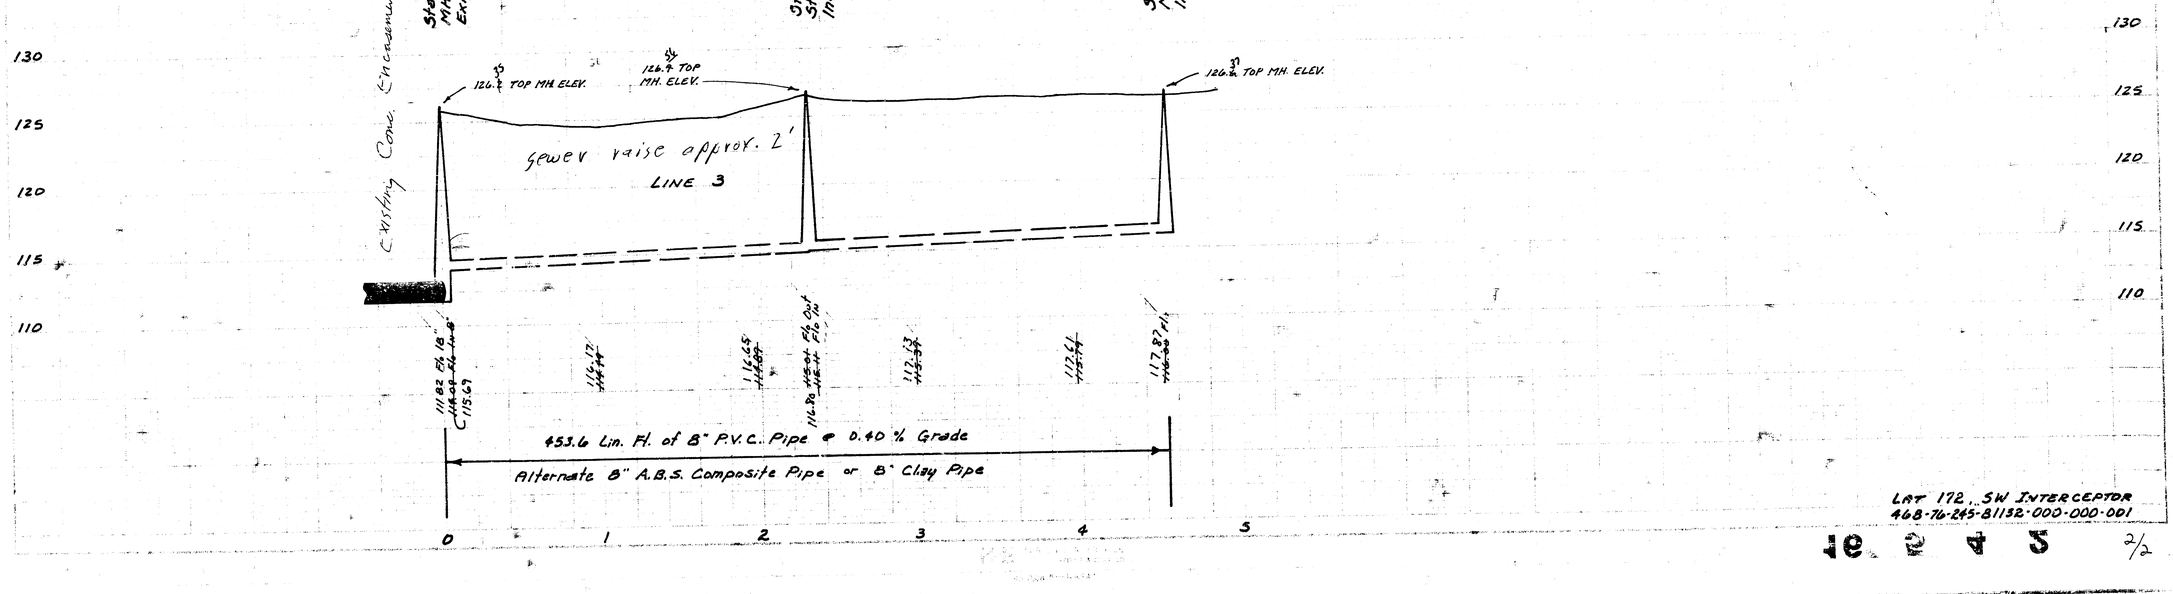

LAT 172., SW INTERCEPTOR
468-76-245-81132-000-000-001

2/2