
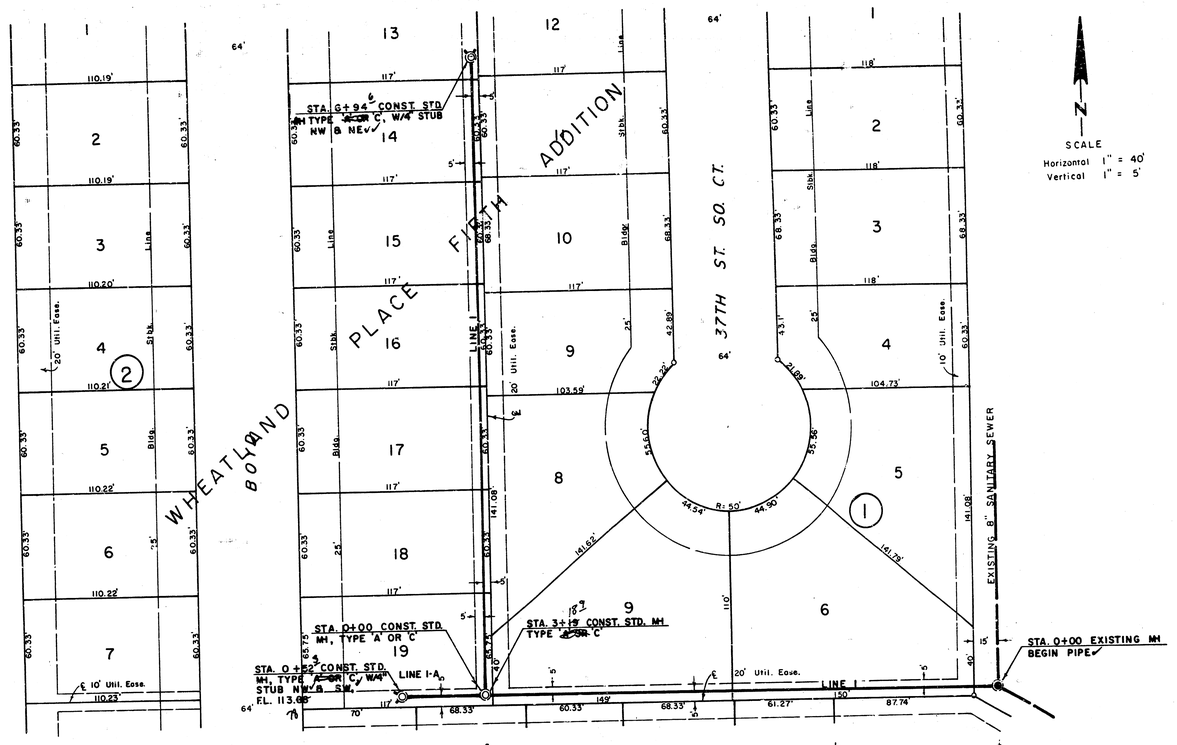


B.M. - WEST RIM OF MH, STA. 0+00, LINE 1, ELEV. 123.97

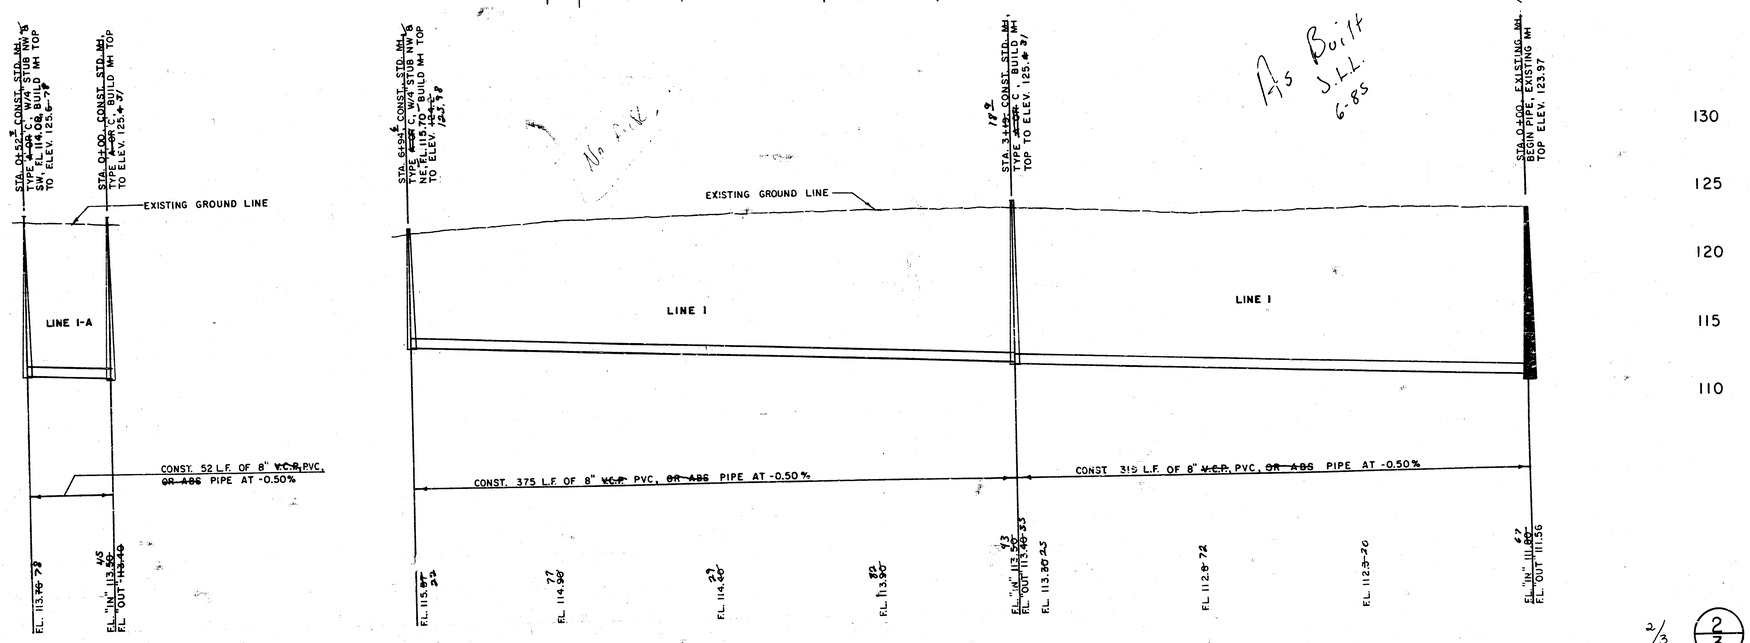


As Built J.T.L. 6-85


2/3 (2/3)

LAT 190, SWI

FILMED FROM THE BEST AVAILABLE COPY

SCALE
Horizontal 1" = 40'
Vertical 1" = 5'

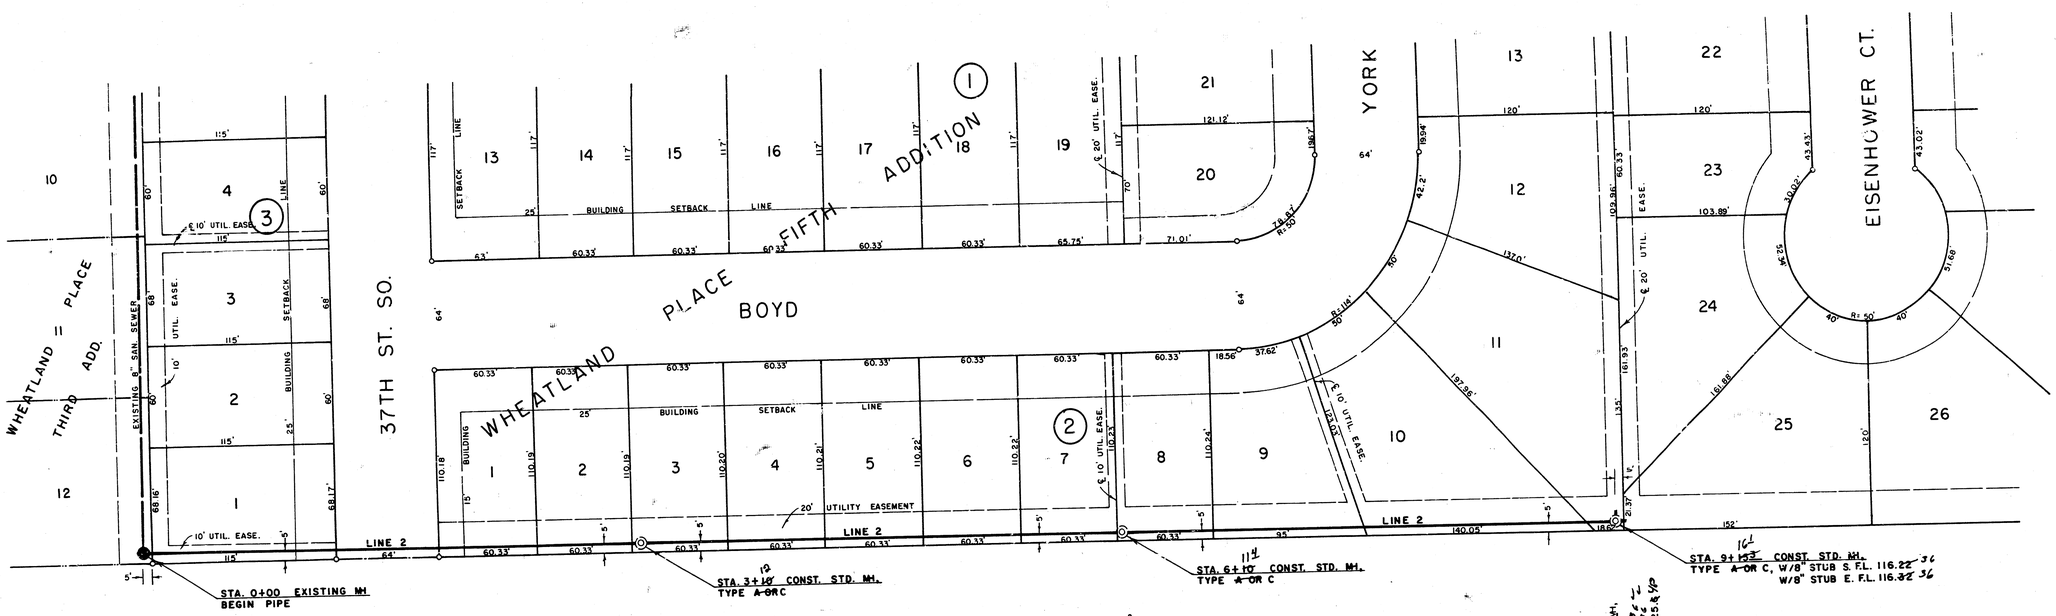

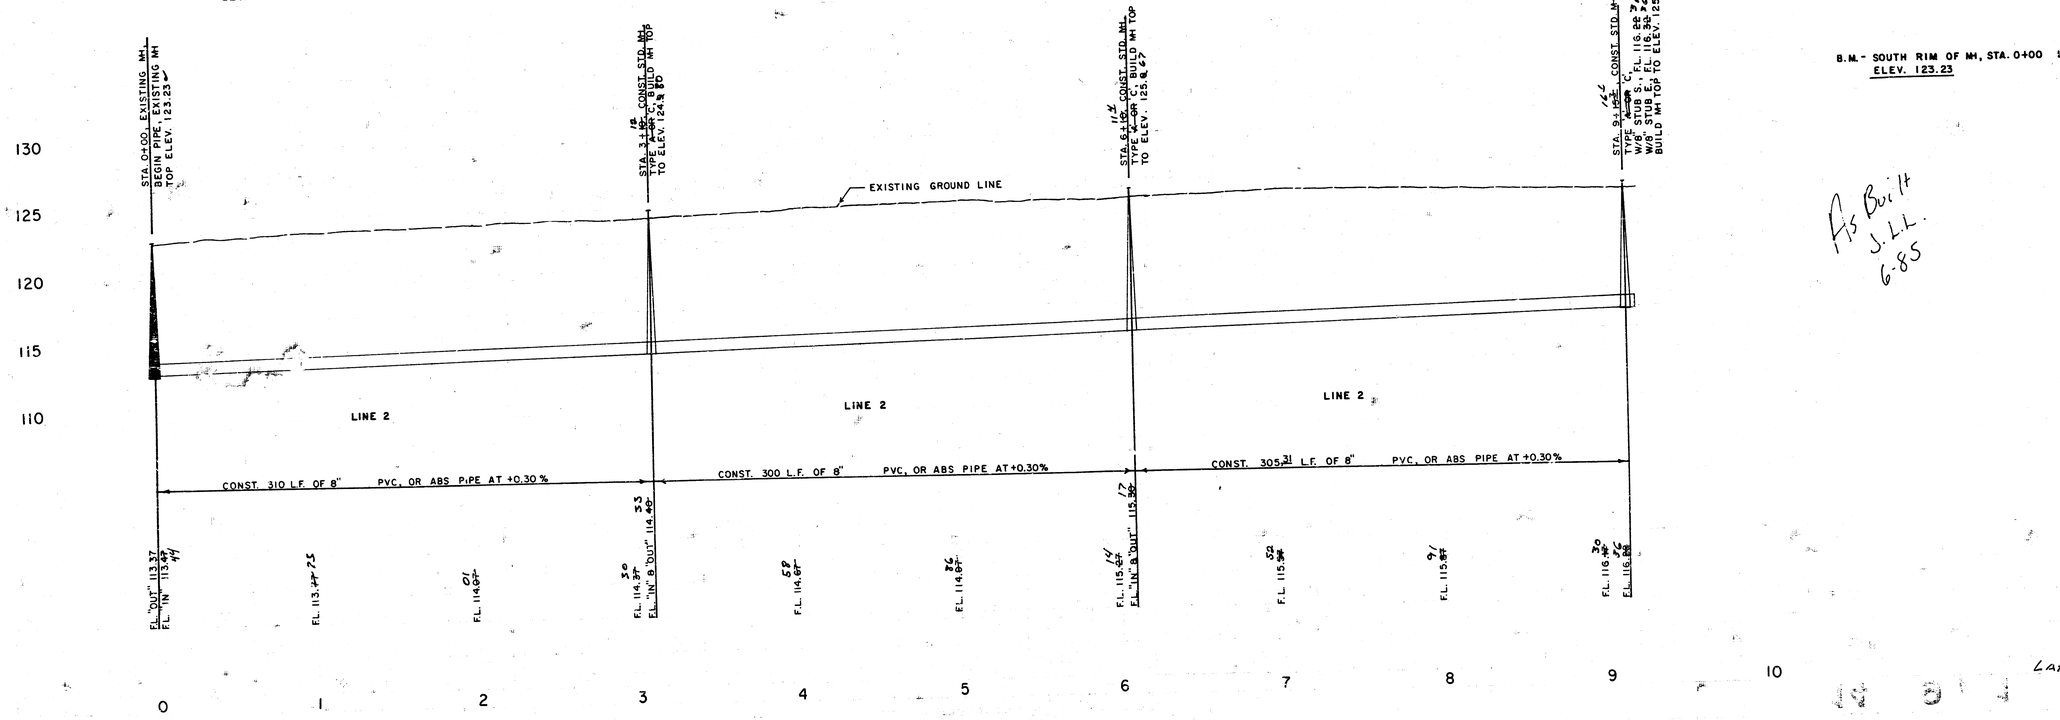

B.M. - SOUTH RIM OF MH, STA. 0+00 LINE 2, ELEV. 123.23

As Built
J.L.L.
6-85

3/3 (3/30)

Lot 190, SWI

FILMED FROM THE BEST AVAILABLE COPY